

CERTIFIED LAND CORNER RESTORATION

Index No. A-19

State of Wisconsin }  
County of Forest } ss.


I Philip T. Hansen, do hereby certify that on the 29th day of July, 1977, I found established the Quarter corner of Section 35 and 2 Township 36 & 35, North, Range 12 East, Fourth Principal Meridian, as described hereon; and that from this evidence I established a new monument and accessories as described hereon to perpetuate the original location of this corner.

Resident witnesses:


Glen Barker

Jim Claflin

Herb Wagoner

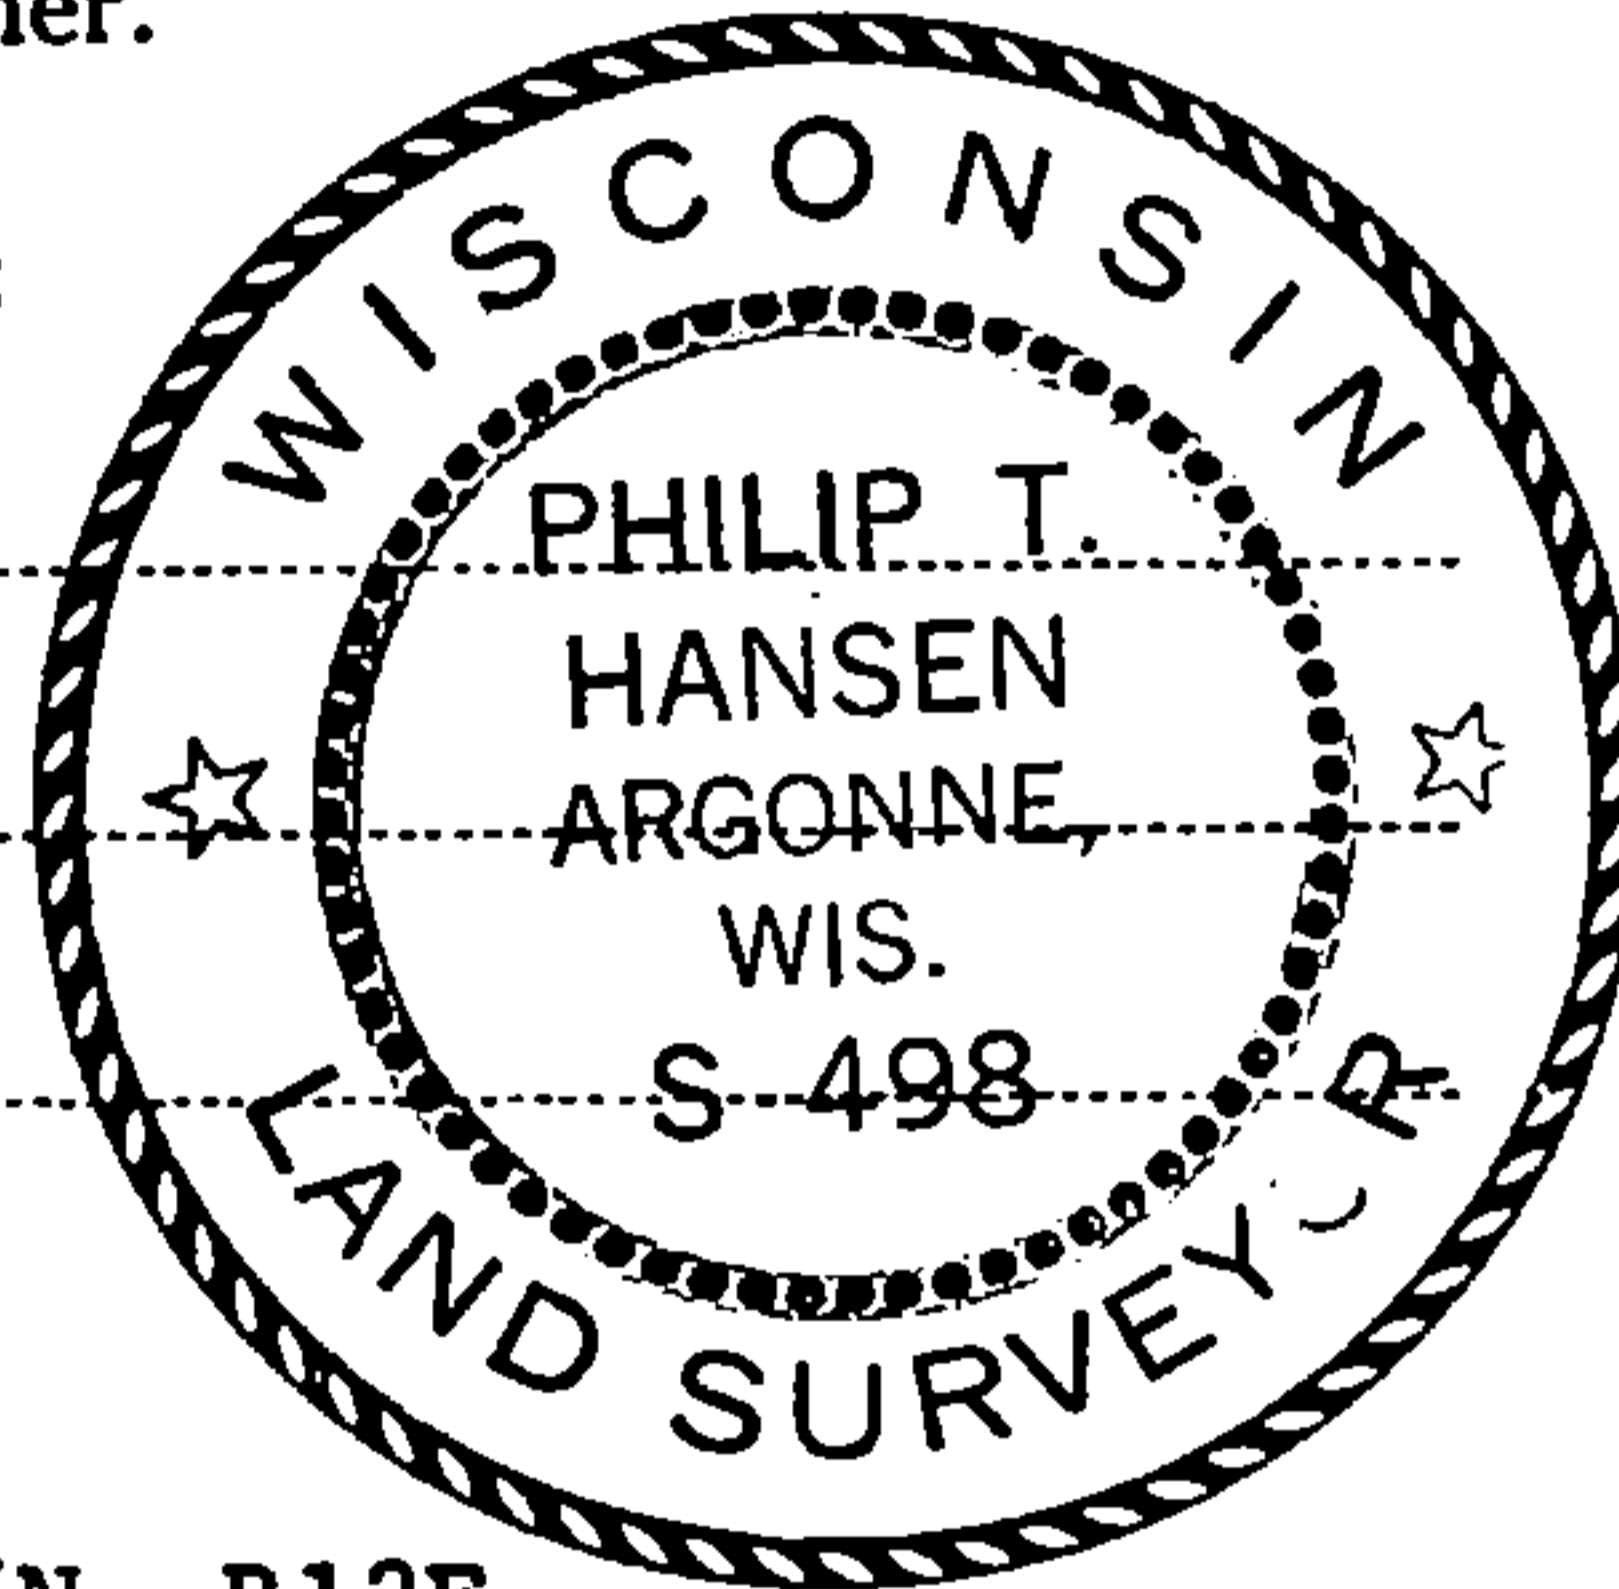

FORM 985 H. C. MILLER CO., MILWAUKEE

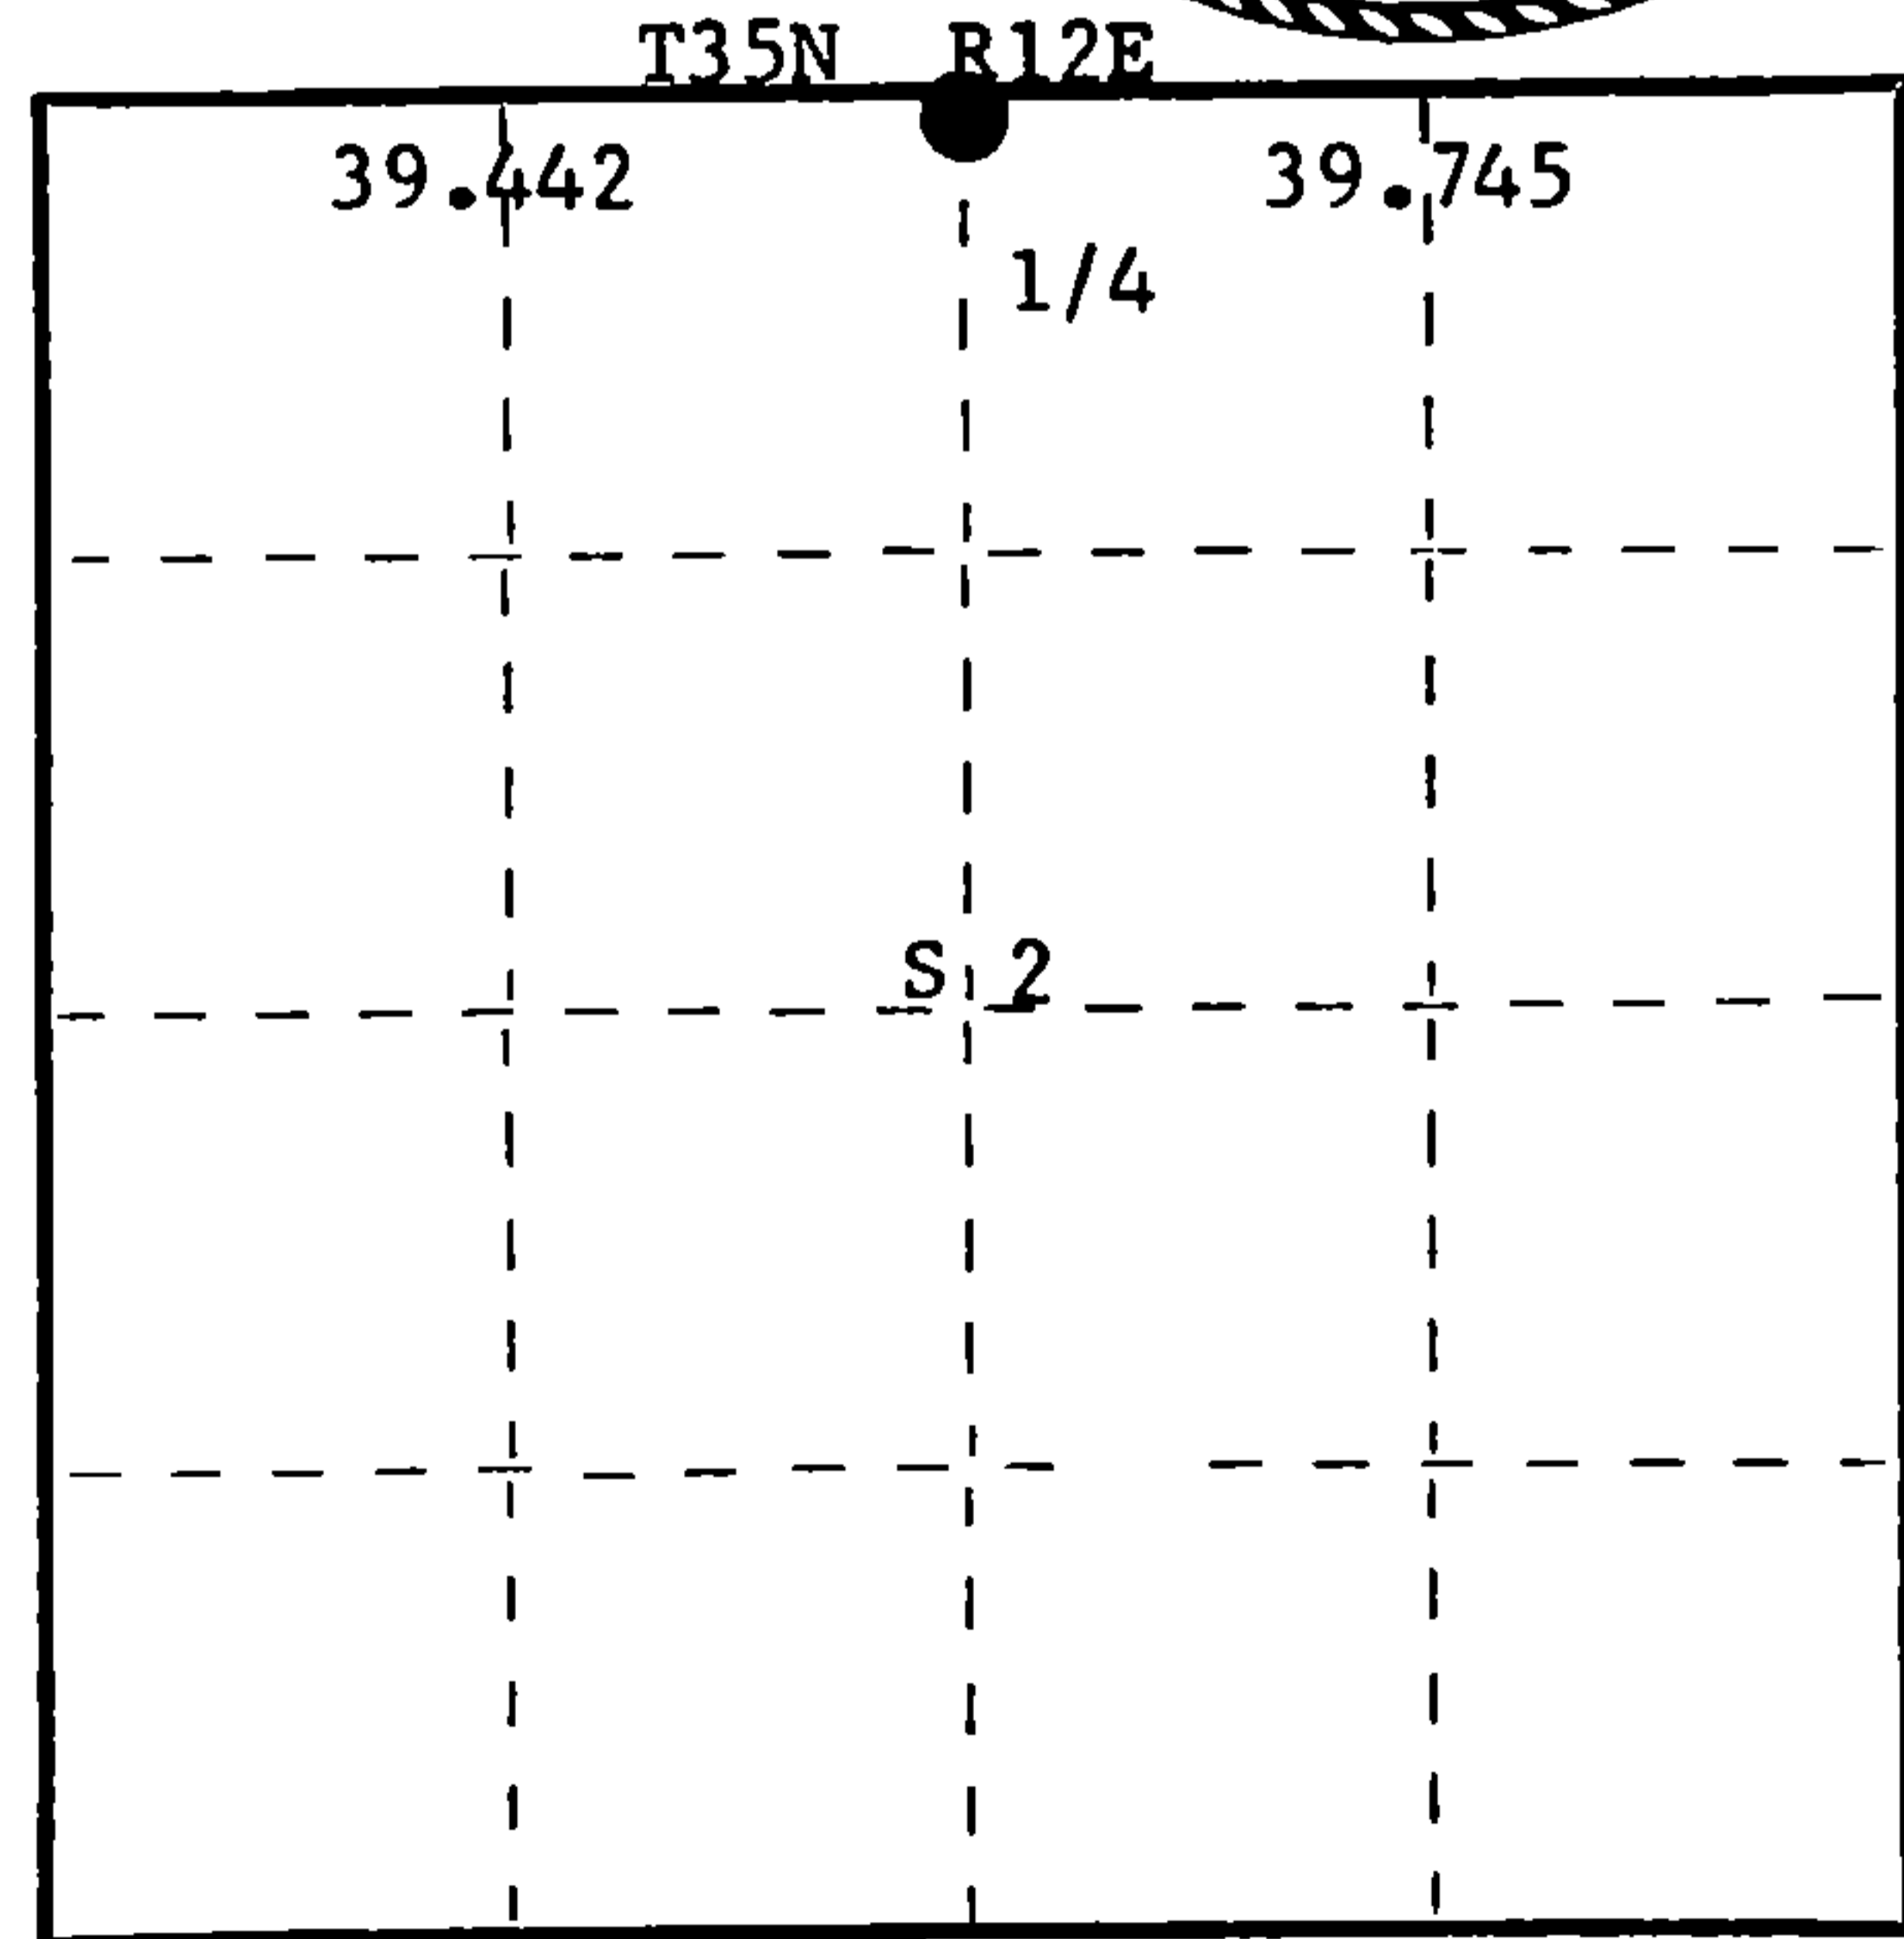

○ = Corner monument restored.

History of original corner establishment:

Original corner established by A. Curtiss, Deputy Surveyor, in 1858, from which Elm 15" bears N82°W, 10 links and Lynn 12" bears S83°E, 19 links.

No records on file for any subsequent survey.

Description of corner evidence found:

Corner established by traverse and computation using measured distance from Section Corner 35, 36, 1 & 2 to E 1/16 corner Section 35 and 2, 1311.579 feet, doubled distance to locate the 1/4 corner at 2623.158, S 89° 00' 07" W of section corner. At the determined distance, old rock fence recovered in line north.

Description of monument and accessories I established to perpetuate the original location of this corner.

Set a 1 1/2" x 18" iron pipe on the north edge of Sipple Road for true corner, 5" below surface. Set a 2 1/2" Berntsen A-1 Federal Monument 70 links south for a witness corner. Stamped: Monument projects 2' above ground.

Marked NBTs - Sugar 10" S28°W, 90.3 links.  
Sugar 8" S46°W, 82.7 links.  
Yellow birch 7" S29°E, 83.7 links.

Measurements and bearings made from true corner.

T36N R12E  
1/4 S 35/2 W.C. 1977  
T35N R12E  
N 70 lks to Cor.  
S-498

Dated at Rhineland, Wis., this 2nd day of August, 1977

Signature *Philip T. Hansen* Title Registered Land Surveyor Registration No. S-498  
(County Surveyor, Registered Land Surveyor, or other duly authorized official)

Office of Register of Deeds, County of Forest, I hereby certify that the within instrument was filed in this office for record on the 22nd day of AUGUST, 1977 at 3:30 o'clock P.M.

*Eugene Stutz*  
(Register of Deeds)

By \_\_\_\_\_ Deputy

DOCUMENT NUMBER 112152

4361235 opp