

CERTIFIED LAND CORNER RESTORATION


Index No. **E 23**

State of Wisconsin }  
County of Forest } ss.

I Thomas R. Arnott, do hereby certify that on the 13 day of Nov., 1976, I found evidence of the 1/4 corner of sec. 1 & 12 Township 36, North, Range 13 E, Fourth Principal Meridian, as described hereon; and that from this evidence I established a new monument and accessories as described hereon to perpetuate the original location of this corner.

Resident witnesses:  
.....  
.....  
.....

FORM 985 H. C. MILLER CO., MILWAUKEE

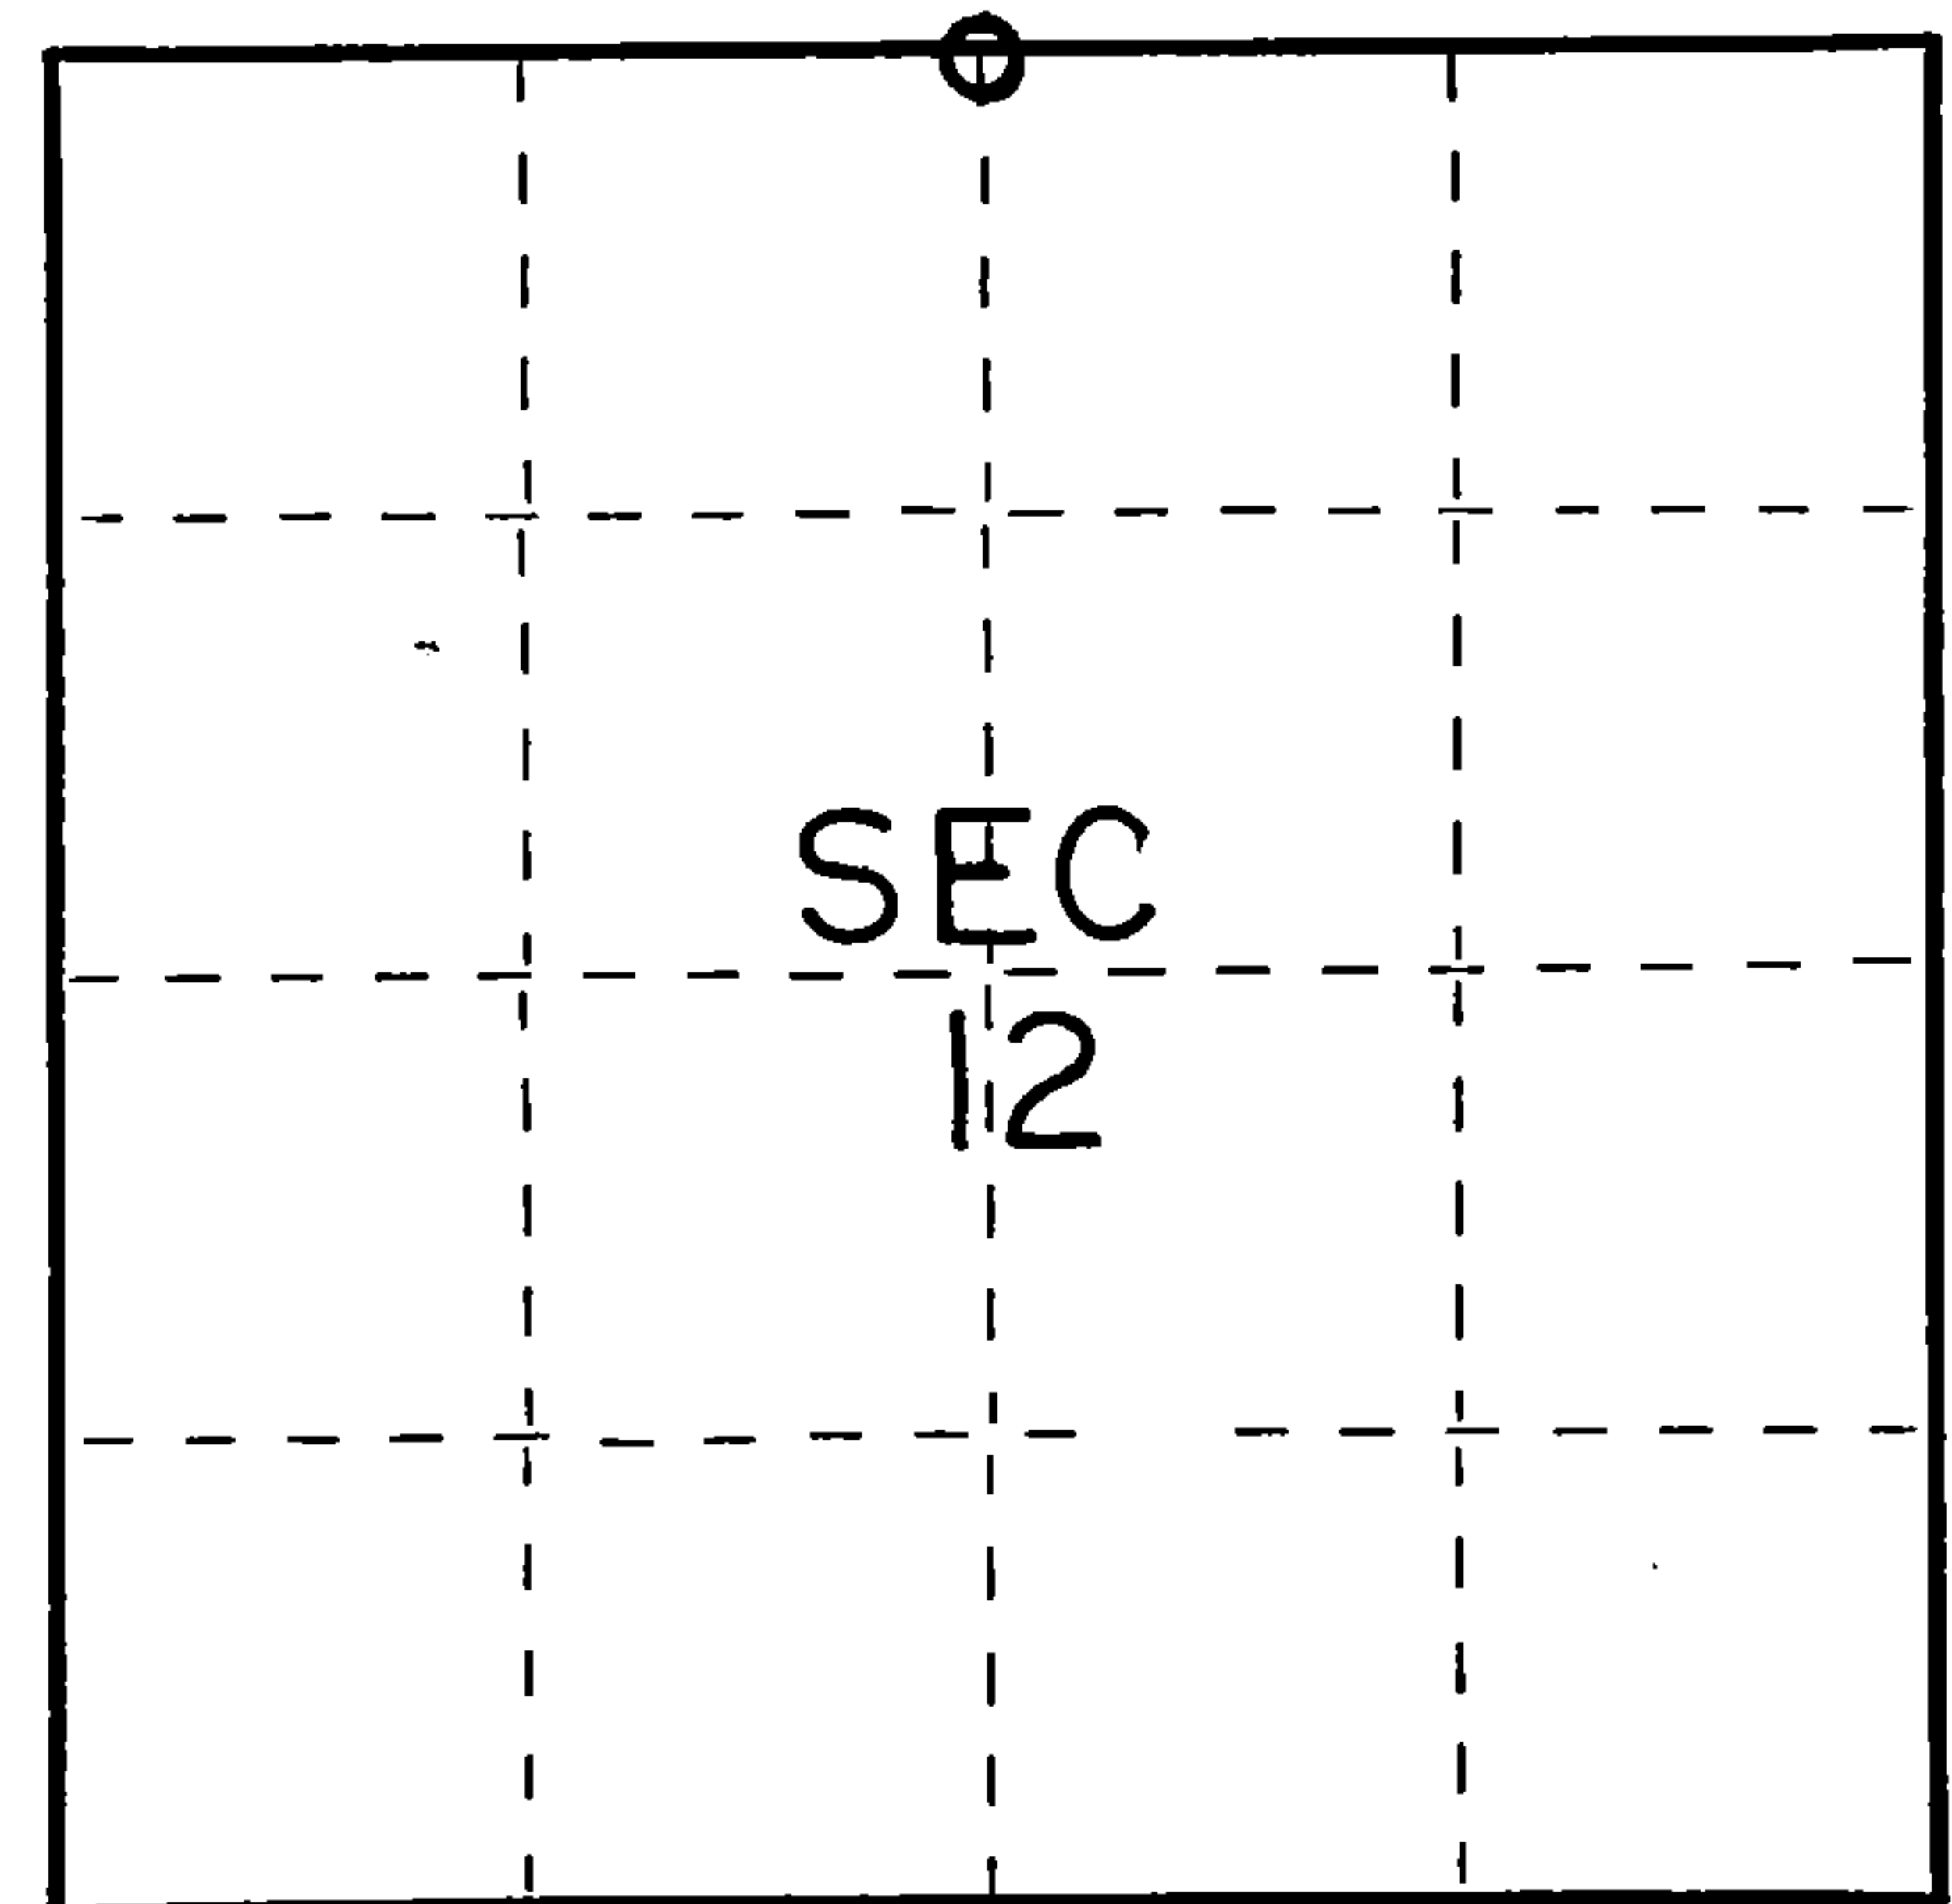

○ = Corner monument restored.

History of original corner establishment:

Original survey by James L. Nowlin June 2 - June 12, 1865

Cedar 10 N13E 12 Lks.  
Cedar 8 S70W 8 Lks.

Description of corner evidence found:

2" iron pipe 5' long with brass cap set by C.E. Walker in 1938.

Description of monument and accessories I established to perpetuate the original location of this corner.

Left monument set by Walker.

Ties:

W. Birch 10 S73W 46.25 feet  
Poplar 10 S24E 36.38 feet



Dated at Crandon, Wis., this 30 day of Nov., 19 76.

Signature Thomas R. Arnott Title Surveyor Registration No. S-887  
(County Surveyor, Registered Land Surveyor, or other duly authorized official)

Office of Register of Deeds, County of Forest, I hereby certify that the within instrument was filed in this office for record on the 30 day of Nov., 19 76 at 11:30 o'clock A. M.

Eugene Stutzman (Register of Deeds) Document Number **110637**

By \_\_\_\_\_ Deputy

43613010020