

CERTIFIED LAND CORNER RESTORATION


Index No. **G 21**

State of Wisconsin }  
County of Forest } ss.

I Thomas R. Arnott, do hereby certify that on the 6 day of Nov., 1976, I found evidence of the 1/4 corner of sec. 11 & 12 Township 36, North, Range 13 E, Fourth Principal Meridian, as described hereon; and that from this evidence I established a new monument and accessories as described hereon to perpetuate the original location of this corner.

Resident witnesses:

.....  
.....  
.....

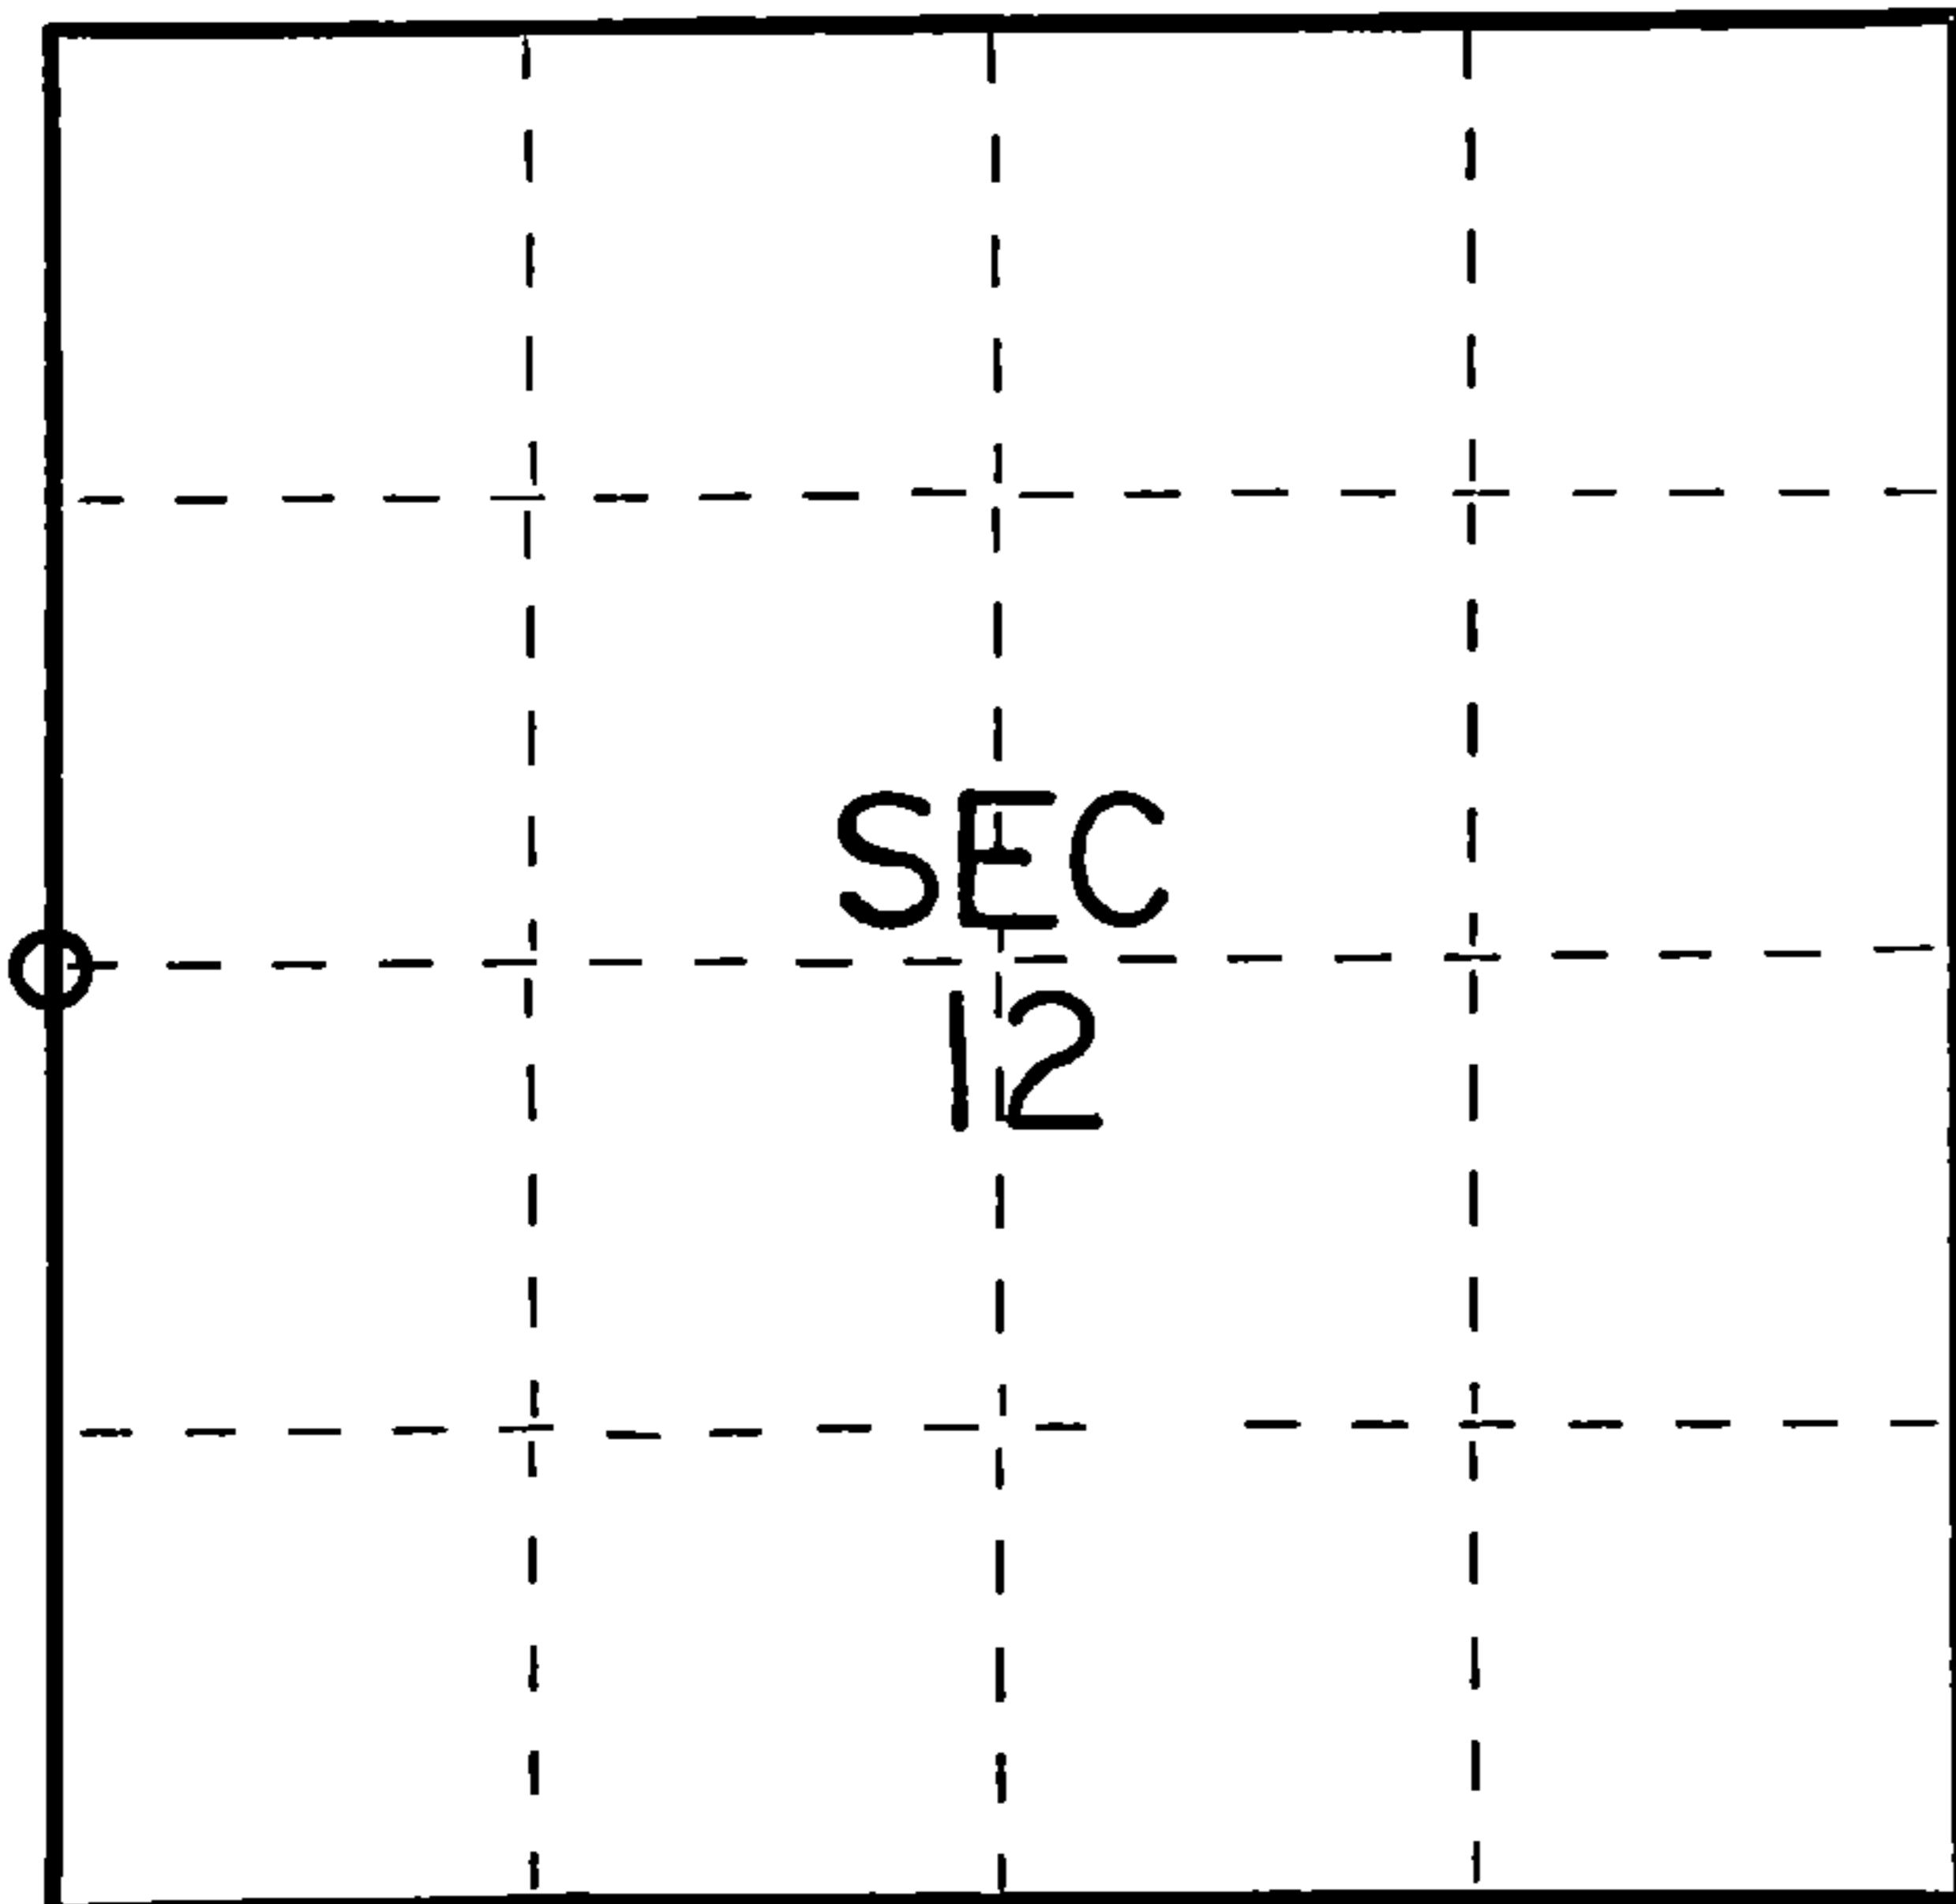

○ = Corner monument restored.

History of original corner establishment:

Original survey by James L. Nowlin June 2 - June 12, 1865

Cedar 8 N22E 5 Lks.  
Cedar 10 N85W 6 Lks.

Description of corner evidence found:


2" iron pipe 5' long with brass cap set by C.E. Walker in 1938.

Description of monument and accessories I established to perpetuate the original location of this corner.

Left monument set by Walker.

Ties:

B. Spruce 6 S56E 8.79 feet  
B. Spruce 4 N33W 13.48 feet

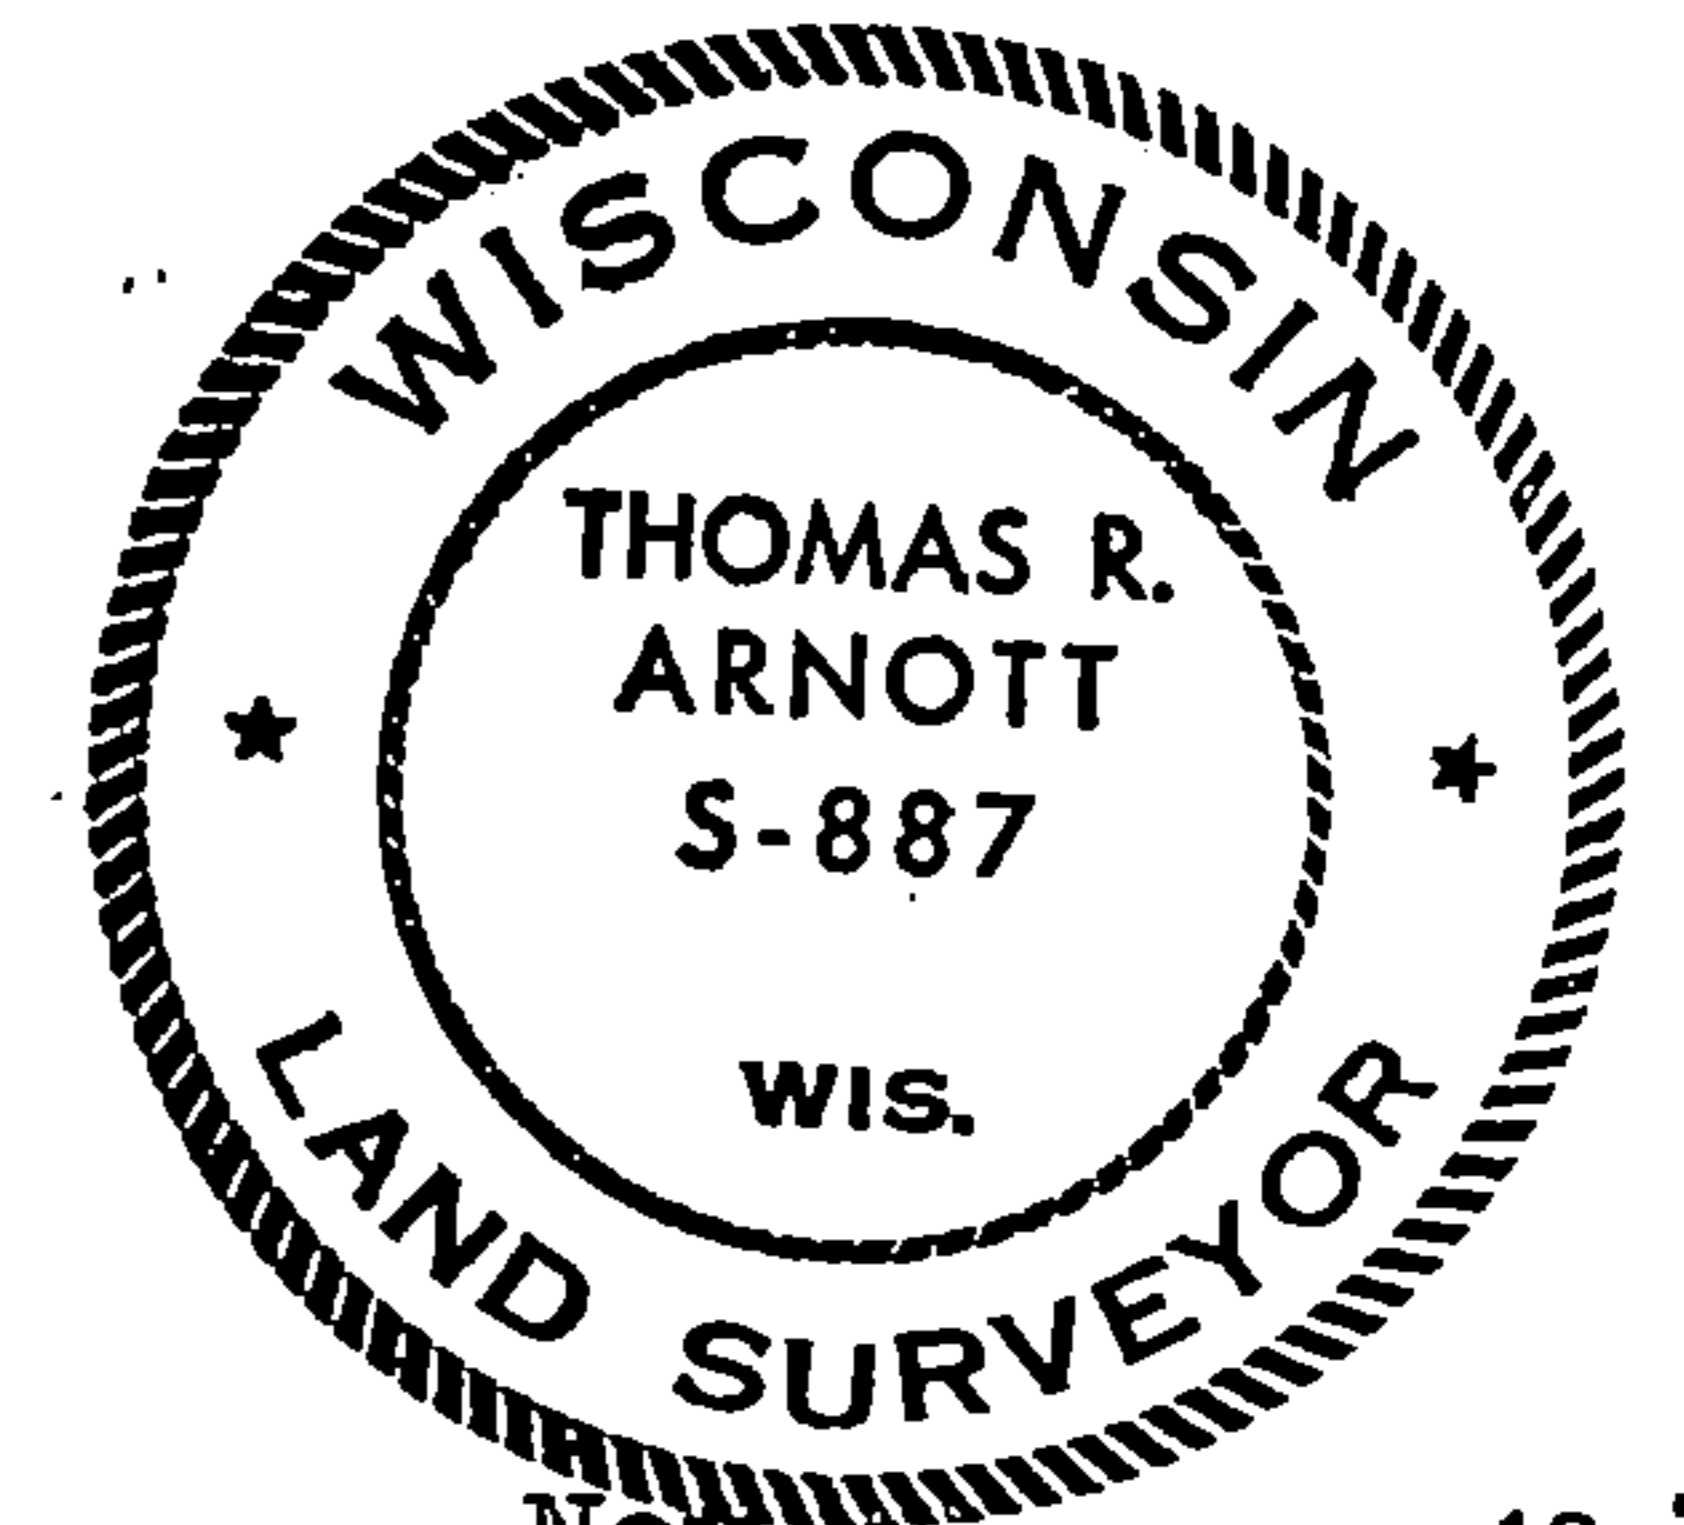

Dated at Grandon, Wis., this 26 day of Nov., 1976.

Signature Thomas Arnott Title Surveyor Registration No. S-887  
(County Surveyor, Registered Land Surveyor, or other duly authorized official)

Office of Register of Deeds, County of Forest, I hereby certify that the within instrument was filed in this office for record on the 26 day of Nov., 1976 at 3:30 o'clock P. M.

EUGENE STATEZNY Document Number **110609**  
(Register of Deeds)

By Eileen Schmidt Deputy

FORM 985 H. C. MILLER CO., MILWAUKEE

4361312000