


CERTIFIED LAND CORNER RESTORATION

Index No **L-21**

State of Wisconsin }  
County of Forest } ss.

I Thomas R. Arnott, do hereby  
certify that on the 12 day  
of Nov., 1976, I found  
evidence of the 1/4  
corner of sec. 13 & 14  
Township 36, North, Range  
13 E, Fourth Principal Meridian,  
as described hereon; and that from this evidence  
I established a new monument and accessories  
as described hereon to perpetuate the original  
location of this corner.

Resident witnesses:

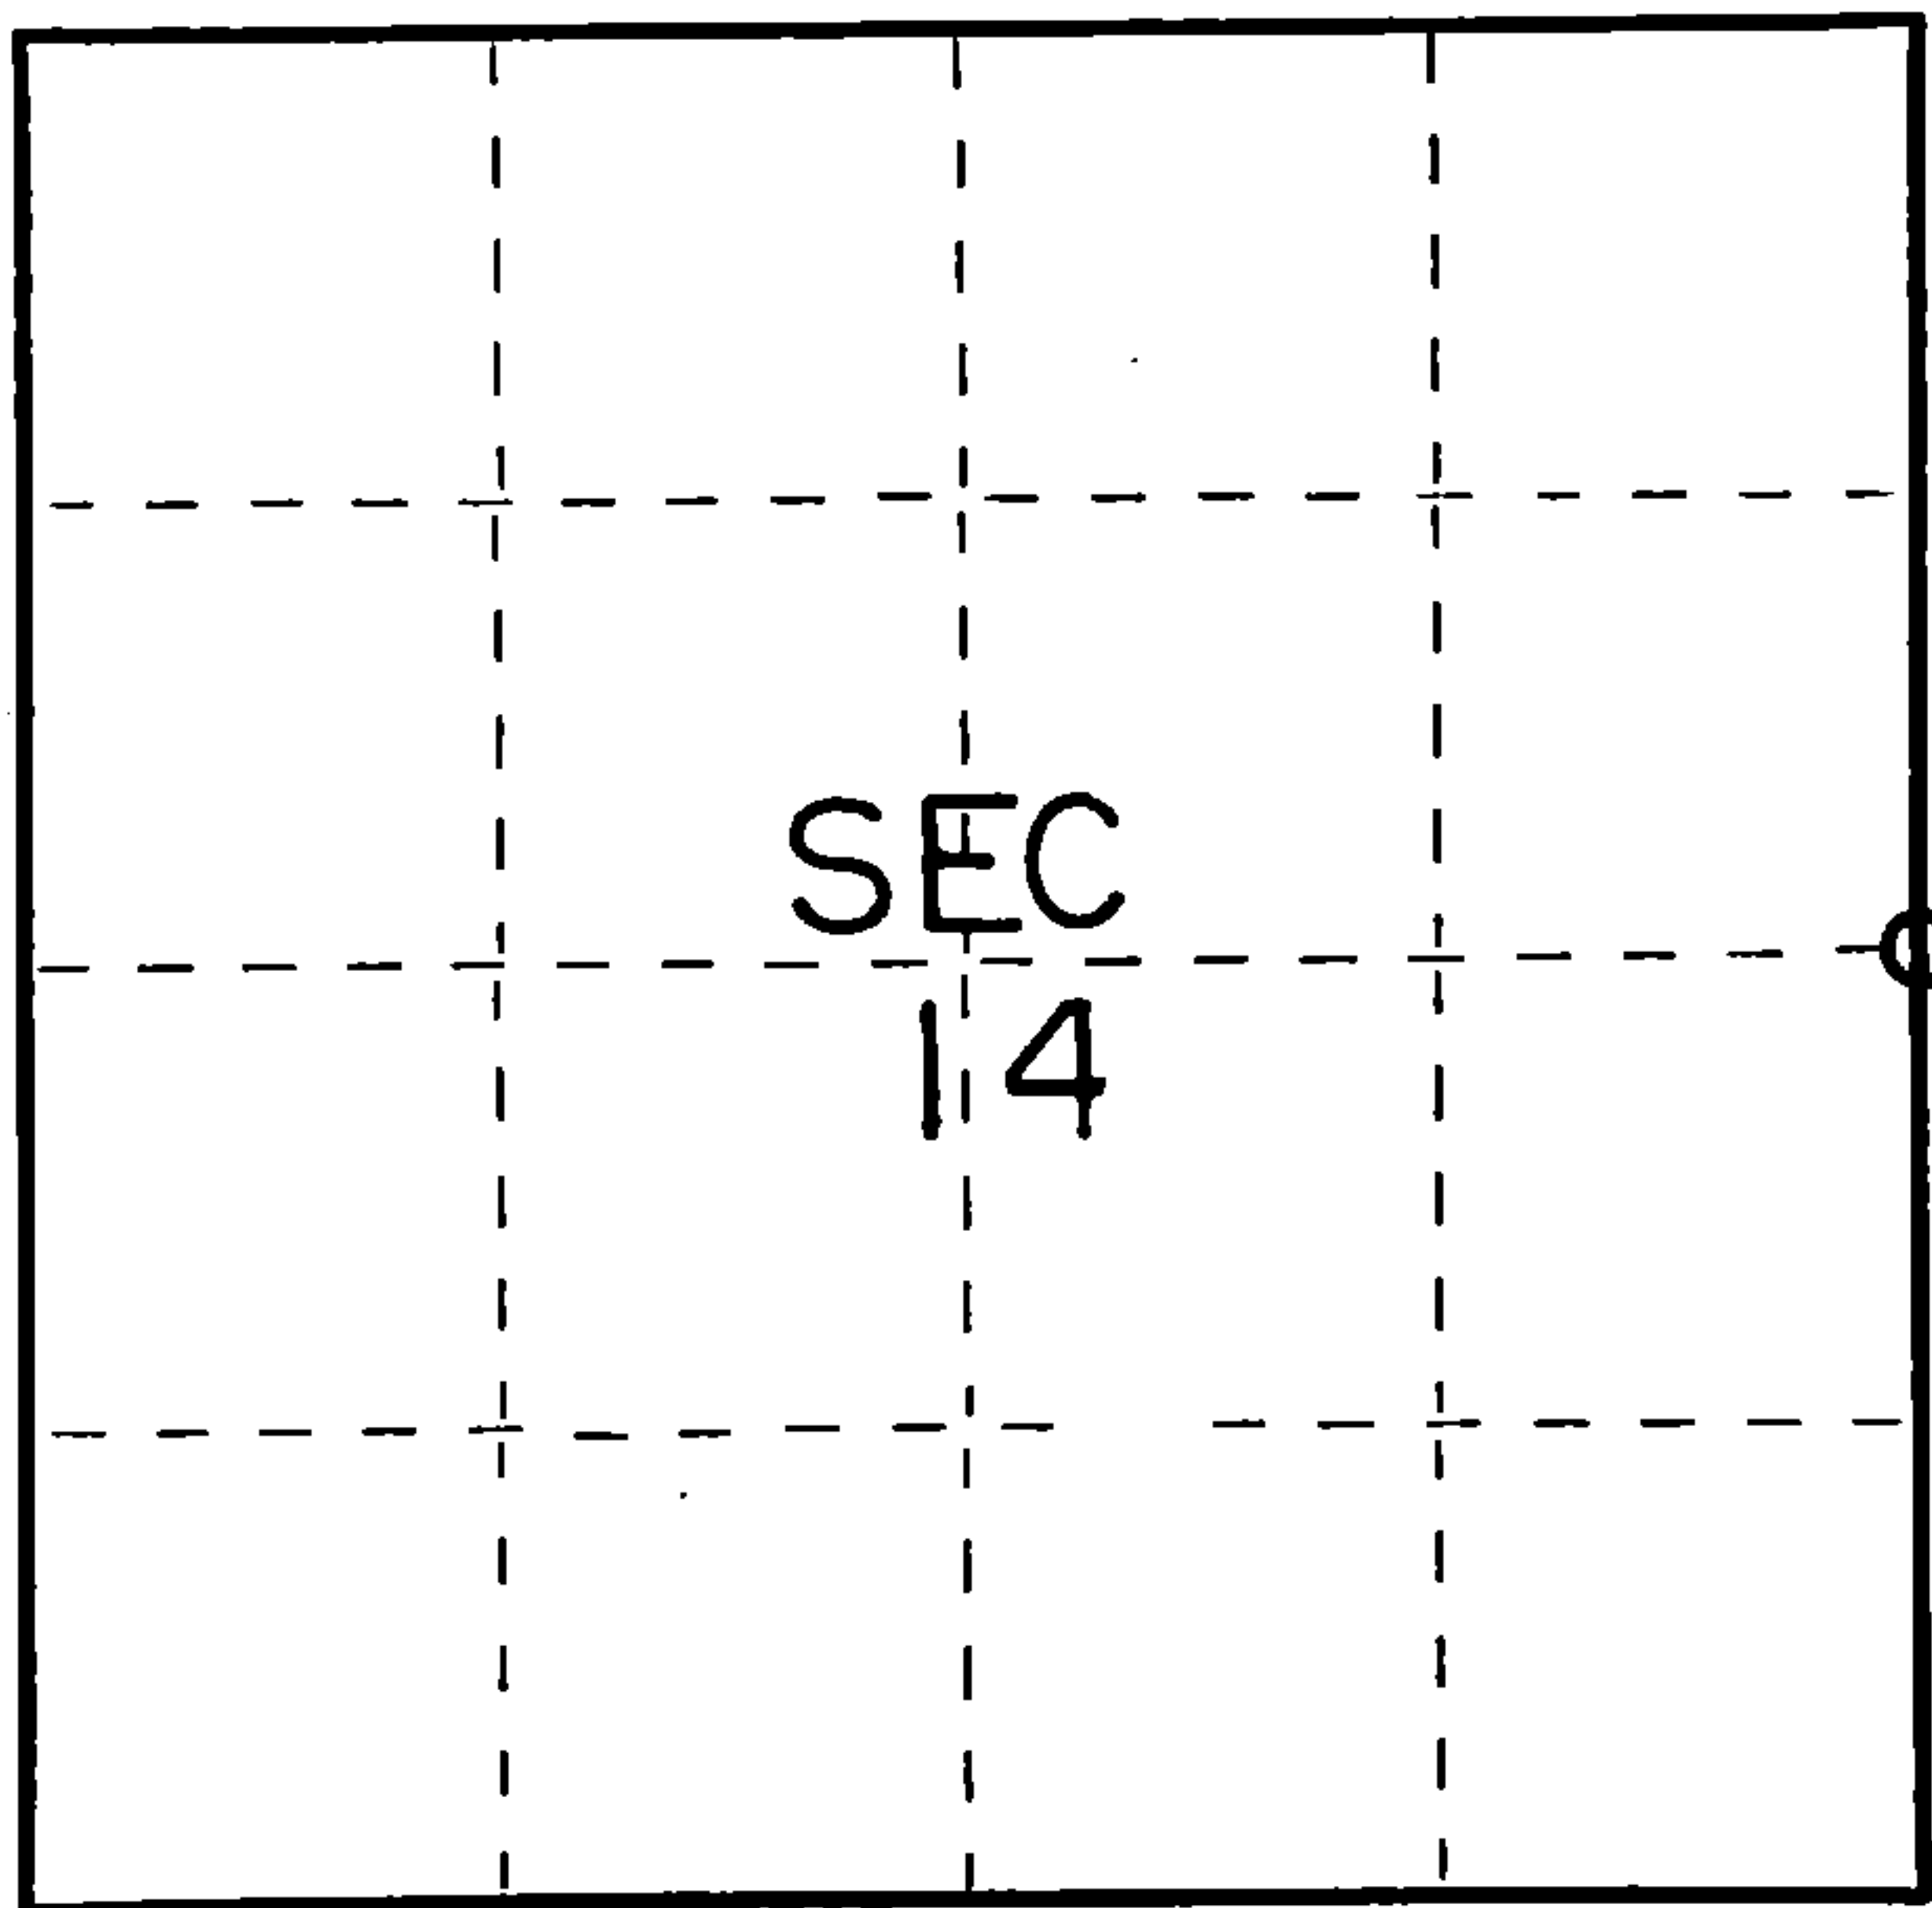

○ = Corner monument restored.

History of original corner establishment:

Original survey by James L. Nowlin June 2 - June 12, 1865

Sugar 12 N37W 25 Lks.  
Birch 20 S29E 15 Lks.

Description of corner evidence found:


2" iron pipe 5' long with brass cap set by C.E. Walker in 1938.

Description of monument and accessories I established to perpetuate the original location of this corner.

Left monument set by Walker.

Ties:

Maple 8 N82W 7.44 feet  
Maple 8 S16W 17.28 feet

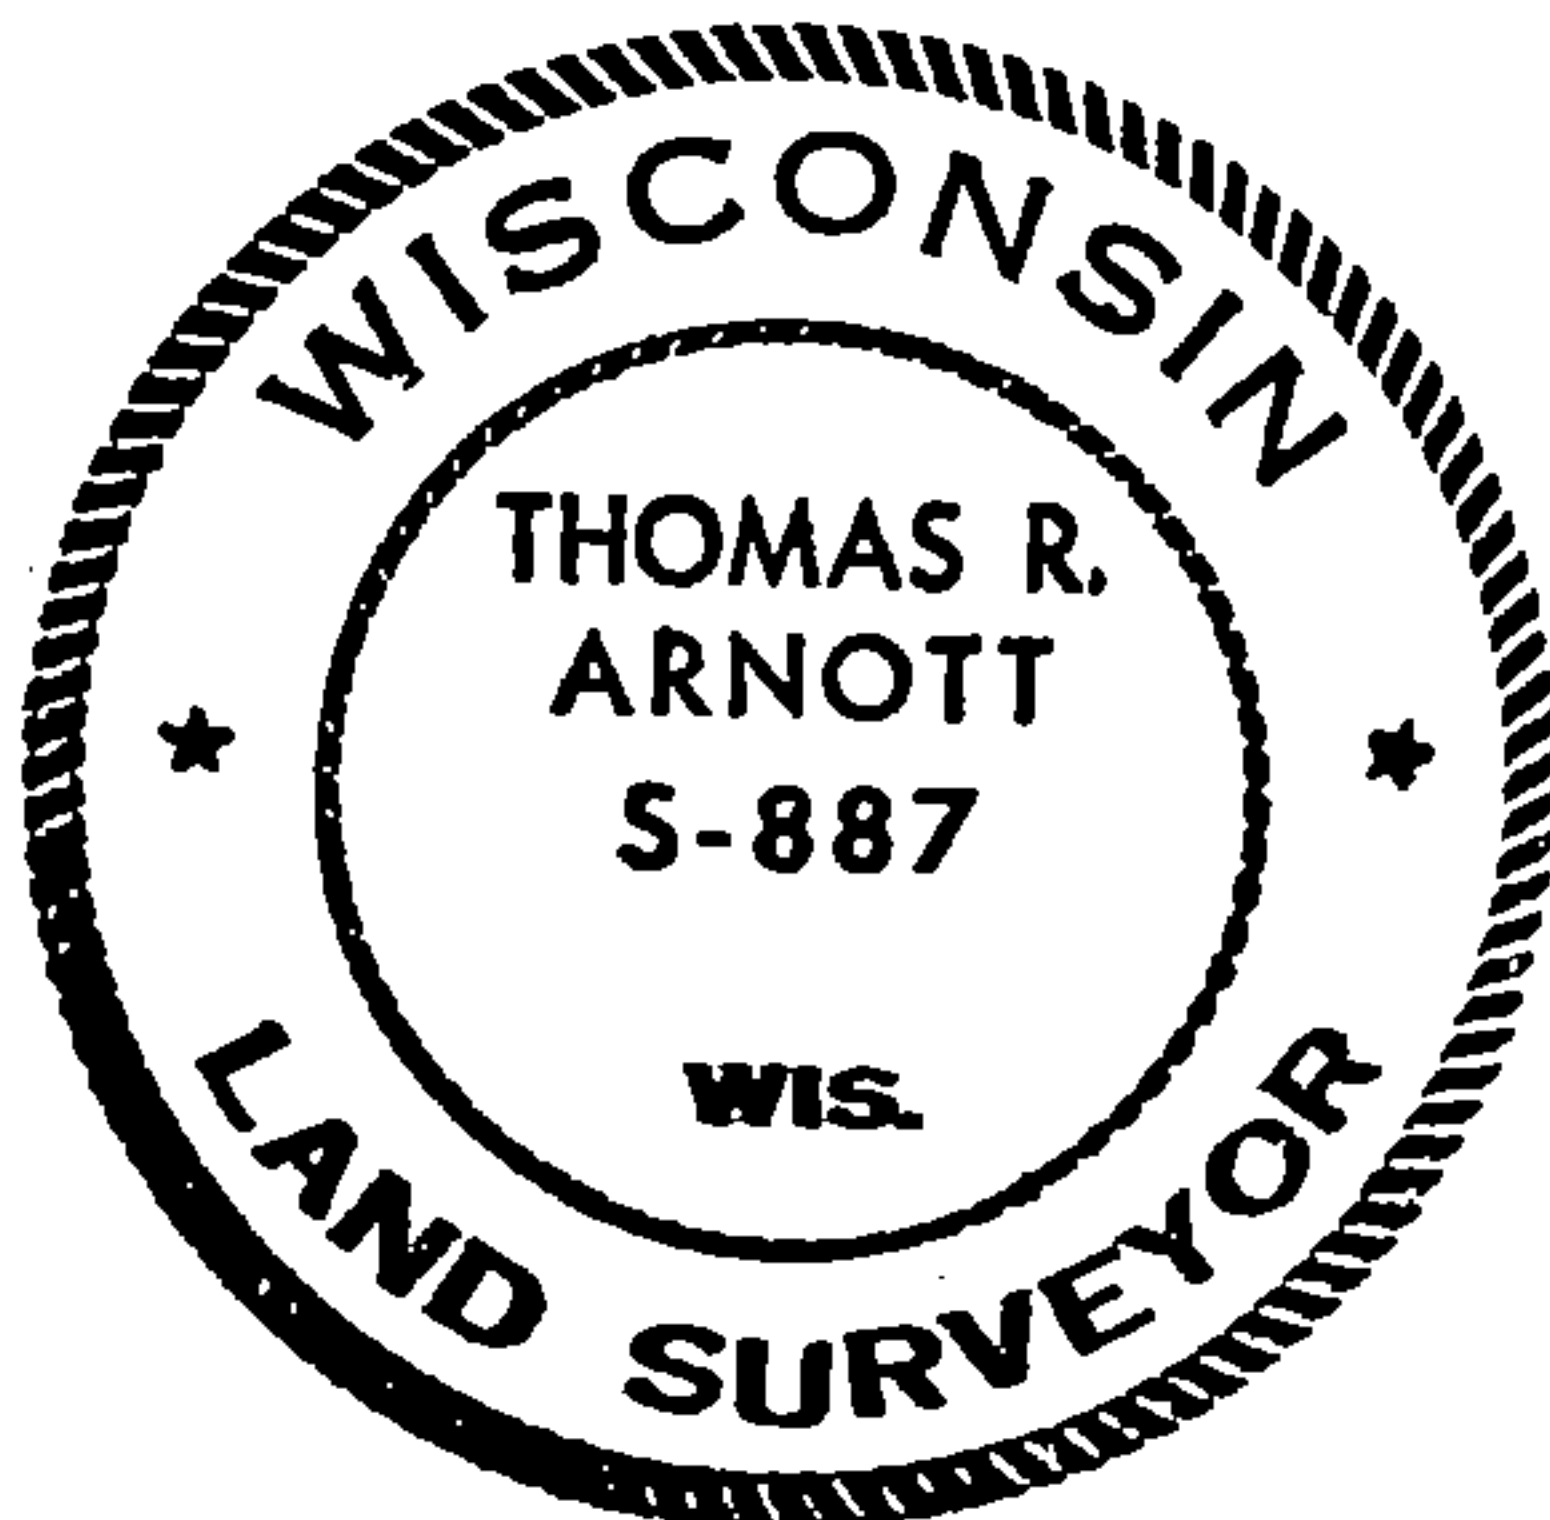

Dated at Crandon, Wis., this 30 day of Nov., 1976.

Signature Thomas R. Arnott Title Surveyor Registration No. S-887  
(County Surveyor, Registered Land Surveyor, or other duly authorized official)

Office of Register of Deeds, County of Forest, I hereby certify that the within  
instrument was filed in this office for record on the 30 day of Nov., 1976  
at 11:30 o'clock A. M.

Eugene Stetson Document Number **110638**  
(Register of Deeds)

By \_\_\_\_\_ Deputy

FORM 985 H. C. MILLER CO., MILWAUKEE

43613142000