


CERTIFIED LAND CORNER RESTORATION

Index No. **L-13**

State of Wisconsin }
County of Forest } ss.

I Thomas R. Arnott, do hereby
certify that on the 9th day
of September, 19 75, I found
evidence of the 1/4
corner of sections 15 & 16
Township 36, North, Range
13 E, Fourth Principal Meridian,
as described hereon; and that from this evidence
I established a new monument and accessories
as described hereon to perpetuate the original
location of this corner.

Resident witnesses:
Herbert Wagoner

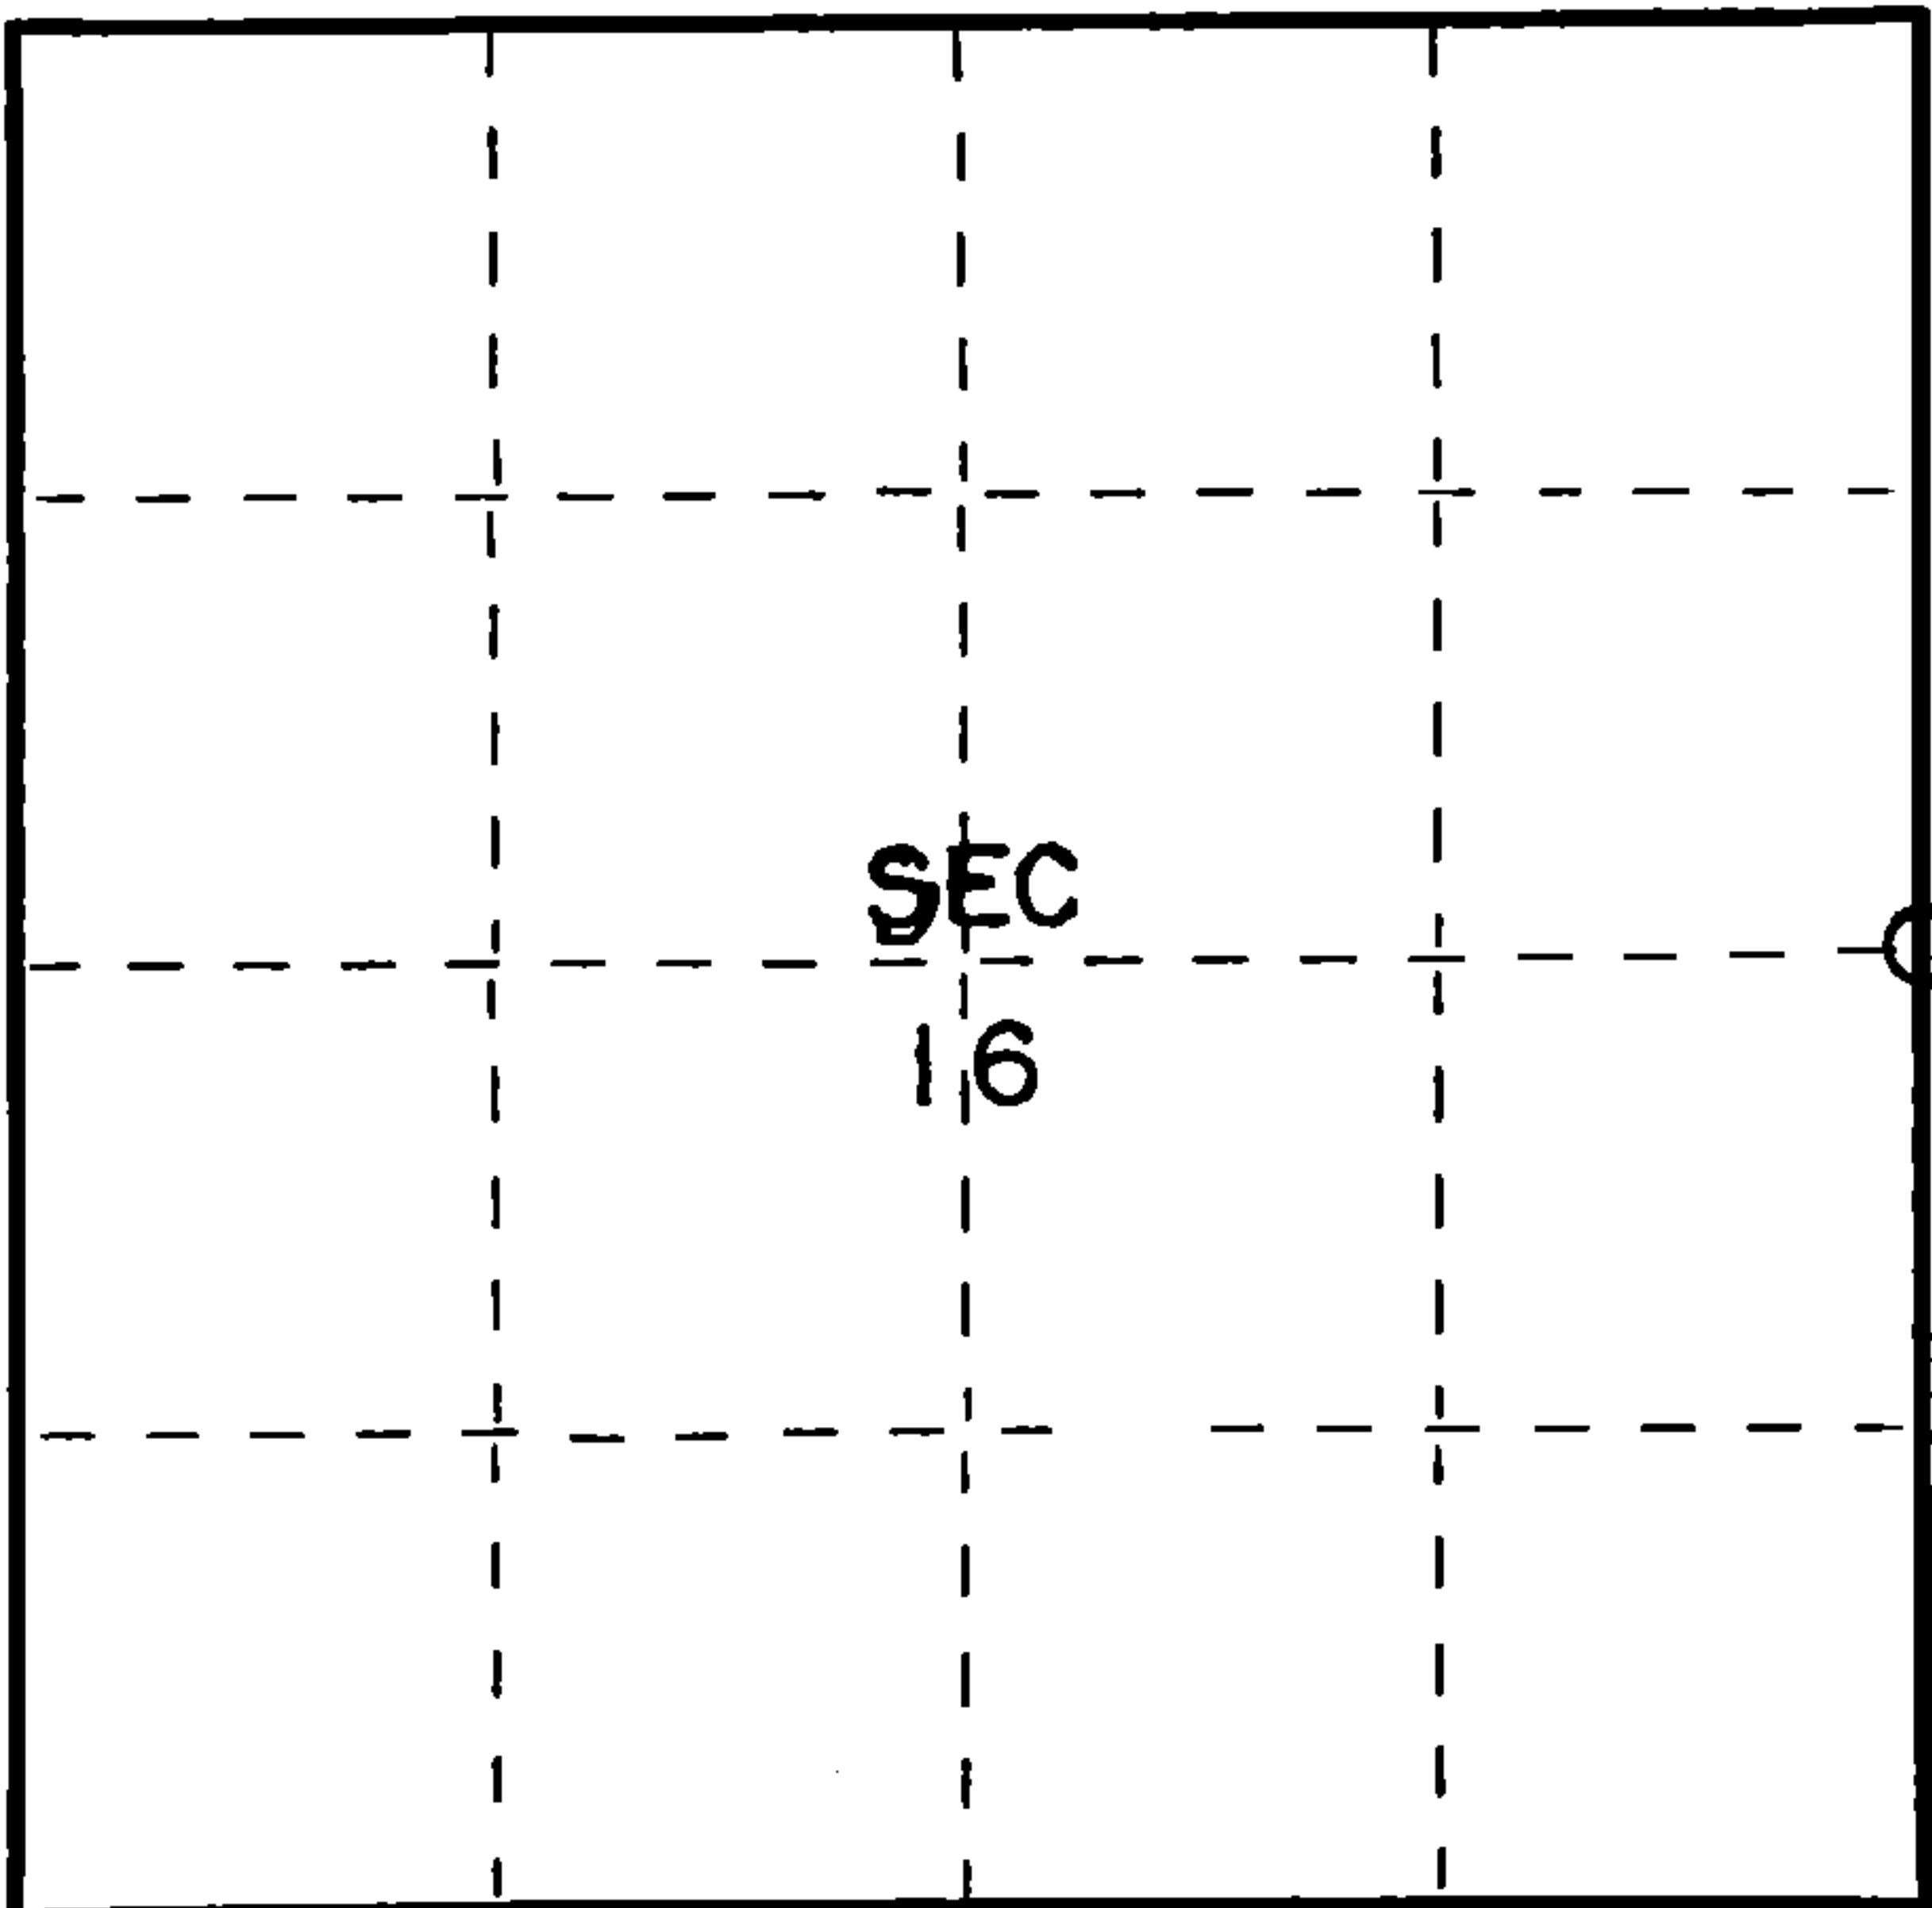

○ = Corner monument restored.

History of original corner establishment:

Original subdivision by James L. Nowlin June 2 - June 12, 1865

Sugar	12	S25W	12 Lks.
Fir	12	N20E	13 Lks.

Description of corner evidence found:


2" iron pipe with brass capp set by C.E. Walker in 1938

Description of monument and accessories I established to perpetuate the original location of this corner.

Left monument set by Walker

Ties:

Maple	18"	S64E	22.85 feet
Maple	20"	N80W	6.65 feet

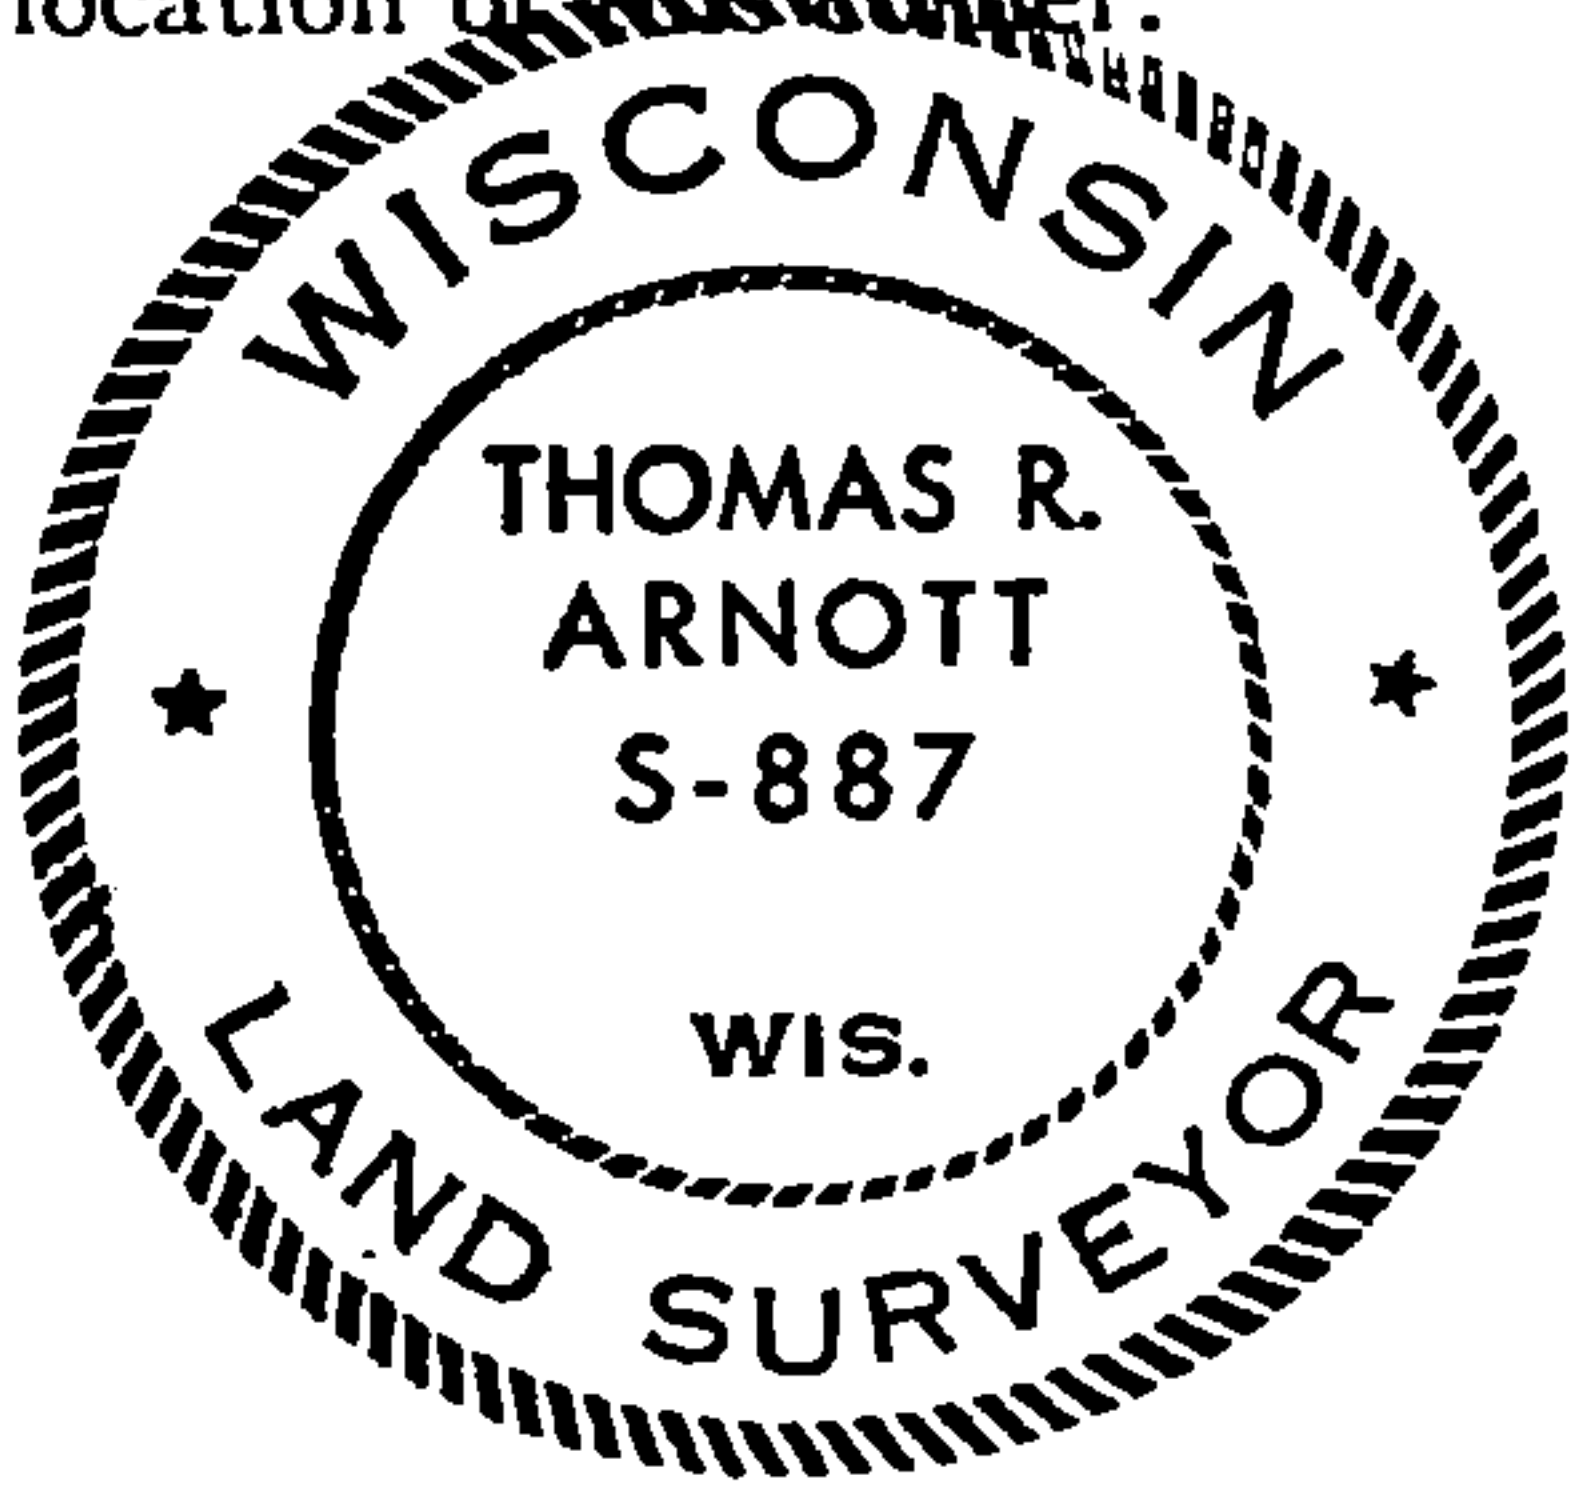

Dated at Crandon, Wis., this 11th day of November, 1975

Signature Thomas R. Arnott Title Land Surveyor Registration No. S-887
(County Surveyor, Registered Land Surveyor, or other duly authorized official)

Office of Register of Deeds, County of Forest, I hereby certify that the within
instrument was filed in this office for record on the 11th day of November, 19 75
at 4 o'clock P. M.

Eugene Staszny Document Number **108206**
(Register of Deeds)
By _____ Deputy