

CERTIFIED LAND CORNER RESTORATION


Index No. R-15

State of Wisconsin }  
County of Forest } ss.

I Thomas R. Arnott, do hereby  
certify that on the 8th day  
of September, 19 75, I found  
evidence of the 1/4  
corner of 22 & 27  
Township 36, North, Range  
13 E, Fourth Principal Meridian,  
as described hereon; and that from this evidence  
I established a new monument and accessories  
as described hereon to perpetuate the original  
location of this corner.

Resident witnesses:

Herbert Wagoner

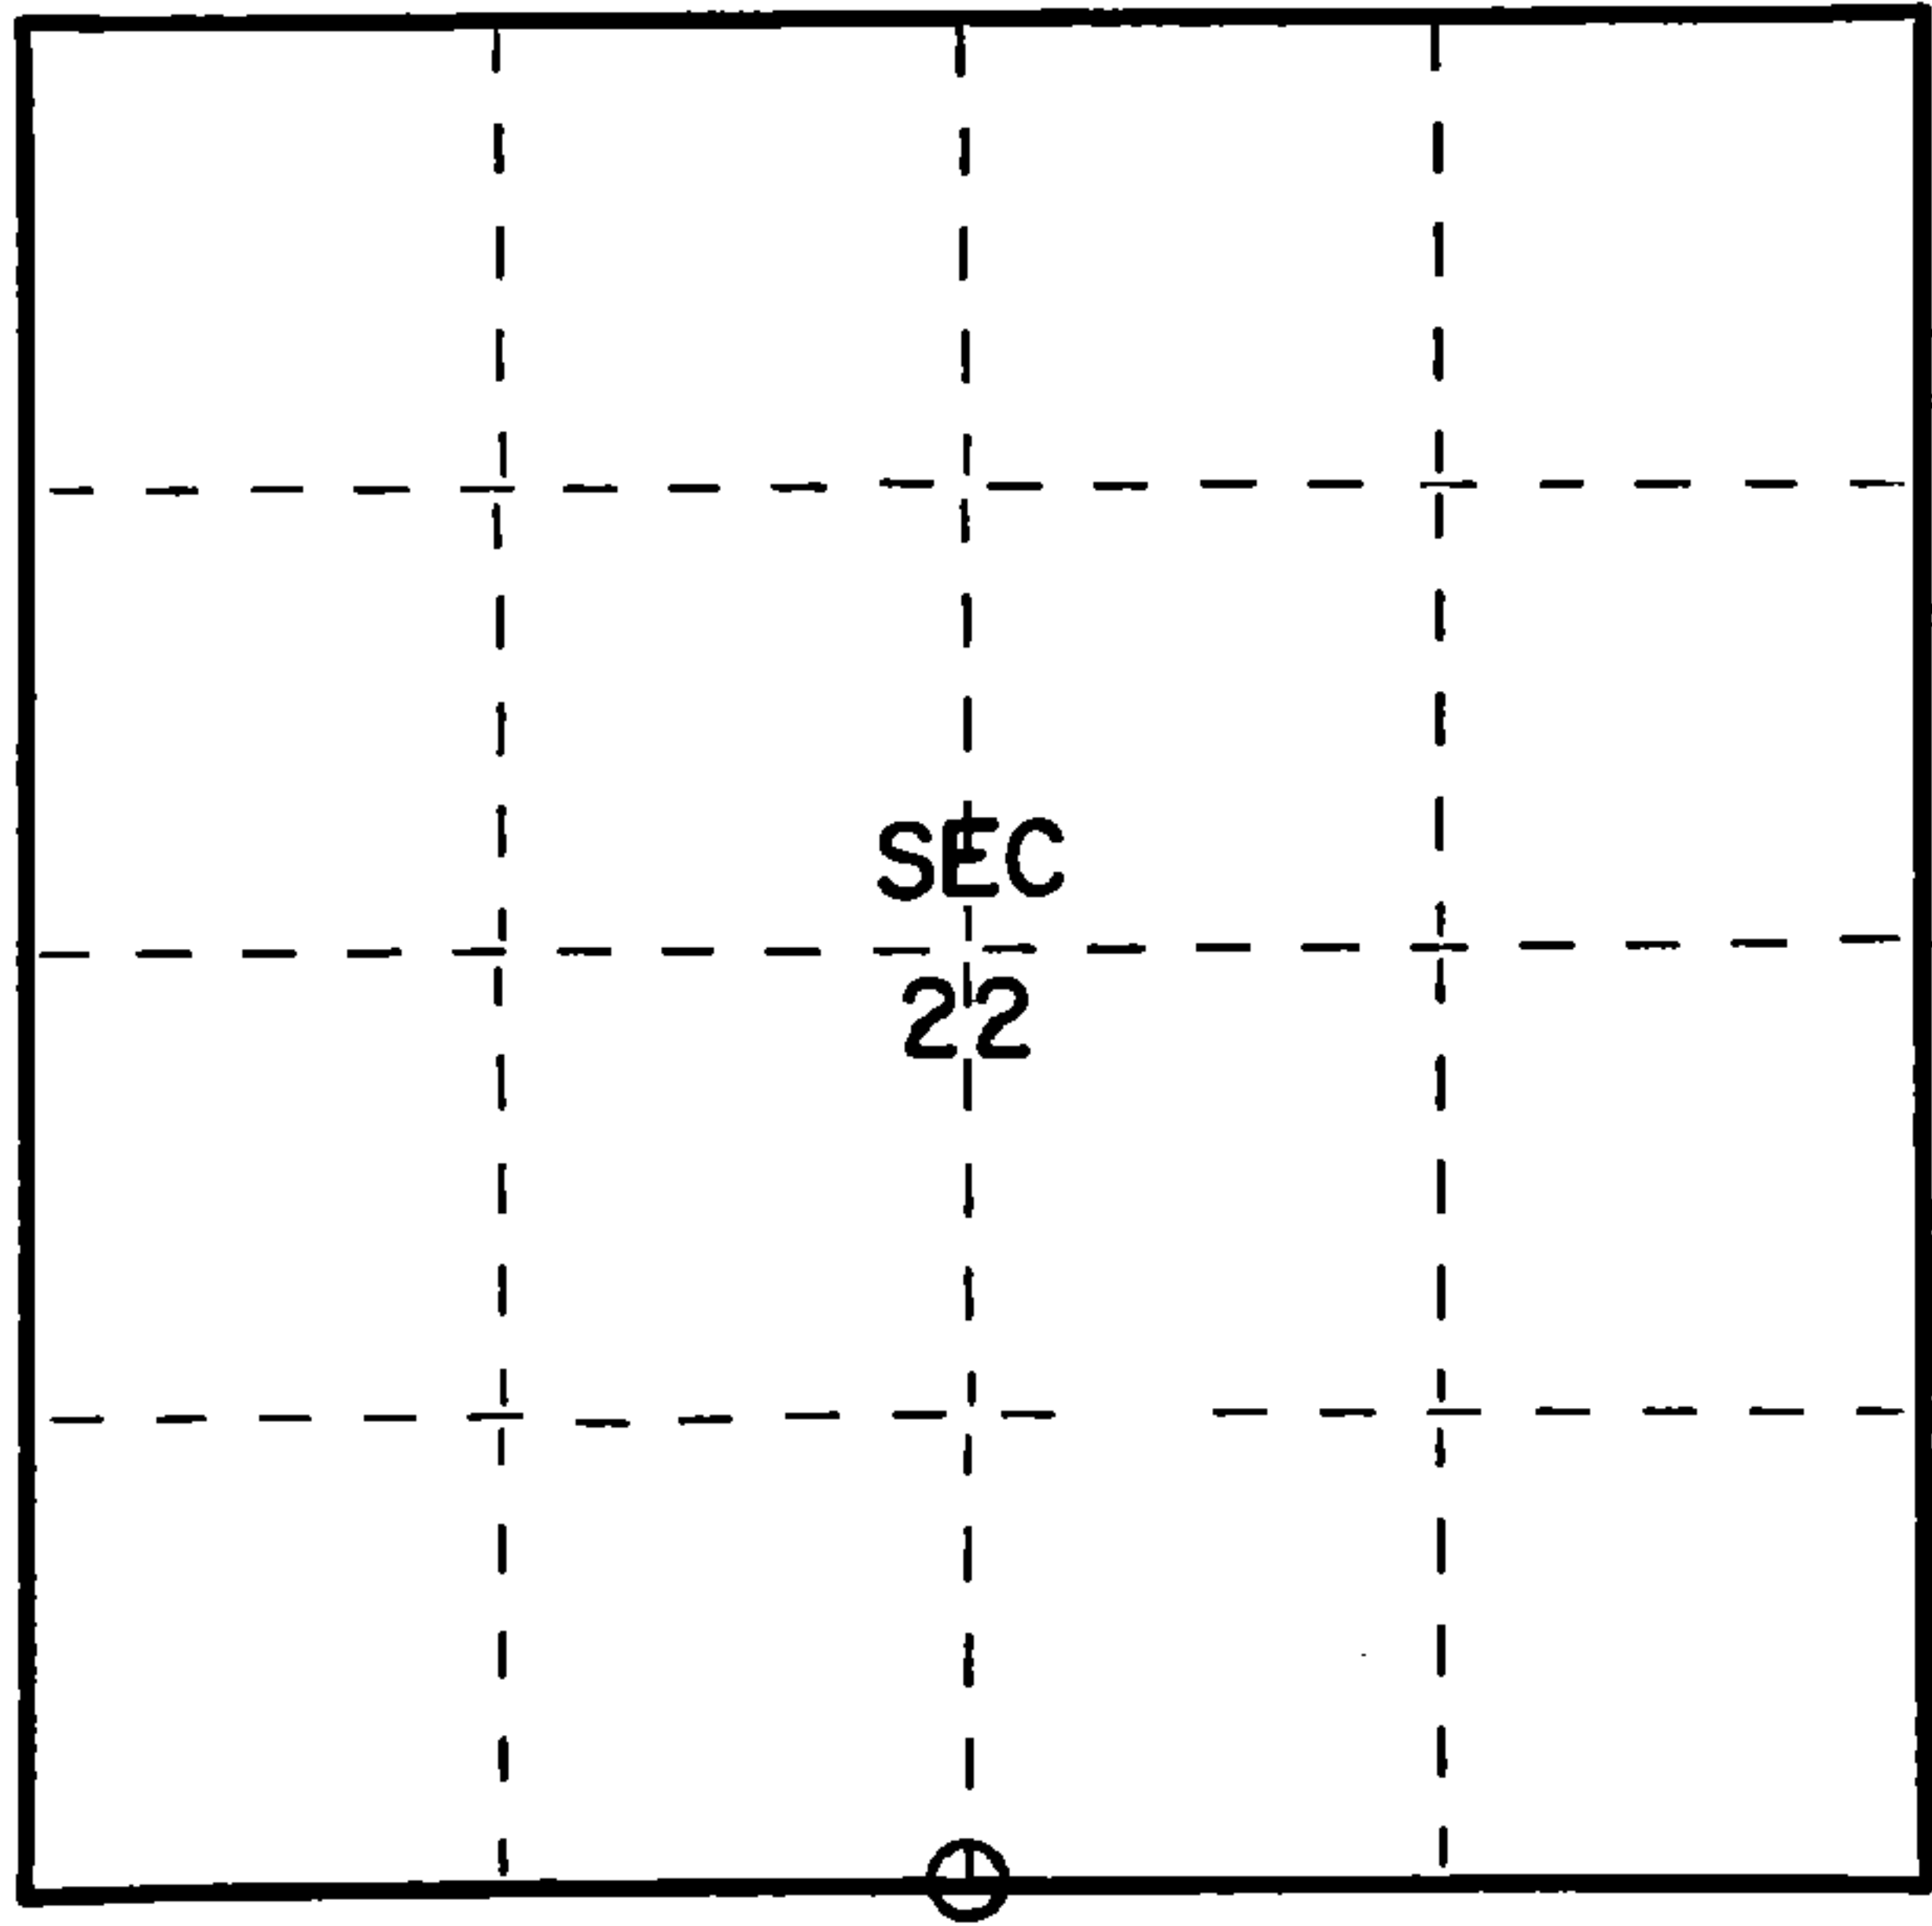

○ = Corner monument restored.

History of original corner establishment:

Original subdivision by James L. Nowlin June 2 - June 12, 1865

Tamarack 10 N7W 10 Lks.  
Tamarack 6 S30E 15 Lks.

Description of corner evidence found:


2" iron pipe 5' long with brass cap set by C.E. Walker in 1938.  
Also found old wood post.

Description of monument and accessories I established to perpetuate the original location of this corner.

Left monument set by Walker

Ties:

Hemlock 12" N48W 31.28 feet  
Hemlock 14" S72W 29.15 feet

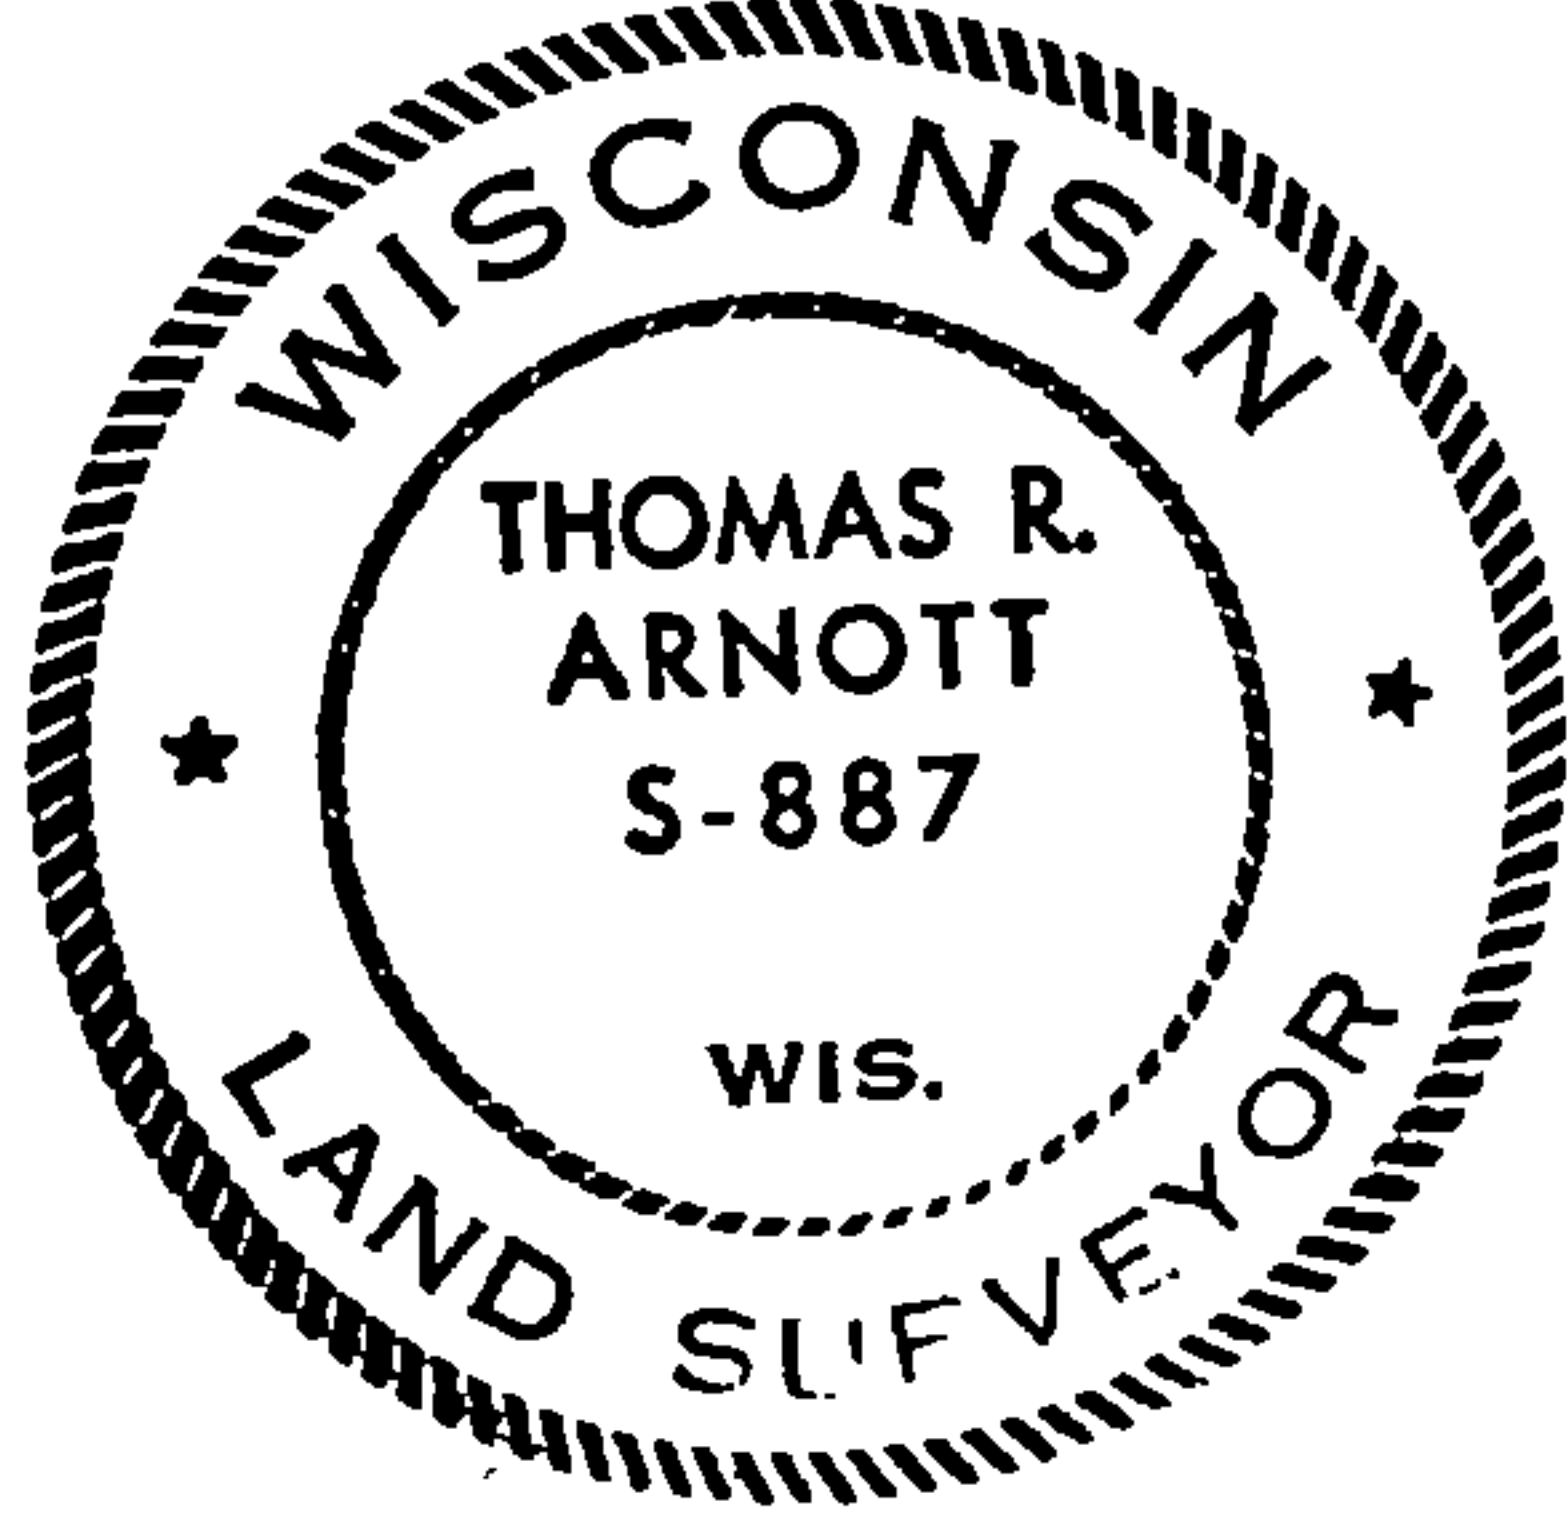

Dated at Crandon, Wis., this 24th day of October, 19 75

Signature Thomas R. Arnott Title Land Surveyor Registration No. S-887  
(County Surveyor, Registered Land Surveyor, or other duly authorized official)

Office of Register of Deeds, County of Forest, I hereby certify that the within  
instrument was filed in this office for record on the 27th day of October, 19 75  
at 8:30 o'clock A.M.

Eugene Stetson  
(Register of Deeds)

Document Number **108060**

By \_\_\_\_\_ Deputy

FORM 985 H. C. MILLER CO., MILWAUKEE

43613220020