

CERTIFIED LAND CORNER RESTORATION

Index No. **P 17**

State of Wisconsin }
County of Forest } ss.

History of original corner establishment:

Original subdivision by James L. Nowlin June 2 - June 12, 1938

I Thomas R. Arnott, do hereby certify that on the 8th day of September, 1975, I found evidence of the 1/4 corner of sections 22 & 23 Township 36, North, Range 13 E, Fourth Principal Meridian, as described hereon; and that from this evidence I established a new monument and accessories as described hereon to perpetuate the original location of this corner.

Birch 15 N30E 10 Lks.
Birch 10 N33W 33 Lks.

Description of corner evidence found:

2" iron pipe 5' long with brass cap set by C.E. Walker in 1938

Resident witnesses:


Herbert Wagoner

Description of monument and accessories I established to perpetuate the original location of this corner:


Left monument set by Walker

Ties:

Maple 10" N33W 9.40 feet
Maple 8" N19E 19.50 feet

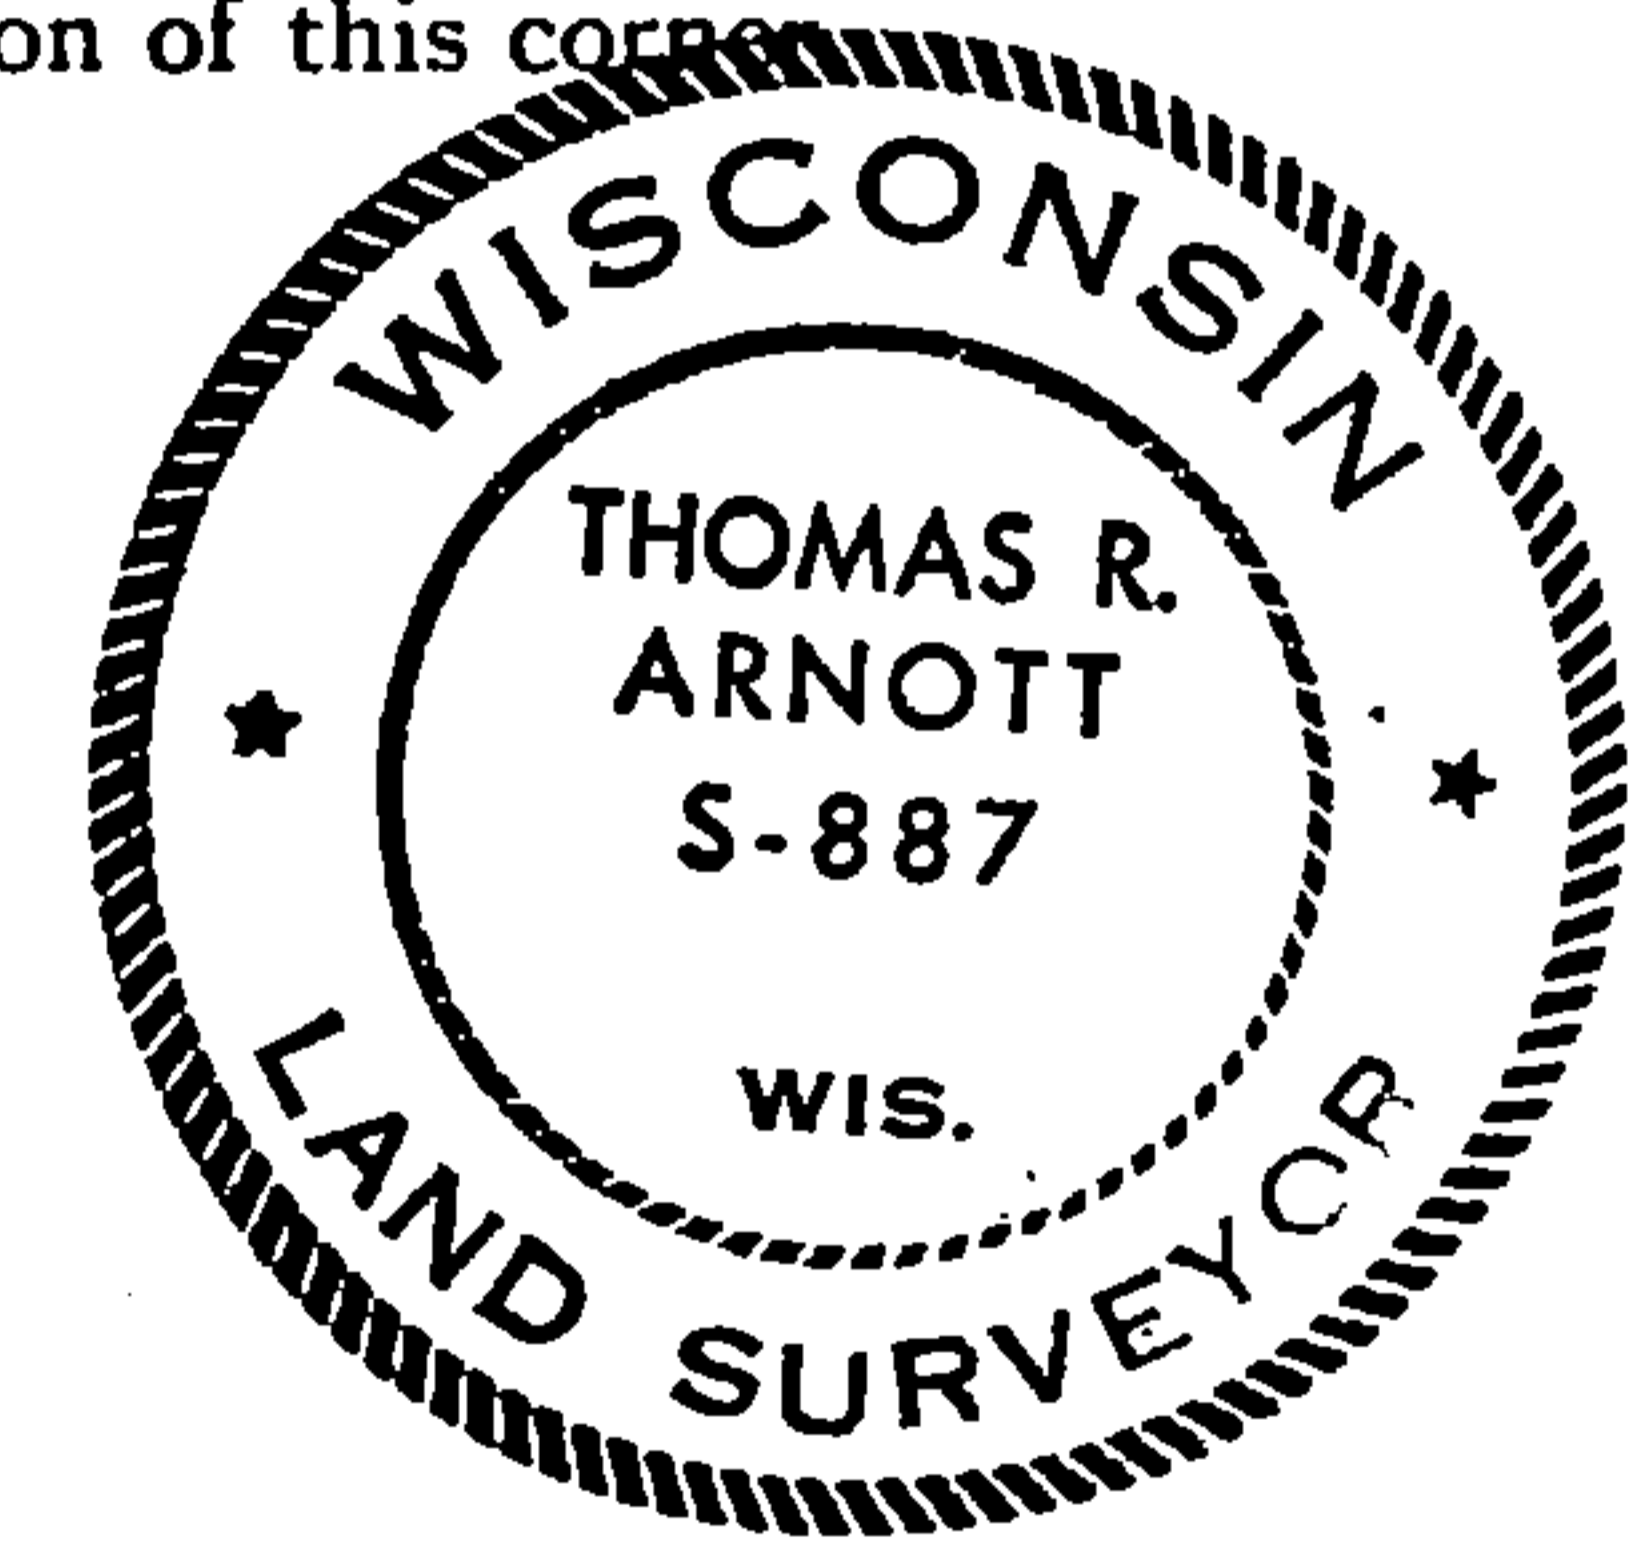

FORM 985 H. C. MILLER CO., MILWAUKEE

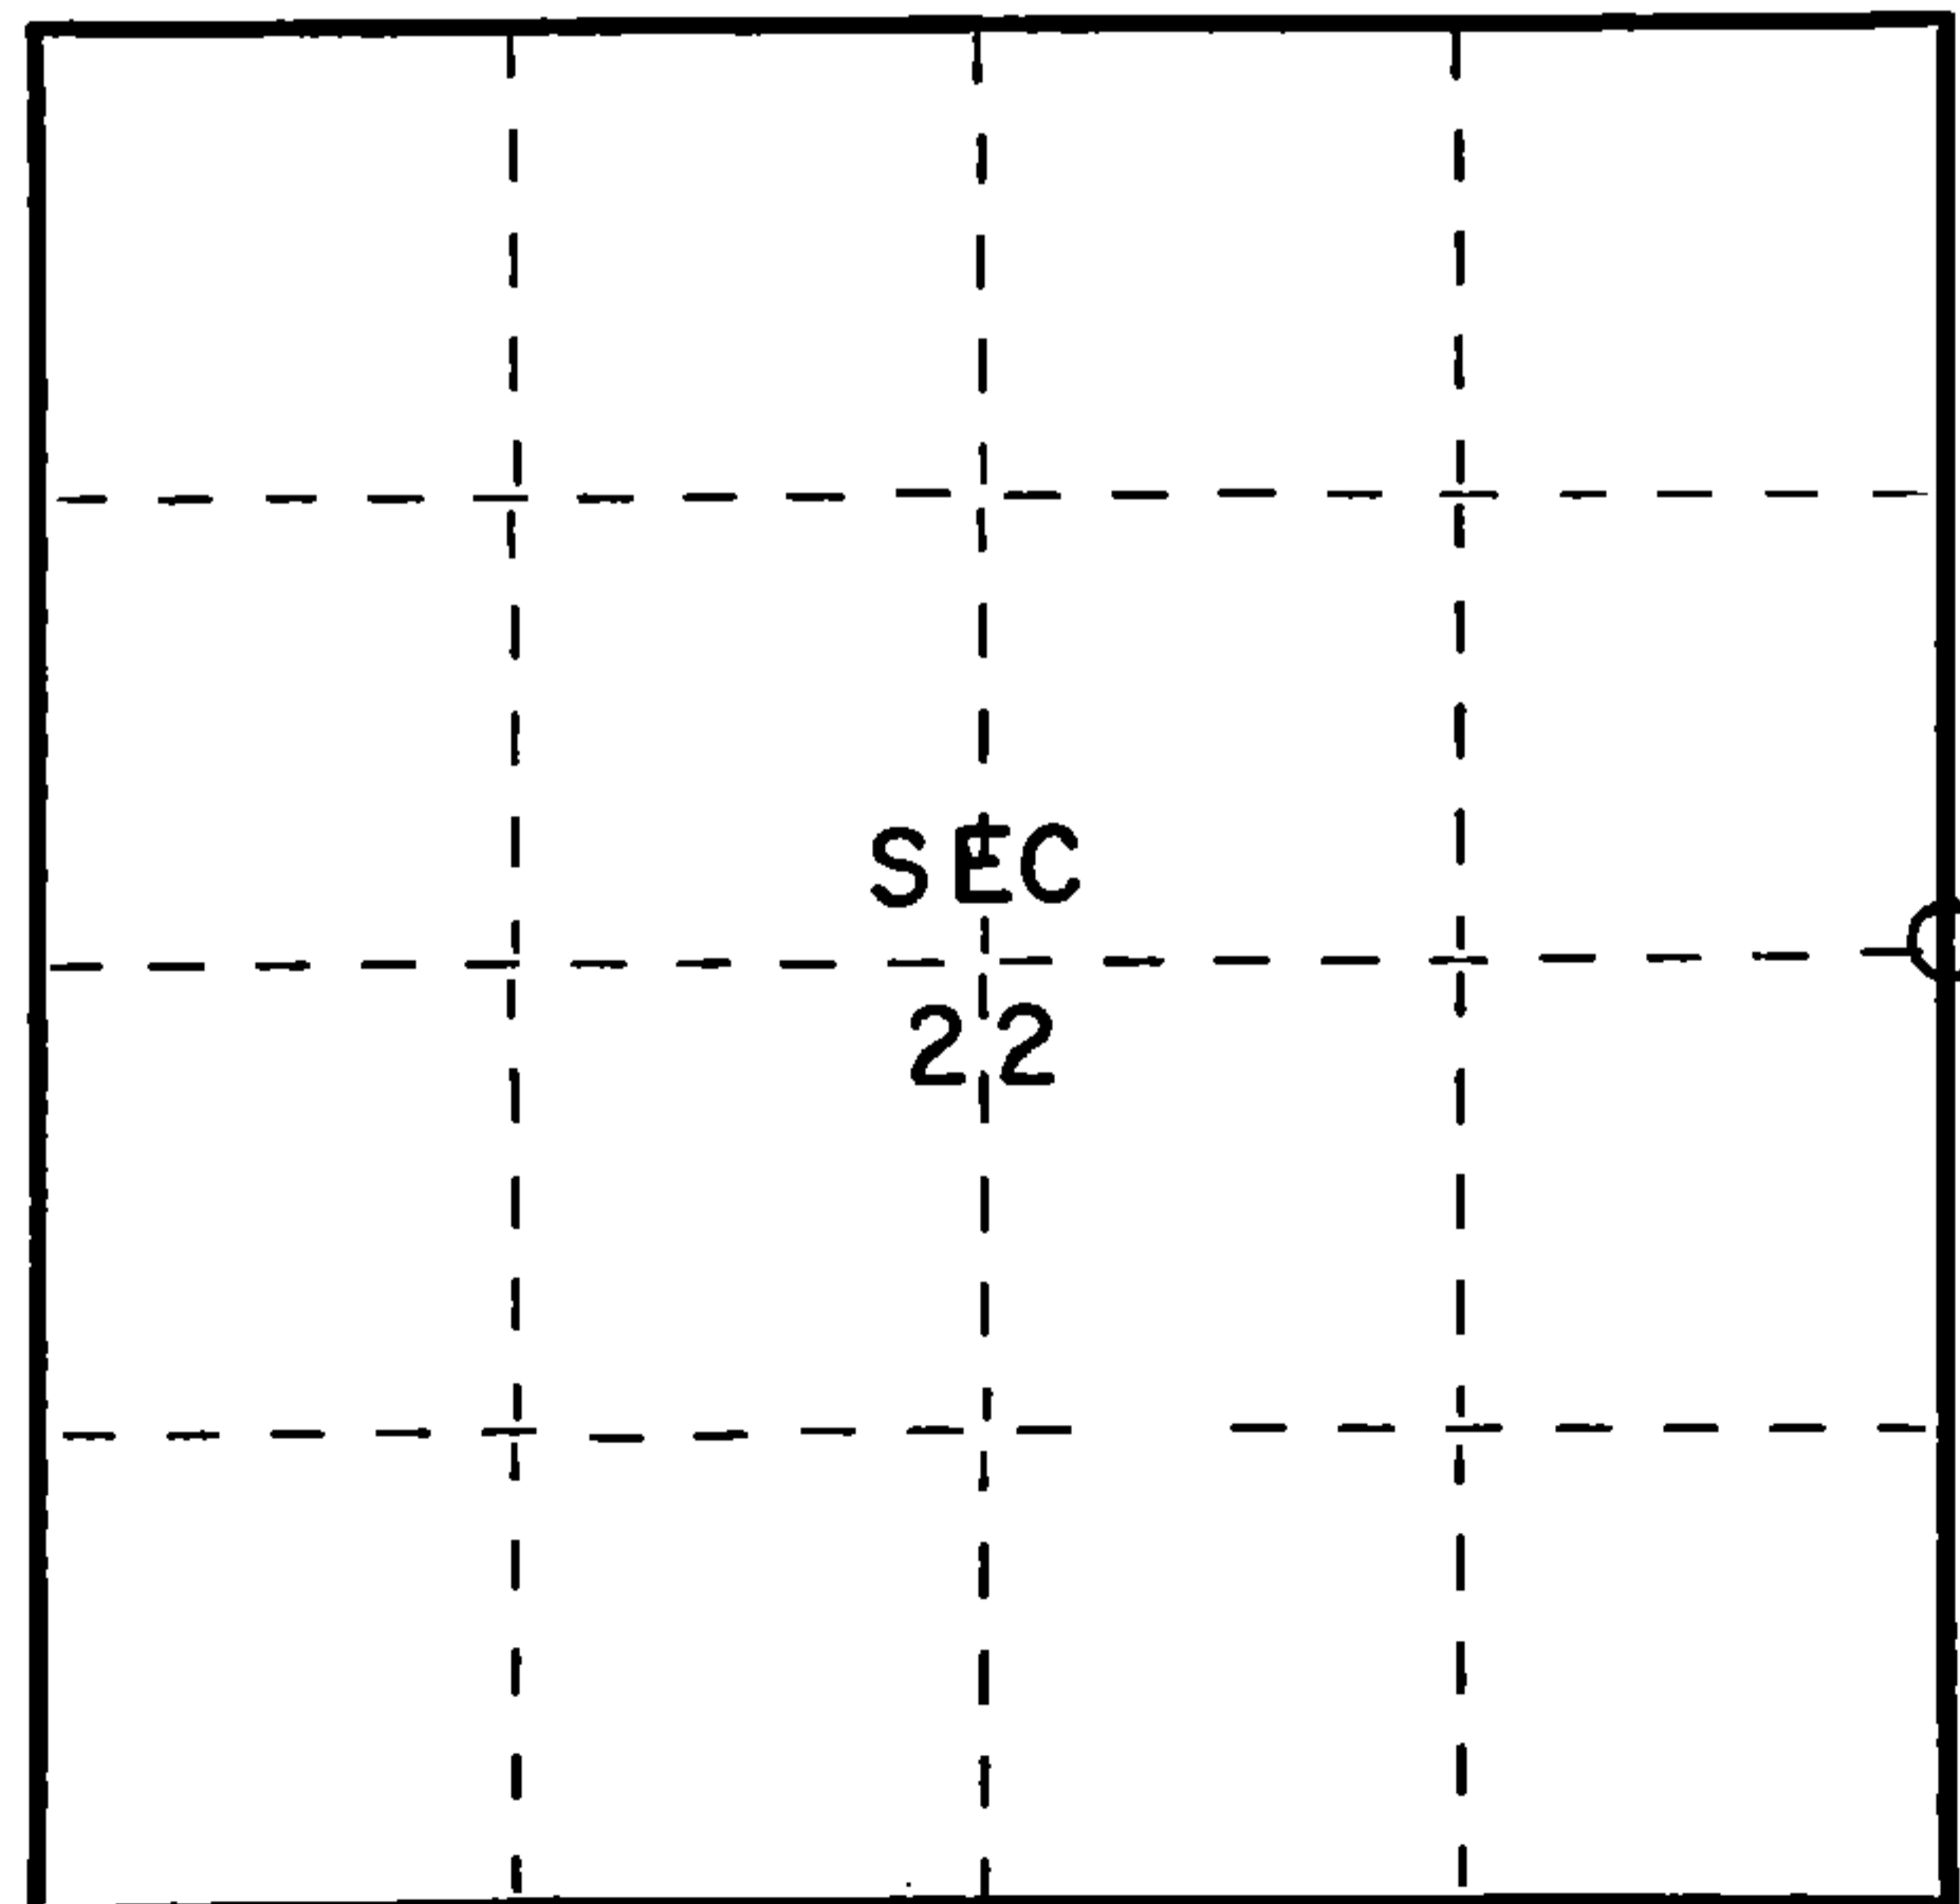

○ = Corner monument restored.

Dated at Grandon, Wis., this 24th day of October, 1975.

Signature Thomas R. Arnott Title Land Surveyor Registration No S-887
(County Surveyor, Registered Land Surveyor, or other duly authorized official)

Office of Register of Deeds, County of Forest, I hereby certify that the within instrument was filed in this office for record on the 27th day of October, 1975 at 8:30 o'clock A. M.

Eugene Staszny Document Number **108058**
(Register of Deeds)

By _____ Deputy

43613222000