

CERTIFIED LAND CORNER RESTORATION


Index No. **T 13**

State of Wisconsin }
County of Forest } ss.

I Thomas R. Arnott, do hereby
certify that on the 8th day
of September, 19 75, I found
evidence of the 1/4
corner of sections 27 & 28
Township 36, North, Range
13 E, Fourth Principal Meridian,
as described hereon; and that from this evidence
I established a new monument and accessories
as described hereon to perpetuate the original
location of this corner.

Resident witnesses:

Herbert Wagoner

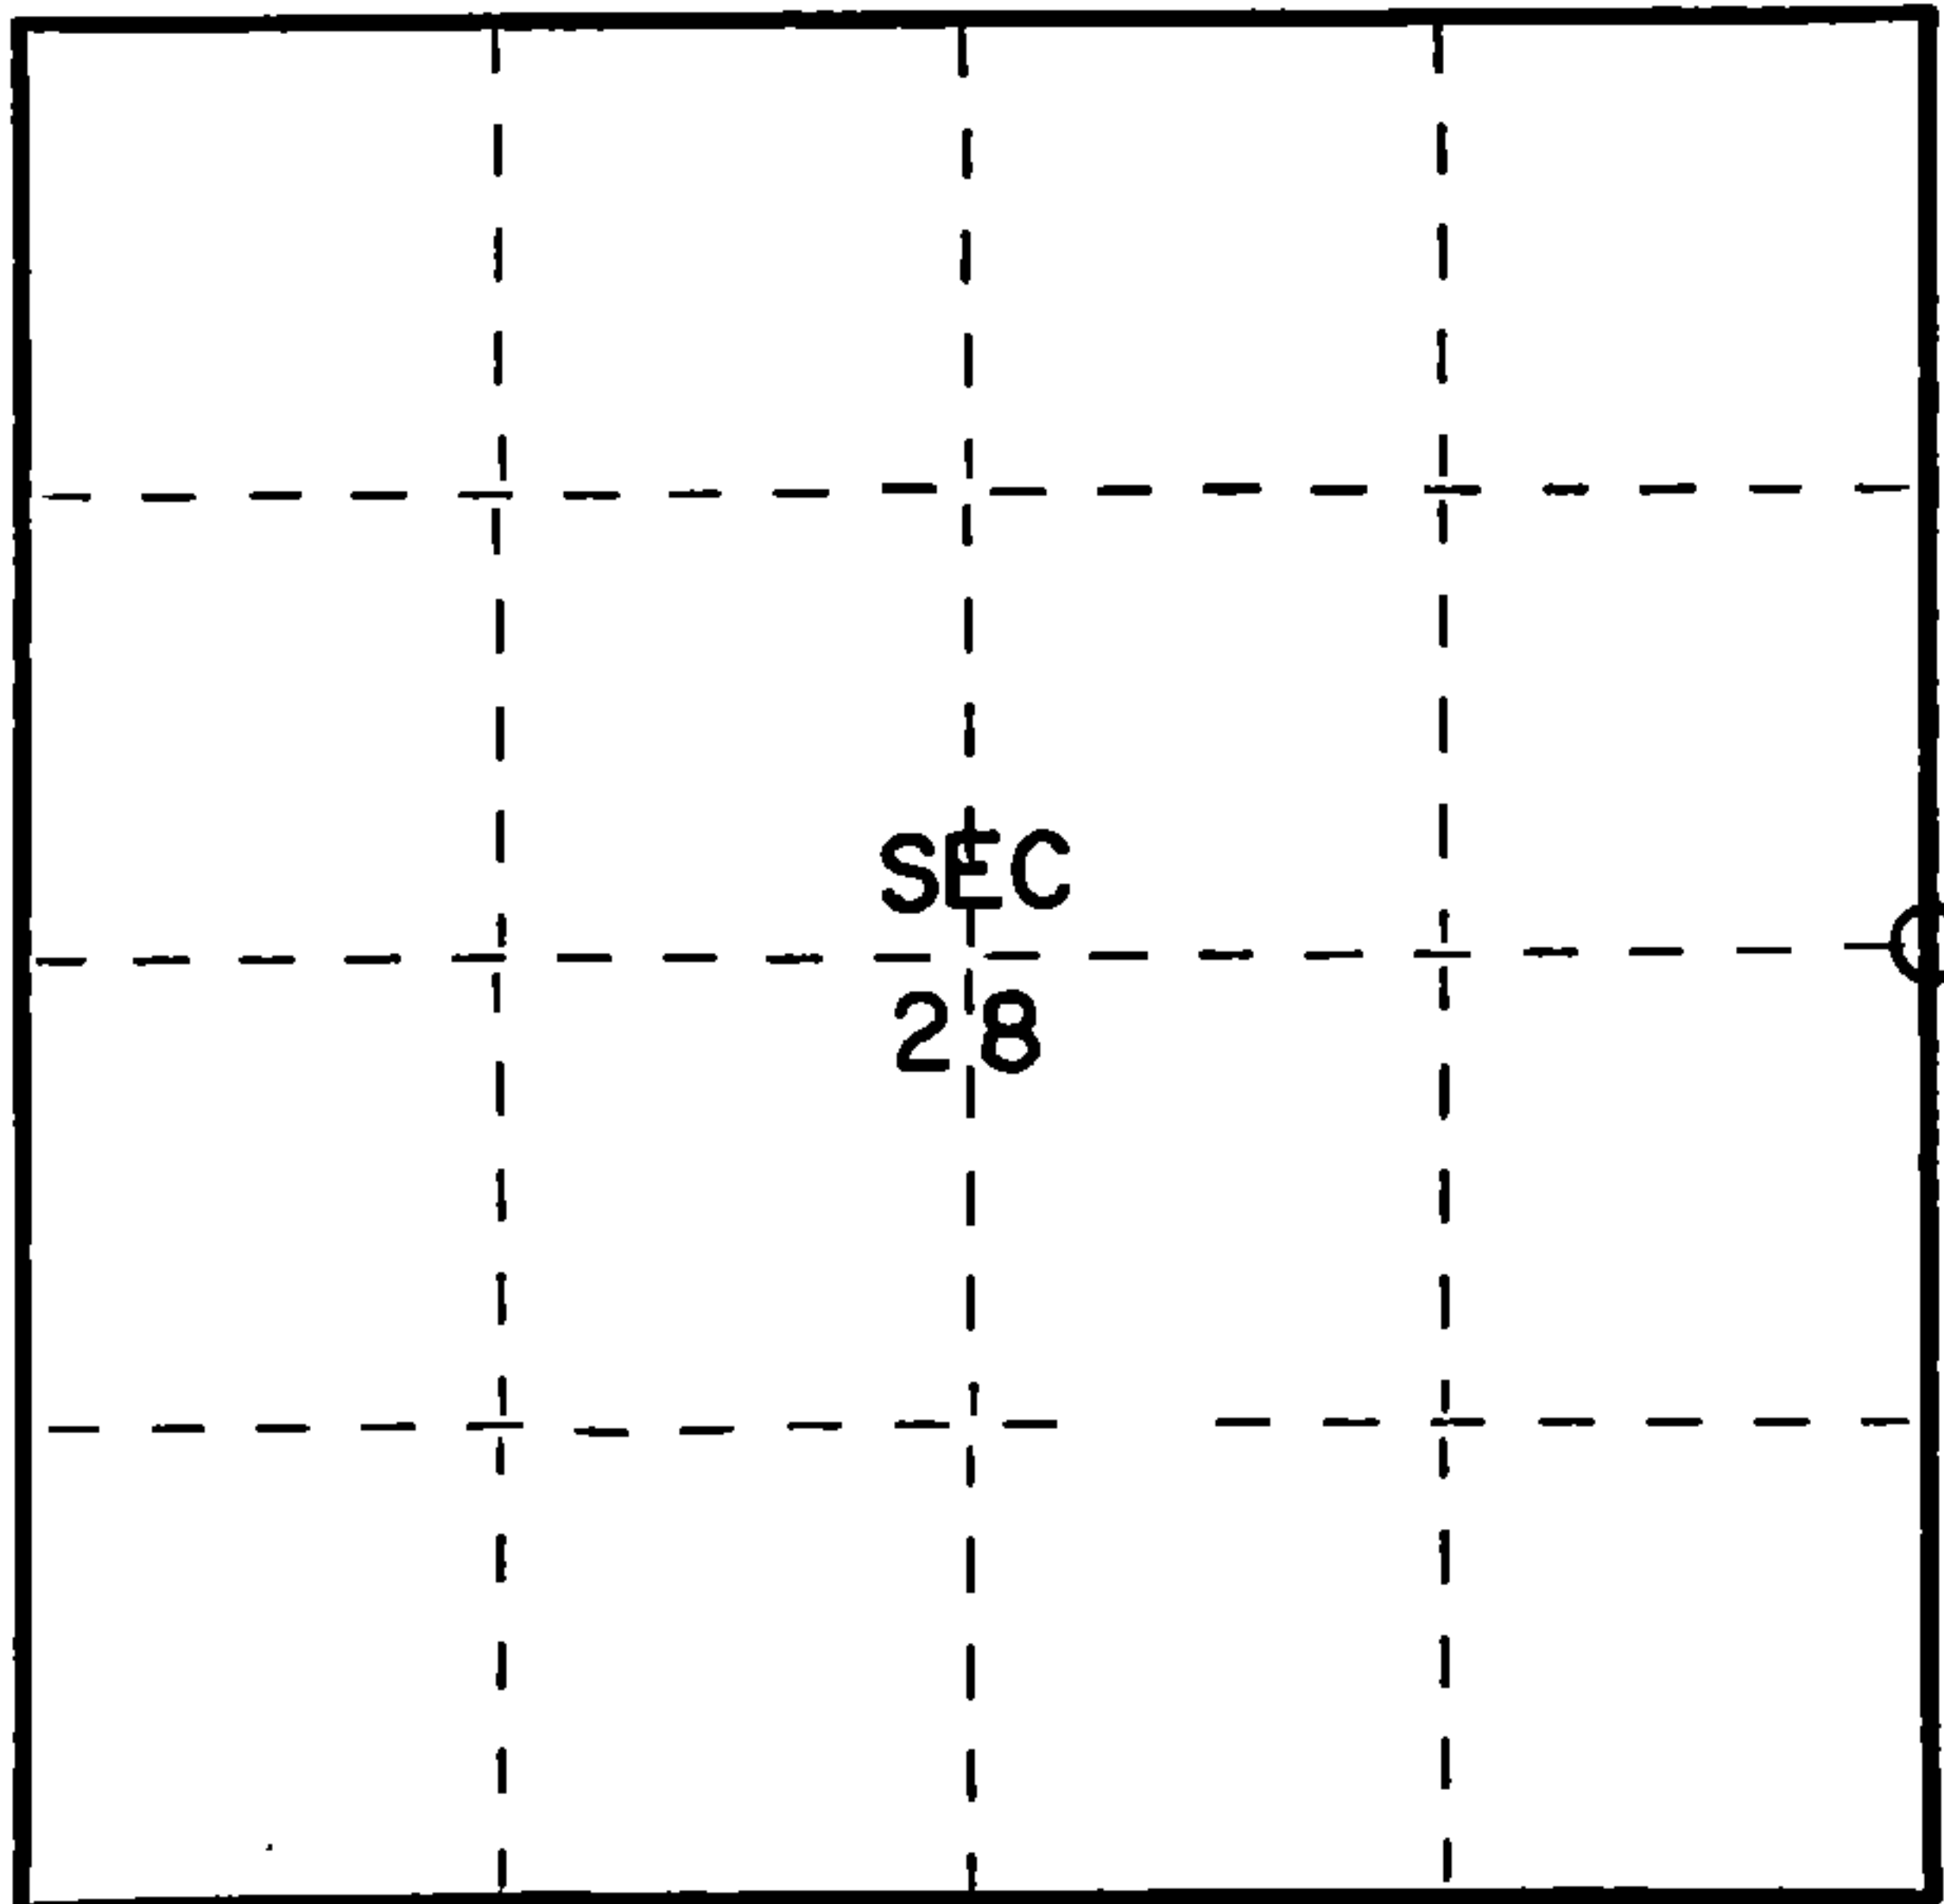

○ = Corner monument restored.

History of original corner establishment:

Original subdivision by James L. Nowlin June 2 - June 12, 1865

Original information on ties missing from the field notes on hand at
the courthouse.

Description of corner evidence found:


2" iron pipe 5' long with brass cap set by C.E. Walker in 1938

Description of monument and accessories I established to perpetuate the original location of this corner.

Left monument set by walker

Ties:

Maple	9"	S40W	13.25 feet
Maple	7"	S19E	6.25 feet

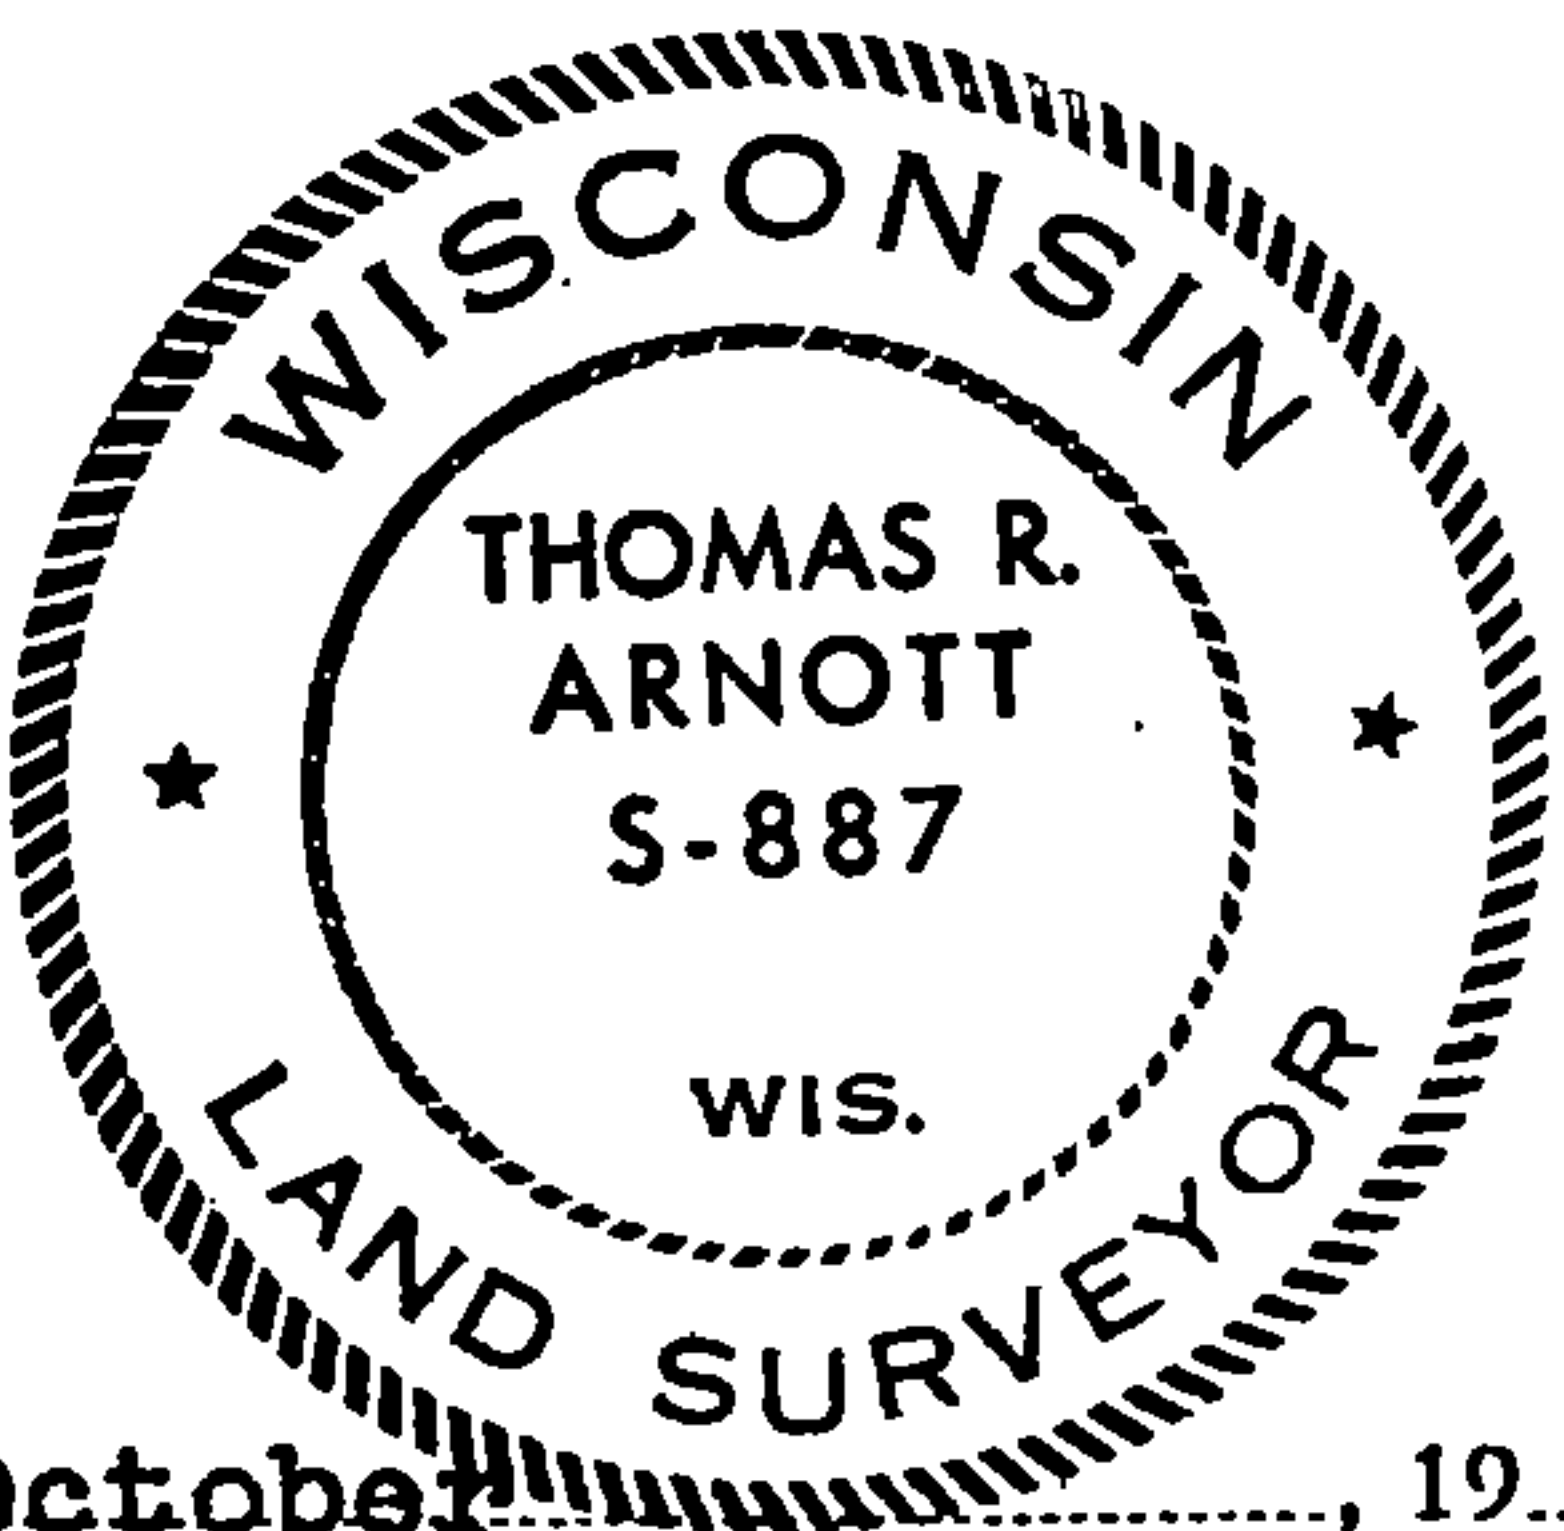

Dated at Crandon Wis., this 24th day of October, 19 75

Signature Thomas R. Arnott Title Land surveyor Registration No. S-887
(County Surveyor, Registered Land Surveyor, or other duly authorized official)

Office of Register of Deeds, County of Forest, I hereby certify that the within
instrument was filed in this office for record on the 27th day of October, 19 75
at 8:30 o'clock A. M.

Eugene Stetson
(Register of Deeds)

Document Number **108063**

By _____ Deputy

FORM 985 H. C. MILLER CO., MILWAUKEE

42613282000