

CERTIFIED LAND CORNER RESTORATION



Index No. E-24

E 24

State of Wisconsin }
County of Forest } ss.

I Daniel K. Pleoger, do hereby
certify that on the 30th day
of March, 19 82, I ~~found~~ found est.
~~evidence of the~~ E 1/16
corner of Sections 1 & 12
Township 36, North, Range
14 East, Fourth Principal Meridian,
as described hereon; and that from this evidence
I established a new monument and accessories
as described hereon to perpetuate the original
location of this corner.

Resident witnesses:

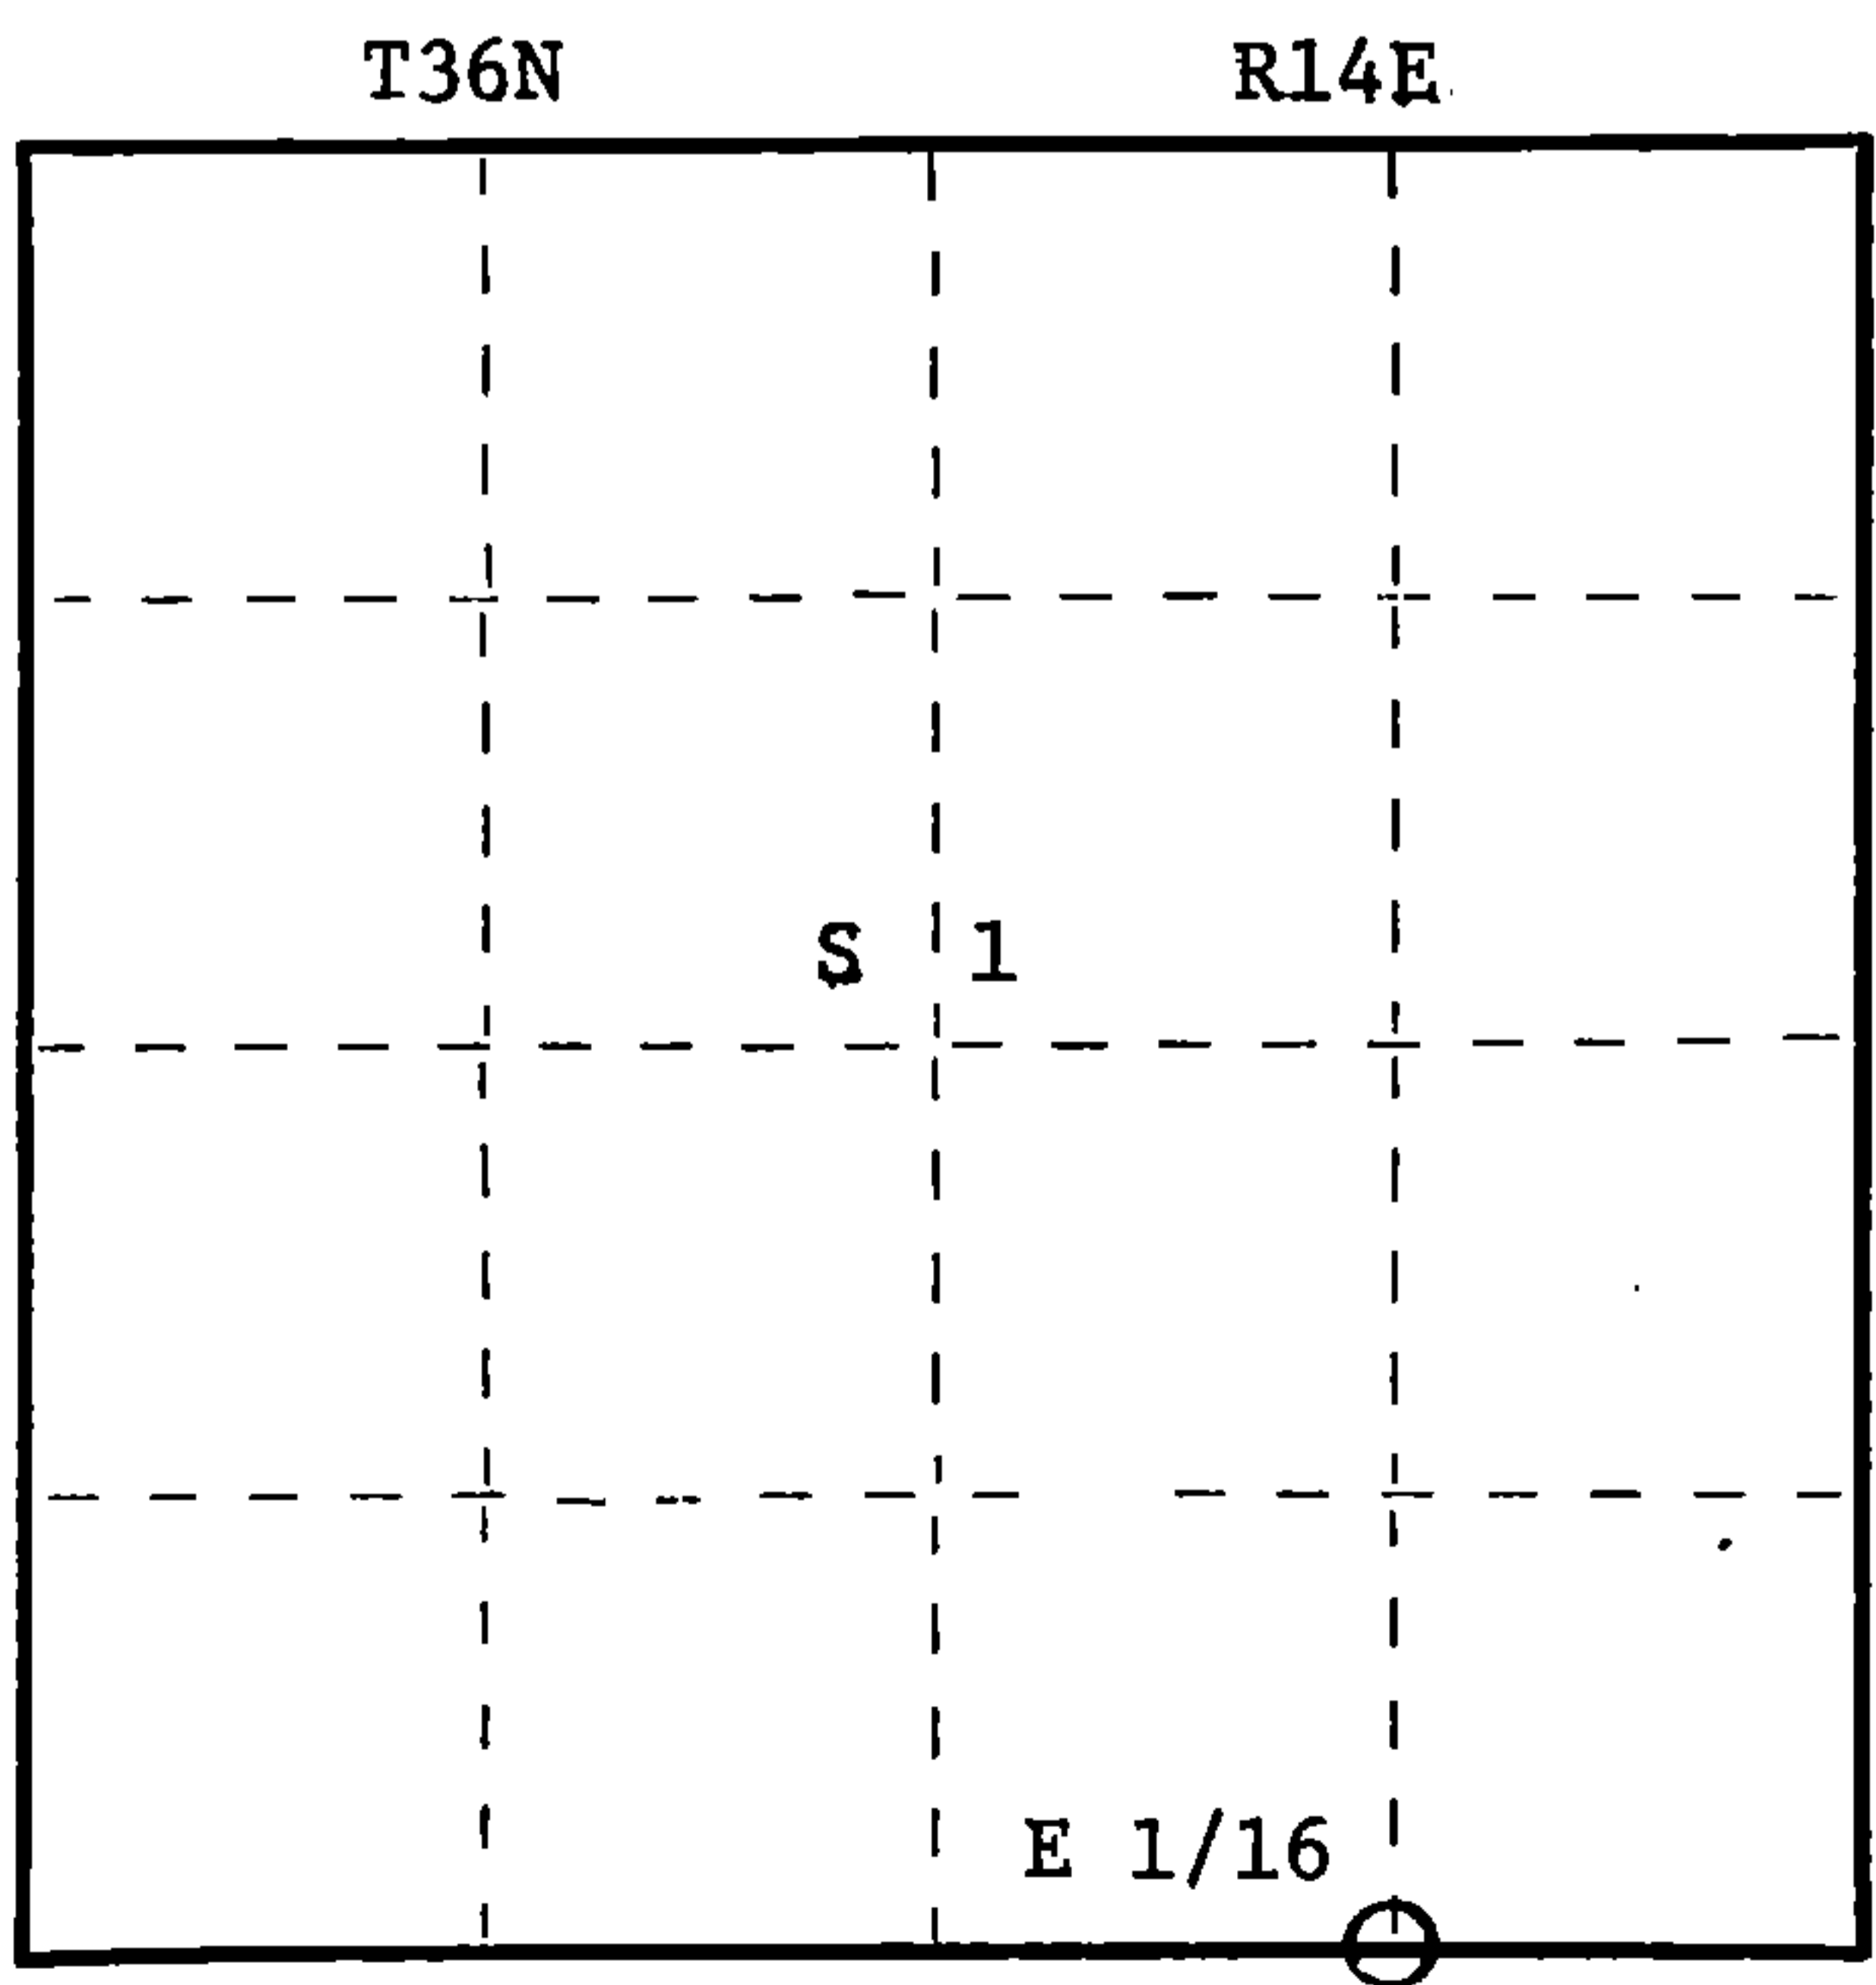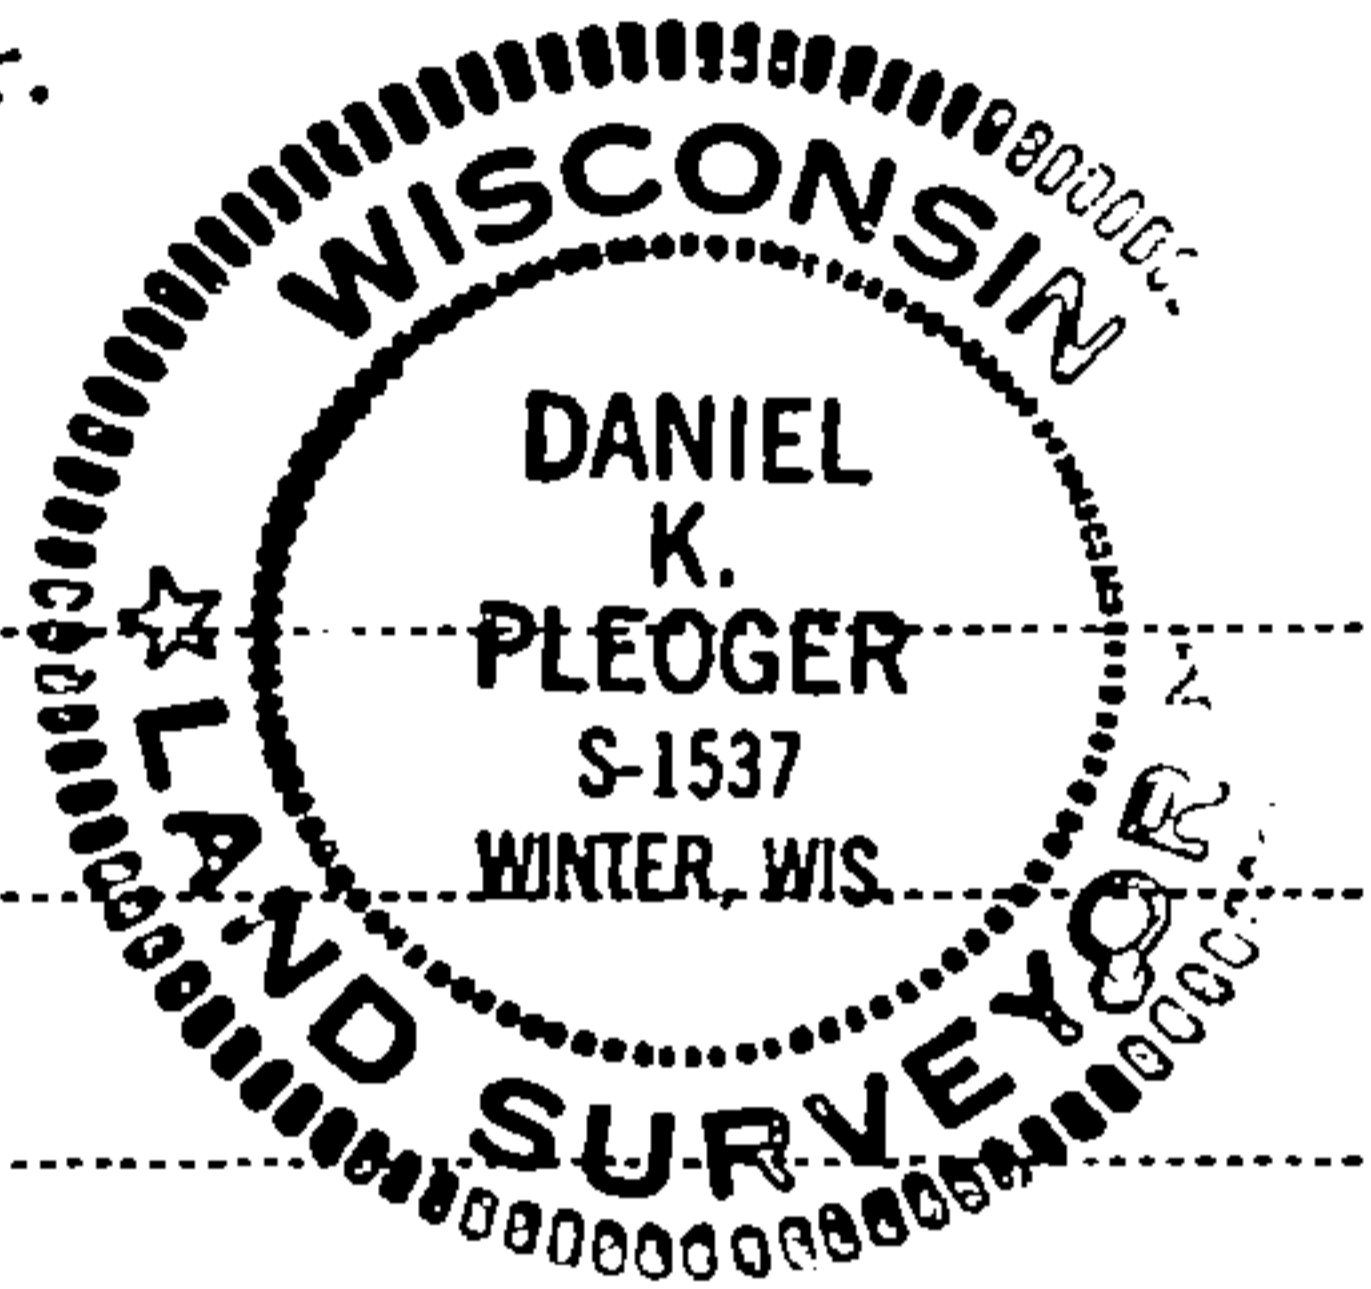

○ = Corner monument restored.

History of original corner establishment:

No evidence of any previous corner.

Description of corner evidence found:

Total distance from section corner 1-12 - 6-7 T36N R14 & 15E to 1/4 corner between
sections 1 & 12 T36N R14E is 2654.78 ft. at bearing S88-05-58W.
Set E 1/16 1327.39 ft. intermediate.

Description of monument and accessories I established to perpetuate the original location of this corner.

Set a 1" iron pipe with 2" diameter alloy cap stamped:

T36N R14E

Monument projects 8" above ground.

Marked NBTs:

Black ash 5" N36W 16.65 ft.
Cedar 6" S1°E 27.34 ft.
Scribed 1/16 - B.T.

E 1/16 $\frac{S}{S} \frac{1}{12}$

S1537 - 1982

Dated at Rhineland, Wis., this 18th day of May, 19 82

Signature Daniel K. Pleoger Title Registered Land Surveyor Registration No. 1537
(County Surveyor, Registered Land Surveyor, or other duly authorized official)

Office of Register of Deeds, County of Forest, I hereby certify that the within
instrument was filed in this office for record on the 15th day of June, 19 82
at 10:00 o'clock A. M.

Eugene Statezny
(Register of Deeds)

By Sharon Mueller Deputy

DOCUMENT NO.
121695

FORM 983 M. C. MILLER CO., MILWAUKEE

43614010010