

CERTIFIED LAND CORNER RESTORATION

Index No. B-1

State of Wisconsin }
County of Forest } ss.


I Philip T. Hansen, do hereby certify that on the 27th day of September, 1979, I ~~found~~ established ~~existence of~~ the N 1/16 corner of Sections 1 and 6 Township 36, North, Range 14 & 15 East, Fourth Principal Meridian, as described hereon; and that from this evidence I established a new monument and accessories as described hereon to perpetuate the original location of this corner.

Resident witnesses:


Glen Barker

Jim Claflin

Herb Wagoner

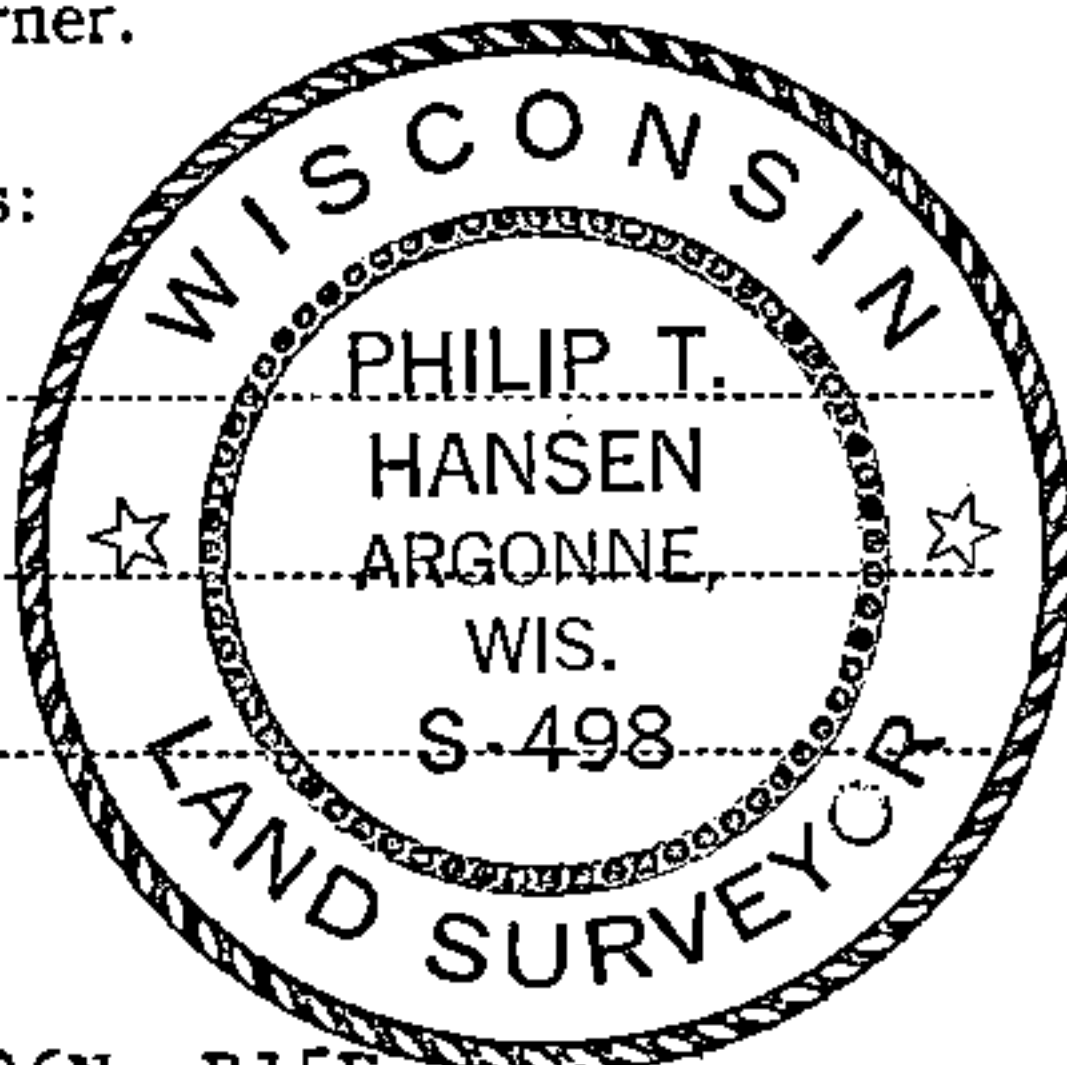

T36N R15E

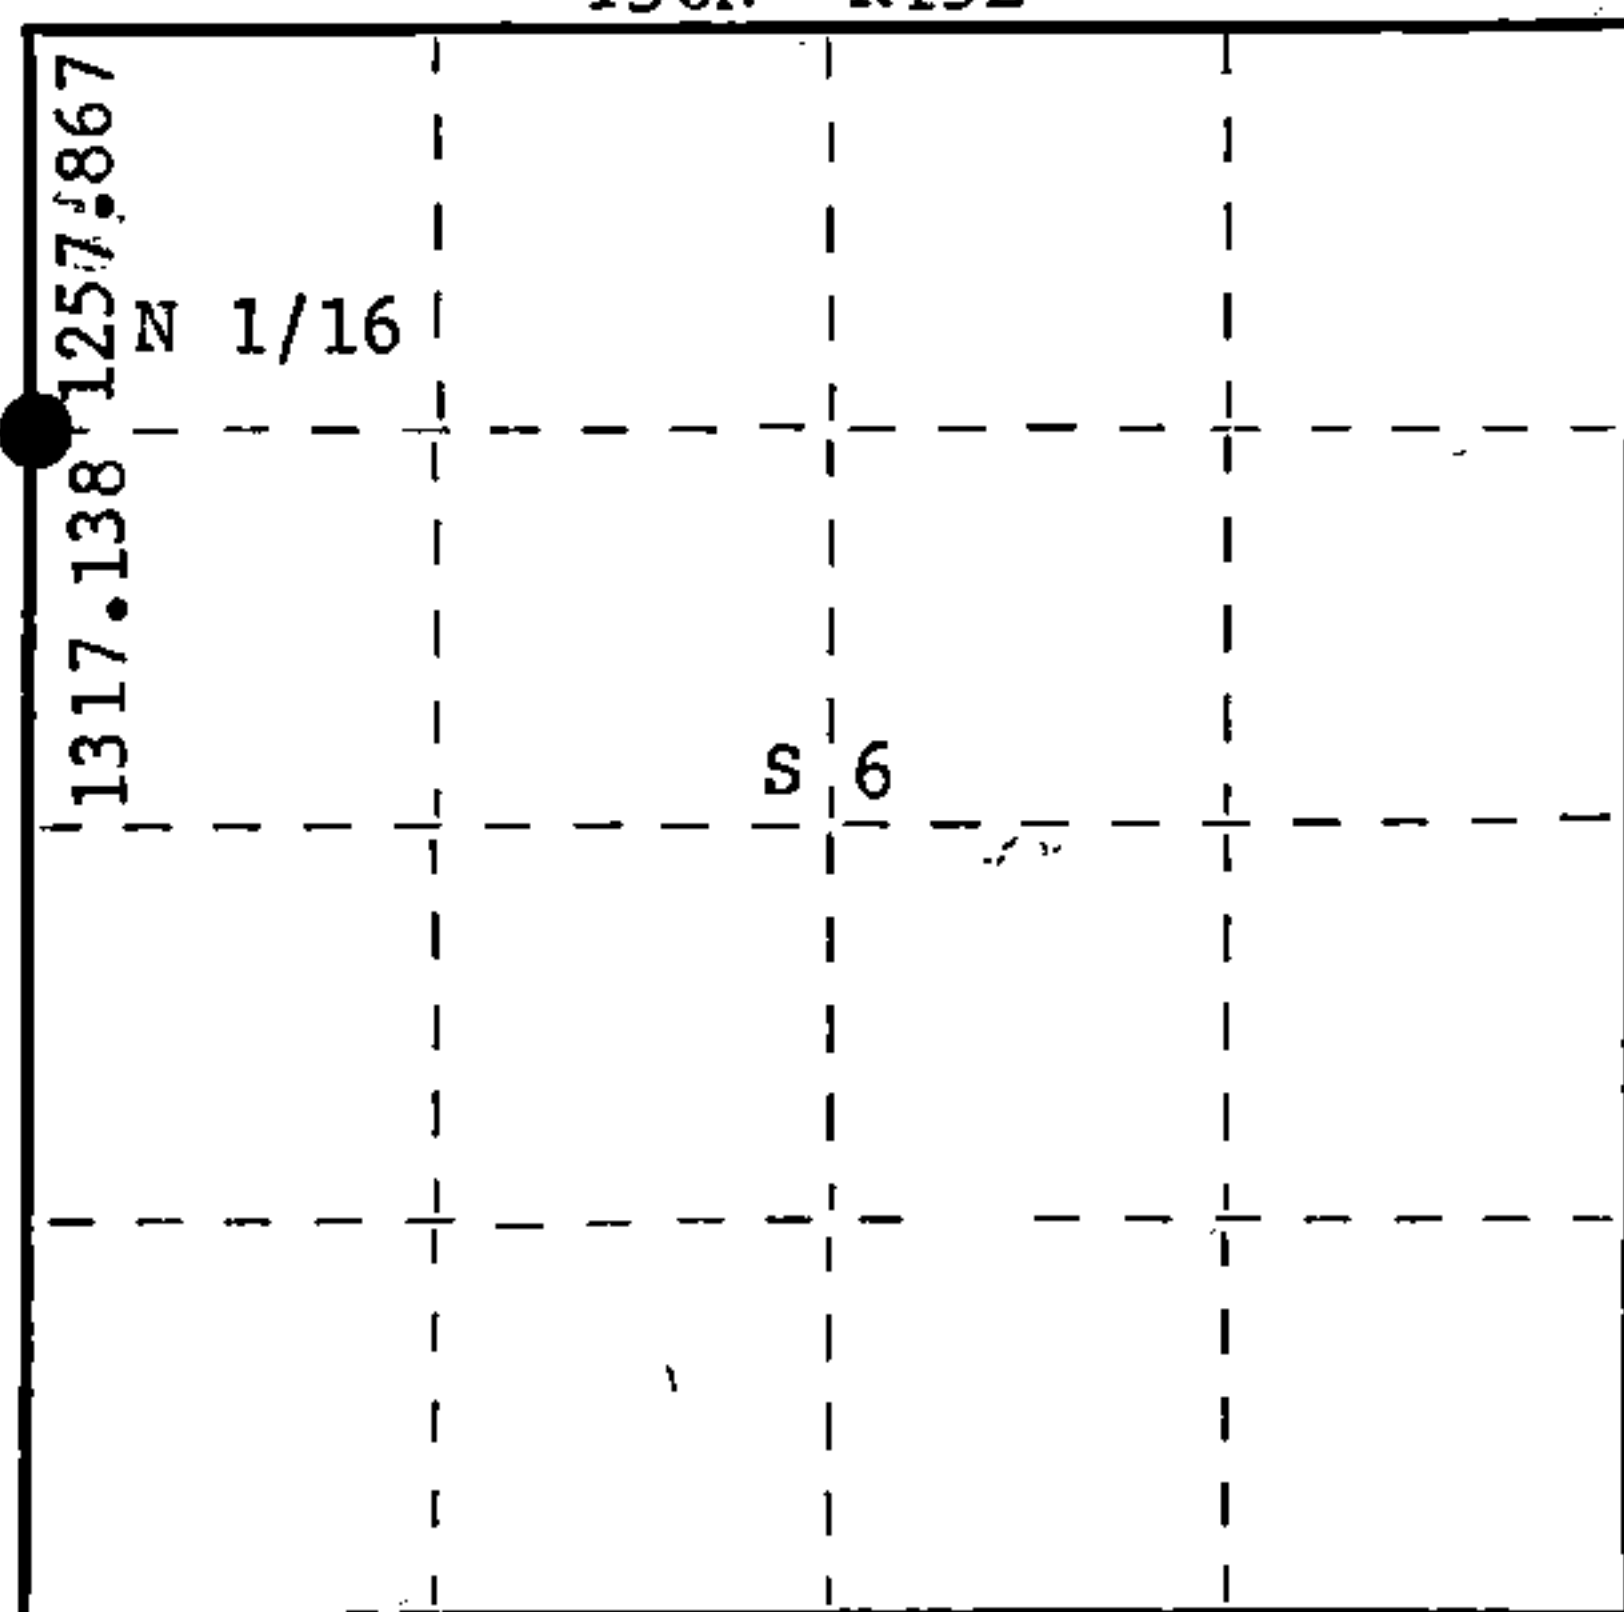

○ = Corner monument restored.

History of original corner establishment:

No records available on any previous survey.
No evidences of any corner recovered.

Description of corner evidence found:

Corner established by traverse and computation. Ran traverse from previously recovered section corner 1, 6, 31 and 36 to the 1/4 corner between sections 1 and 6. Computed distance 2575.007 feet at bearing S 2° 00' 15" W. Corner set by proportional measurement to the original distance 1257.867', S 2° 00' 15" W of section corner and N 2° 00' 15" E, 1317.138 feet from 1/4 corner.

Description of monument and accessories I established to perpetuate the original location of this corner.

Set a 1-1/2" iron pipe with 2" brass cap, stamped:
Monument projects 24" above ground.

Marked NBT's -
Maple 6" S32°E 13.40 feet
Sugar 5" N7°E 49.40 feet
scribed N 1/16 BT

S498
R14E T36N R15E
N 1/16 1+6
CPI-1979

Dated at Rhineland, Wis., this 9th day of October, 1979

Signature Philip T. Hansen Title Registered Land Surveyor Registration No. S-498
(County Surveyor, Registered Land Surveyor, or other duly authorized official)

Office of Register of Deeds, County of Forest, I hereby certify that the within instrument was filed in this office for record on the 13th day of November, 1979 at 8:30 o'clock A. M.

Eugene Stearns
(Register of Deeds)

By _____ Deputy

DOCUMENT NO. **117083**

FORM 985 H. C. MILLER CO., MILWAUKEE

4361403000