

CERTIFIED LAND CORNER RESTORATION


Index No. E-21

E 21


State of Wisconsin }
County of Forest } ss.

I Daniel K. Pleoger, do hereby certify that on the 22nd day of March, 1982, I found evidence of the Section corner of Sections 1-2-11-12 Township 36, North, Range 14 East, Fourth Principal Meridian, as described hereon; and that from this evidence I established a new monument and accessories as described hereon to perpetuate the original location of this corner.

Resident witnesses:

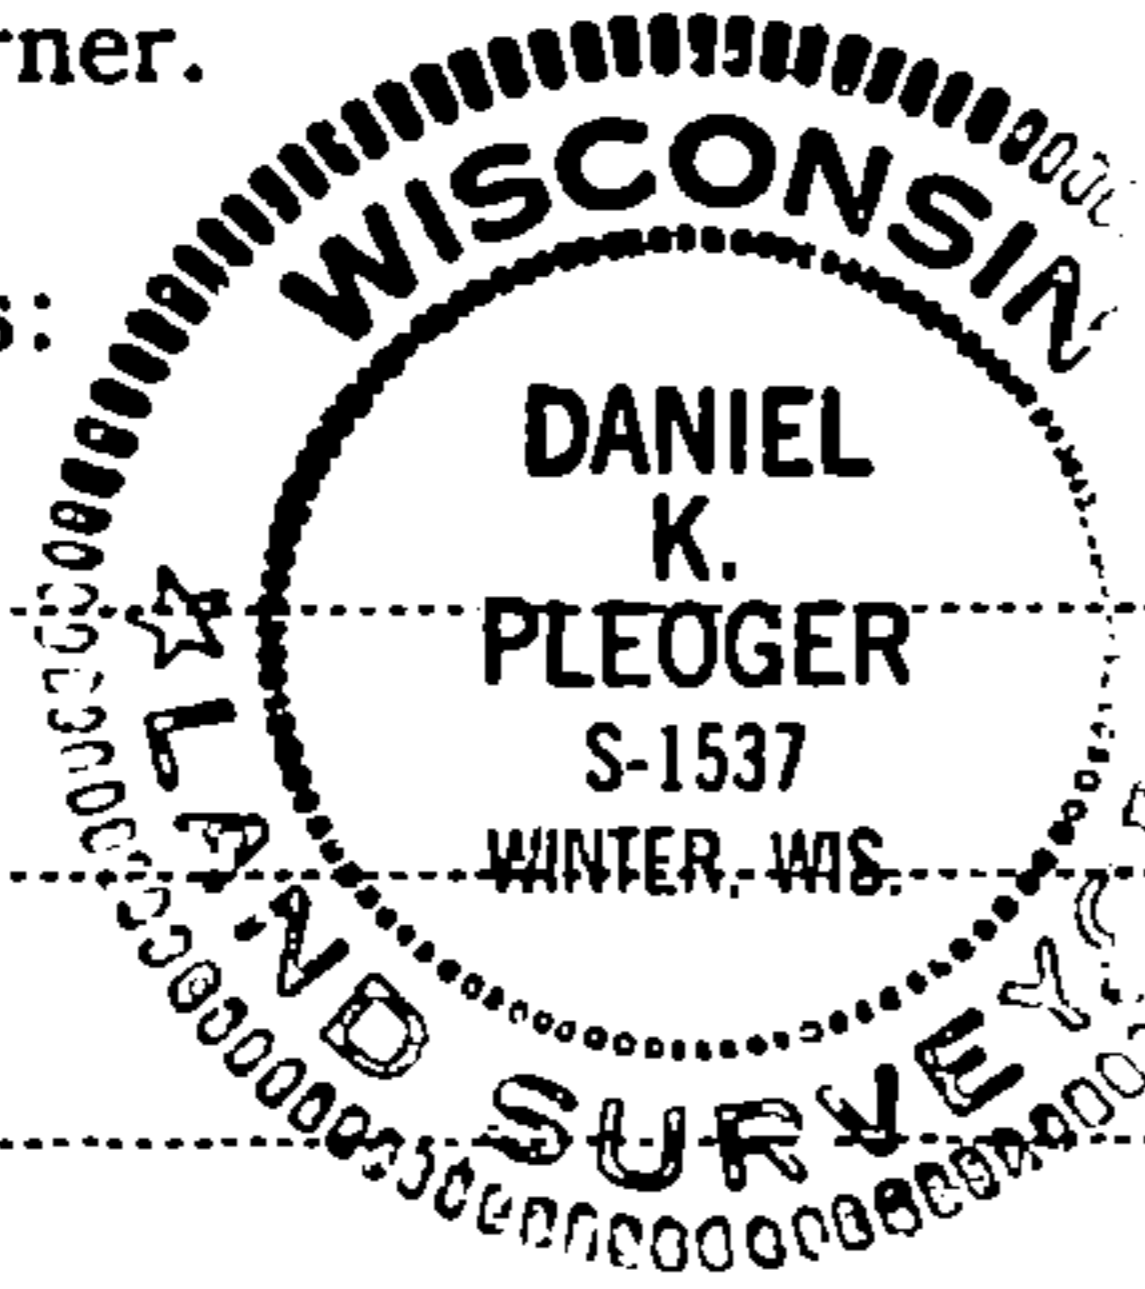

FORM 983 R. C. MILLER CO., MILWAUKEE

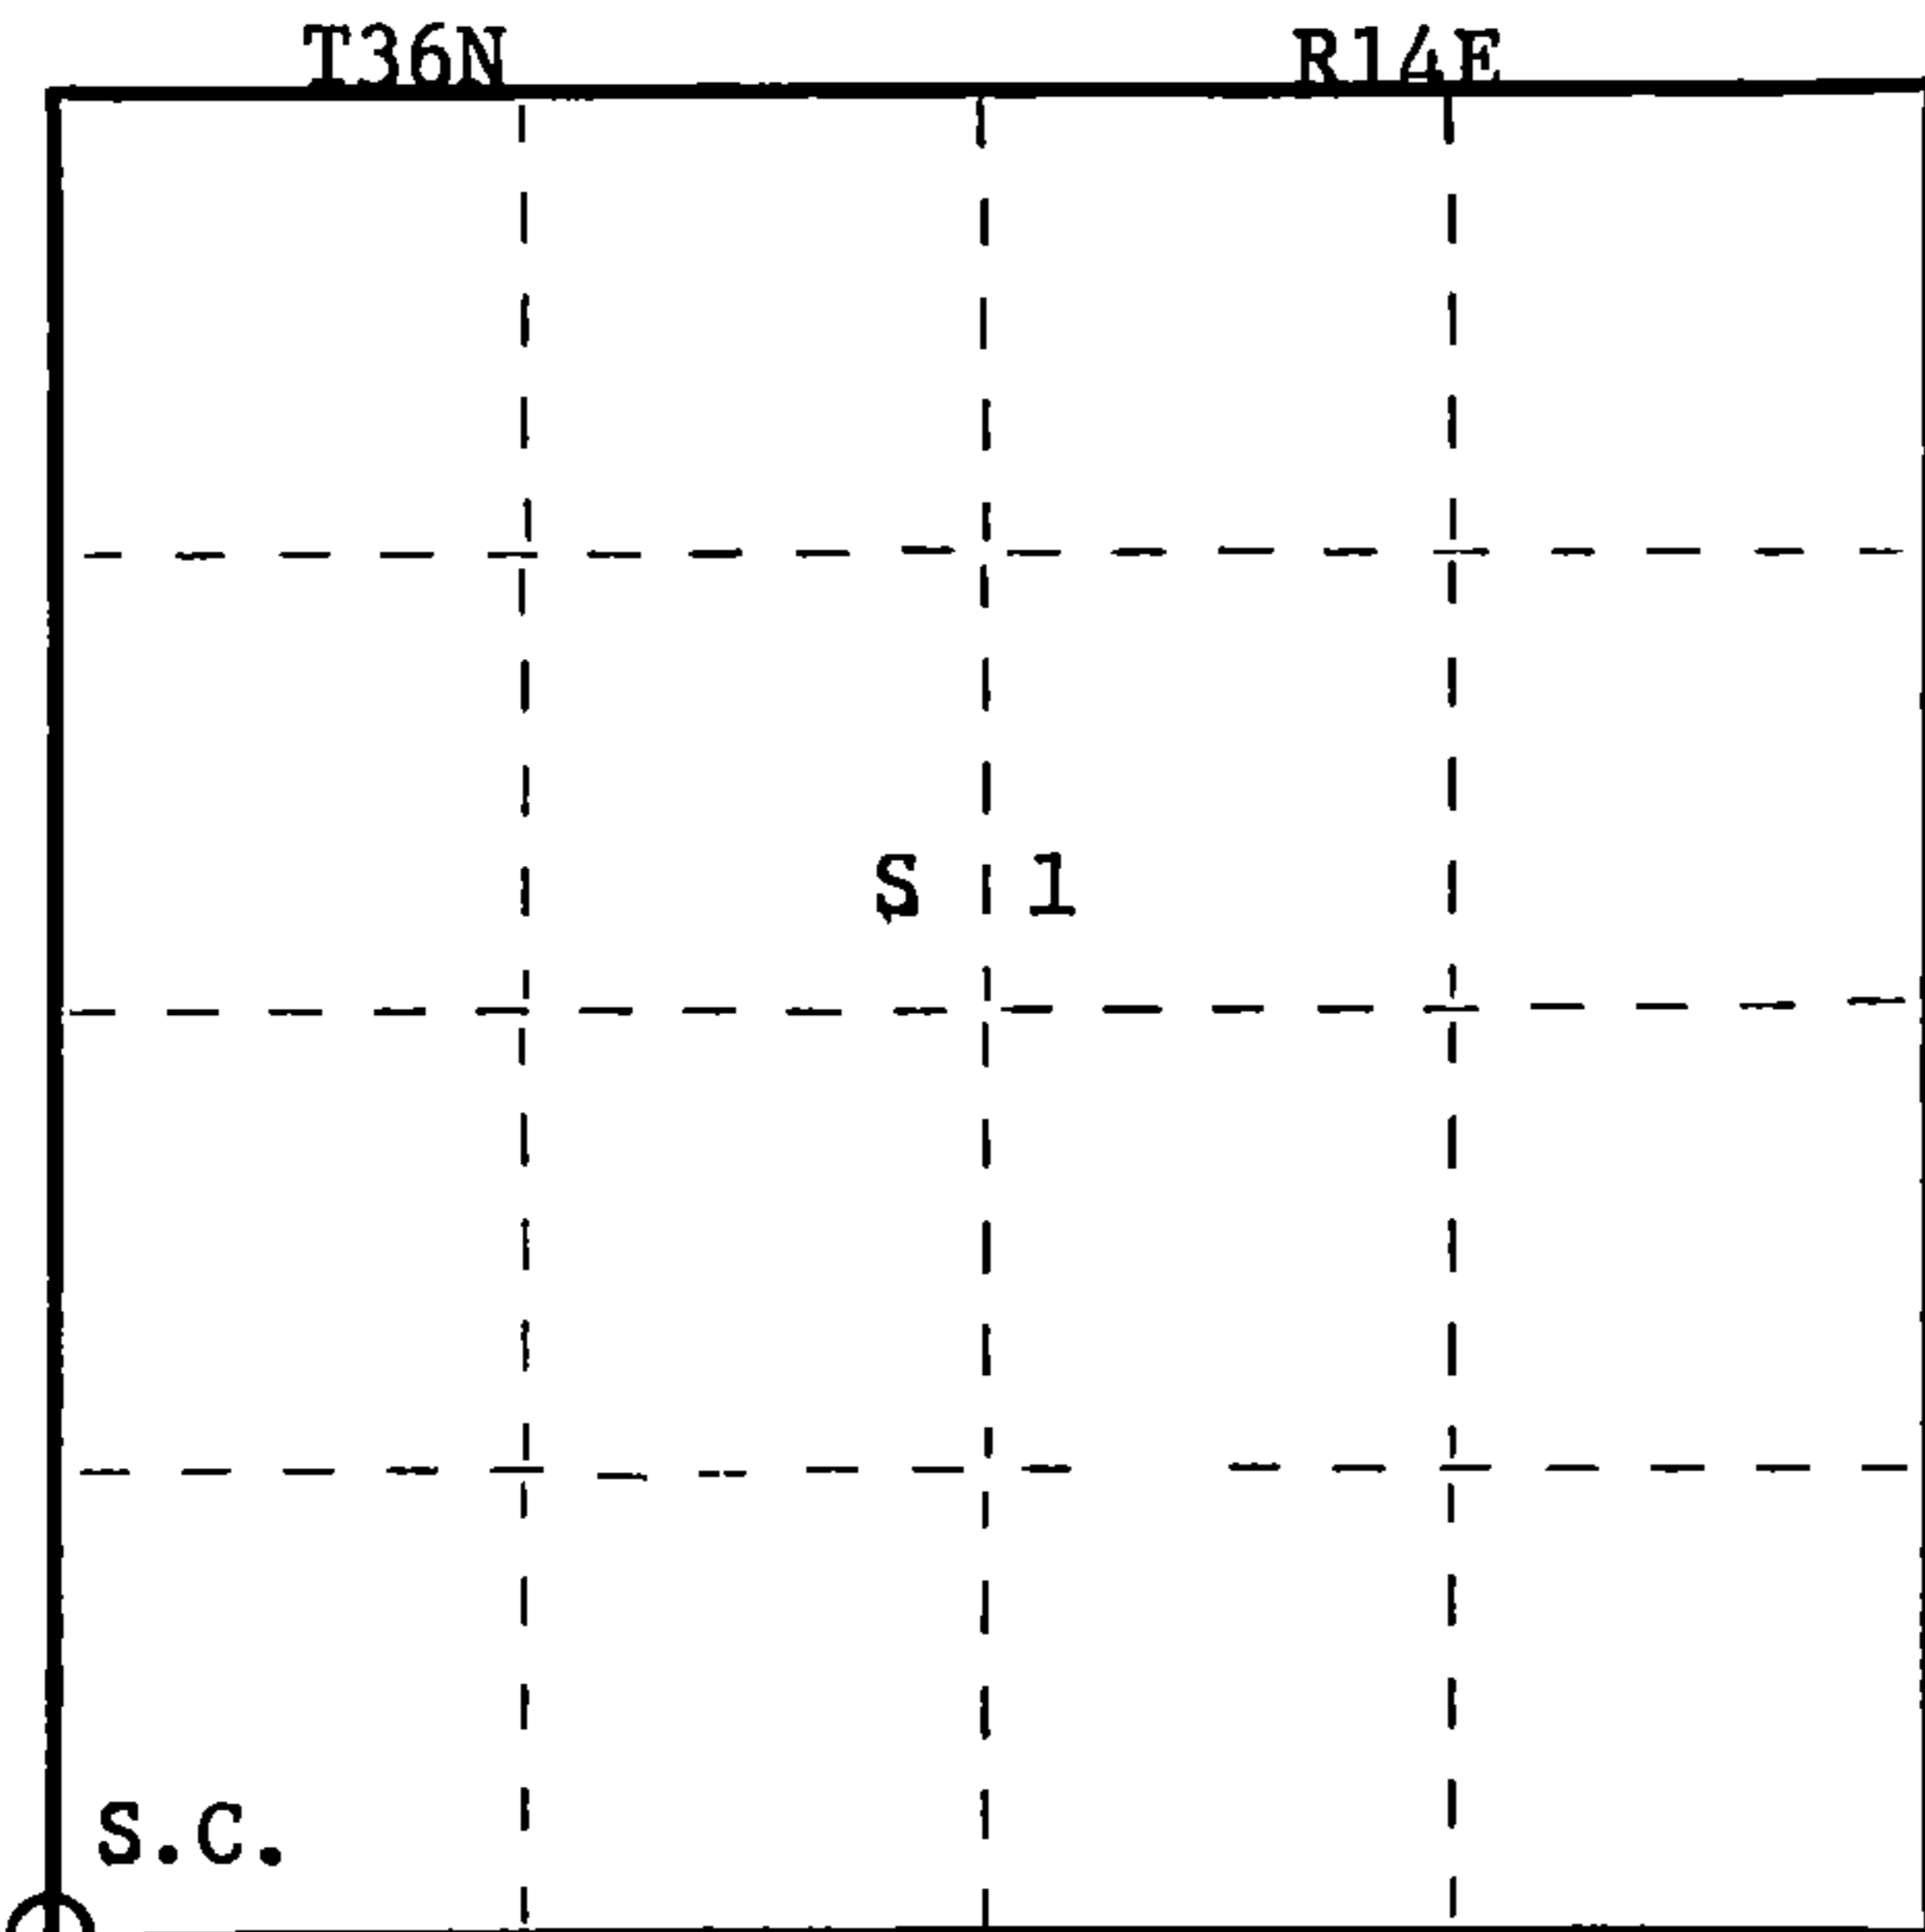

○ = Corner monument restored.

History of original corner establishment:

Original corner established by James McBride, Gov. deputy surveyor in 1859 from which hemlock 12" bears N36W 28 links, hemlock 16" N38E 17 links, cedar 12" S61E 31 links and hemlock 10" bears S53W 60 links.

Description of corner evidence found:

Recovered a piece of old post point, old blazed trees facing corner, an old forest service location tag on nearby tree, a very old blazed line running east and west from corner.

Description of monument and accessories I established to perpetuate the original location of this corner.

Set a 2 1/2" A-1 federal monument with alloy cap stamped:

T36N R14E

Monument projects 12" above ground.

S.C. $\frac{2}{11} \frac{1}{12}$

Marked NBTs:

- Sugar 5" N67E 8.30 ft.
- Sugar 8" S24W 12.23 ft.
- Sugar 7" N61W 23.98 ft.
- Scribed S.C. - B.T.

S1537 - 1982

Dated at Rhineland, Wis., this 18th day of May, 1982.

Signature Daniel K. Pleoger Title Registered Land Surveyor Registration No. 1537
(County Surveyor, Registered Land Surveyor, or other duly authorized official)

Office of Register of Deeds, County of Forest, I hereby certify that the within instrument was filed in this office for record on the 15th day of June, 1982 at 10:00 o'clock A. M.

Eugene Staszny
(Register of Deeds)

By Sharon Mueller Deputy

DOCUMENT NO.
121692

43614020000