


State of Wisconsin }
County of Forest } ss.

I Glen Barker, do hereby
certify that on the 4th day
of November, 19 85, I found
evidence of the Section Corner
corner of 2-3-10-11
Township 36, North, Range
14 East, Fourth Principal Meridian,
as described hereon; and that from this evidence
I established a new monument and accessories
as described hereon to perpetuate the original
location of this corner.

Resident witnesses:

N. Spiess

H. Wagoner

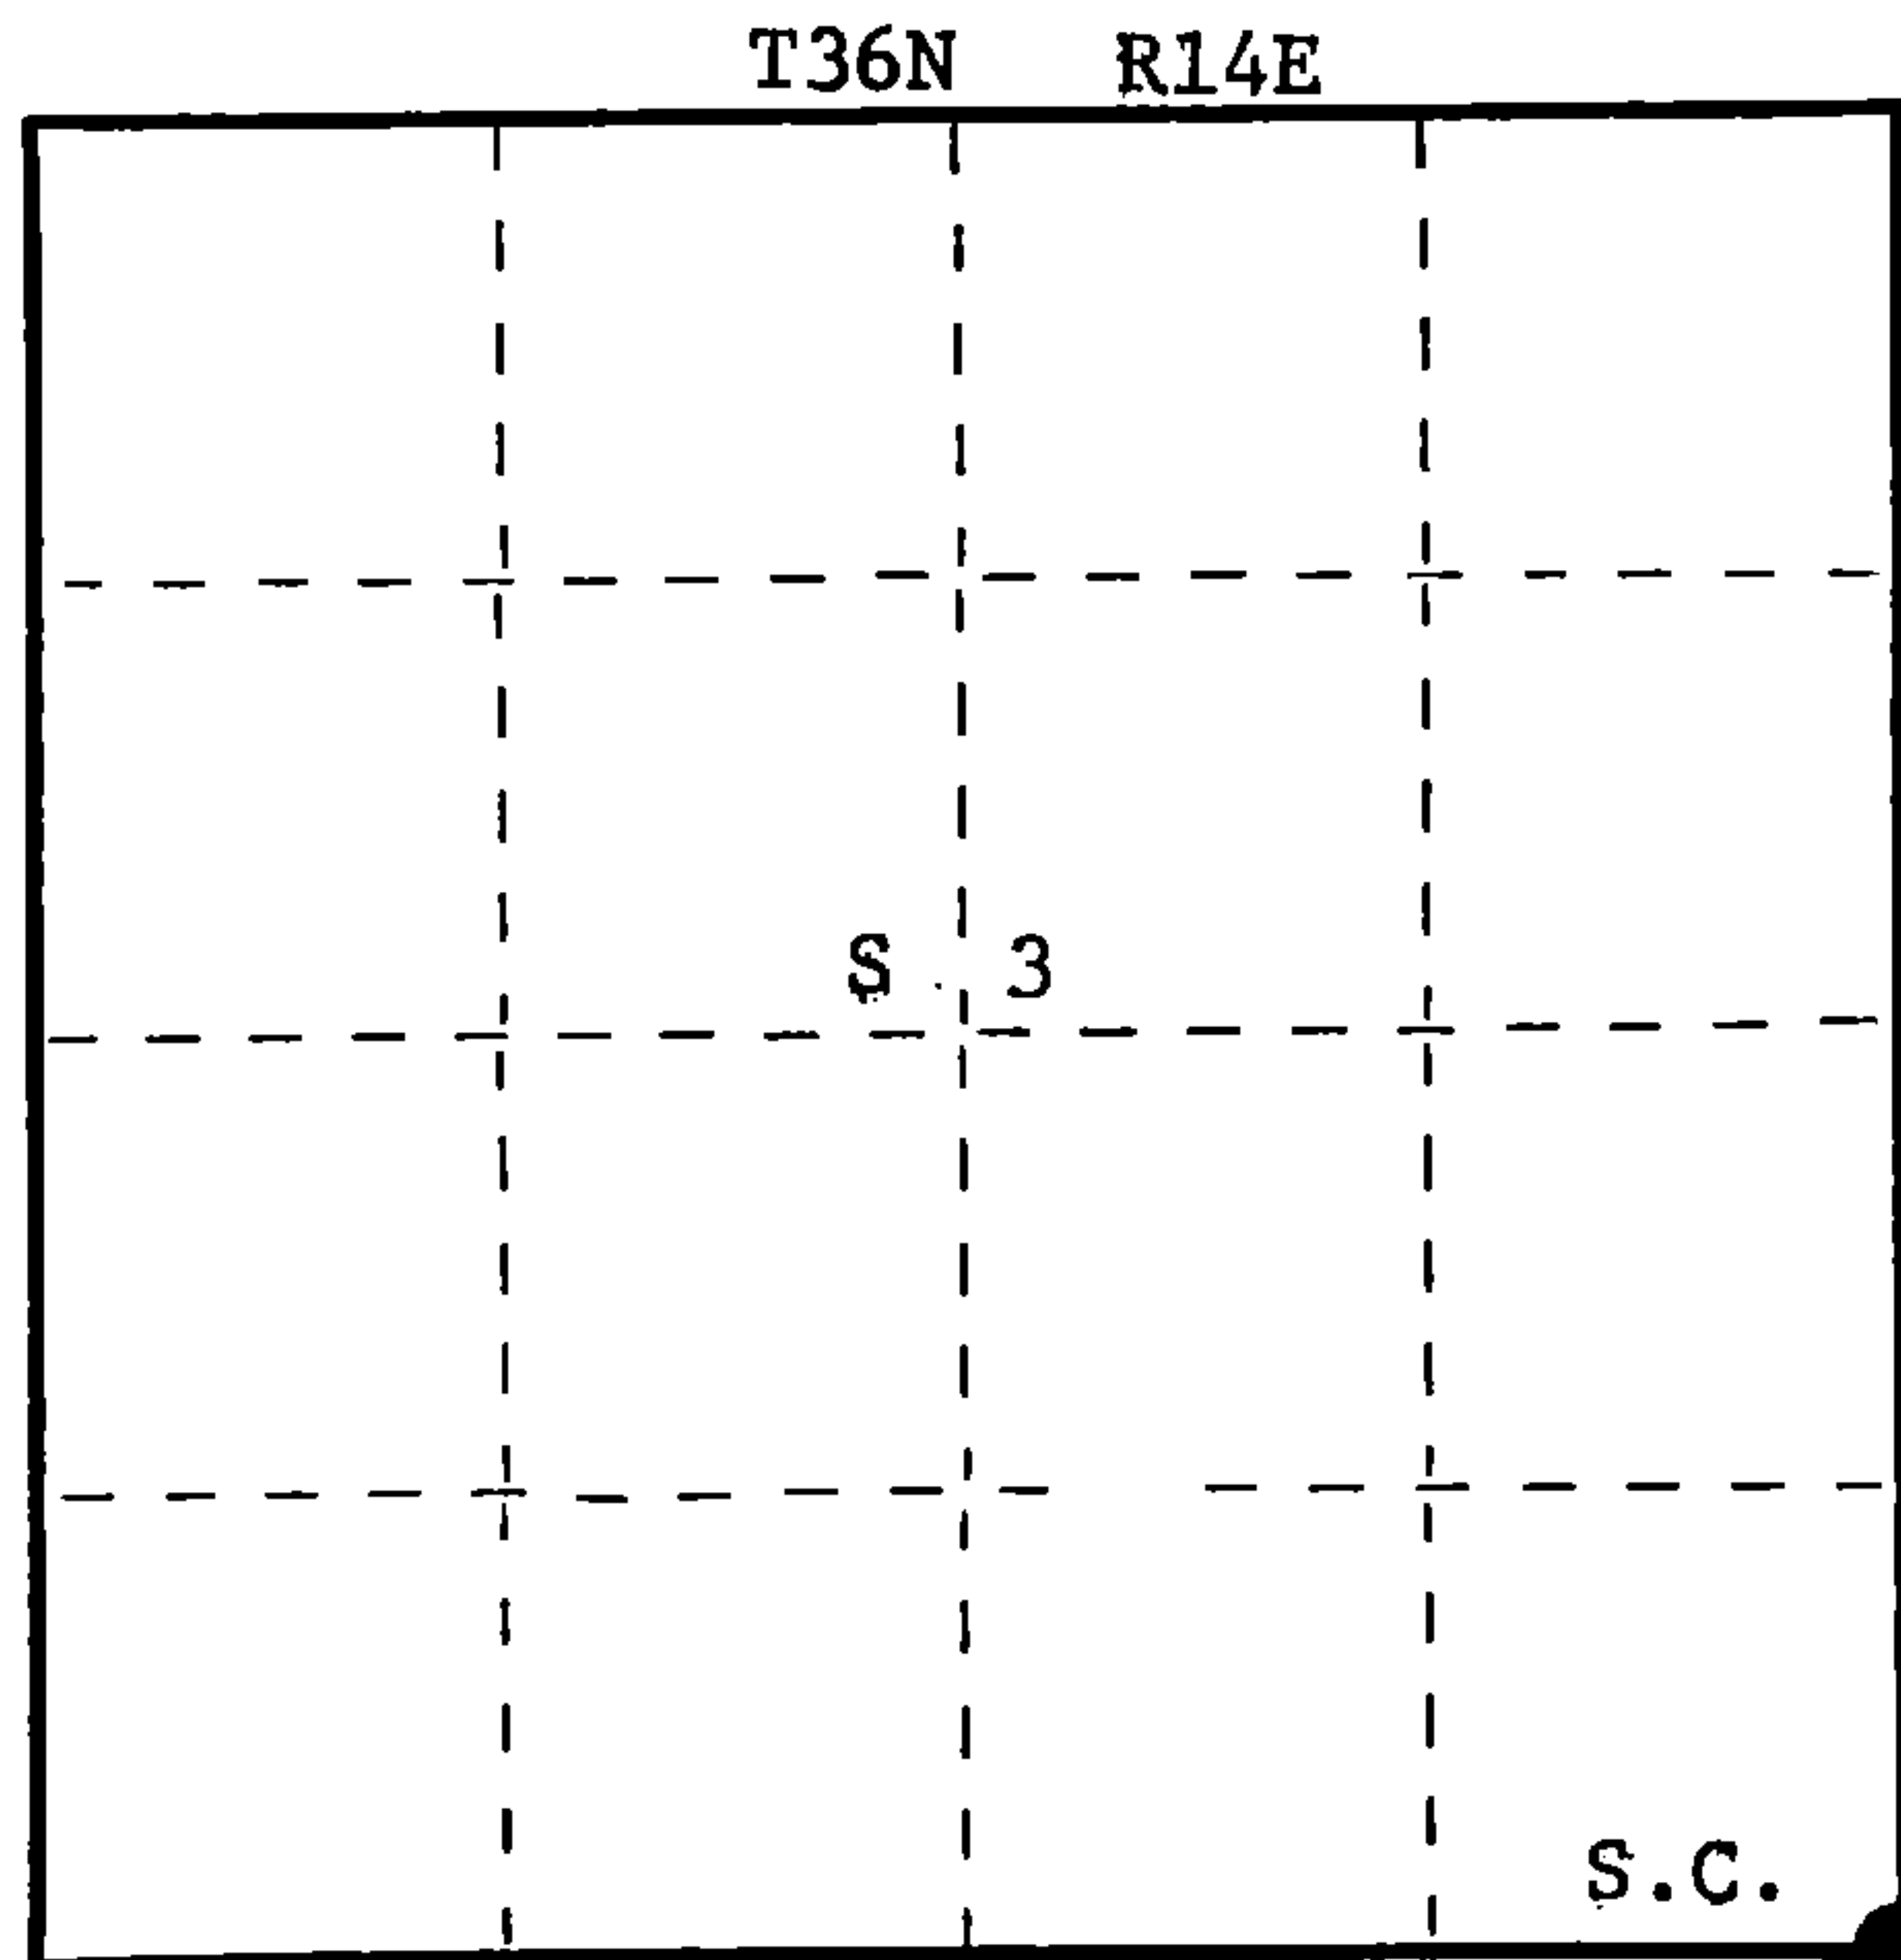

○ = Corner monument restored.

CERTIFIED LAND CORNER RESTORATION
U.S. PUBLIC LAND SURVEY

History of original corner establishment:

Original corner established by James McBride, deputy surveyor, in 1859. From which
Hemlock 12" N55W 25 links - Hemlock 20" N44E 16 links - Fir 6" S18E 10 links -
Fir 8" S79W 30 links.

Description of corner evidence found:

Recovered a 1" iron pipe unknown source. From this position checked original calls. Original has south corrected between sections 2 & 3, 76.00 chains to stream, 80.0 chains leave swamp, 80.22 chains section corner. - From this position it is 22 links (+ -) north to swamp's edge, and 4.22 chains (+ -) to creek. At a reasonable measurement, because of beaver dams, it cannot be determined where the original creek bed was. Original calls between sections 2 & 11 has west corrected 8.50 chains enter swamp, 39.80 set 1/4 corner, 53.0 chains stream 10 lks NE, 79.35 chains leave swamp. 76.90 chains section corner. From this position it is 25 links east to swamp's edge. Having surveyed to the quarter corners half mile - north - east - south and to section corner 2-3-10-11 to the west. Only the distance to south is close to the original distance. The other three being (over) Description of monument and accessories I established to perpetuate the original location of this corner.

Set a 2 1/4" aluminum Forest County monument with 3" diameter aluminum cap.
Monument projects 3" above ground.

Marked NBTs:

Black Spruce 7" N32W 19.87'
Black Spruce 10" N19E 19.54'
Black Spruce 5" N89E 12.13'
White Birch 7" S24W 12.22'

T36N R14E
S3 + S2
S10 + S11
1985
S1682

Dated at Rhinelander, Wis., this 23rd day of December, 19 85

Signature Glen Barker Title Registered Land Surveyor Registration No. S1682
(County Surveyor, Registered Land Surveyor, or other duly authorized official)

Office of Register of Deeds, County of Forest, I hereby certify that the within
instrument was filed in this office for record on the 1st day of May, 19 86.
at 10:30 o'clock A. M.

Paul Aschenbrenner
(Register of Deeds)

By _____ Deputy

- 4.) Describe any material discrepancy between the location of the corner as restored or reestablished and the location of that corner as previously restored or reestablished by distance and direction. Show the discrepancy on the plan view drawing under (d), above. Show the distances between the corner as previously restored or reestablished and (1) the corner as restored or reestablished, and (2) to at least 2 of the witness monuments shown on the drawing in (d), above.

inconsistent. On the basis of the original calls, I accepted this position, they being so close to the corner, the variables would be little.

- (f) Was the corner restored through acceptance of (1) an obliterated evidence location, or, (2) a found perpetuated location?

See front

- (g&h) Was the corner reestablished through lost corner proportionate methods? If so, show the method, including the directions and distances to other public land survey corners used as evidence or used for proportioning in determining the corner location?

- (i) 1. Glen Barker
(type or print name) certify that the corner location shown on this record was determined by me or under my direction and control and that this U.S. Public Land Survey Monument Record is correct and complete to the best of my knowledge and belief.

Signature

Date

