

CERTIFIED LAND CORNER RESTORATION

Index No. **E 13**


State of Wisconsin }
County of Forest } ss.

I Philip T. Hansen, do hereby certify that on the 8th day of December, 1975, I found evidence of the Section corner of Sections 3, 4, 9, and 10 Township 36 North, Range 14 East, Fourth Principal Meridian, as described hereon; and that from this evidence I established a new monument and accessories as described hereon to perpetuate the original location of this corner.


Resident witnesses:

Glen Barker

Jim Claflin

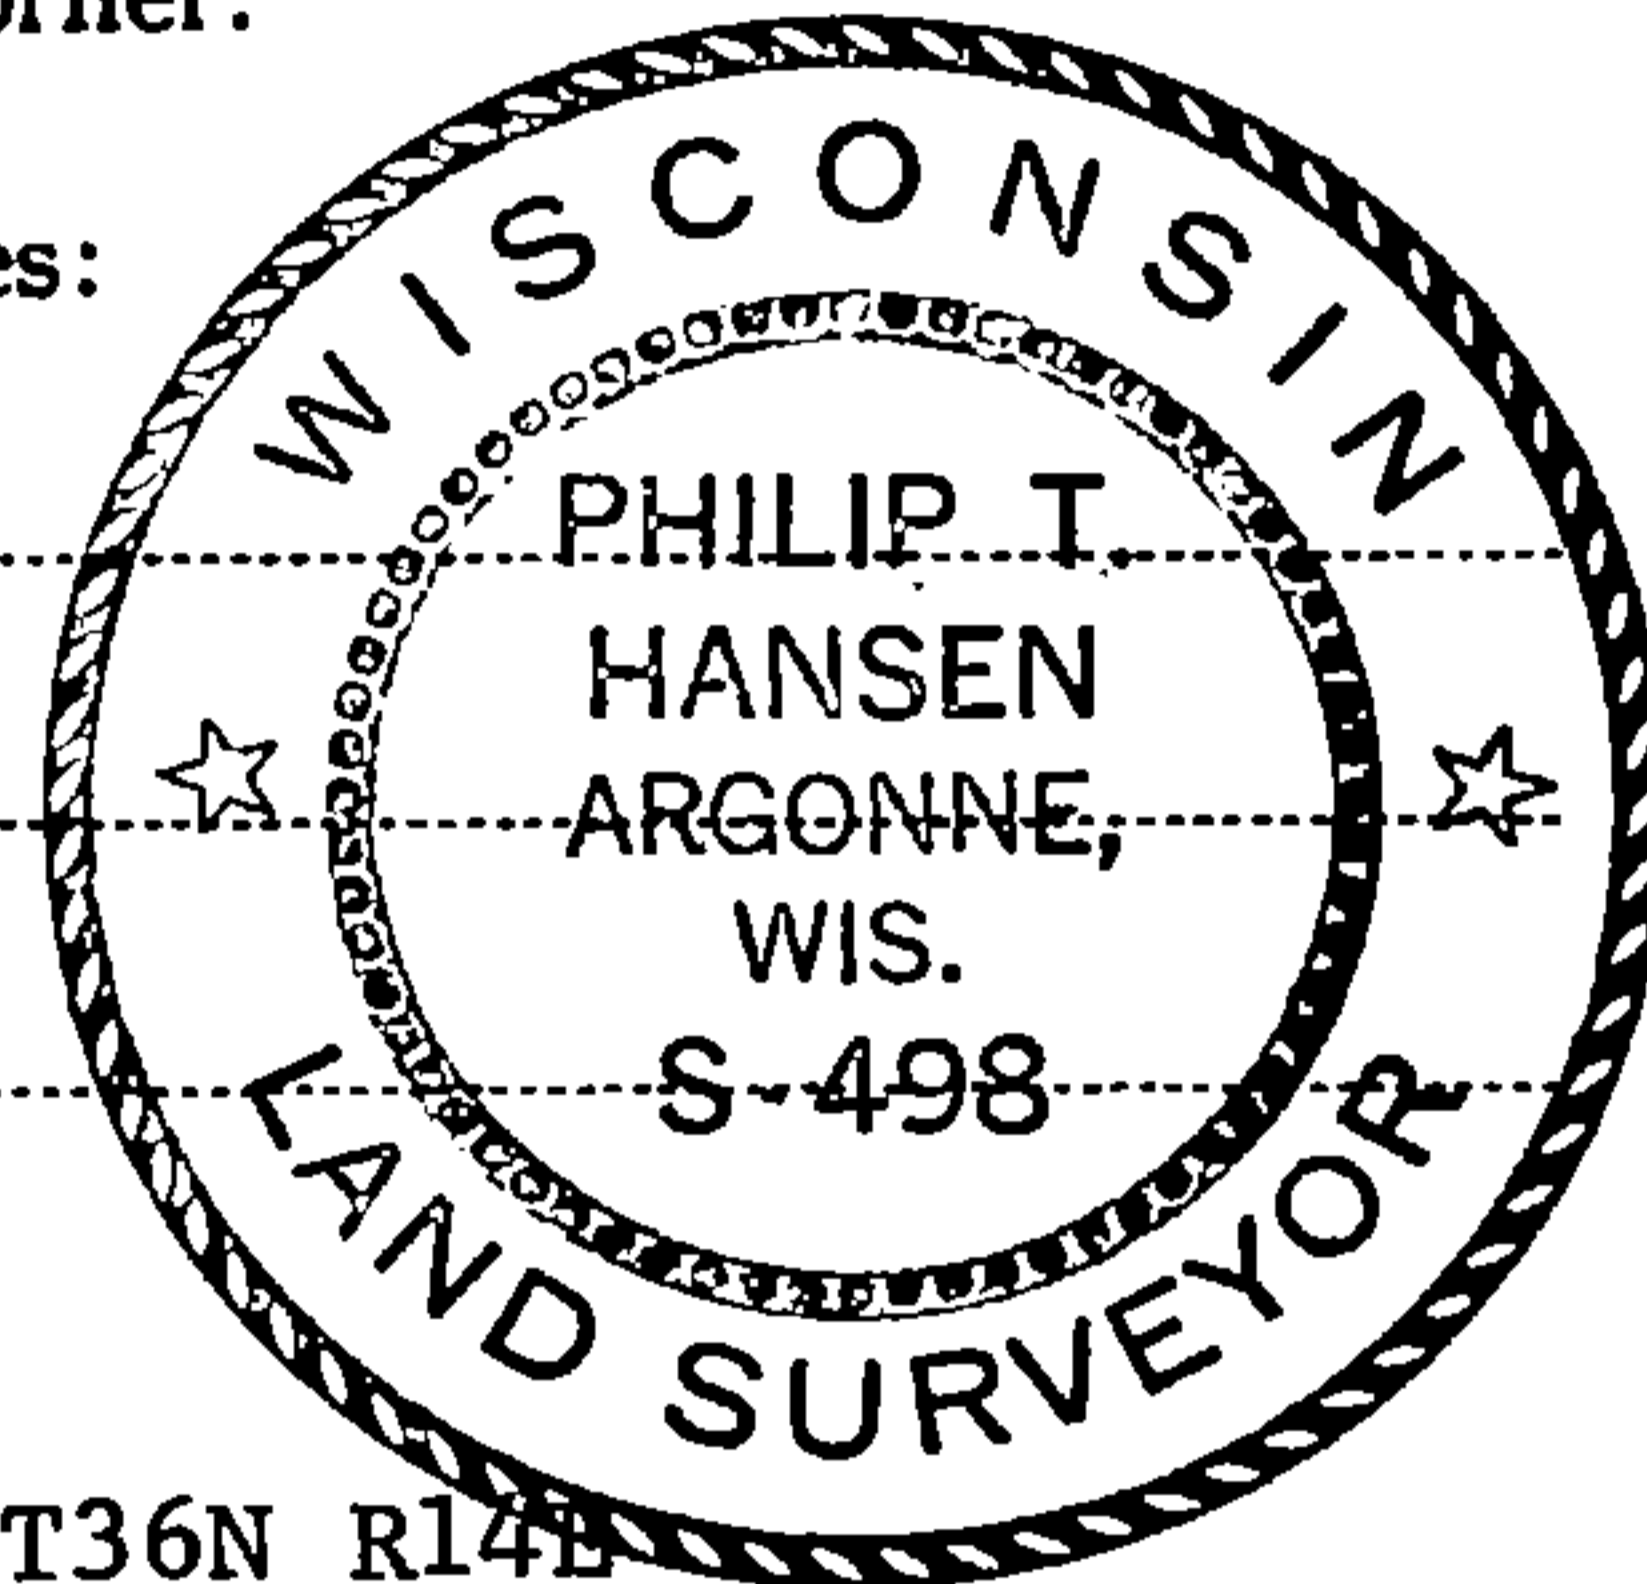

T36N R14E

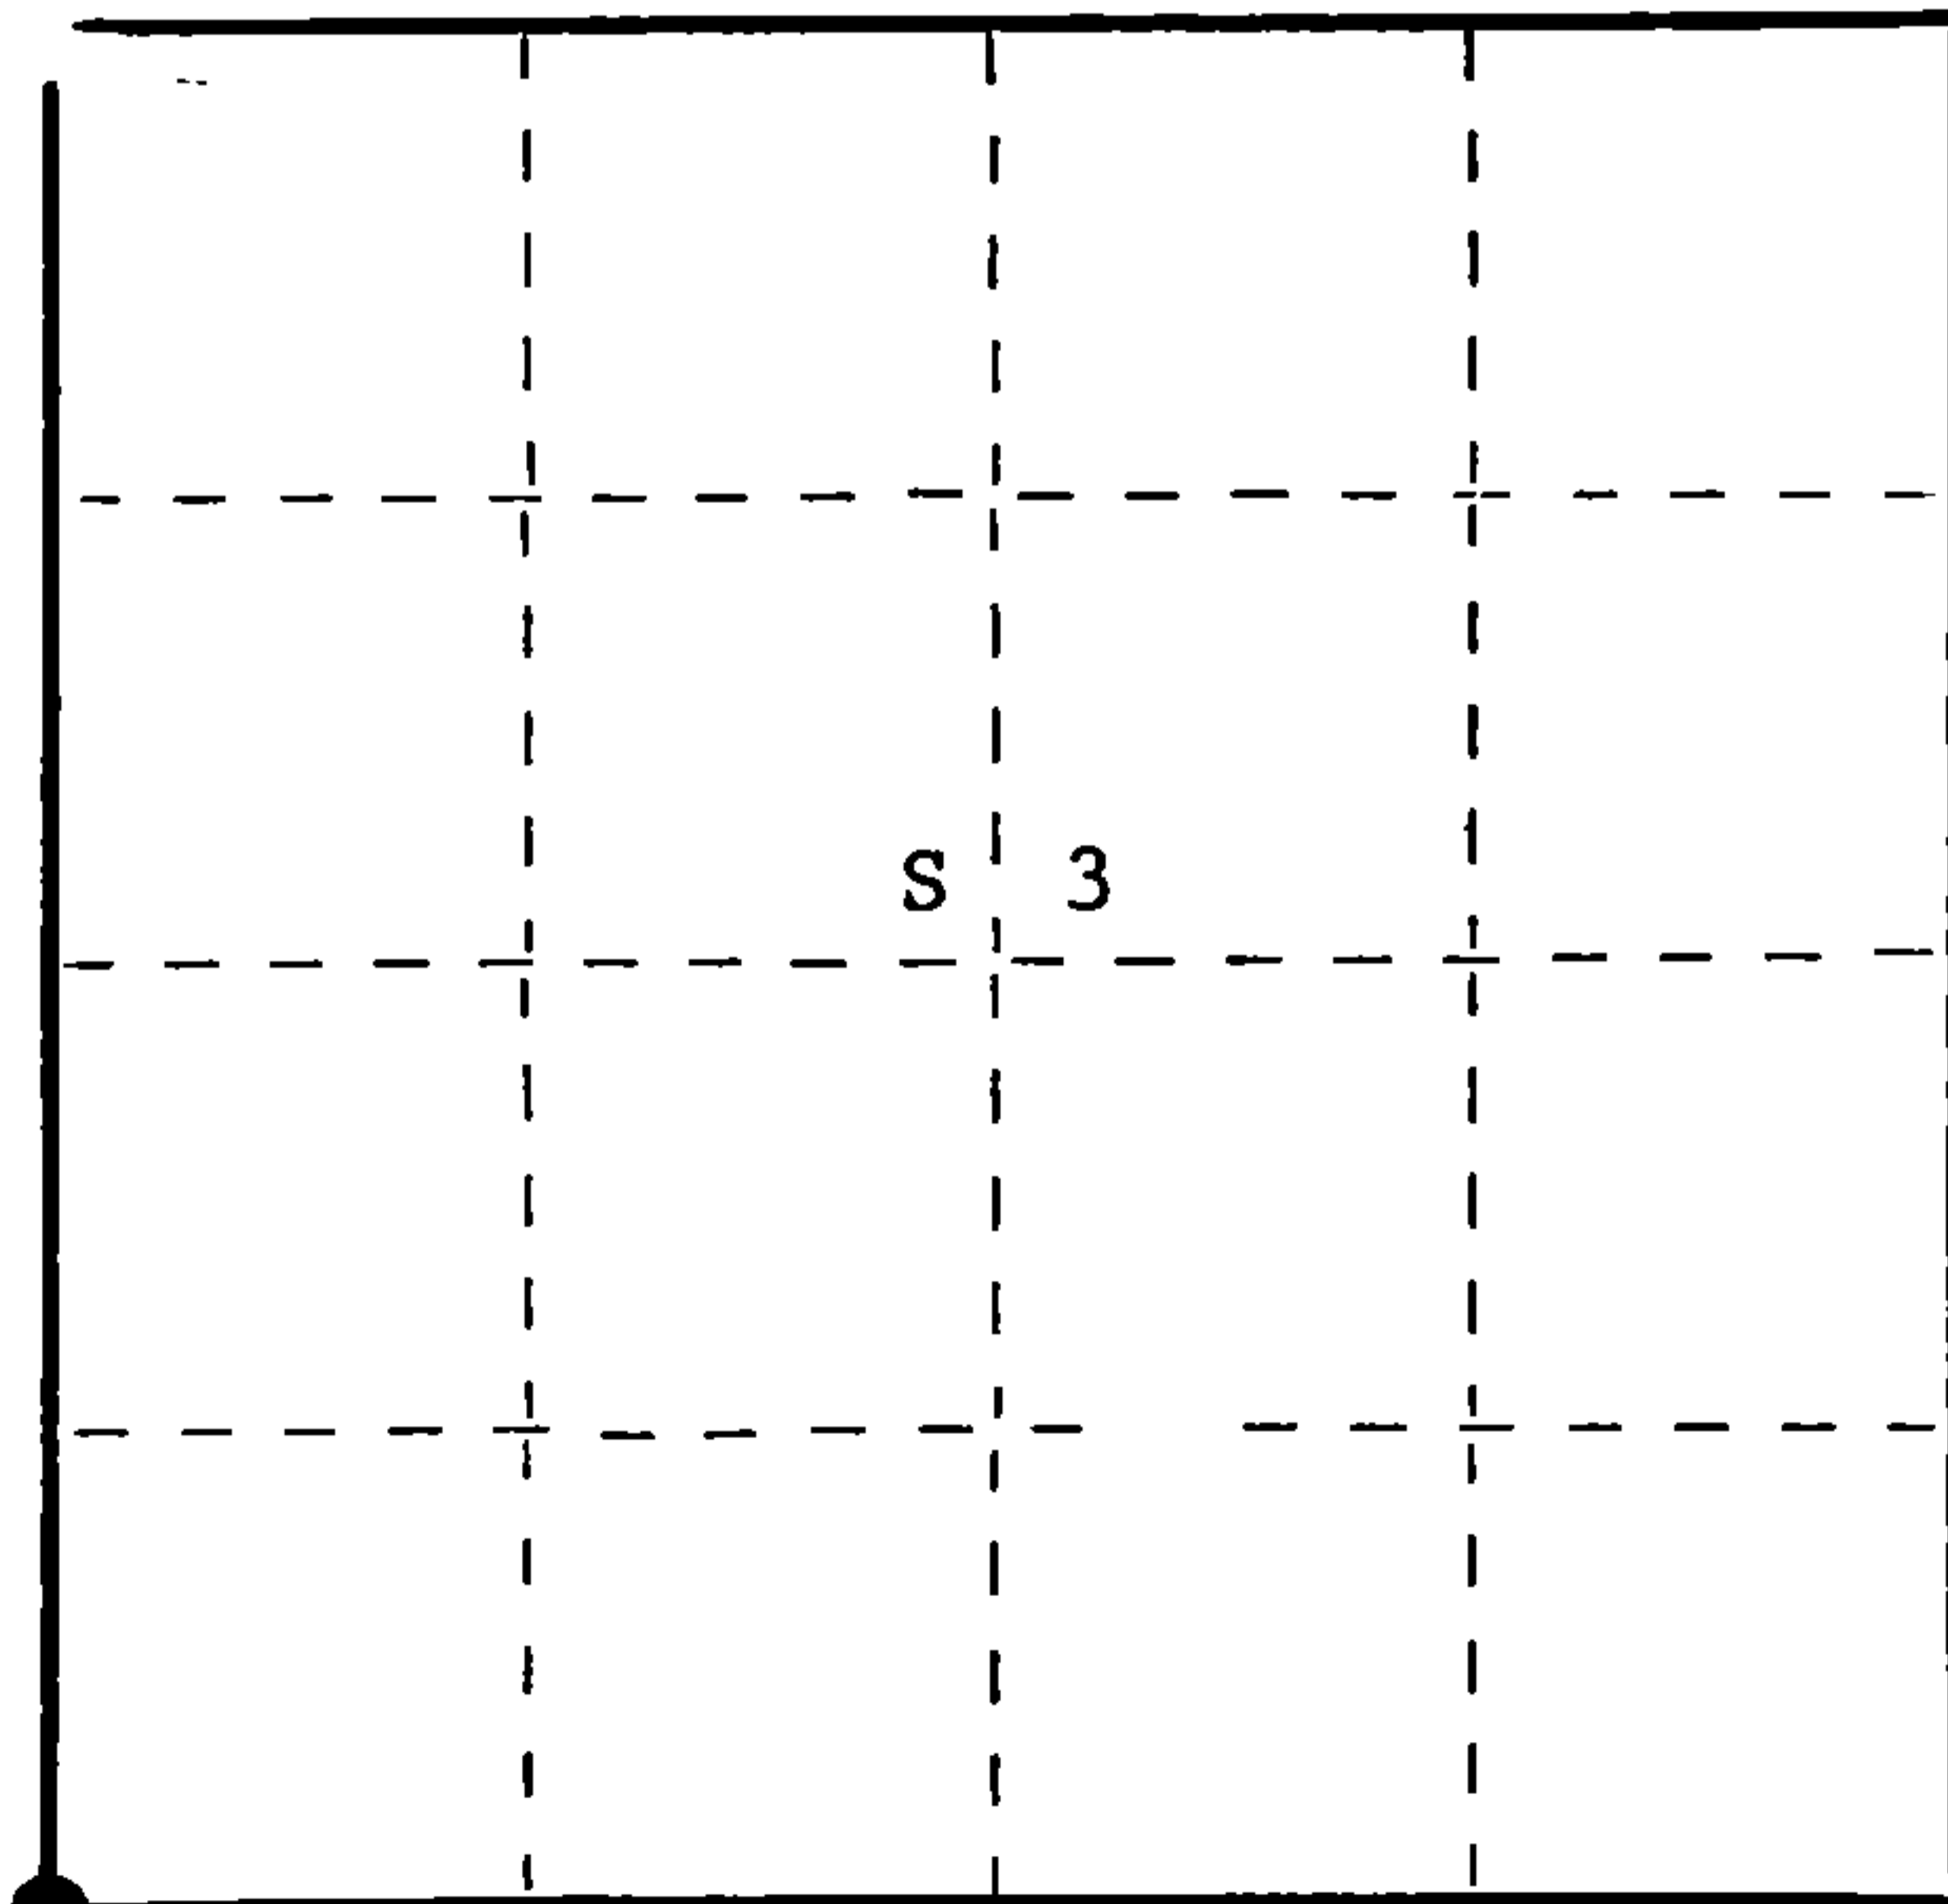

○ = Corner monument restored.

History of original corner establishment: Original corner established by James McBride in 1859, from which hemlock 10" bears N16°W 20 links, hemlock 18" bears N27°E 92 links, spruce 8" bears S28°E 52 links, cedar 10" bears S60°W 37 links.

This corner was recovered by E.B. Hurst, Consolidated Forester, and P. Hansen, in 1932 while running lines for acquisition purposes. Corner maintained by Ray Leigh, Consolidated Forester, about 1945. Replaced old post with 7" squared cedar post.

Description of corner evidence found: Recovered 7" cedar post, squared and scribed, with rock cairn placed around base. Post was in good condition.

Recovered OBT - sugar 12" S89°E 24 links, scribed S10 BT.

No evidence of original BT's found. This area was cut in the '30's.

Description of monument and accessories I established to perpetuate the original location of this corner.

Replaced 7" cedar post with 2½" Berntsen A-1 Federal Monument, aluminum, with magnet installed in cap and base. Pipe projects 18" above ground. Cap stamped -

NBT's - Sugar 10" N74°W 72.7 links, scribed SC BT.
Elm 7" S58°W 14.5 links, scribed SC BT.

Pipe and BT's painted blue.

S498
T36N R14E
Sec. 4 | 3
9 | 10
1975

Dated at Argonne, Wis., this 15th day of December, 1975

Signature *Philip T. Hansen* Title Registered Land Surveyor Registration No. S-498
(County Surveyor, Registered Land Surveyor, or other duly authorized official)

Office of Register of Deeds, County of Forest, I hereby certify that the within instrument was filed in this office for record on the 5th day of January, 1976 at 2:45 o'clock P.M.

DOCUMENT NUMBER -- **108492**

EUGENE STATEZNY

(Register of Deeds)

By *Eileen Schmidt* Deputy

FORM 985 R. C. MILLER CO., MILWAUKEE

43614040000