

CERTIFIED LAND CORNER RESTORATION

State of Wisconsin }
County of Forest } ss.


I, Philip T. Hansen, do hereby certify that on the 12th day of January, 1976, I found evidence of the Quarter corner of Sections 10 and 15 Township 36 North, Range 14 East, Fourth Principal Meridian, as described hereon; and that from this evidence I established a new monument and accessories as described hereon to perpetuate the original location of this corner.

Resident witnesses:


Glen Barker

Jim Claflin

Tom Jewell

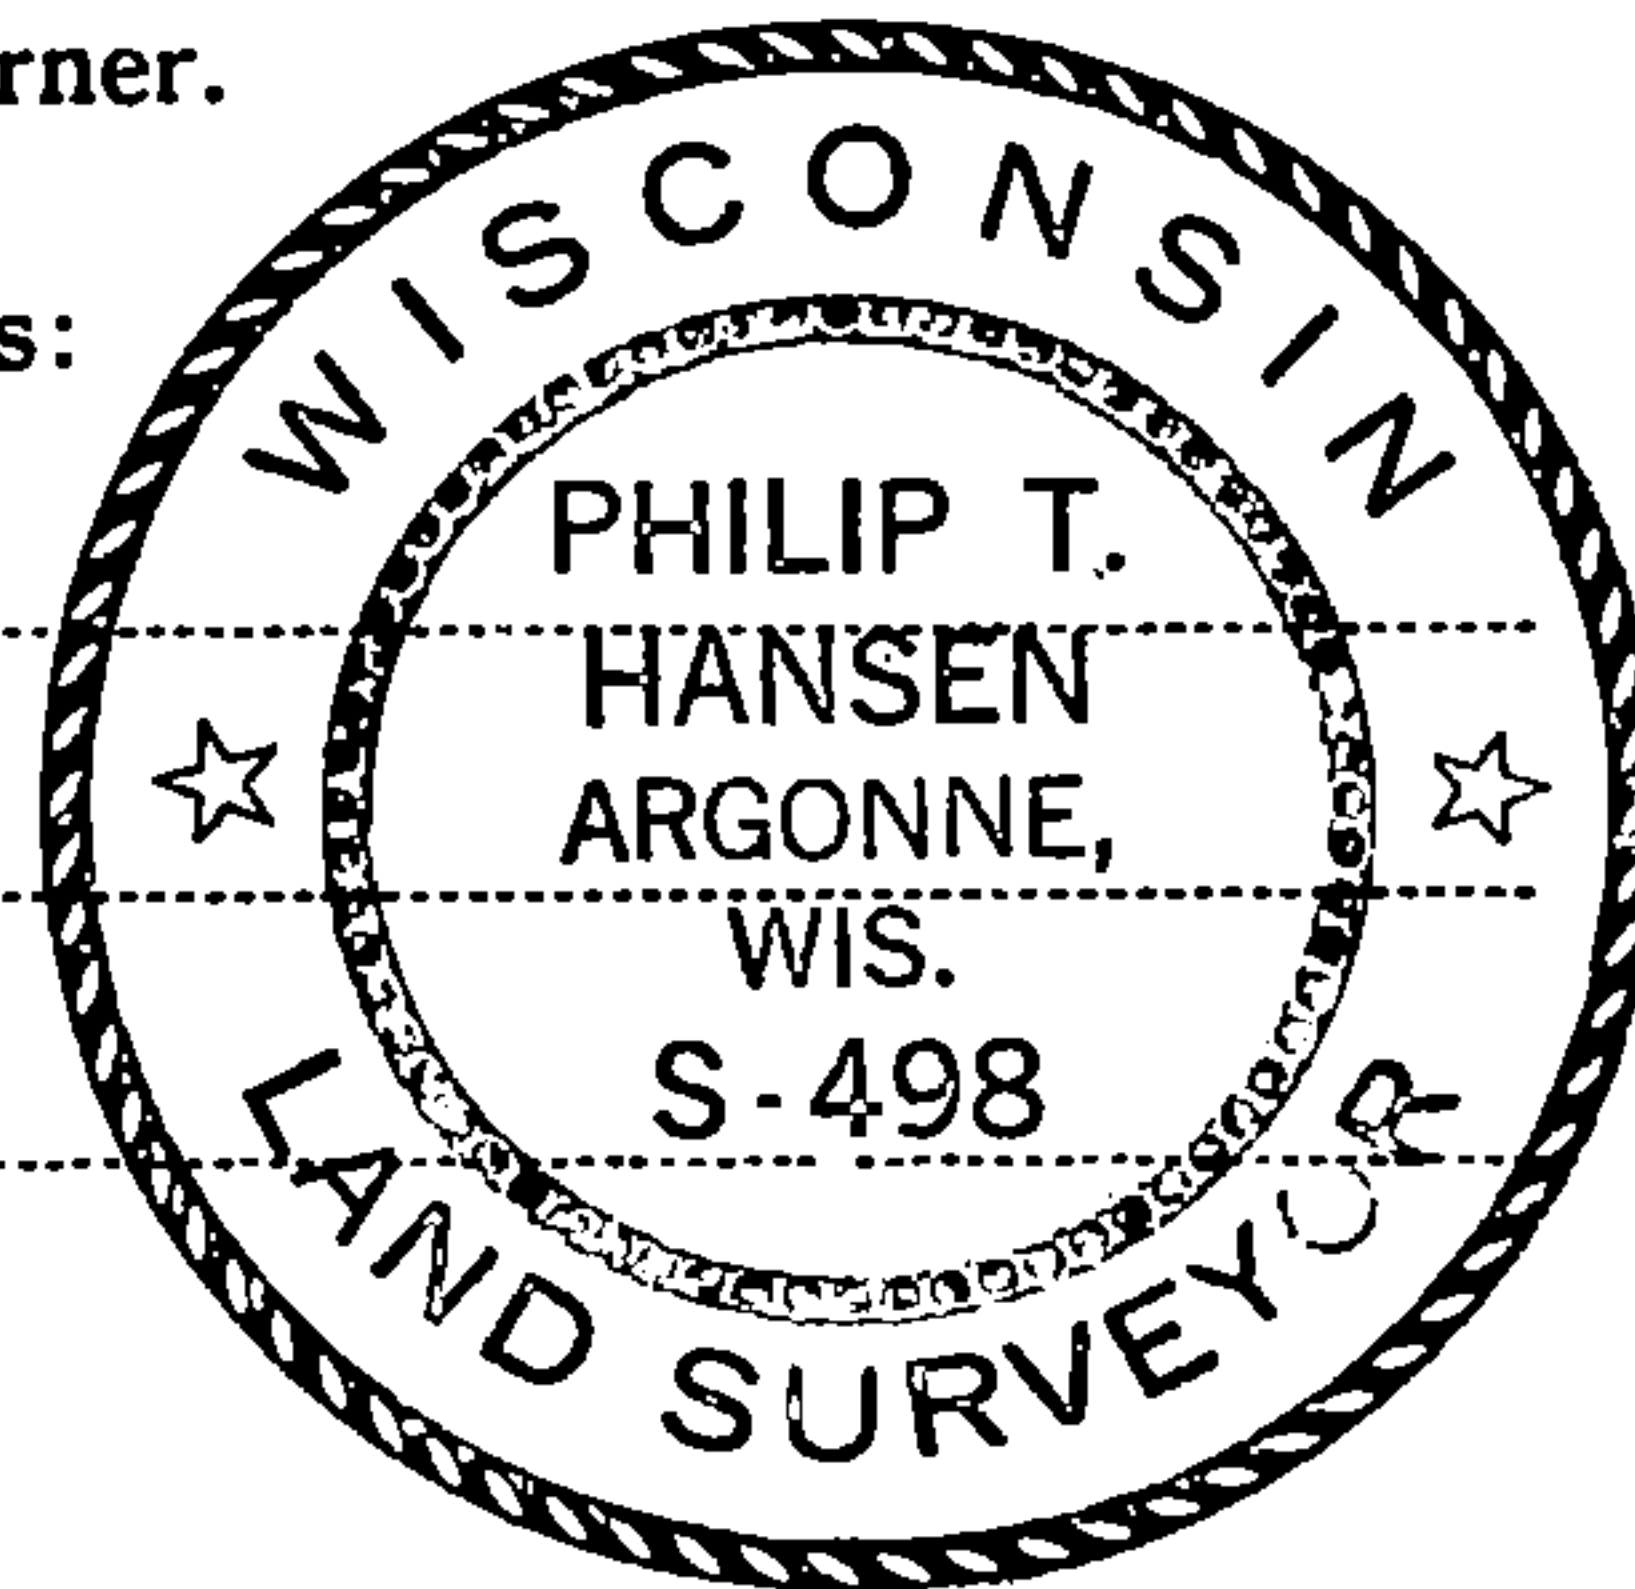

FORM 985 H. C. MILLER CO., MILWAUKEE

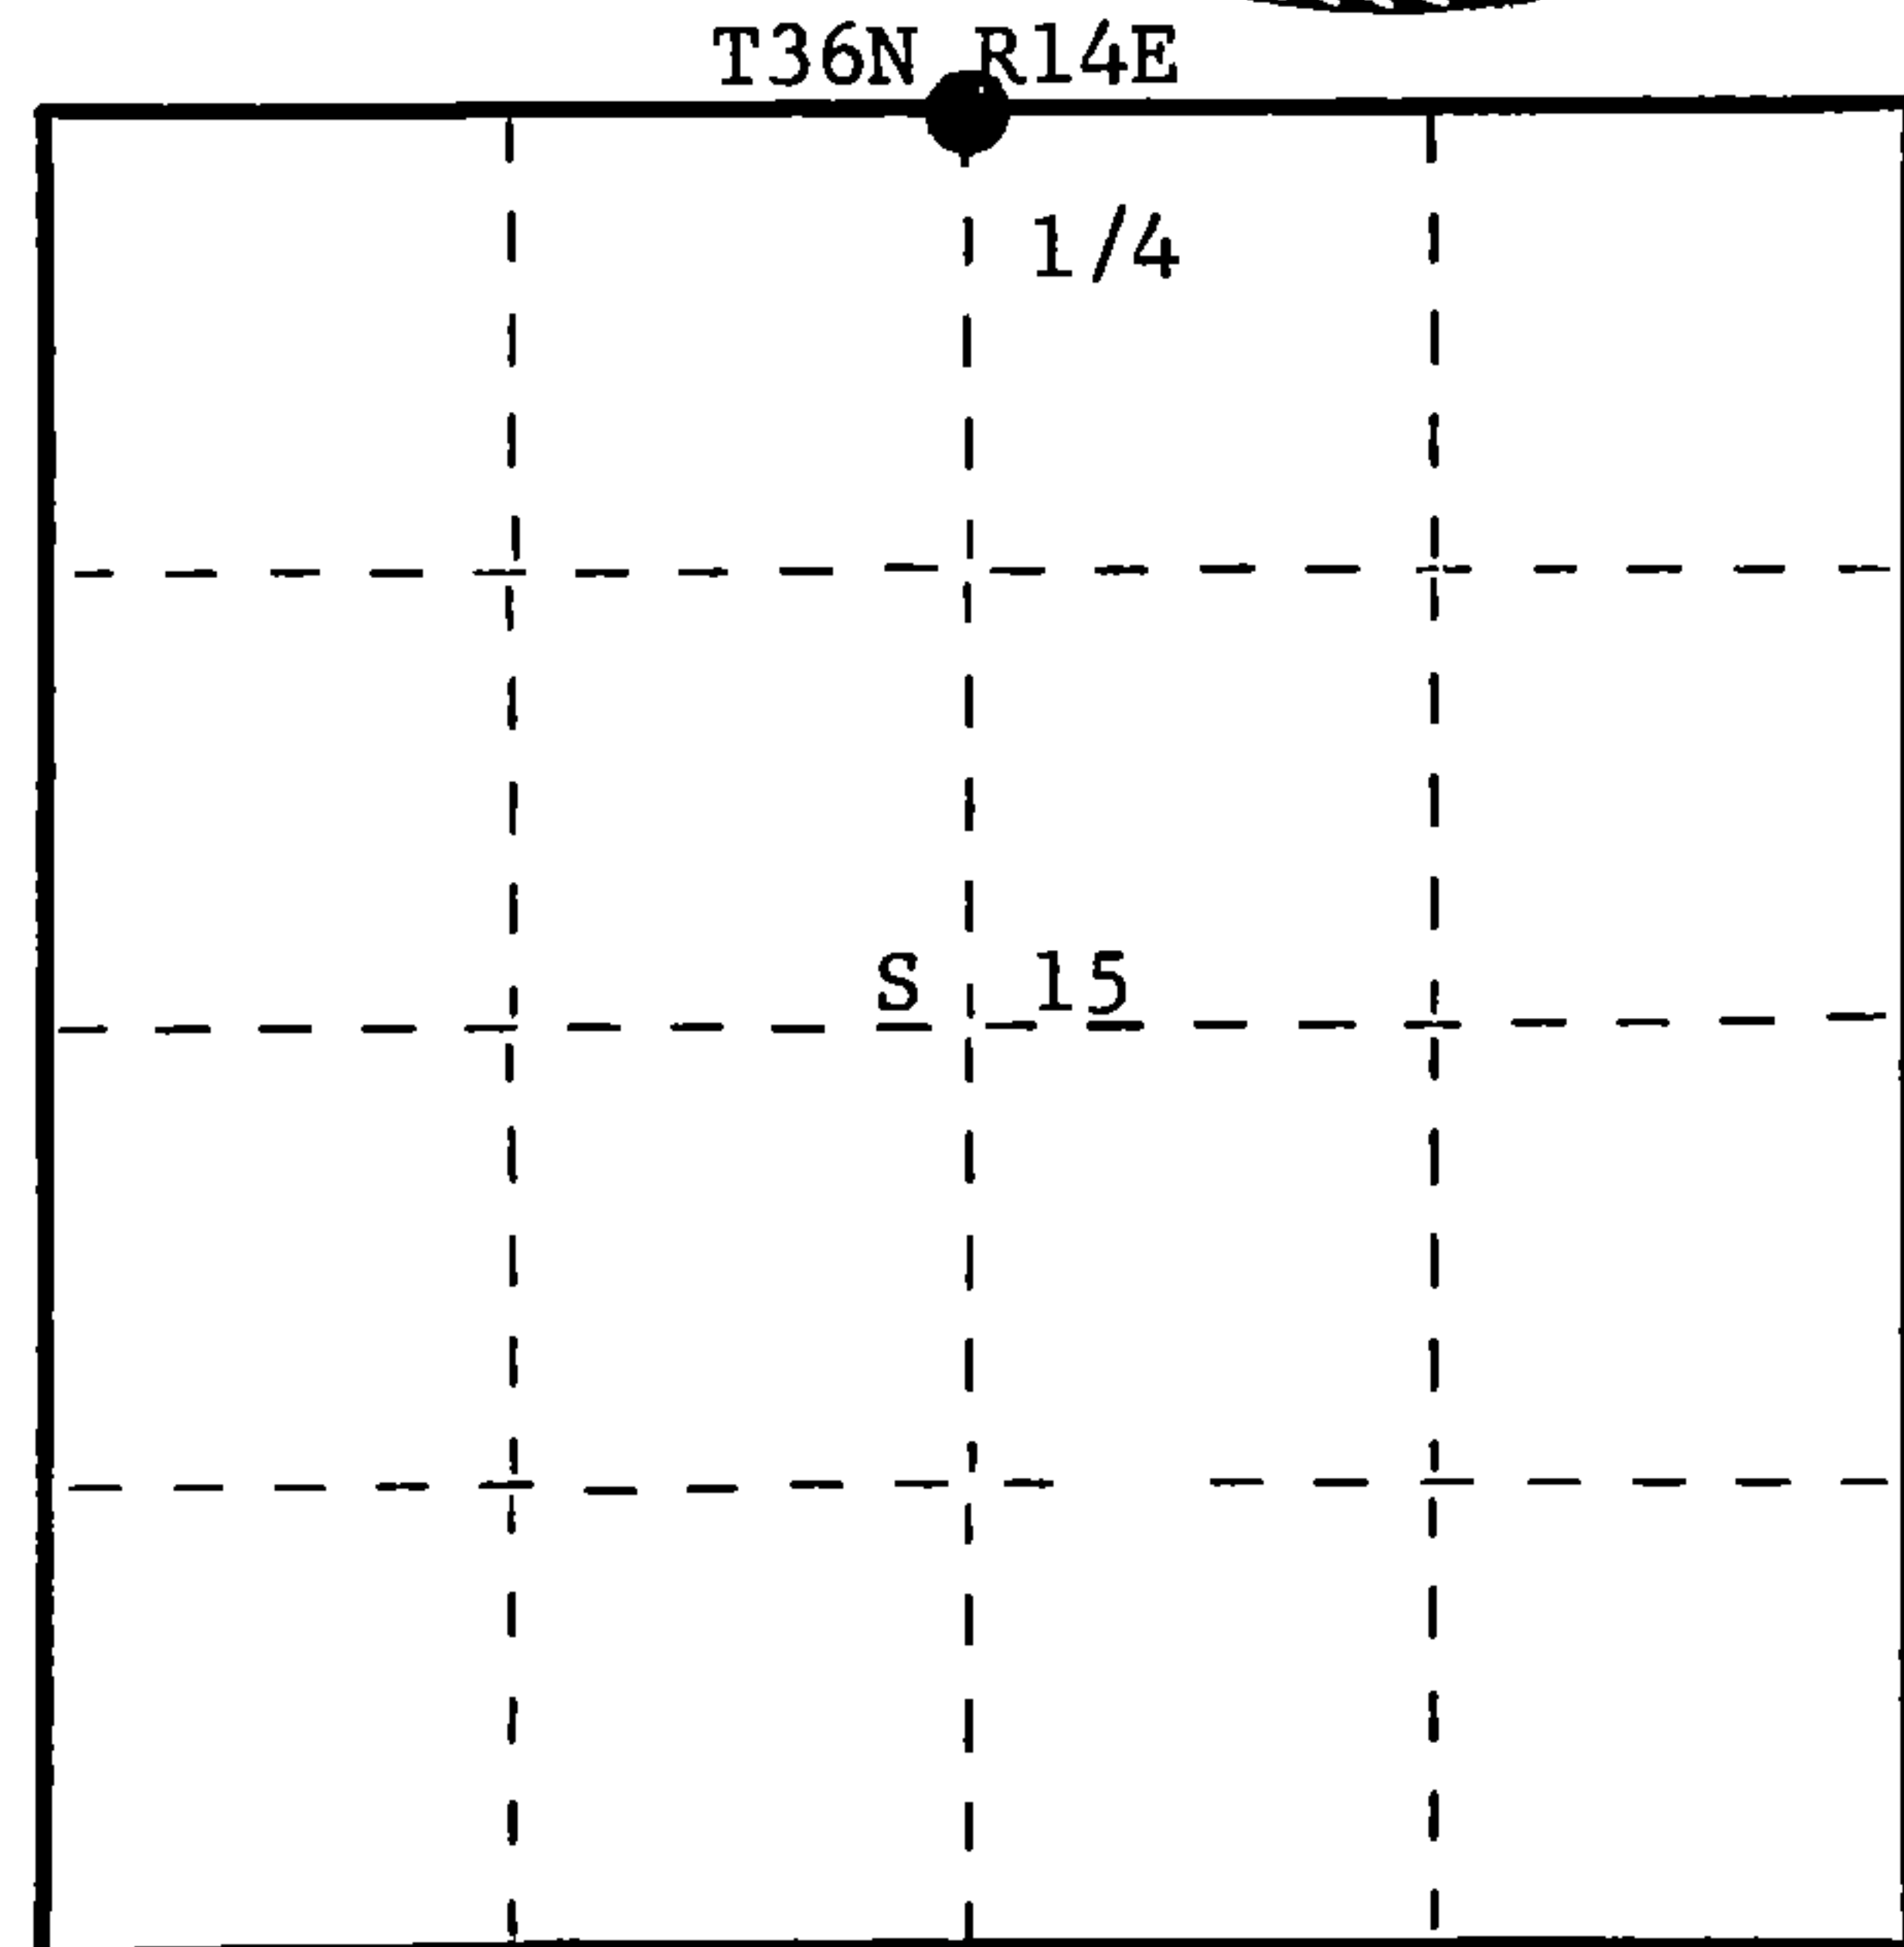

○ = Corner monument restored.

History of original corner establishment:

Original corner established by James McBride, Deputy Surveyor, in 1859, from which cedar 10" bears N16°W, 18 links and cedar 12" bears S30°E, 20 links. Corner recovered by Ray Leigh, Consolidated forester, in 1949. Recovered old wooden post, replaced with squared and scribed 4" cedar post, maintained by Consolidated and Connor Forest Industries foresters since 1949.

Description of corner evidence found:

Recovered 4" cedar post, squared and scribed 1/4S S10, 1/4S S15, in poor condition, but still standing in place.

Recovered OBT's - Hemlock 12" N70°E 32 links - scribed 1/4S BT
Sugar 7" S56°W 30 links - scribed 1/4S BT

Description of monument and accessories I established to perpetuate the original location of this corner.

Replaced 4" cedar post with 2-1/2" Berntsen, A-1 Federal Monument, aluminum with magnet installed in cap and base. Pipe projects 18" above ground.

Cap stamped -

S498

Wood post set up beside new pipe.

T36N R14E

NBT - Sugar 8" N68°W 29.1 links - scribed 1/4 BT.

Pipe, post, and BT's painted blue.

1/4 S|10
S|15

1975

Dated at Argonne, Wis., this 19th day of January, 1976.

Signature *Philip T. Hansen* Title Registered Land Surveyor Registration No. S-498
(County Surveyor, Registered Land Surveyor, or other duly authorized official)

Office of Register of Deeds, County of Forest, I hereby certify that the within instrument was filed in this office for record on the 4th day of February, 1976 at 4:00 o'clock P. M.

Eugene Staszynski
(Register of Deeds)

DOCUMENT NUMBER -- 108710

By _____ Deputy

43014100020