

CERTIFIED LAND CORNER RESTORATION
U.S. PUBLIC LAND SURVEY

Index No. N-15

History of original corner establishment:

Original corner established by James McBride, Deputy Gov't Surveyor in 1859 from which a 8" Cedar bears N64W, 4 lks. and a 8" Fir bears S2W, 18 lks.

State of Wisconsin }
County of FOREST } ss.

I Glen Barker, do hereby certify that on the 5th day of November, 1991, I established the Quarter Section corner of Section 15 & 22 Township 36 North, Range 14 East, Fourth Principal Meridian, as described hereon; and that from this evidence I established a new monument and accessories as described hereon to perpetuate the original location of this corner.

Resident witnesses:

N. Spiess

J. Spiess

Description of corner evidence found:

Recovered a 3" x 3" squared post rotted off at the base, scribed 1/4. Found point of same in muck. A 4" x 4" rough squared post along side point. Also a 1 - 1/2" iron pipe 5' long.

A 8" Cedar old blazes on three sides bears N65E, 11.0'. A 12" Cedar root crown blaze bears N57E, 10.0'.

This position has been witnessed for many years by C.P.I. and Connor Lumber Co. Foresters.


Description of monument and accessories I established to perpetuate the original location of this corner.

Replaced old point with a 2 - 1/4" Aluminum Forest County Monument with 3 - 1/4" alloy cap stamped. Monument projects 6" above ground.

MARKED N.B.T.'s:

6"	Black Spruce	N35E	63.19'
9"	Cedar	S69E	34.63'
12"	Cedar	S52W	30.52'
10"	Cedar	N57W	29.78'

	T36N	R14E
1/4	S	15
	S	22
	1991	
	S1682	
	FOREST COUNTY	

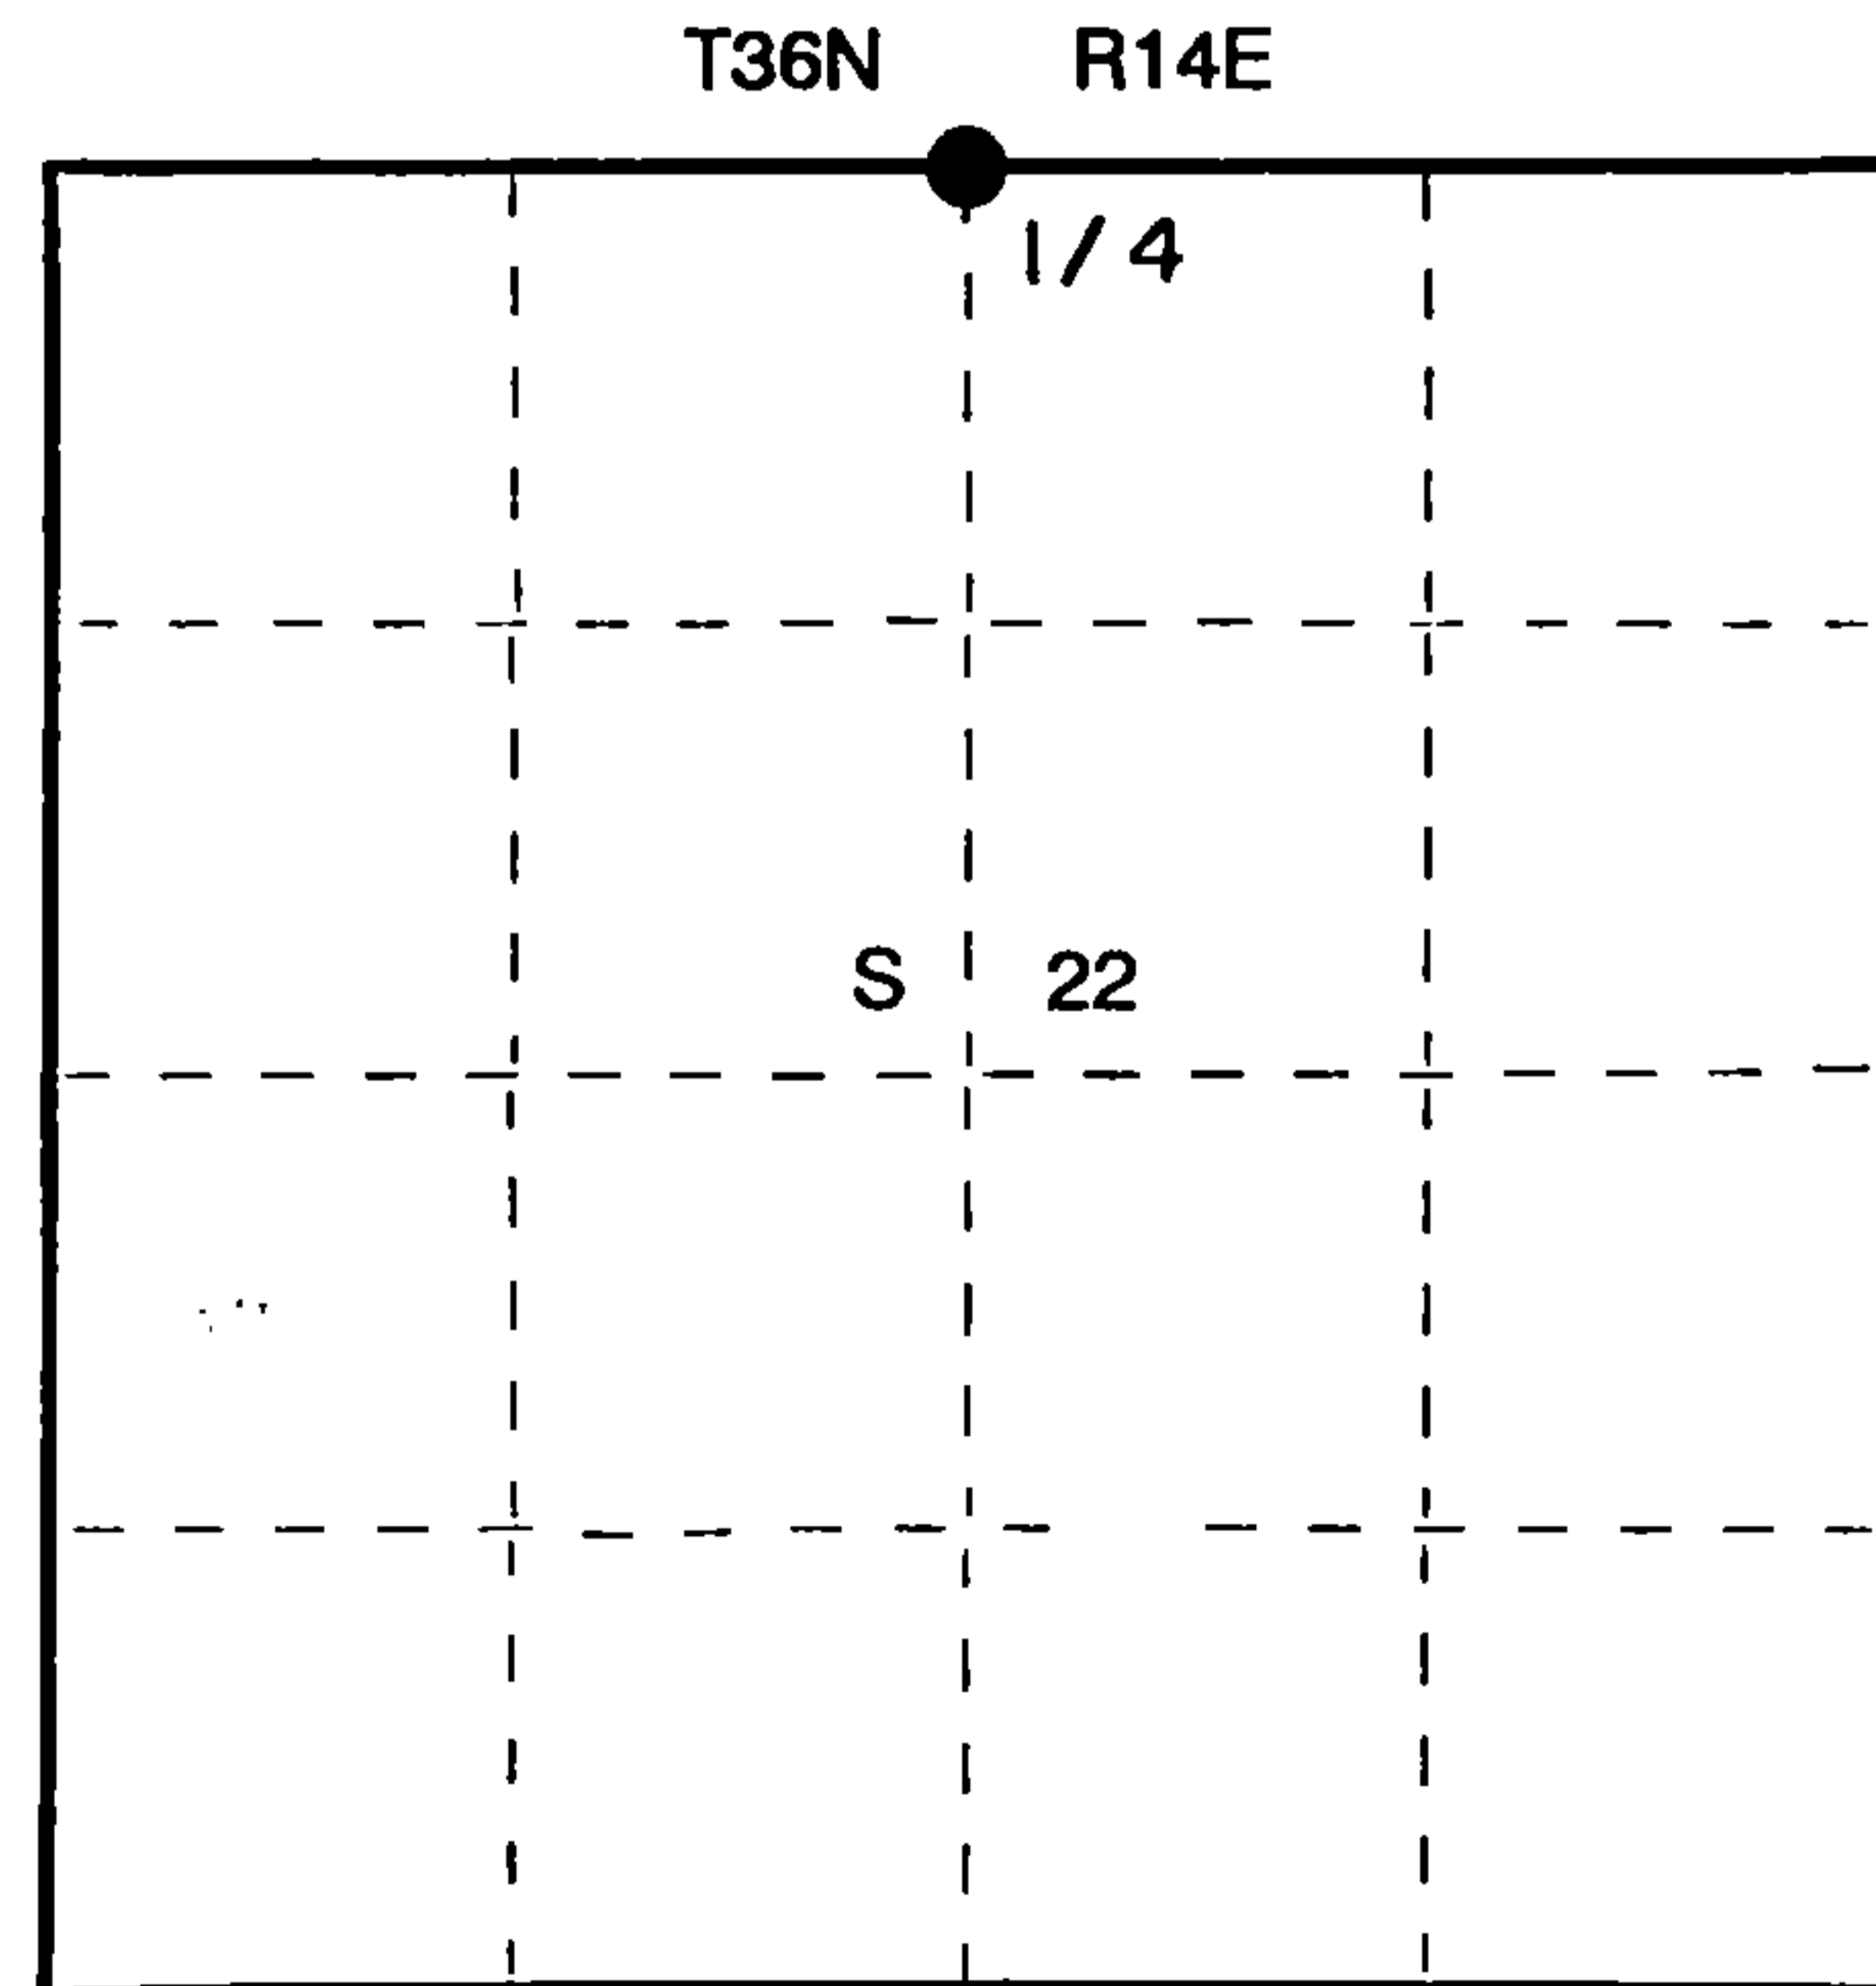

○ = Corner monument restored.

Dated at Rhineland, Wis., this 24th day of April, 1992

Signature Glen Barker Title Registered Land Surveyor Registration No. S-1682
(County Surveyor, Registered Land Surveyor, or other duly authorized official)

Office of Register of Deeds, County of Forest, I hereby certify that the within instrument was filed in this office for record on the 13th day of August, 1992 at 9:30 o'clock A. M.

Paul Hochstetler
(Register of Deeds)

By _____ Deputy

DOCUMENT NUMBER

145202

FORM 985 H. C. MILLER CO., MILWAUKEE

43614150020

e) Describe any material discrepancy between the location of the corner as restored or reestablished and the location of that corner as previously restored or reestablished by distance and direction. Show the discrepancy on the plan view drawing under (d), above. Show the distances between the corner as previously restored or reestablished and (1) the corner as restored or reestablished, and (2) to at least 2 of the monuments shown on the drawing in (d), above.


(f) Was the corner restored through acceptance of (1) an obliterated evidence location, (2) a found perpetuated location?

Perpetuated location

(g&h) Was the corner reestablished through lost corner proportionate methods? If so, the method, including the directions and distances to other public land survey corners as evidence or used for proportioning in determining the corner location?



Recovered
1/4 Cor.

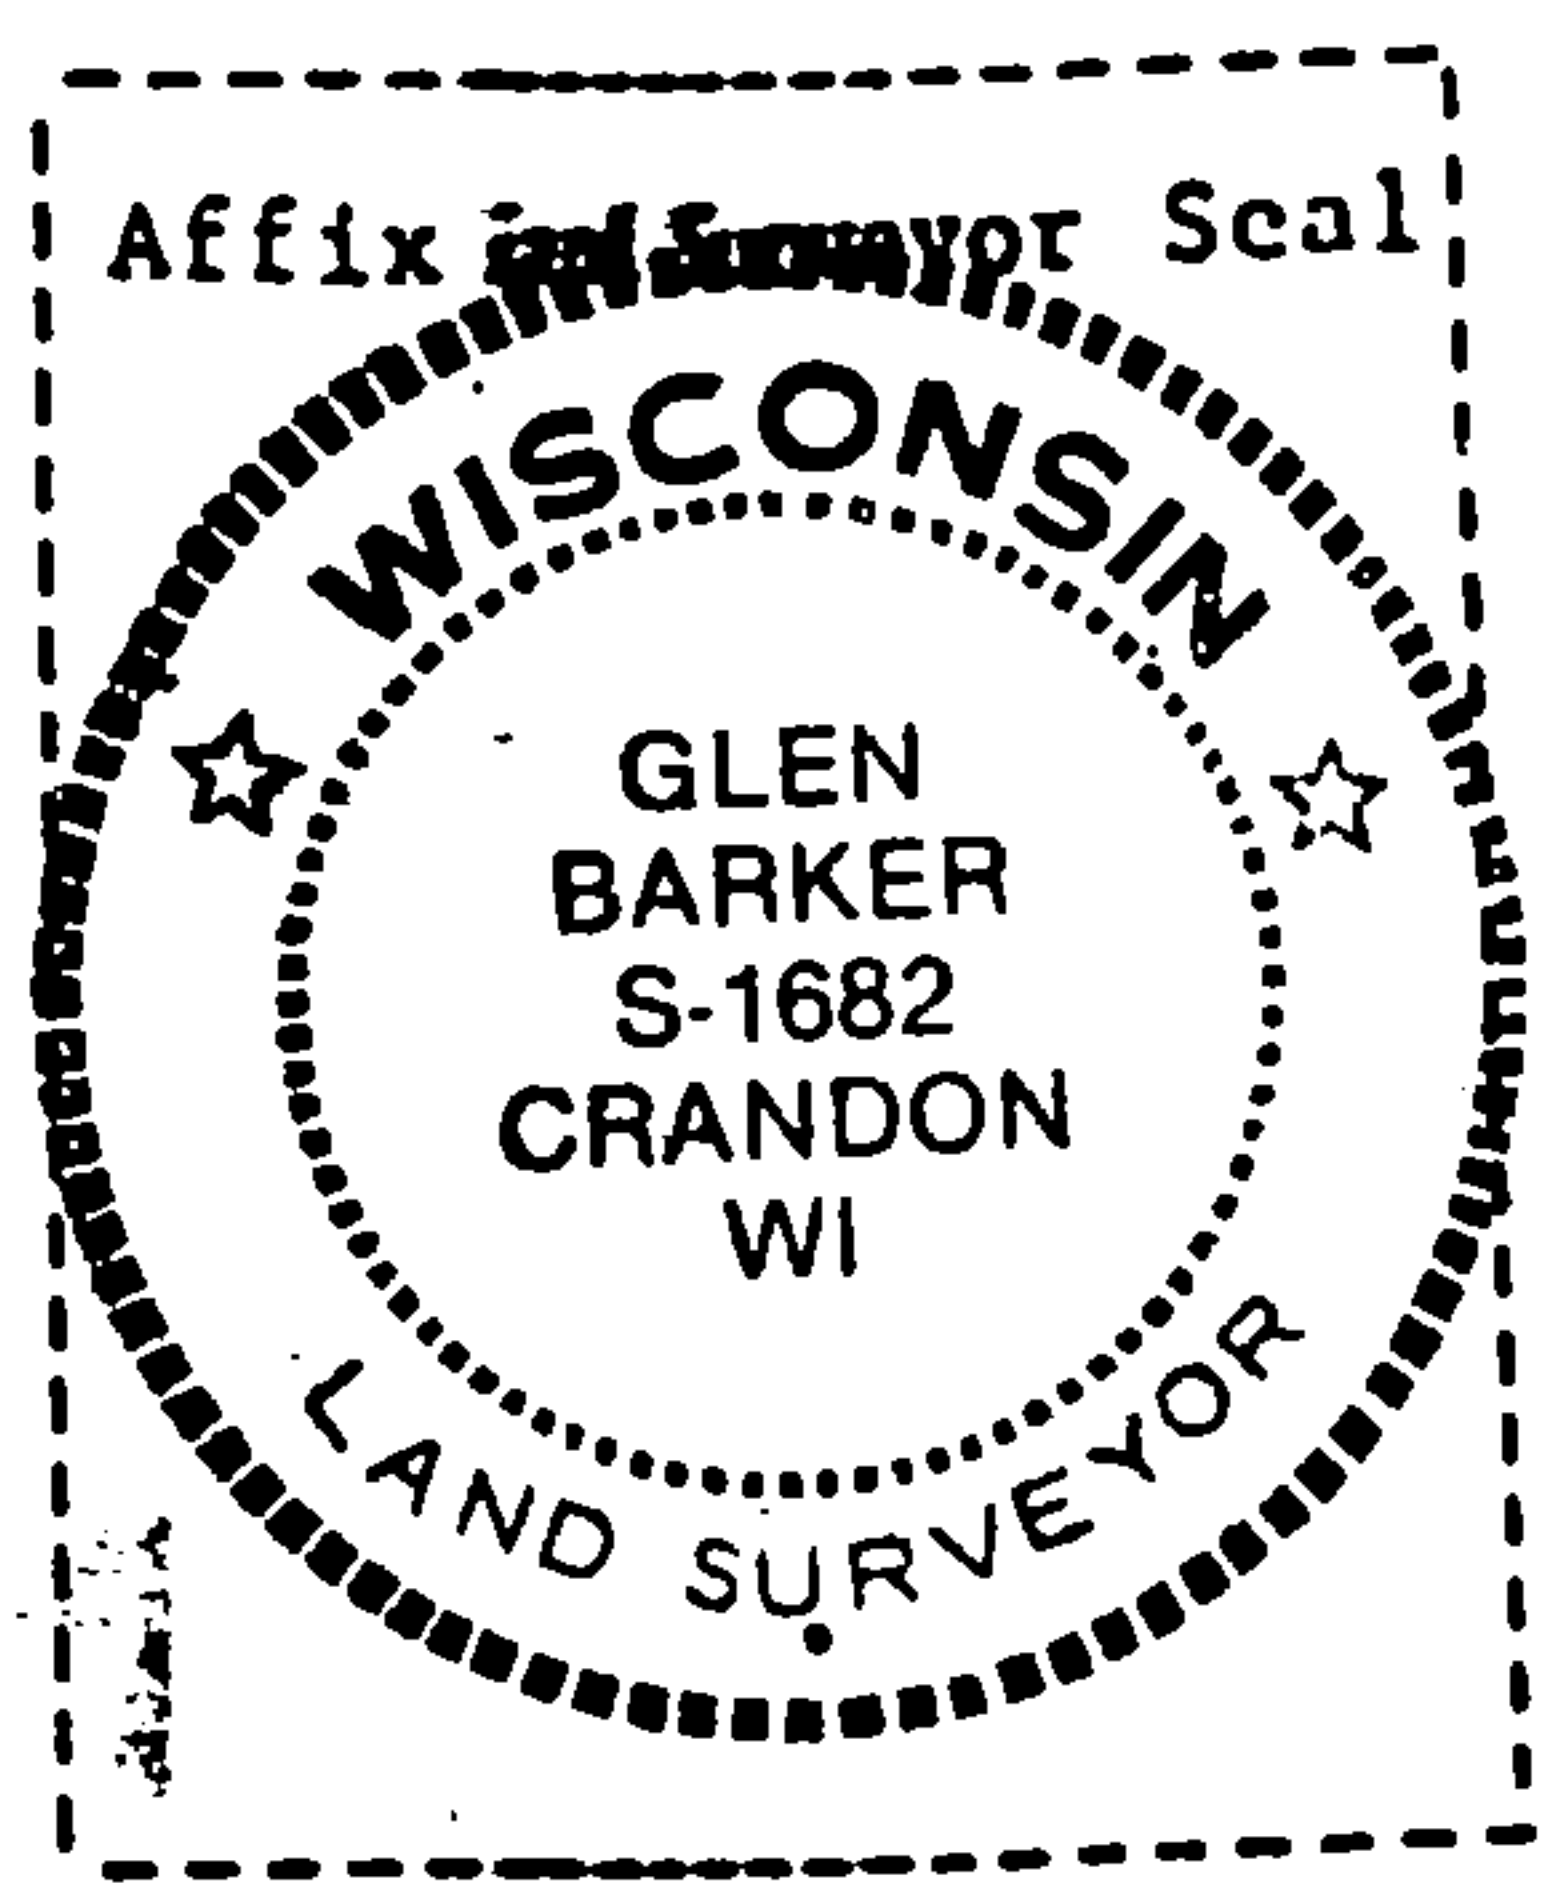

(i) I, Glen Barker
(type or print name) certify that the corner location shown on this record was determined by me or under my direction and control and that this U.S. Public Land Survey Monument Record is correct and complete to the best of my knowledge and belief.

Glen Barker
Signature

4/24/92
Date