

CERTIFIED LAND CORNER RESTORATION

Index No. **13**

State of Wisconsin } ss.
County of Forest



I Philip T. Hansen, do hereby certify that on the 13th day of January, 1976, I found evidence of the Quarter corner of Sections 15 and 16 Township 36 North, Range 14 East, Fourth Principal Meridian, as described hereon; and that from this evidence I established a new monument and accessories as described hereon to perpetuate the original location of this corner.

Resident witnesses:

Glen Barker

Jim Claflin

Tom Jewell

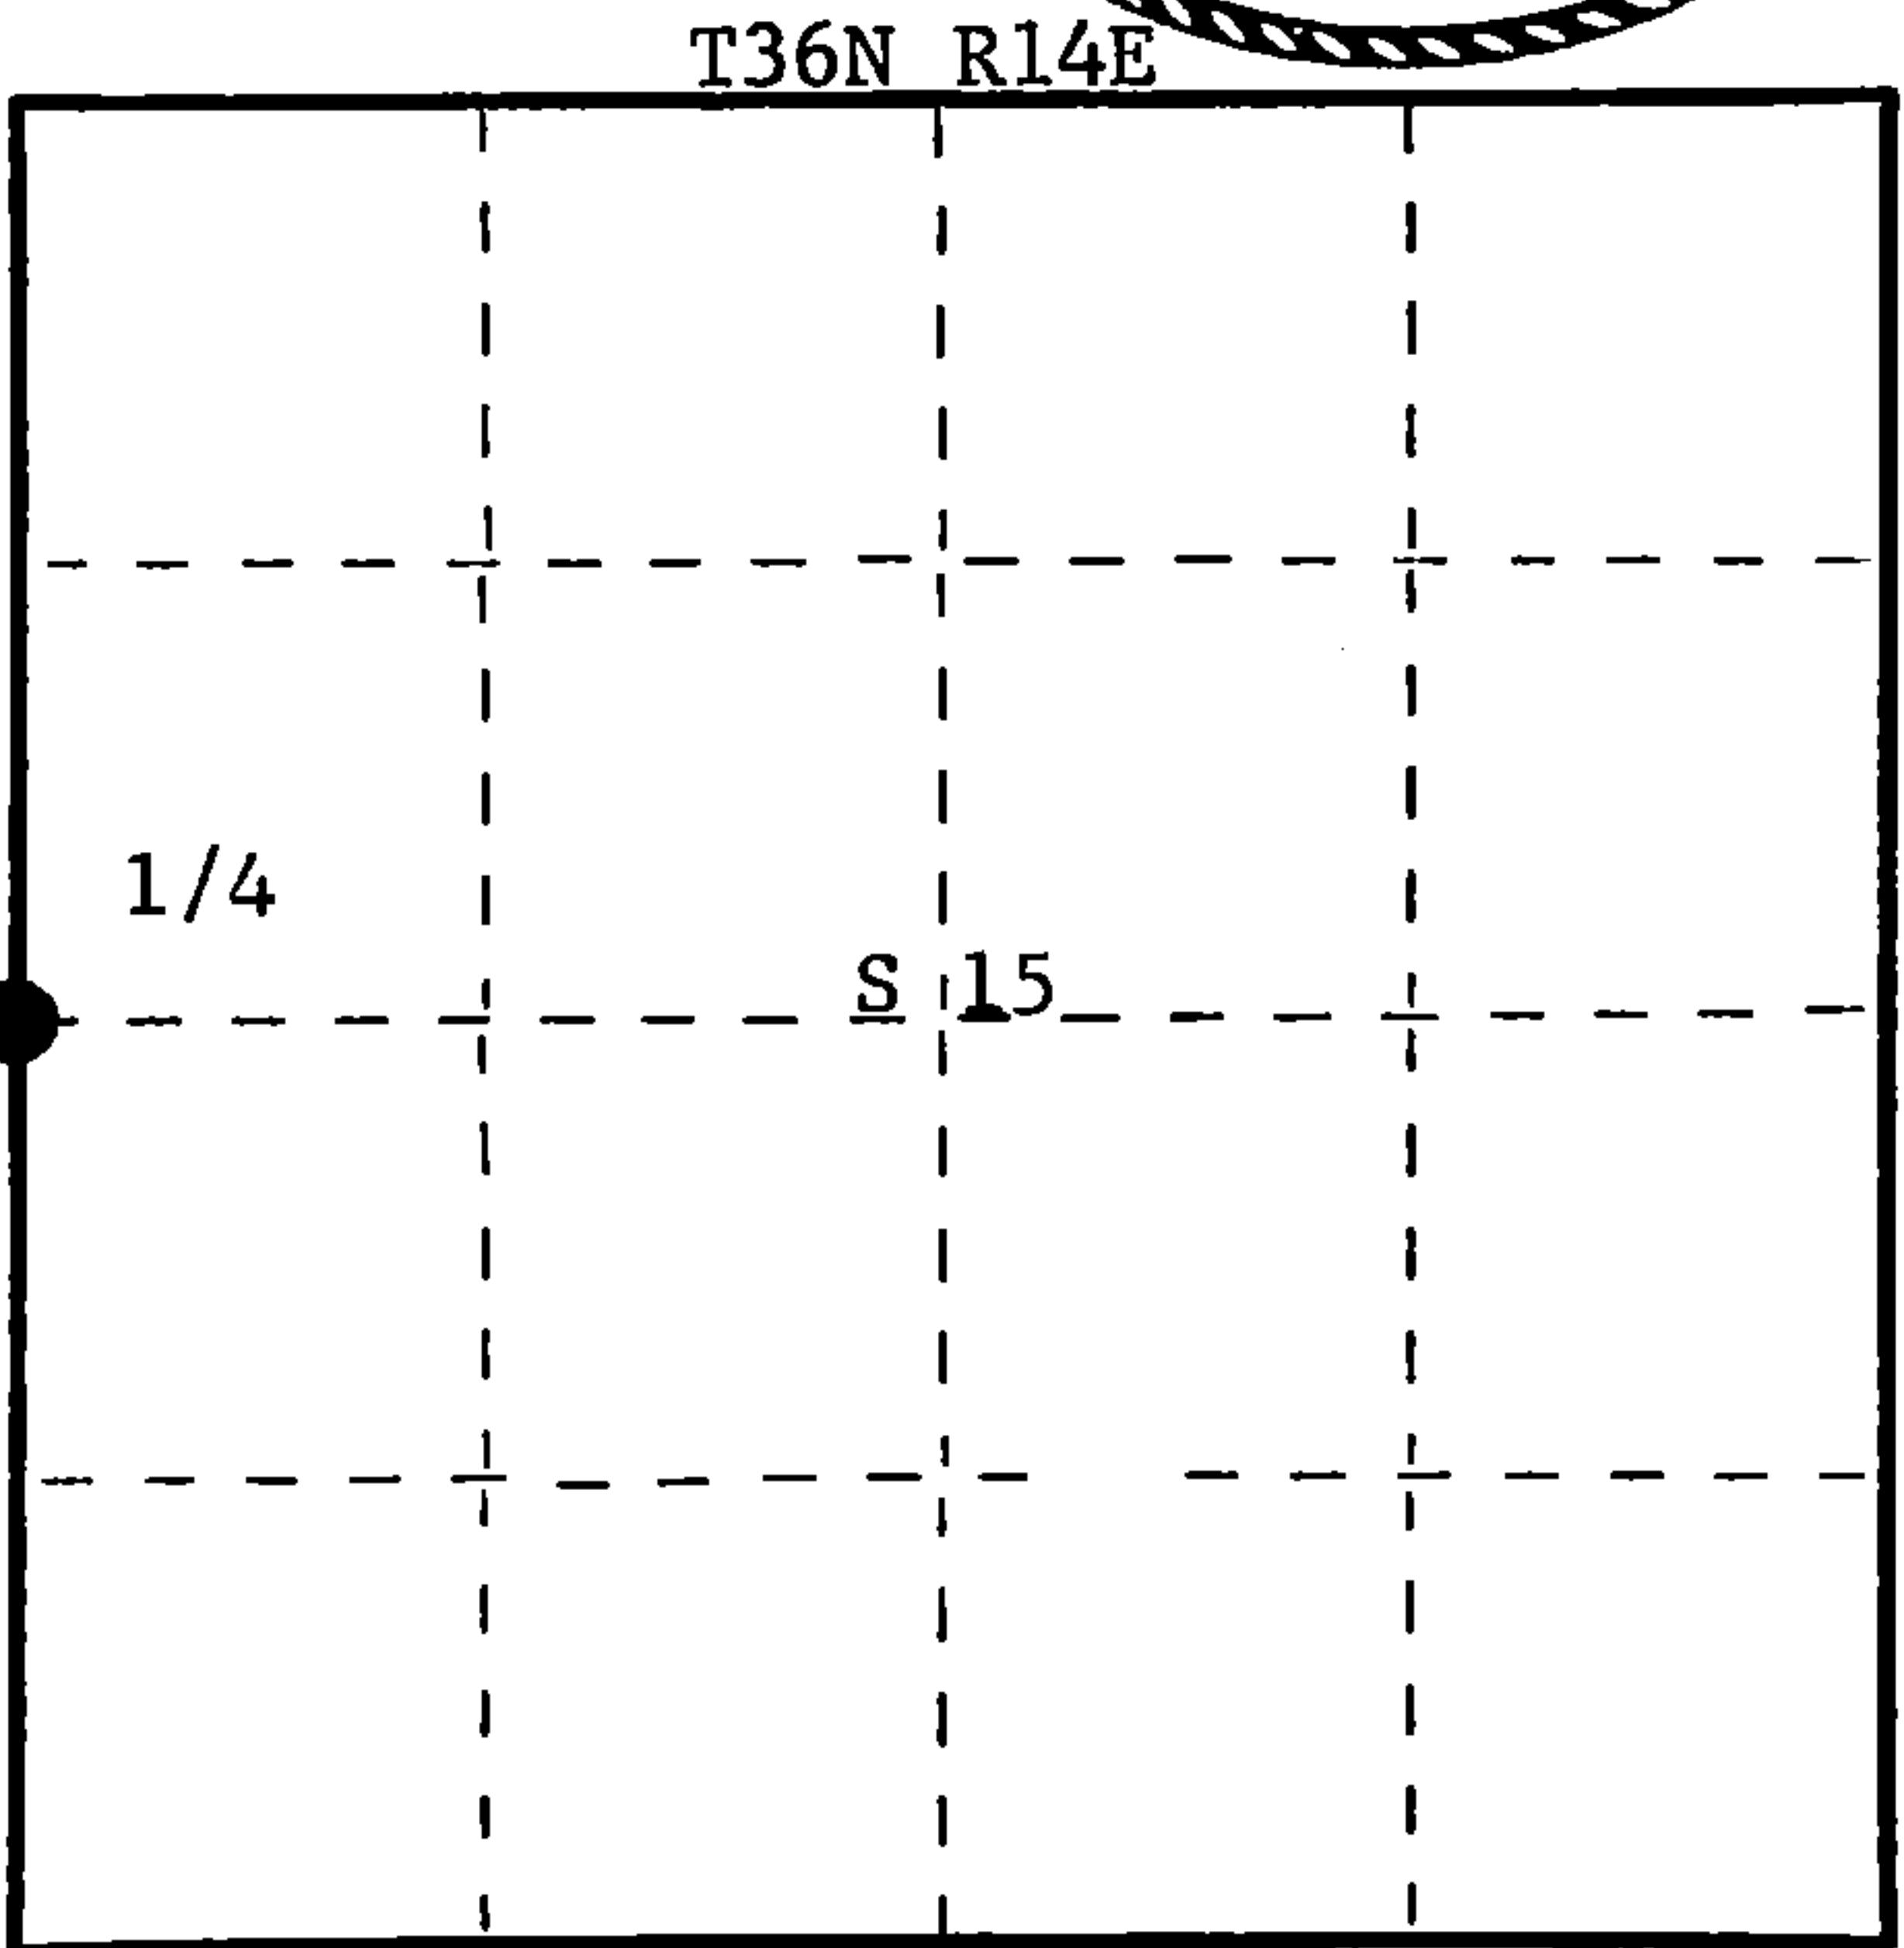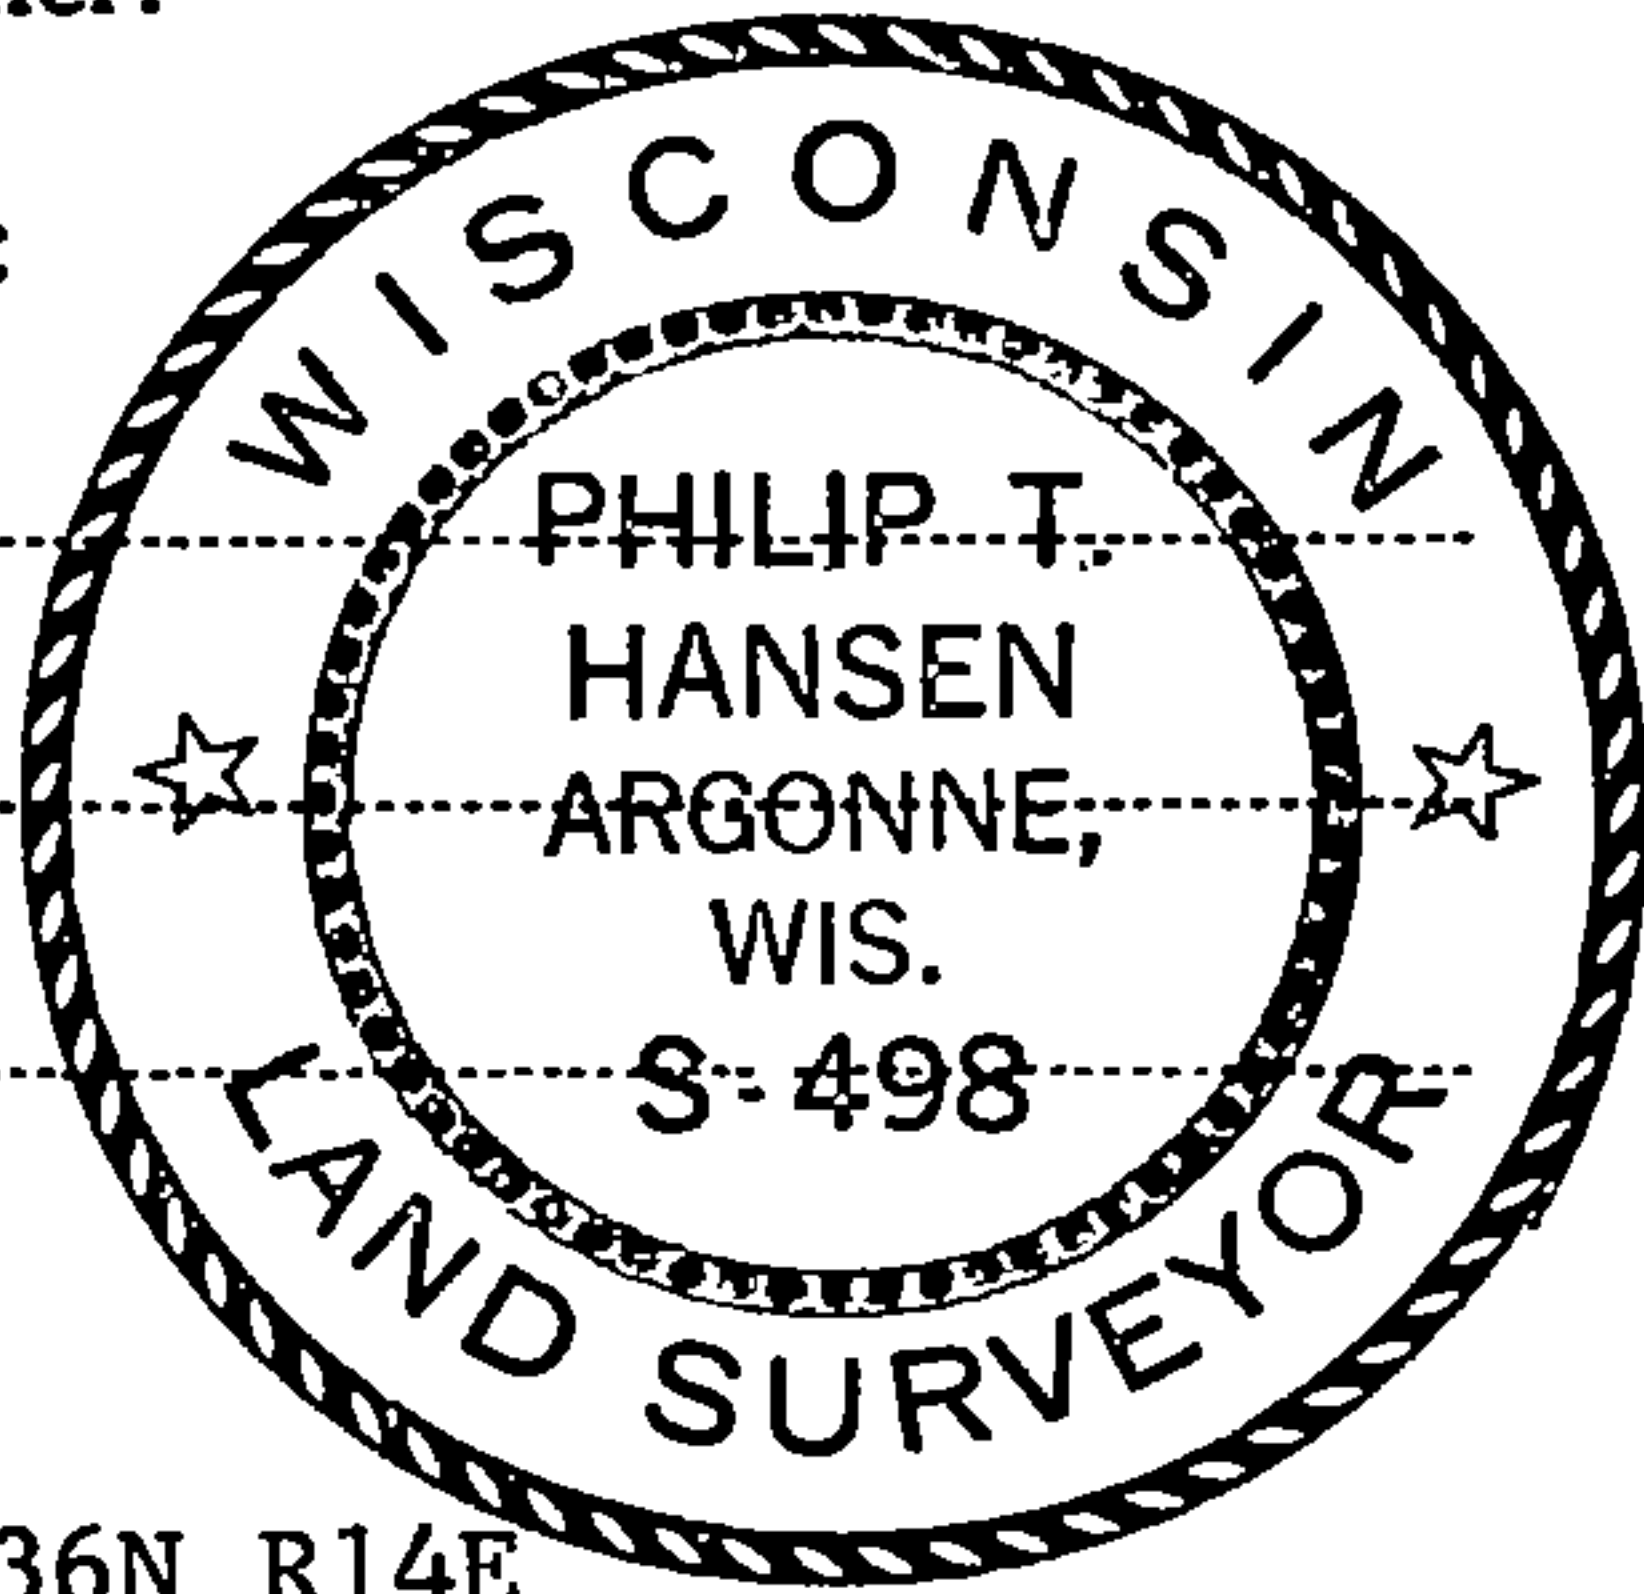

○ = Corner monument restored.

History of original corner establishment:

Original corner established by James McBride, Deputy Surveyor, in 1859, from which hemlock 12" bears S55°W, 23 links and hemlock 10" bears N85°E, 24 links. This corner recovered and maintained by Connor Forest Industries foresters for years.

Description of corner evidence found:

Recovered 2-1/2" iron pipe projecting 2' above ground. Also found an old squared cedar post lying beside it. While digging a new hole, found the point of old wood post buried in the muck.

OBT - Hemlock 32' S5°E 19 links - scribing partly visible.

Description of monument and accessories I established to perpetuate the original location of this corner.

Replaced 2-1/2" iron pipe with 2-1/2" Berntsen, A-1 Federal Monument, aluminum with magnet installed in cap and base. Pipe projects 12" above ground.

Cap stamped -

Reset old iron pipe and wood post beside new pipe.

NBT's - Sugar 8" N30°W 40.3 links - scribed 1/4 BT

Sugar 8" N74°W 54.7 links - scribed 1/4 BT

Pipe, old pipe, and BT's painted blue.

S498
T36N R14E

1/4 16 15
1975

Dated at Argonne, Wis., this 19th day of January, 1976.

Signature *Philip T. Hansen* Title Registered Land Surveyor Registration No. S-498
(County Surveyor, Registered Land Surveyor, or other duly authorized official)

Office of Register of Deeds, County of Forest, I hereby certify that the within instrument was filed in this office for record on the 4th day of February, 1976 at 4:00 o'clock P. M.

Eugene Stategny
(Register of Deeds)

By Deputy

DOCUMENT NUMBER 108715

FORM 985 H. C. MILLER CO., MILWAUKEE

43614162000