

U. S. PUBLIC LAND SURVEY MONUMENT RECORD

INSTRUCTIONS:


This record shall show the location of the corner and shall include all of the following nine elements (a through i).

- (a) Identify the corner by reference to the U.S. public land survey system.
 ○ = Corner monument restored.

Quarter Corner between Sections 3 and 4,
 T.36N., R.15E., Forest County, Wisconsin.

State Plane Coordinates
 Wisconsin North Zone
 N - 171693.106411
 E - 2323145.95016

Geographic Coordinates
 N - 45 - 37 - 44.50800
 W - 088 - 36 - 49.31142

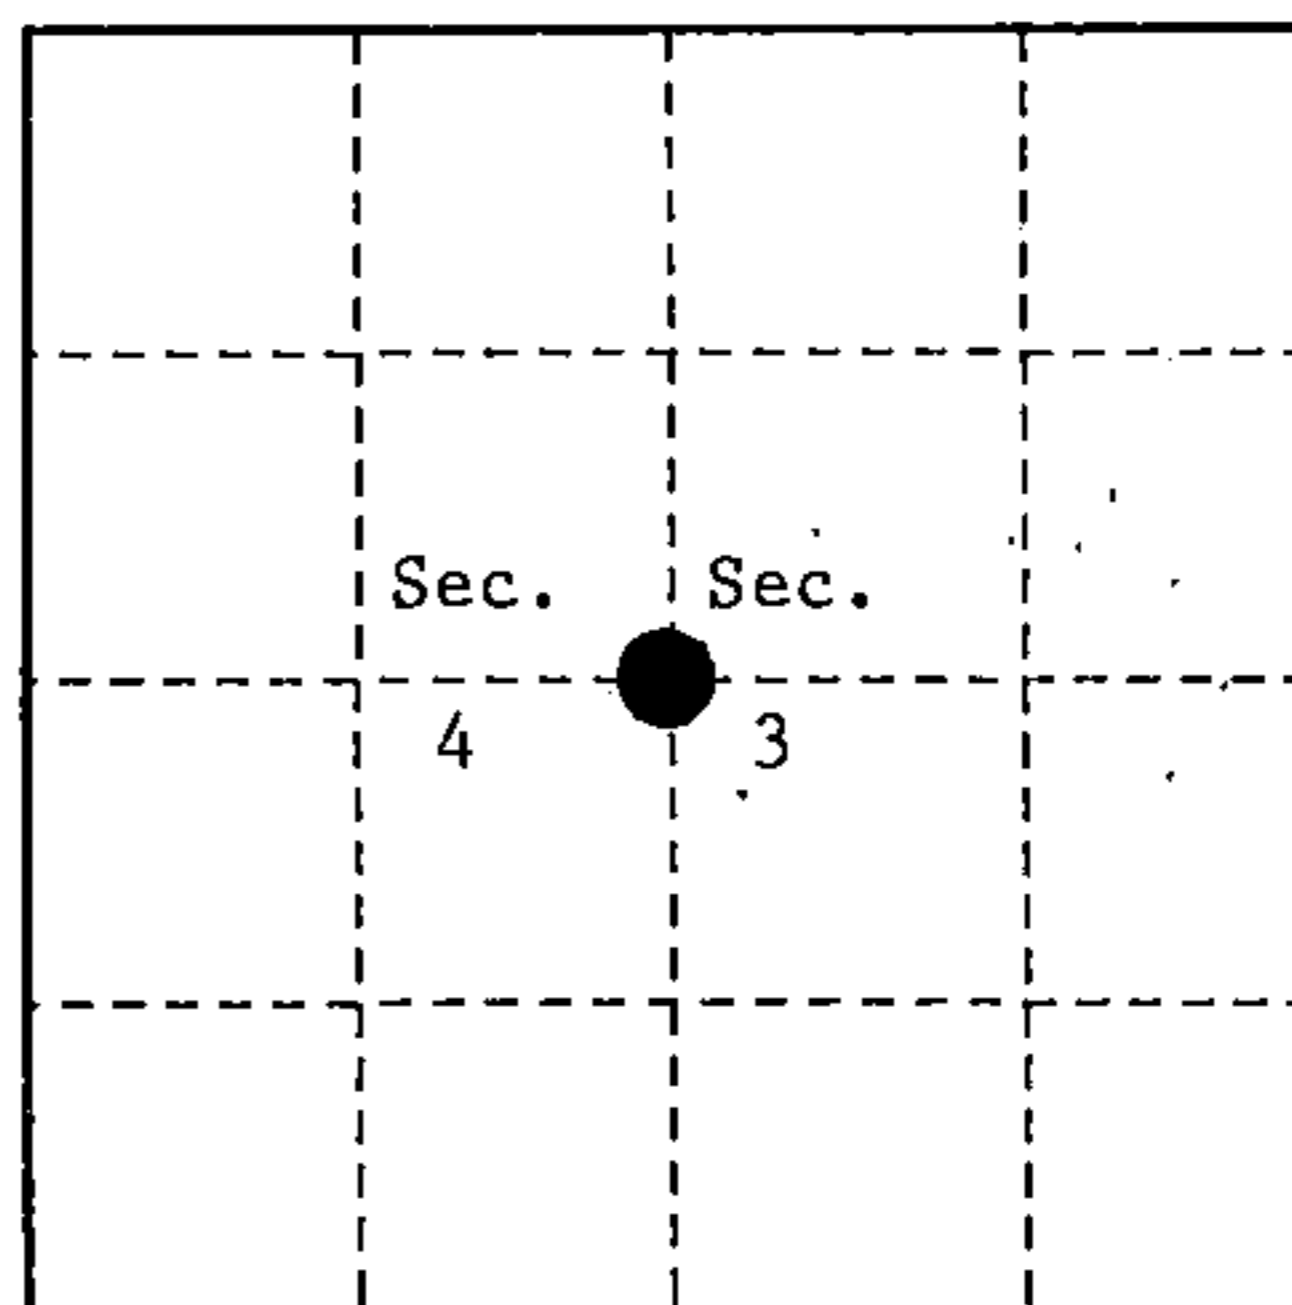

- (b) Describe any record evidence, monument evidence, occupational evidence, testimonial evidence or any other material evidence you considered, and whether the monument was found or placed.

Original Survey in 1859 by James McBride. Set wood post and the following B.T.'s; Aspen, 12", S.74°W., 7 links, Aspen, 10" N.40°E., 19 links.


In 1915 J. Melindy set a 5" X 5" Cedar Post at 39.94 chains from the original Northwest Section Corner. Marked the following new B.T.'s; White Birch, 10" S.15½°W., 2.90 feet, Spruce, 12", S.30 ¾°E., 20.38 feet, White Birch, 10", N.24°E., 23.84 feet, South, 5.00 chains, creek 8 links wide runs Southeast.

In 1994, Alan Harrison, RLS, chained from the Southeast Section Corner of Section 4. Found a 4" X 12" piece of Cedar Post lying next to a post hole. Found a 19" White Birch stump, N.24°E., 23.84 feet, a 19" Spruce stump, S.30 ¾°E., 20.38 feet, and a live 16" White Birch, S.15½°W., 2.90 feet. Chained South to creek and verified creek call. In post hole, set a 2½" X 36" Aluminum Monument and blazed and scribed new B.T.'s as noted below.

- (c) In the plan view drawing below, provide reference ties to at least 4 witness monuments, or, if the location is within a municipality, to at least 2 witness monuments. (witness monuments shall be made of concrete, natural stone, iron or other equally durable material.)

- (d) Show a plan view drawing depicting the relevant monuments and reference ties which is sufficient in detail to enable accurate relocation of the corner monument if the corner monument is disturbed. Indicate north.

1. 2½" X 36" Aluminum Monument with aluminum tablet stamped to identify corner.
2. Red Maple, 10", N.59°E., 57.49 feet.
3. Red Maple, 9", S.63°E., 34.10 feet.
4. Hemlock, 11", N.52°W., 60.73 feet.
5. Steel Sign Post, East, 1.25 feet.

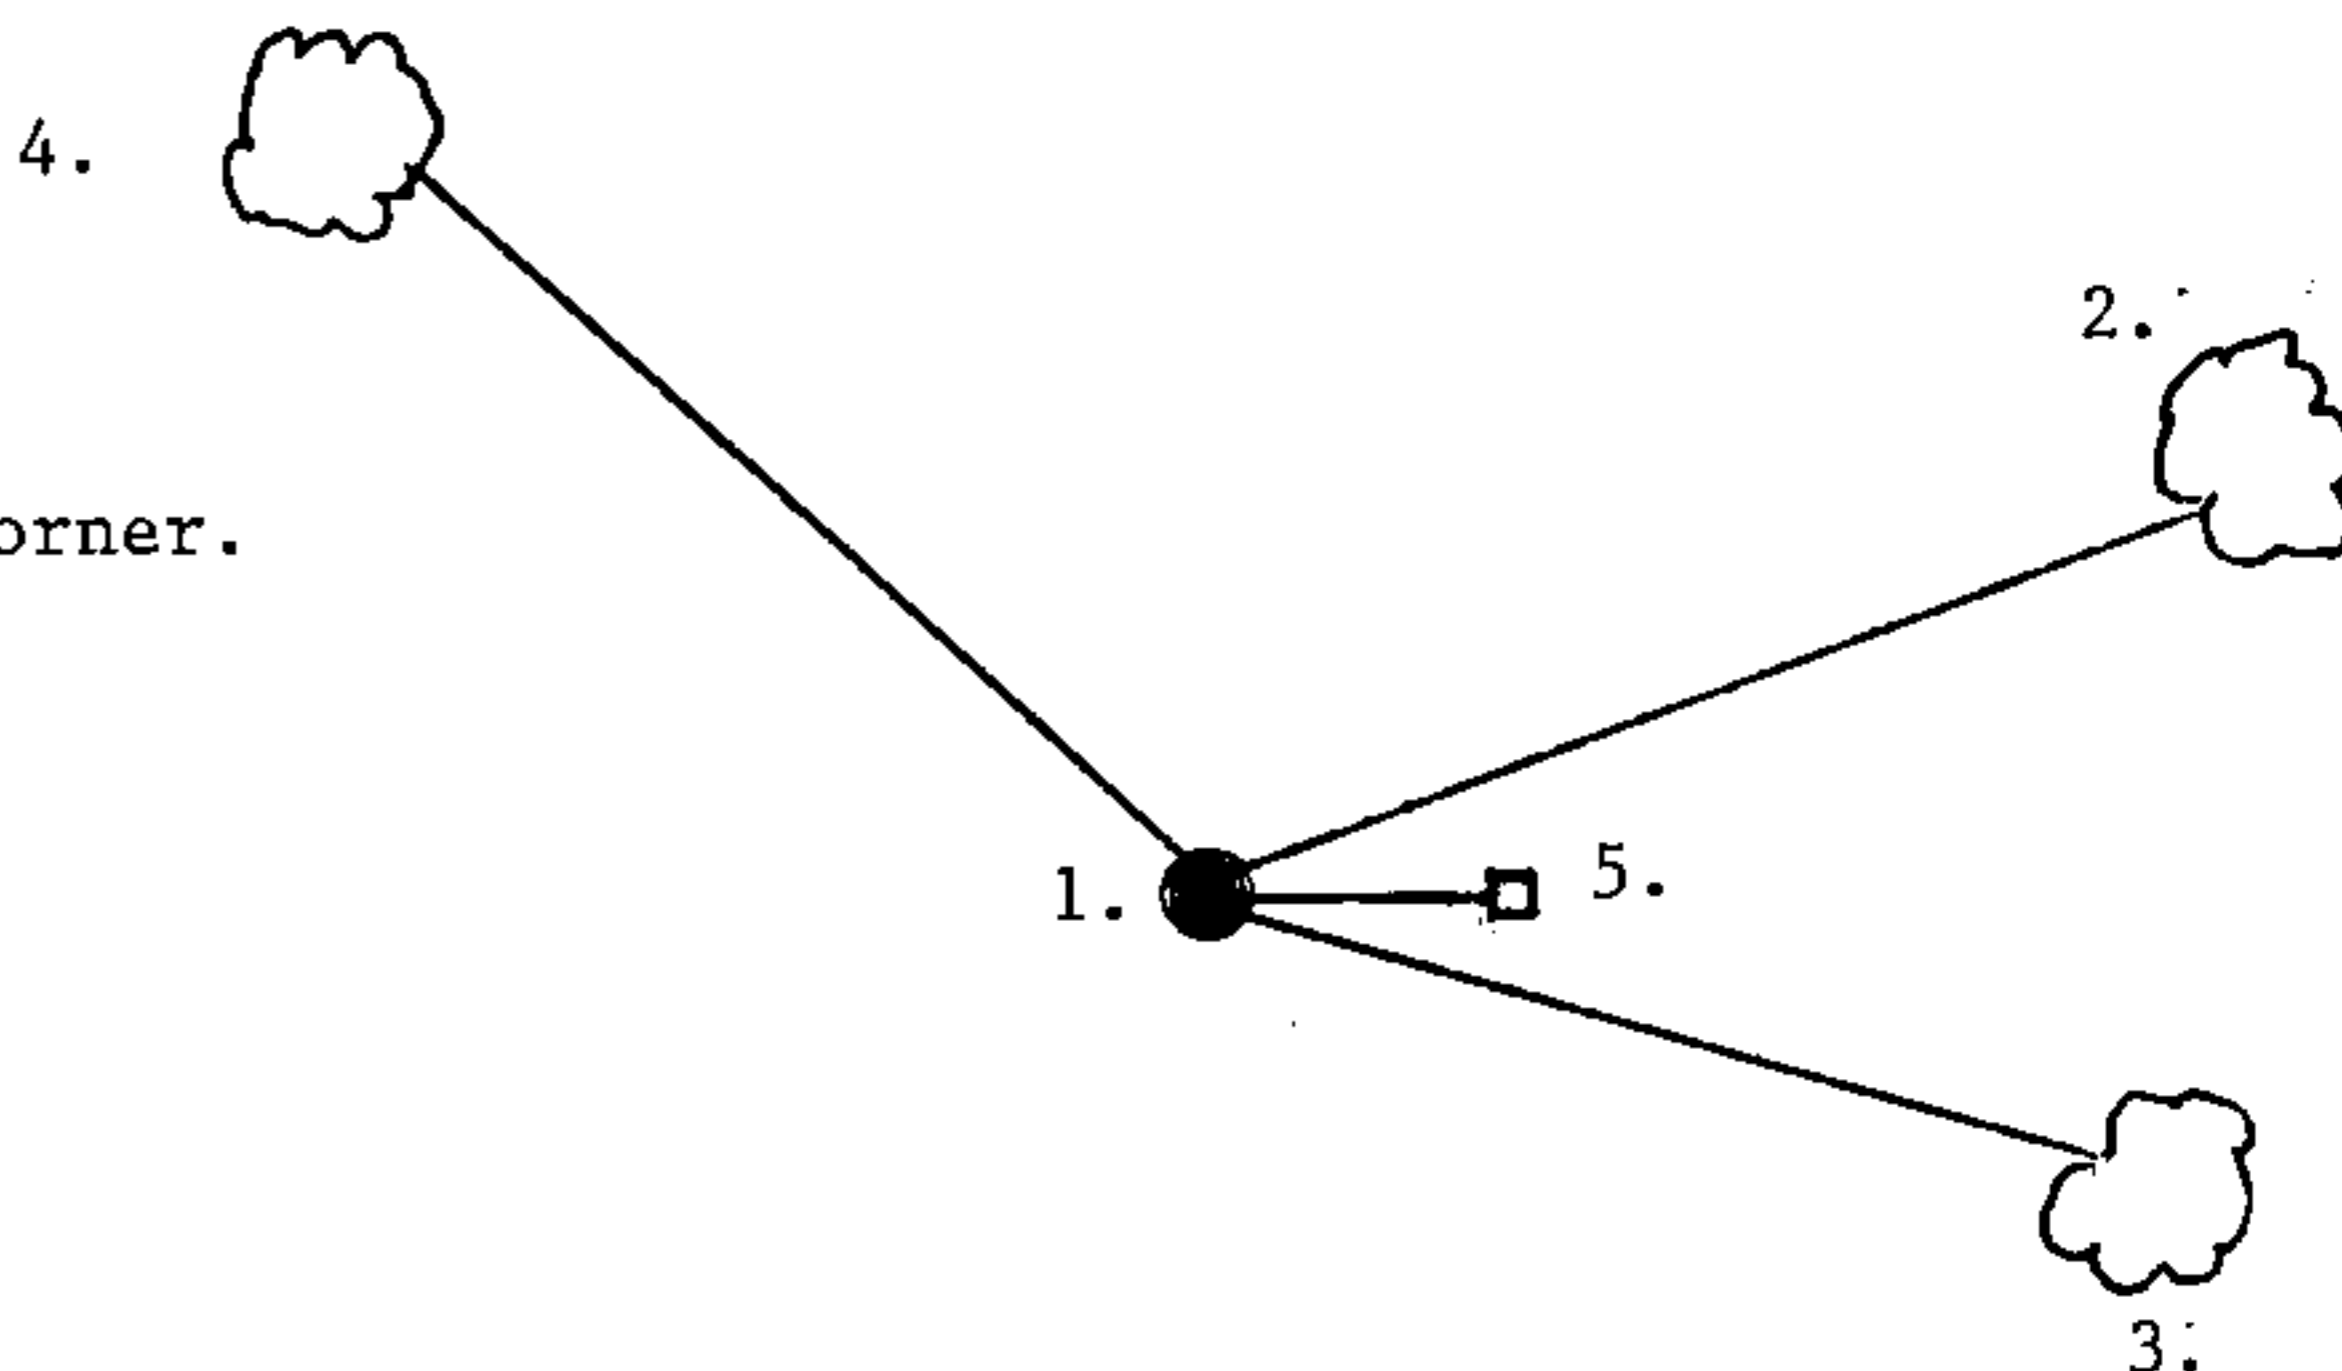

(e) Describe any material discrepancy between the location of the corner as restored or reestablished and the location of that corner as previously restored or reestablished by distance and direction. Show the discrepancy on the plan view drawing under (d), above. Show the distances between the corner as previously restored or reestablished and (1) the corner as restored or reestablished, and (2) to at least 2 of the witness monuments shown on the drawing in (d), above.


None

(f) Was the corner restored through acceptance of (1) an obliterated evidence location, or, (2) a found perpetuated location?


(1)

(g & h) Was the corner reestablished through lost corner proportionate methods? If so, show the method, including the directions and distances to other public land survey corners used as evidence or used for proportioning in determining the corner location?

No

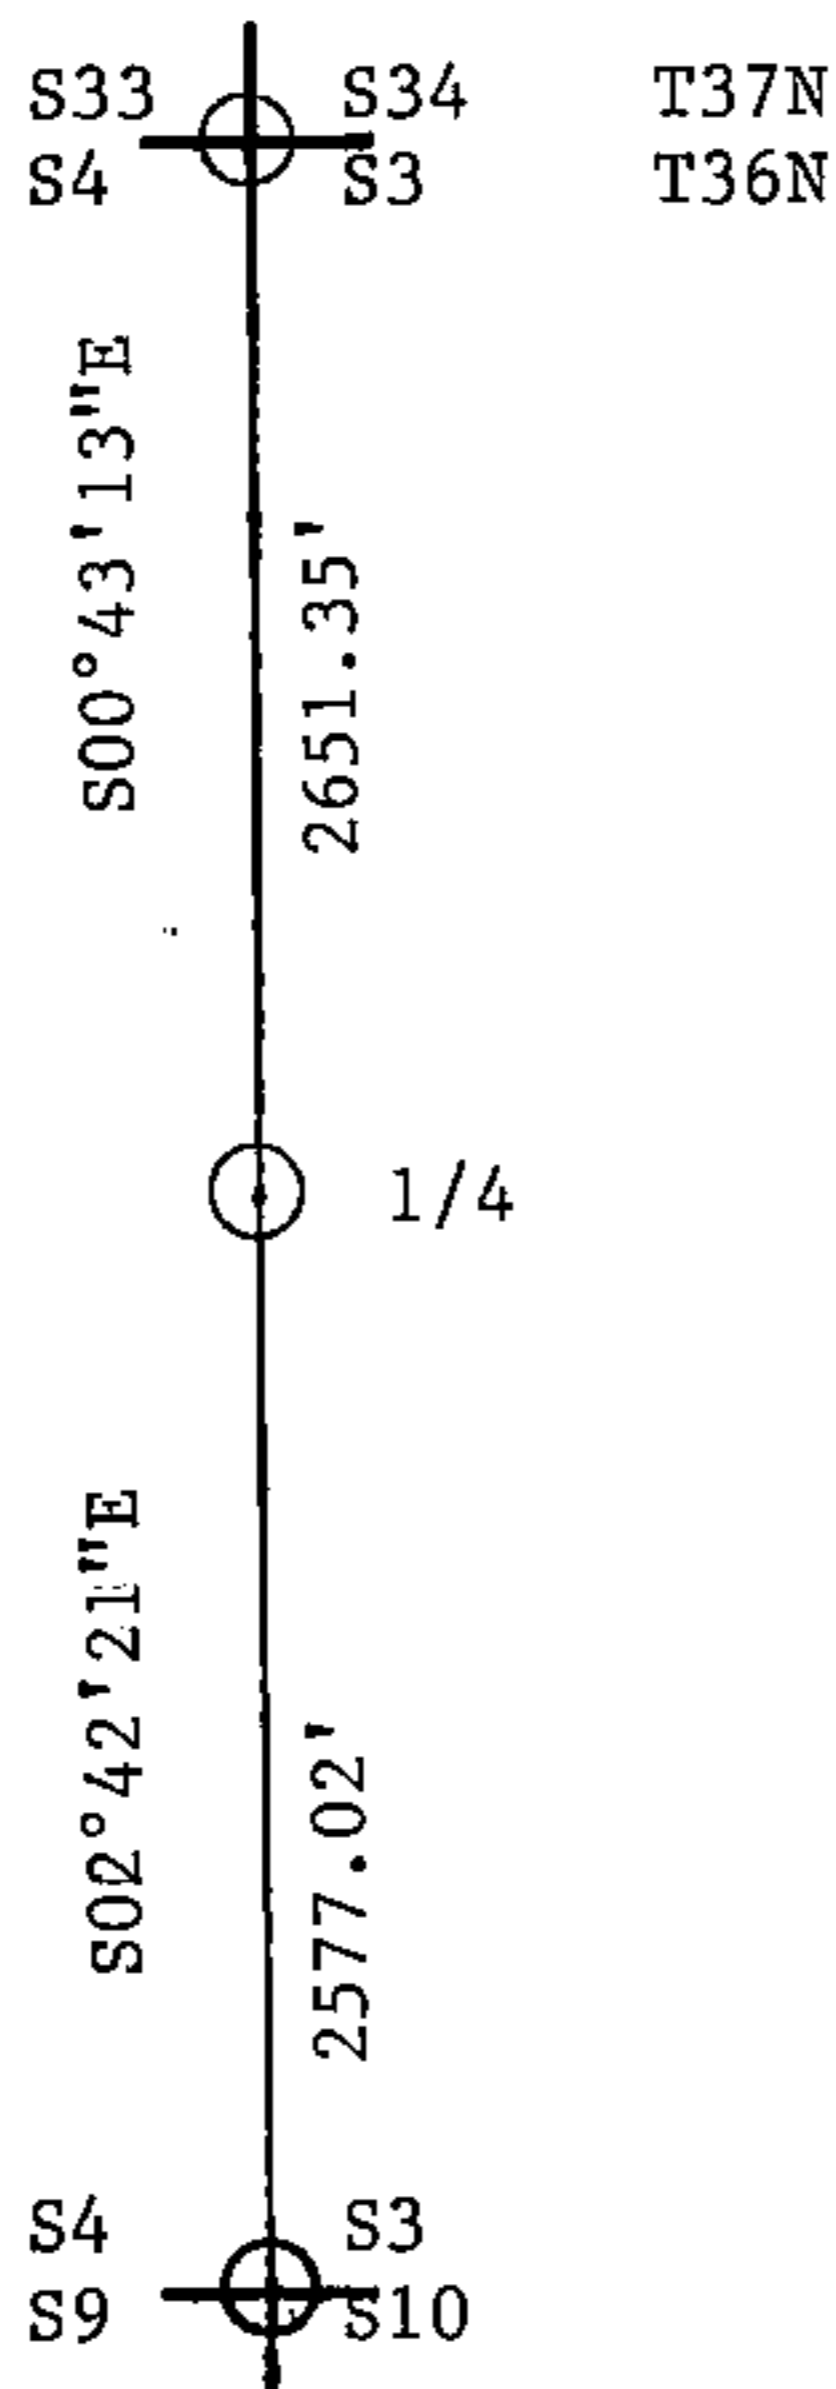

REGISTER'S OFFICE
Forest County, Wis.
Received for record this 10th day
of May A.D. 19 95 at
8:30 o'clock A. M. and recorded
in Vol. Corner Restorations
page 36-15, C-13
Paul Chittie, Deputy
Register of Deeds

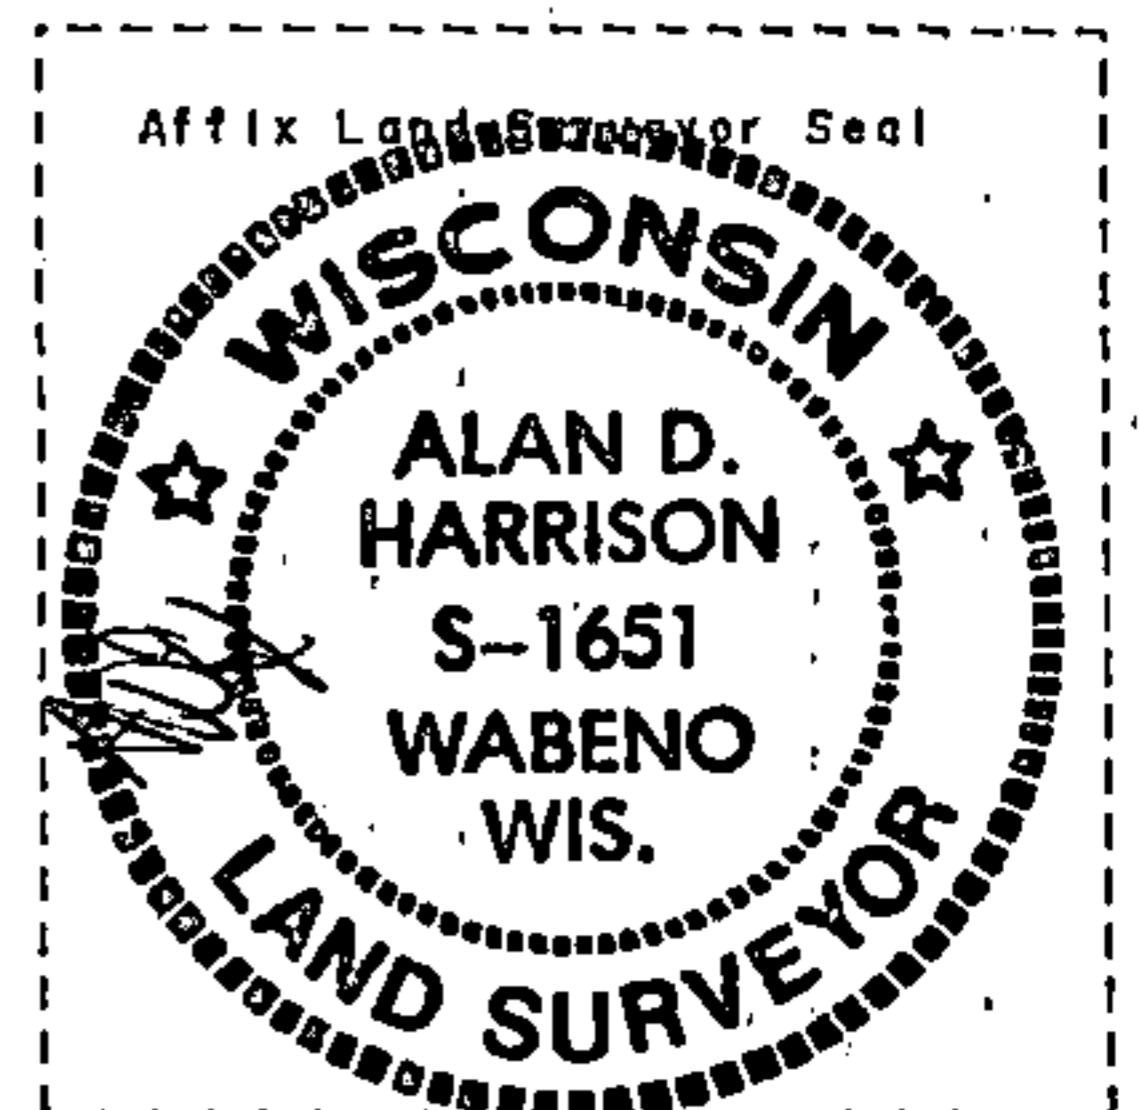

(1) I, Alan D. Harrison
(type or print name) certify that the corner location shown
on this record was determined by me or under my direction and
control and that this U.S. Public Land Survey Monument Record is
correct and complete to the best of my knowledge and belief.

Alan D. Harrison 4/25/95
Signature Date

CERTIFICATE READY FOR FILING:

Paul Shaker
District Ranger