

CERTIFIED LAND CORNER RESTORATION

Index No. B-3

State of Wisconsin }
County of Forest } ss.


I Philip T. Hansen, do hereby certify that on the 22nd day of September, 1979, I ~~found~~ established ~~the~~ NC 1/16 corner of Section 6 Township 36, North, Range 15 East, Fourth Principal Meridian, as described hereon; and that from this evidence I established a new monument and accessories as described hereon to perpetuate the original location of this corner.

Resident witnesses:


Glen Barker

Jim Claflin

Herb Wagoner

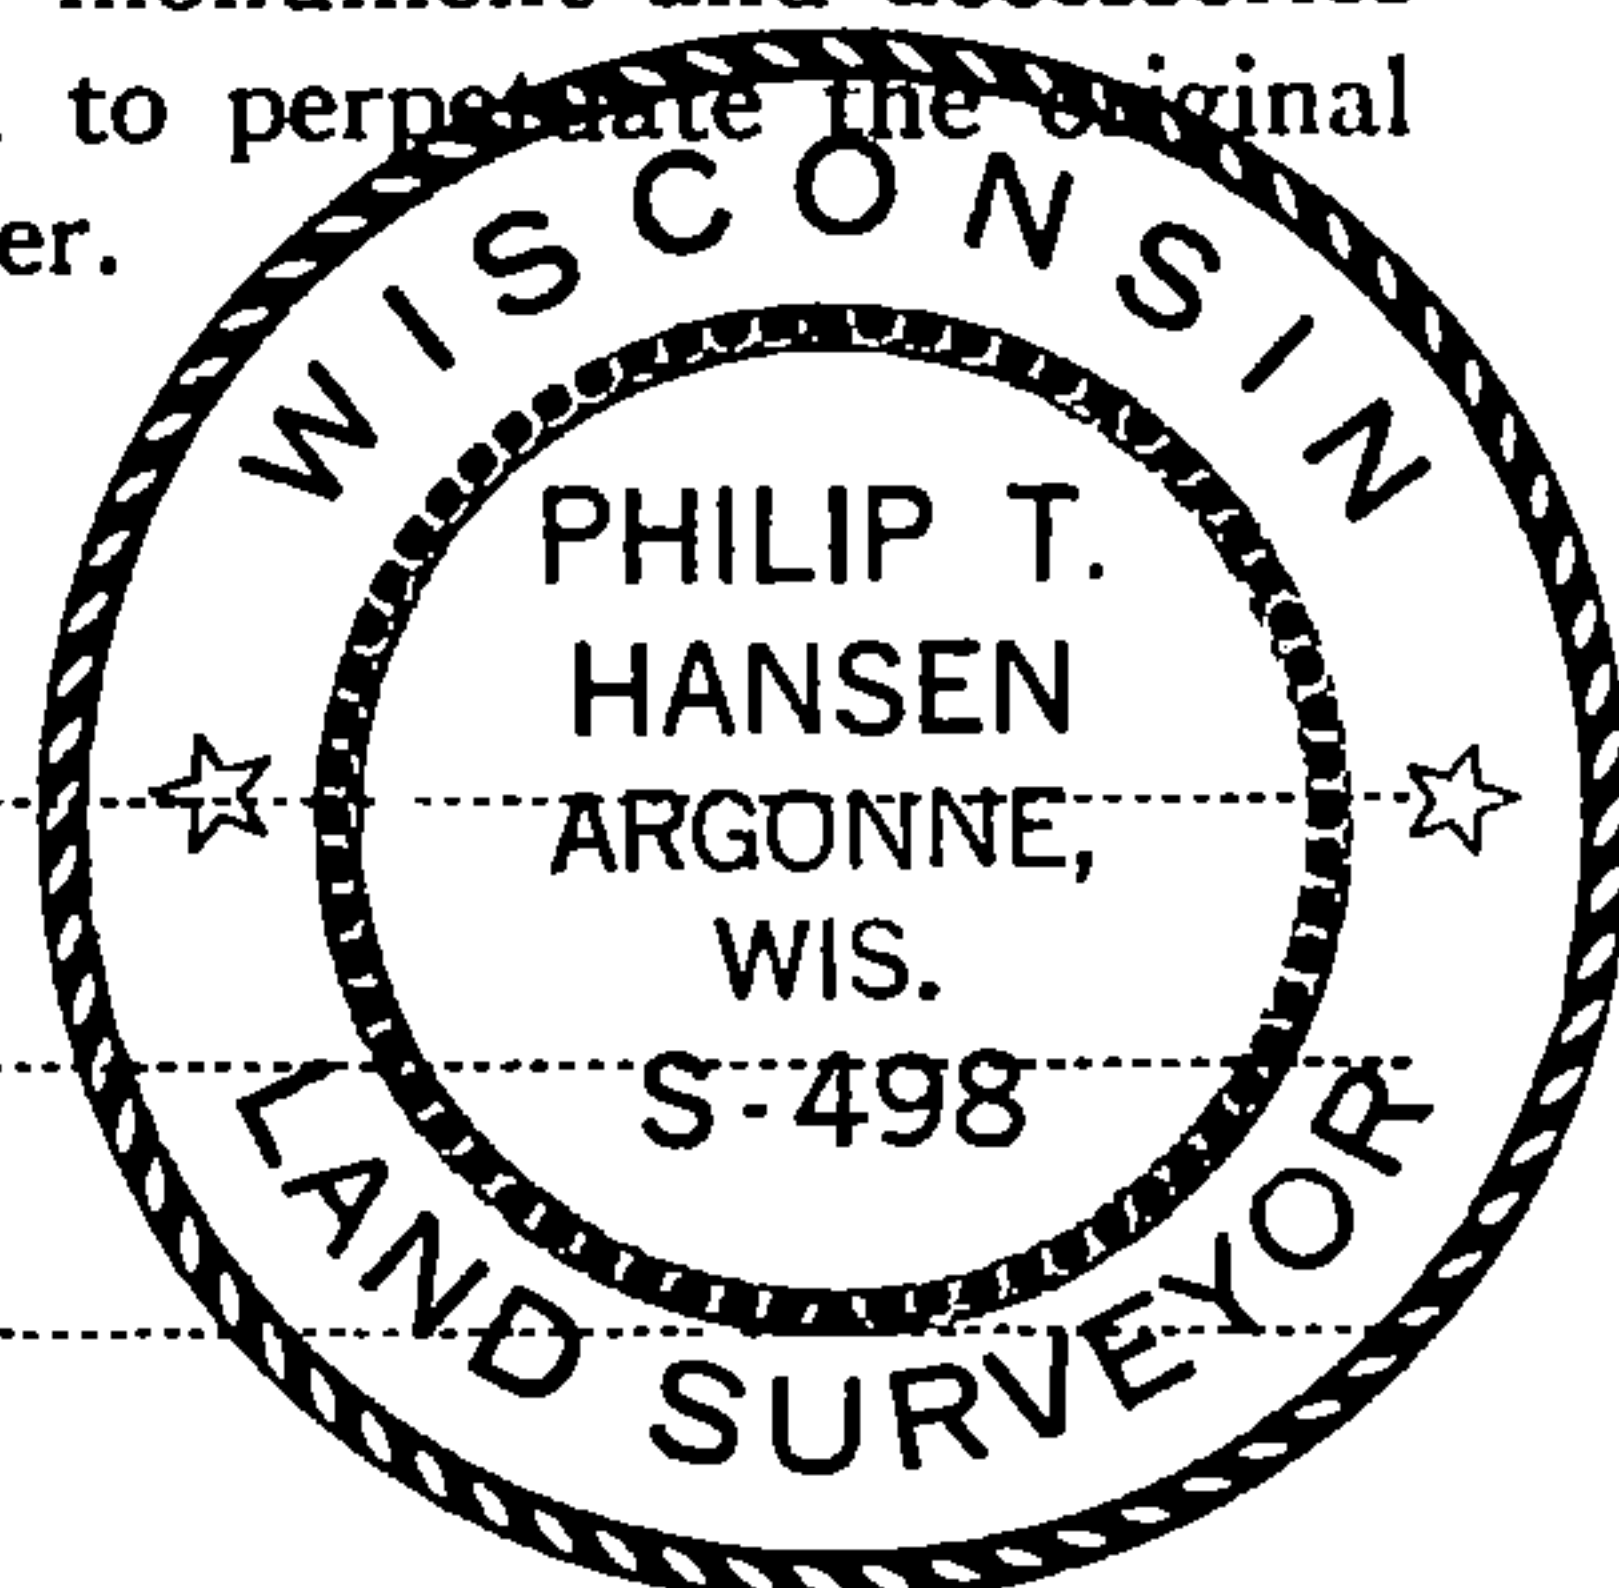

FORM 985 H. C. MILLER CO., MILWAUKEE

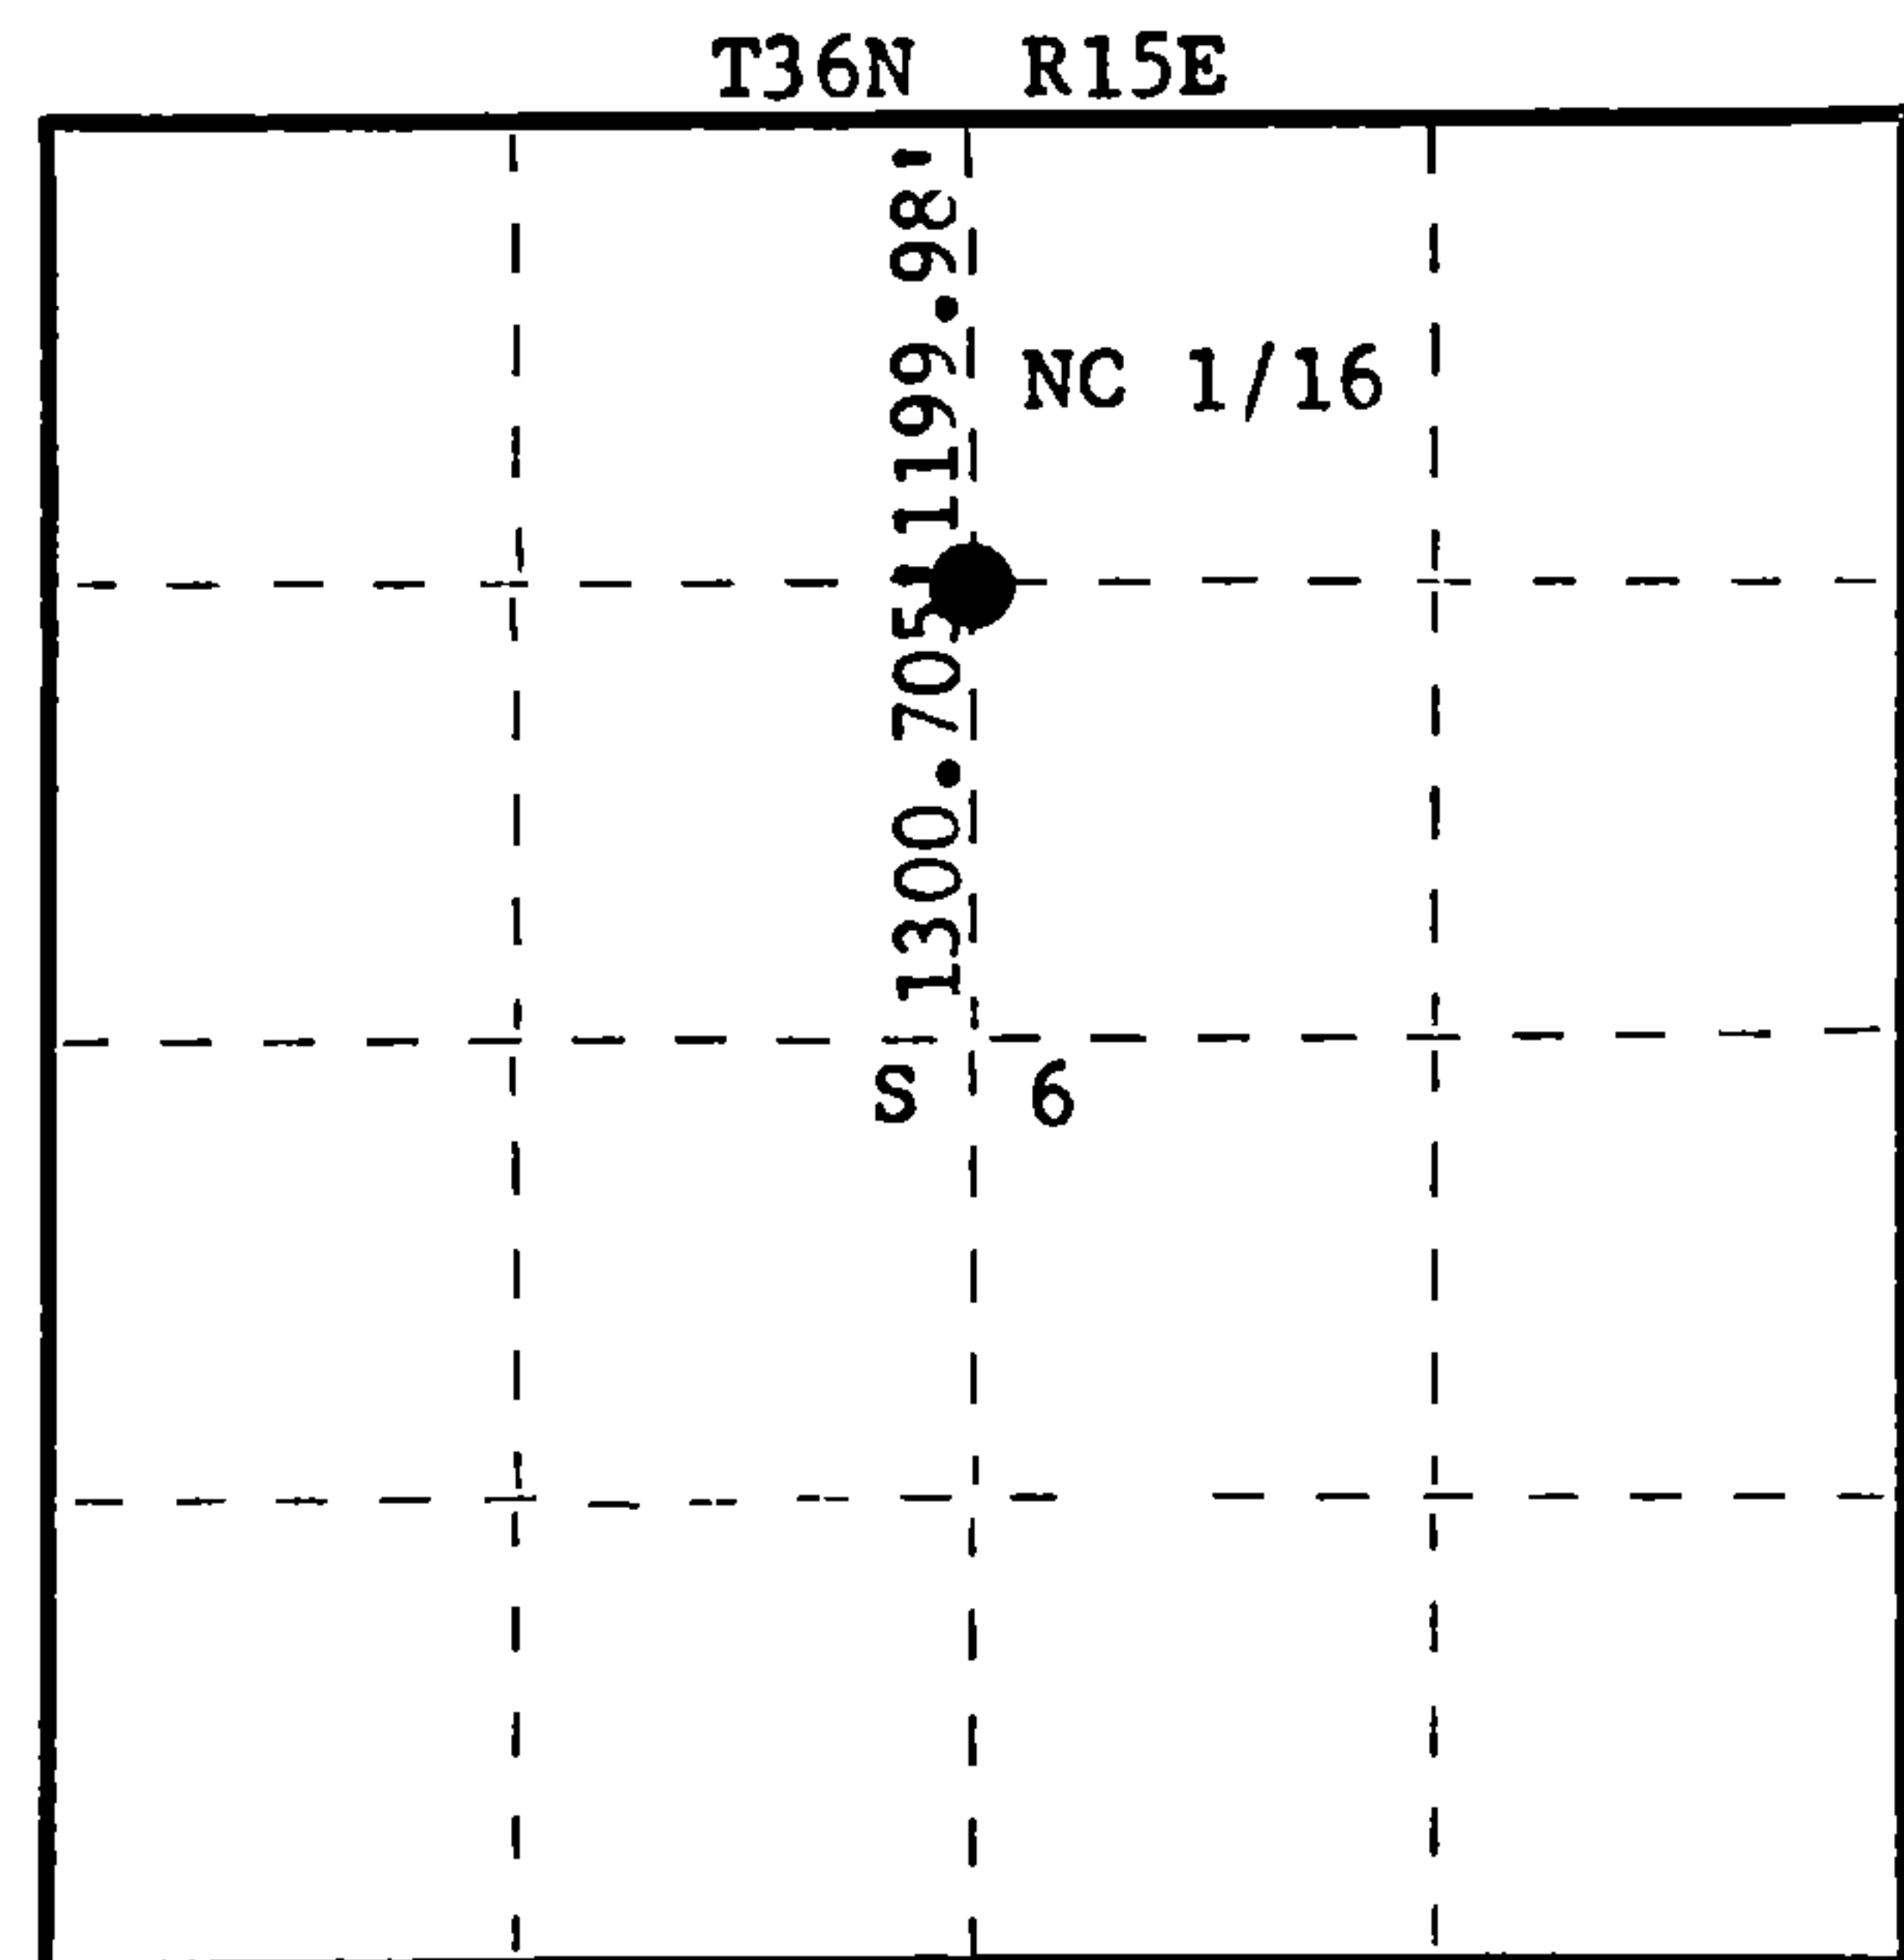

○ = Corner monument restored.

History of original corner establishment:

No records of any survey available.
No evidence of any corner recovered.

Description of corner evidence found:

Corner established by traverse and computation. Computed the distance of N-S and E-W 1/4 lines to locate the C 1/4 corner. Computed distance from C 1/4 corner to N 1/4 corner is 2500.682 feet at bearing S 2°04'20"W. Set the NC 1/16 at proportional distance 1199.98 feet S 2° 04' 20" W of N 1/4 and 1300.705' N 2° 04' 20" E of C 1/4.

Description of monument and accessories I established to perpetuate the original location of this corner.

Set a 1-1/2" iron pipe with 2" brass cap, stamped: Monument projects 18".

Marked NBT's -
Maple 9" S4°W 13.25 feet, scribed 1/16 BT.
Sugar 8" S74°E 16.25 feet, scribed 1/16 BT.

S498
T36N R15E
NC 1/16 S+6
CPI-1979

Dated at Rhineland, Wis., this 9th day of October, 1979.

Signature Philip T. Hansen Title Registered Land Surveyor Registration No. S-498
(County Surveyor, Registered Land Surveyor, or other duly authorized official)

Office of Register of Deeds, County of Forest, I hereby certify that the within instrument was filed in this office for record on the 13th day of November, 1979 at 8:30 o'clock A. M.

Eugene Stutzman
(Register of Deeds)

By _____ Deputy

DOCUMENT NO. **117084**

430150103020