

CERTIFIED LAND CORNER RESTORATION

State of Wisconsin }
County of Forest } ss.

I, Milo E. Stefan, do hereby certify that on the 24th day of June, 1981, I found evidence of the West 1/4 corner of Section 10, Township 36 North, Range 15 East, Fourth Principal Meridian, as described hereon; and that from this evidence I established a new monument and accessories as described hereon to perpetuate the original location of this corner:

Description of original monument and accessories and subsequent restorations:

Surveyed in 1859 by James McBride
40.00 Set 1/4 section wood post
Hemlock, 16", N55W, 32 lks., 21.12 feet
Sugar, 14", S56E, 12 lks., 7.92 feet
1.45 chains south, 10 links creek runs east


Description of corner evidence found:

- Pulled distance from section corner south. At 39.15 chains we found:
- 1. 4" x 4" x 12" Cedar post (fallen) with location poster attached.
 - 2. 1 1/4" x 36" iron pipe alongside post point.
 - 3. Hemlock stump remains, N55W, 21.0 feet.
 - 4. Creek call south fits well.
 - 5. Plantation posts north 20 feet - 25 feet.
 - 6. No trace of SE BT.
 - 7. Blazed line south.

Description of monument and accessories I established to perpetuate the location of this corner:

Replaced the wood post with a 2" x 30" aluminum pipe with cap stamped as follows:
T36N, R15E, S9, 1/4, S10, 1981, RLS-1558
From which the following bear:
R. Pine, 12", N39E, 24.08 feet -
W. Spruce, 10", S60W, 11.73 feet
R. Pine, 12", N37W, 27.74 feet
Set steel sign post, South, 1.40 feet

DOCUMENT NO.
124202

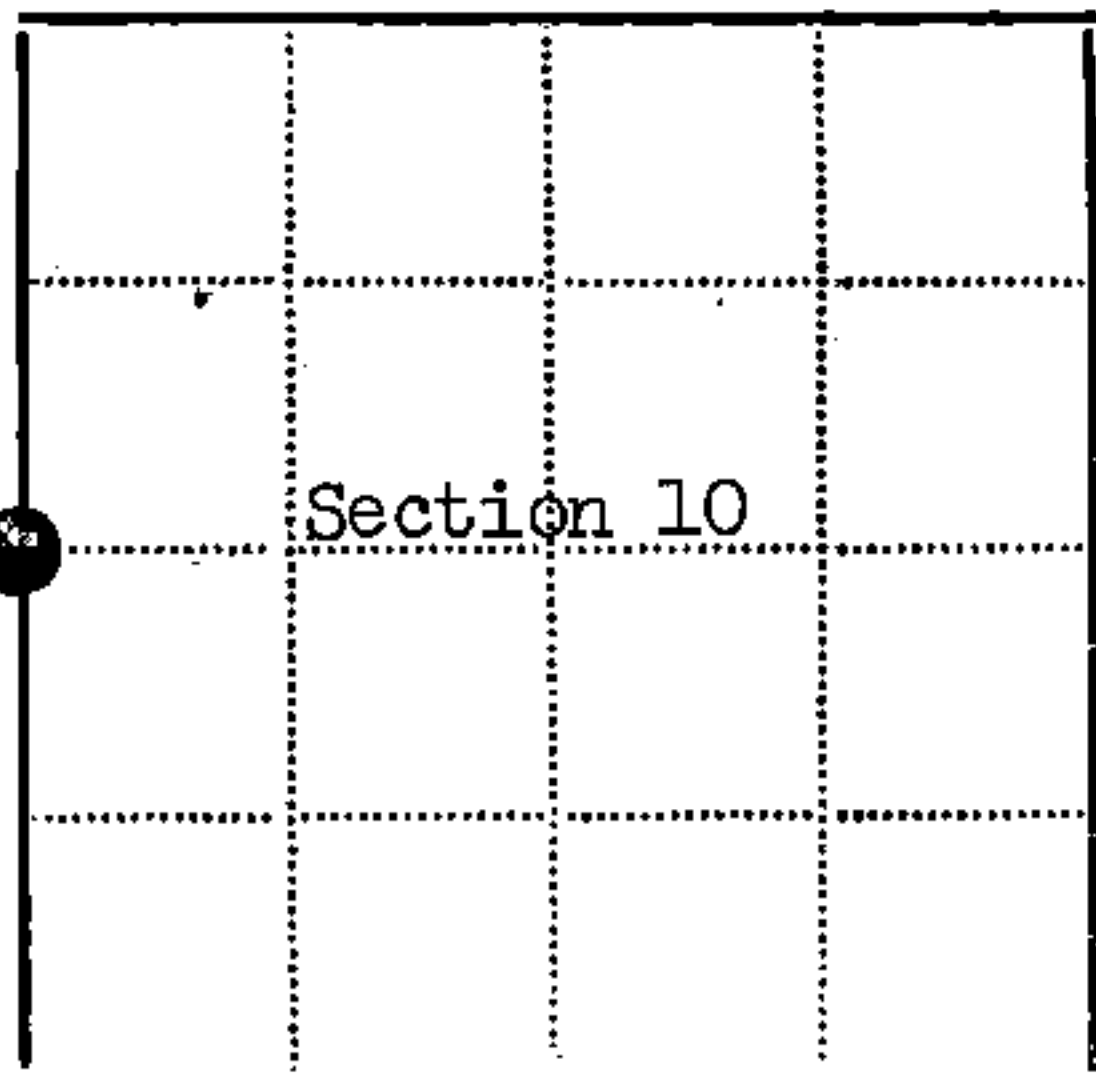

● - Corner monument restored
□ -

Resident witnesses.....

Dated at Rhinelander, Wisconsin, this 13th day of September, 1983.

Signature Milo E. Stefan Title Land Surveyor
(County Surveyor, Registered Land Surveyor, or other duly authorized official)

Surveyors Registration No. RLS-1558

Office of Register of Deeds County of Forest

I hereby certify that the within instrument was filed in this office for record on the 13th day of September, 1983, and was filed in Book No. Page No. of County Records.

Signature Eugene Staszynski Title Register of Deeds

Township 36 North, Range 15 East, Section 10, Index No. G-13, Page No. 15