


U. S. PUBLIC LAND SURVEY MONUMENT RECORD

INSTRUCTIONS: This record shall show the location of the corner and shall include all of the following nine elements (a through i).

- (a) Identify the corner by reference to the U.S. public land survey system.
- = Corner monument restored.

Quarter corner to Sections 16 and 17, T.36N., R.15E., Forest County, Wisconsin.

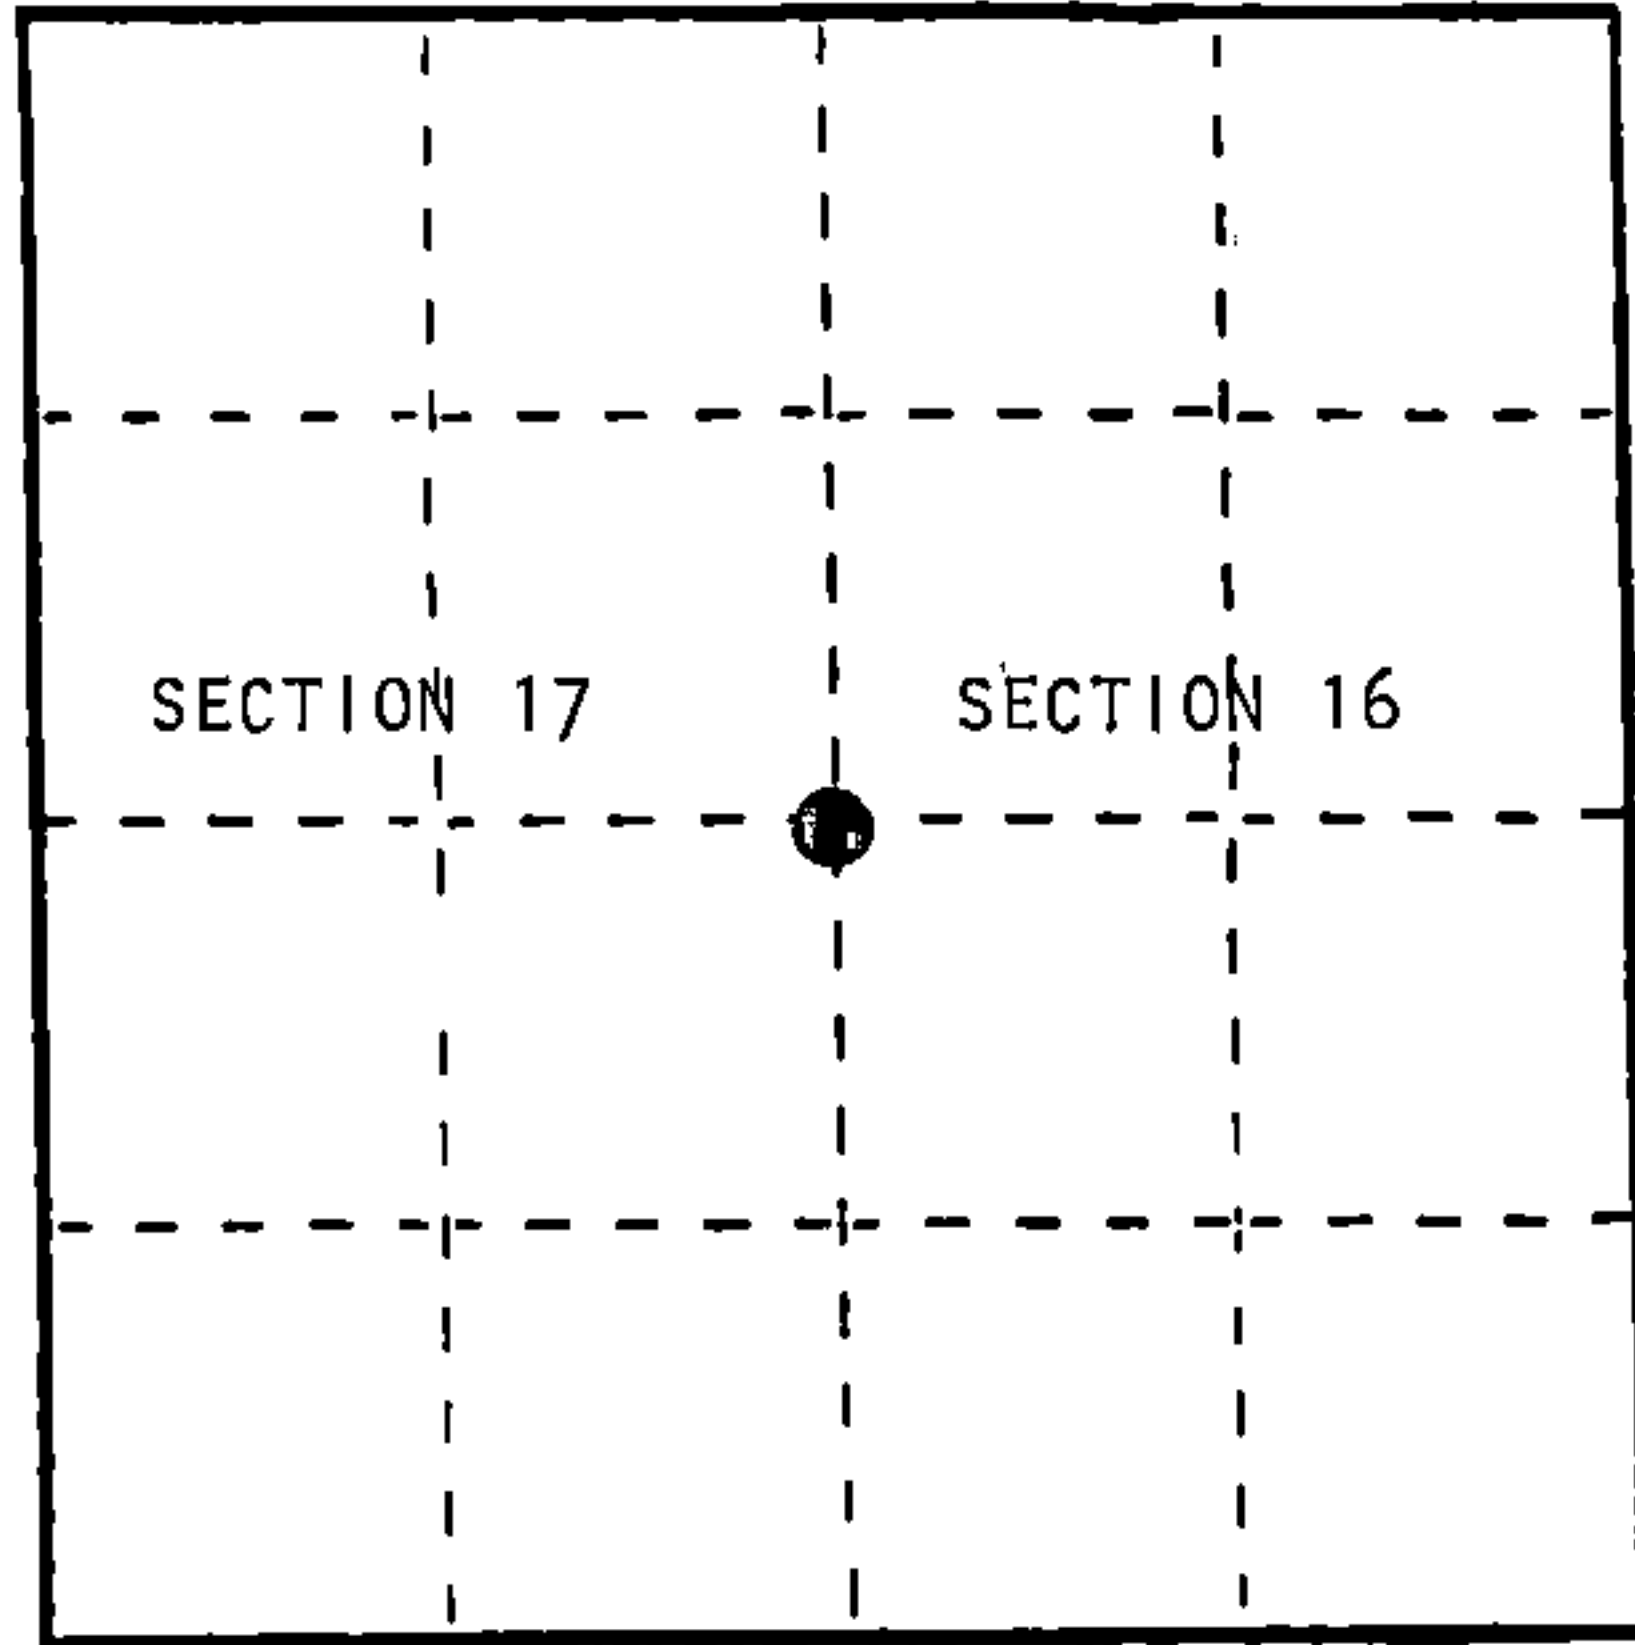

REGISTER'S OFFICE  
 Forest County, Wis.  
 Received for record this 21st day  
 of April A.D., 1987 at  
 9:20 o'clock A.M. and recorded  
 in Vol. CORNER RESTORATIONS  
 page 4-9  
*Paul Achenbrenner*  
 Register of Deeds


- (b) Describe any record evidence, monument evidence, occupational evidence, testimonial evidence or any other material evidence you considered, and whether the monument was found or placed.

In 1859 James McBride set a wood post with the following Bt's: Sugar, 10", S.34E., 17 lks.; Birch, 14", N.62W., 37 lks.  
 In 1911 J.J. Melindy found: Post bw W.L. Harris; original Birch, 18", N.62W., 36½ lks; Original Maple, 14", S.34E., 17 lks. Made new BT: Maple 14", N.50 3/4 E., 36 3/4 lks.  
 In 1979, J. Resvick (RLS) found: fence post with hemlock post point along side of fence post; Sugar, 21", S.34E., 17 lks.  
 In 1982 Milo Stefan found: corner position marked by a post point with original Sugar Maple BT, S.34°E., 17 links, and fence lines north, south, and west. Accepted post point as true location of corner and monumented the same.

- (c) In the plan view drawing below, provide reference ties to at least 4 witness monuments, or, if the location is within a municipality, to at least 2 witness monuments. (Witness monuments shall be made of concrete, natural stone, iron or other equally durable material.) Describe witness monuments.

- (d) Show a plan view drawing depicting the relevant monuments and reference ties which is sufficient in detail to enable accurate relocation of the corner monument if the corner monument is disturbed. Indicate north.

1. 2'x 36" aluminum monument stamped to identify corner.
2. Hemlock, 18", N.46°E., 33.74 feet
3. Sugar Maple, 21", S.38°E., 11.36 feet
4. Sugar Maple, 8", N.17°W., 53.61 feet
5. Steel Sign Post, South, 1.00 feet

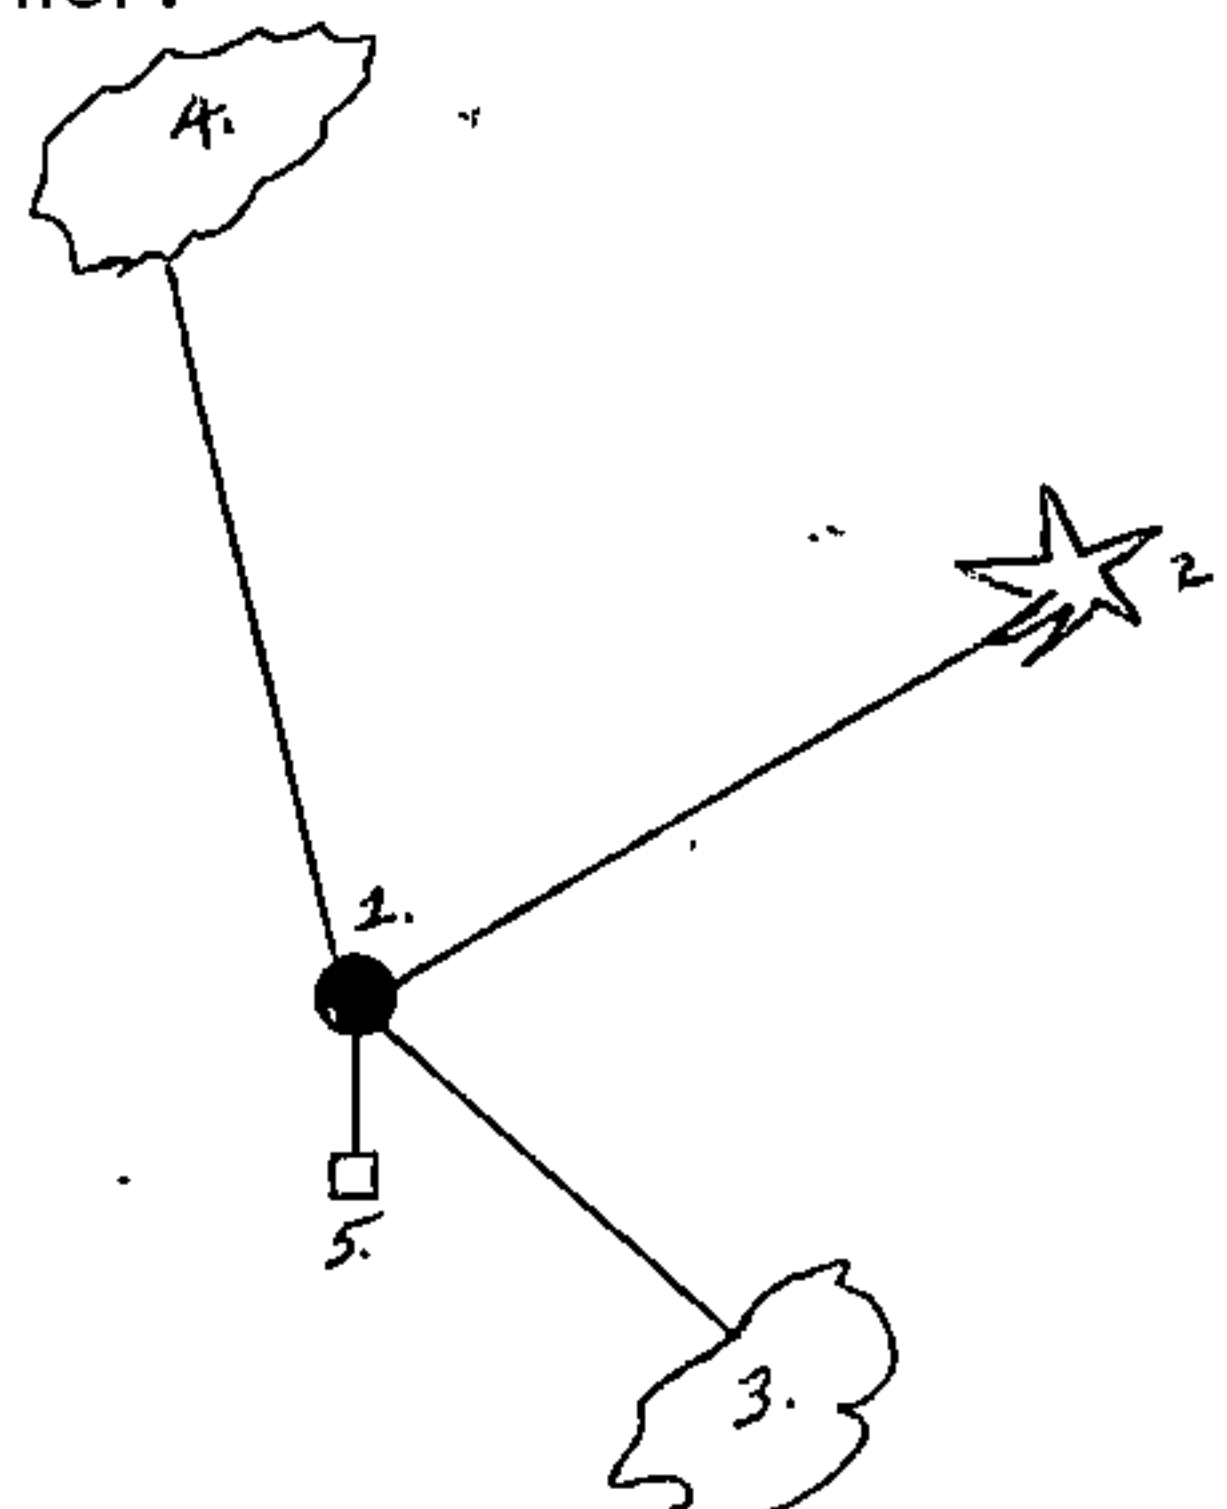

(e) Describe any material discrepancy between the location of the corner as restored or reestablished and the location of that corner as previously restored or reestablished by distance and direction. Show the discrepancy on the plan view drawing under (d), above. Show the distances between the corner as previously restored or reestablished and (1) the corner as restored or reestablished, and (2) to at least 2 of the witness monuments shown on the drawing in (d), above.

None.

(f) Was the corner restored through acceptance of (1) an obliterated evidence location, or, (2) a found perpetuated location?

Original bearing tree and post point.

(g&h) Was the corner reestablished through lost corner proportionate methods? If so, show the method, including the directions and distances to other public land survey corners used as evidence or used for proportioning in determining the corner location?

No.

Affix Land Surveyor Seal



(1) I, Milo E. Stefan  
(Type or print name) certify that the corner location shown on this record was determined by me or under my direction and control and that this U.S. Public Land Survey Monument Record is correct and complete to the best of my knowledge and belief.

Milo E. Stefan  
Signature

3/30/87  
Date


## U. S. PUBLIC LAND SURVEY MONUMENT RECORD

## INSTRUCTIONS:

This record shall show the location of the corner and shall include all of the following nine elements (a through i).

- (a) Identify the corner by reference to the U.S. public land survey system.  
 ○ = Corner monument restored.

Quarter Corner to Sections 16 and 17,  
 T.36N., R.15E., Forest County, Wisconsin.

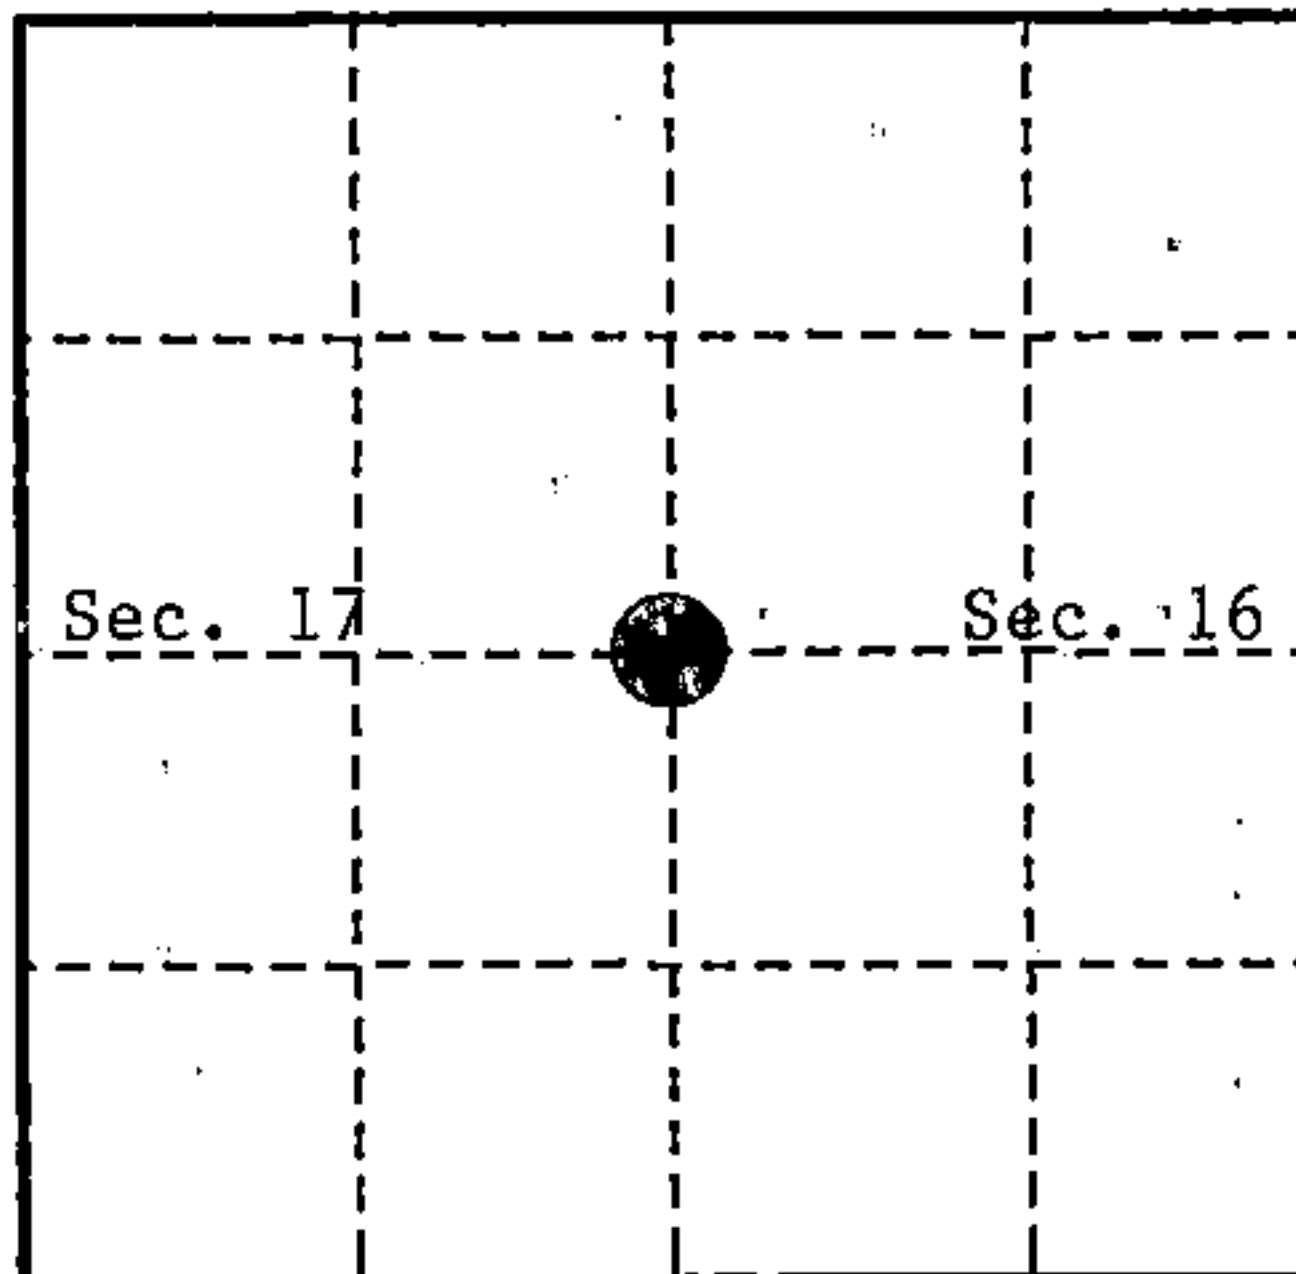

- (b) Describe any record evidence, monument evidence, occupational evidence, testimonial evidence or any other material evidence you considered, and whether the monument was found or placed.

In 1859, James McBride set a wood post with the following B.T.'s: Sugar, 10", S.43°E., 17 links (11.22 feet); Birch, 14", N.62°W., 37 links (24.42 feet).

In 1911, J. J. Melindy found post by W. L. Harris; original Birch, 18", N.62°W., 36 1/2 links (24.09 feet); original Maple, 14", S.34°E., 17 links (11.22 feet).  
 Made new B.T.: Maple, 14", N.50 3/4°E., 36 3/4 links (24.255 feet).

In 1979, J. Resvick (RLS) found fence post with Hemlock post point alongside of fence post: Sugar, 21", S.34°E., 17 links (11.22 feet).


In 1982, Milo Stefan (RLS) found corner position marked by a post point with original Sugar B.T., S.34°E., 17 links (11.22 feet) and fence lines north, south and west. Accepted post point as true location of corner and monumented the same (for B.T.'s see items c & d).

In 1991, Alan Harrison (RLS) found corner and accessories as per Stefan with the Hemlock B.T. dead. Added new B.T.

- (c) In the plan view drawing below, provide reference ties to at least 4 witness monuments, or, if the location is within a municipality, to at least 2 witness monuments. (witness monuments shall be made of concrete, natural stone, iron or other equally durable material.)

- (d) Show a plan view drawing depicting the relevant monuments and reference ties which is sufficient in detail to enable accurate relocation of the corner monument if the corner monument is disturbed. Indicate north.

1. 2 1/2" x 36" aluminum monument stamped to identify the corner.
2. Hemlock, 18", N.46°E., 33.74 feet (dead)
3. Sugar, 21", S.38°E., 11.36 feet (old)
4. Red Oak, 6", S.89°W., 26.23 feet (new)
5. Sugar, 8", N.17°W., 53.61 feet (old)
6. Steel Sign Post, South, 1.00 feet (old)

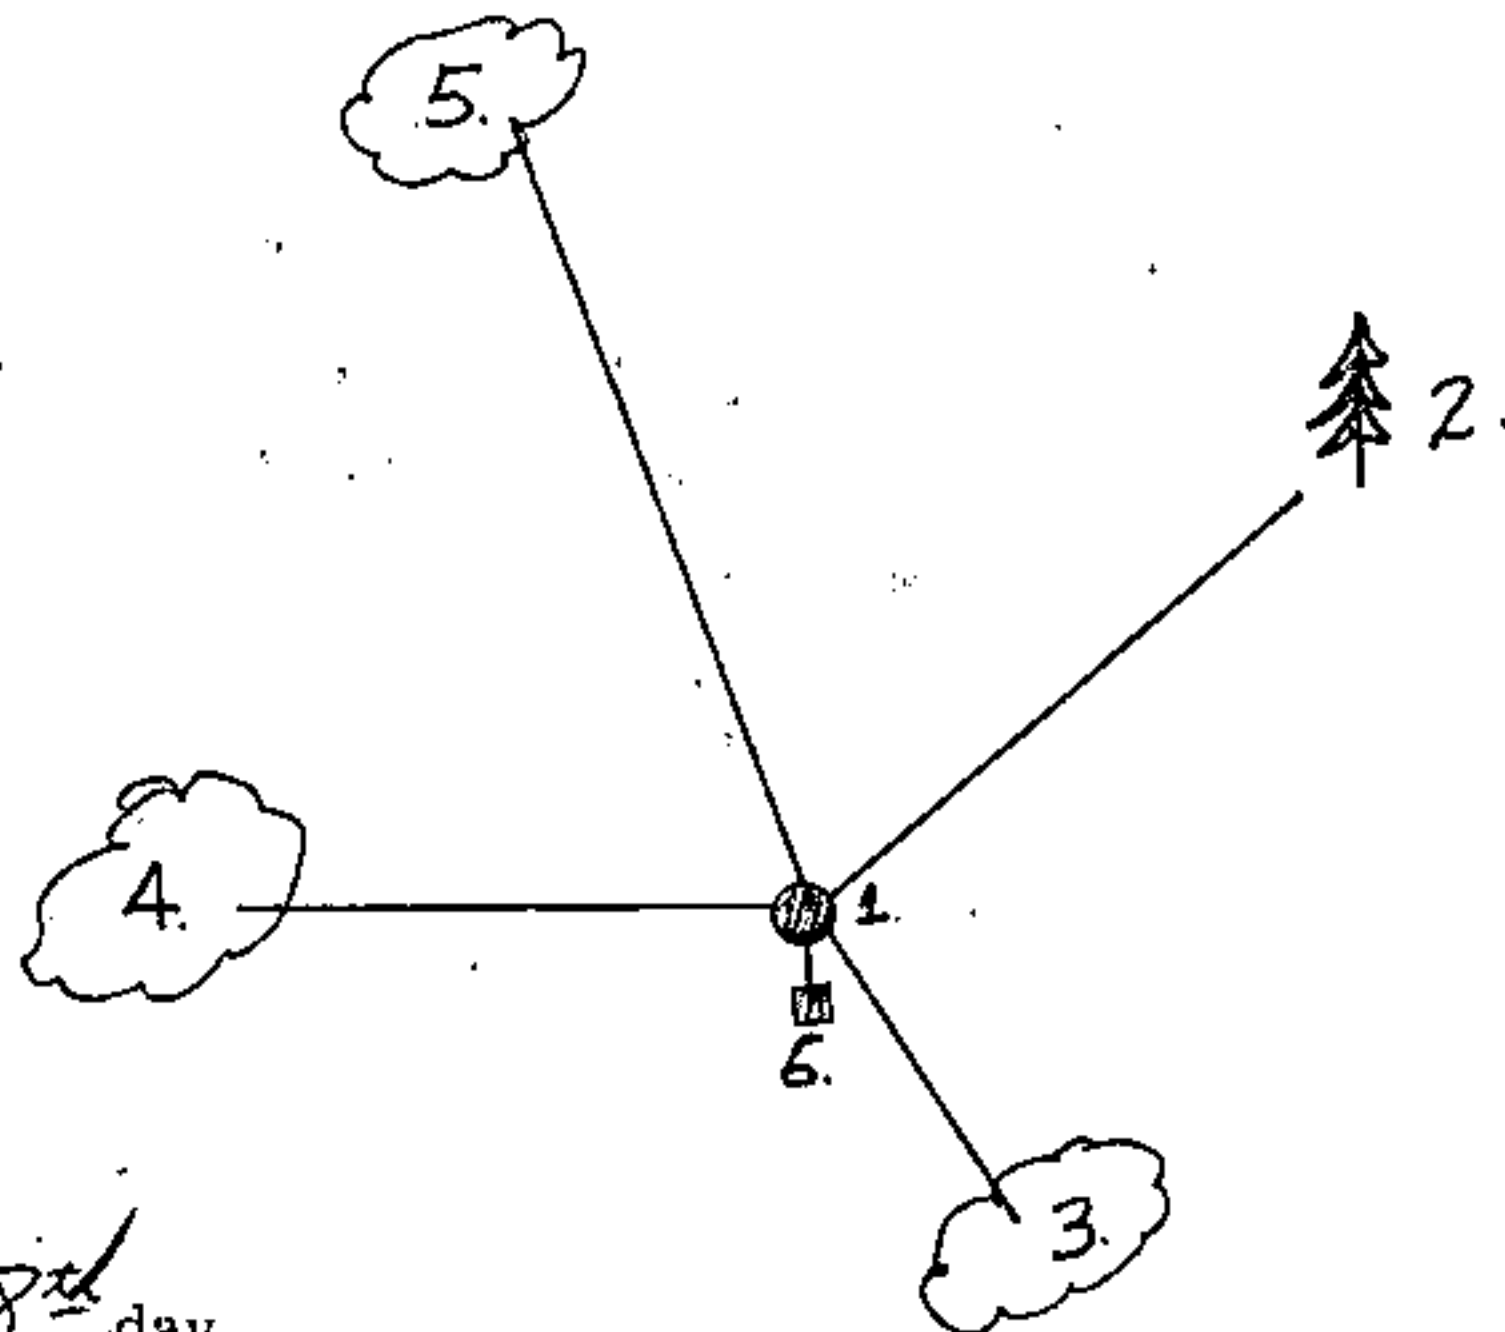

REGISTER'S OFFICE  
 Forest County, Wis.

Received for record this 8<sup>th</sup> day  
 of April A.D., 1991 at  
1:15 o'clock P.M. and recorded  
 in Vol. CORNER RESTORATIONS  
 page 4-9

*Paul Aschenbrenner*  
 Register of Deeds

(a) Describe any material discrepancy between the location of the corner as restored or reestablished and the location of that corner as previously restored or reestablished by distance and direction. Show the discrepancy on the plan view drawing under (d), above. Show the distances between the corner as previously restored or reestablished and (1) the corner as restored or reestablished, and (2) to at least 2 of the witness monuments shown on the drawing in (d), above.

None.


(f) Was the corner restored through acceptance of (1) an obliterated evidence location, or, (2) a found perpetuated location?

(2) a found perpetuated location.

(g & h) Was the corner reestablished through lost corner proportionate methods? If so, show the method, including the directions and distances to other public land survey corners used as evidence or used for proportioning in determining the corner location?

No.

(1) I, Alan D. Harrison  
(type or print name) certify that the corner location shown on this record was determined by me or under my direction and control and that this U.S. Public Land Survey Monument Record is correct and complete to the best of my knowledge and belief.

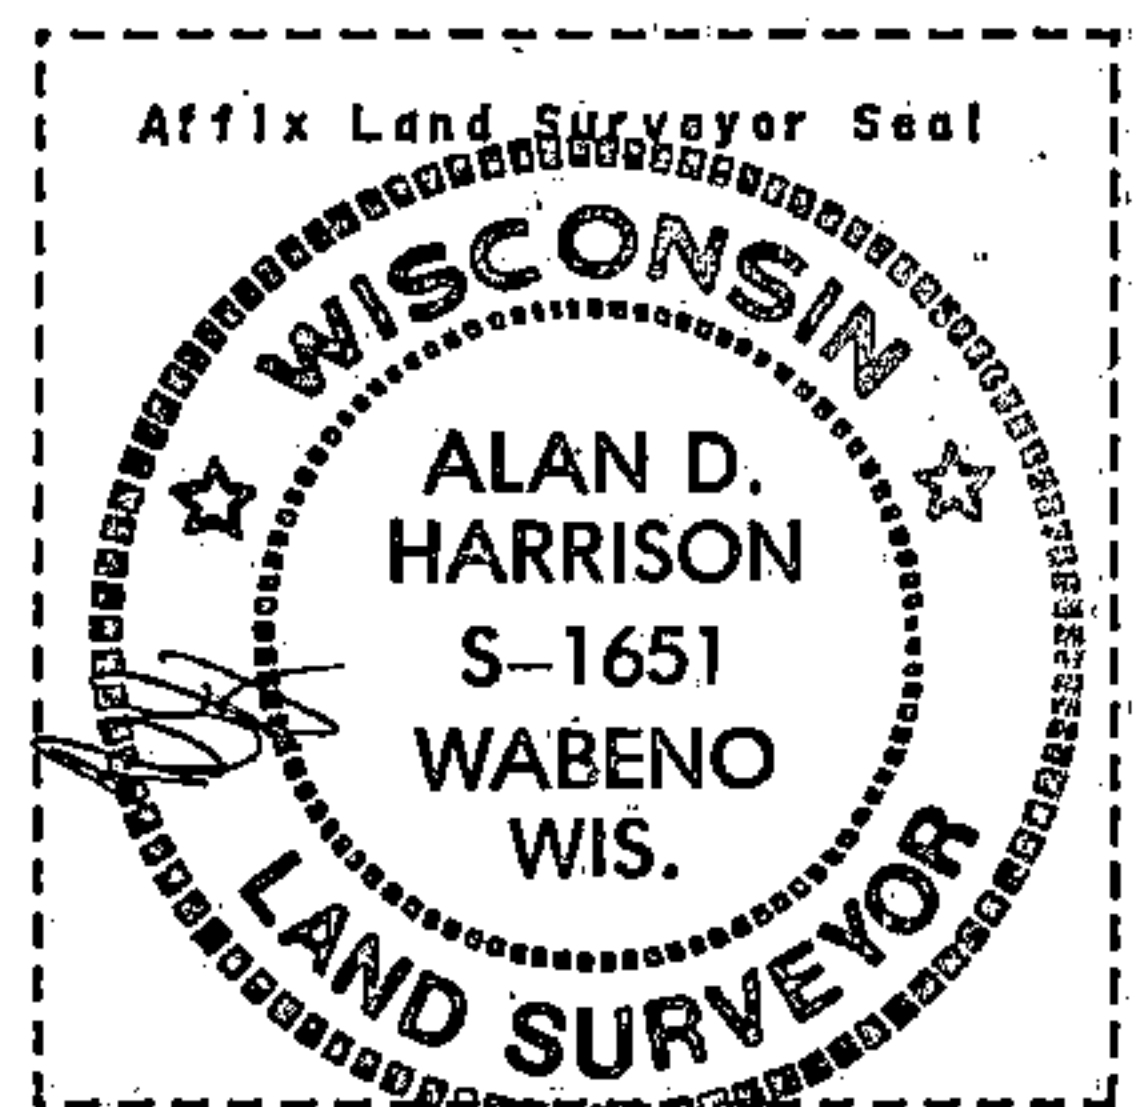

Alan D. Harrison  
Signature

4/1/91  
Date

CERTIFICATE READY FOR FILING:

Dale Staege  
District Ranger