


U. S. PUBLIC LAND SURVEY MONUMENT RECORD

INSTRUCTIONS: This record shall show the location of the corner and shall include all of the following nine elements (a through i).

- (a) Identify the corner by reference to the U.S. public land survey system.
- O = Corner monument restored.

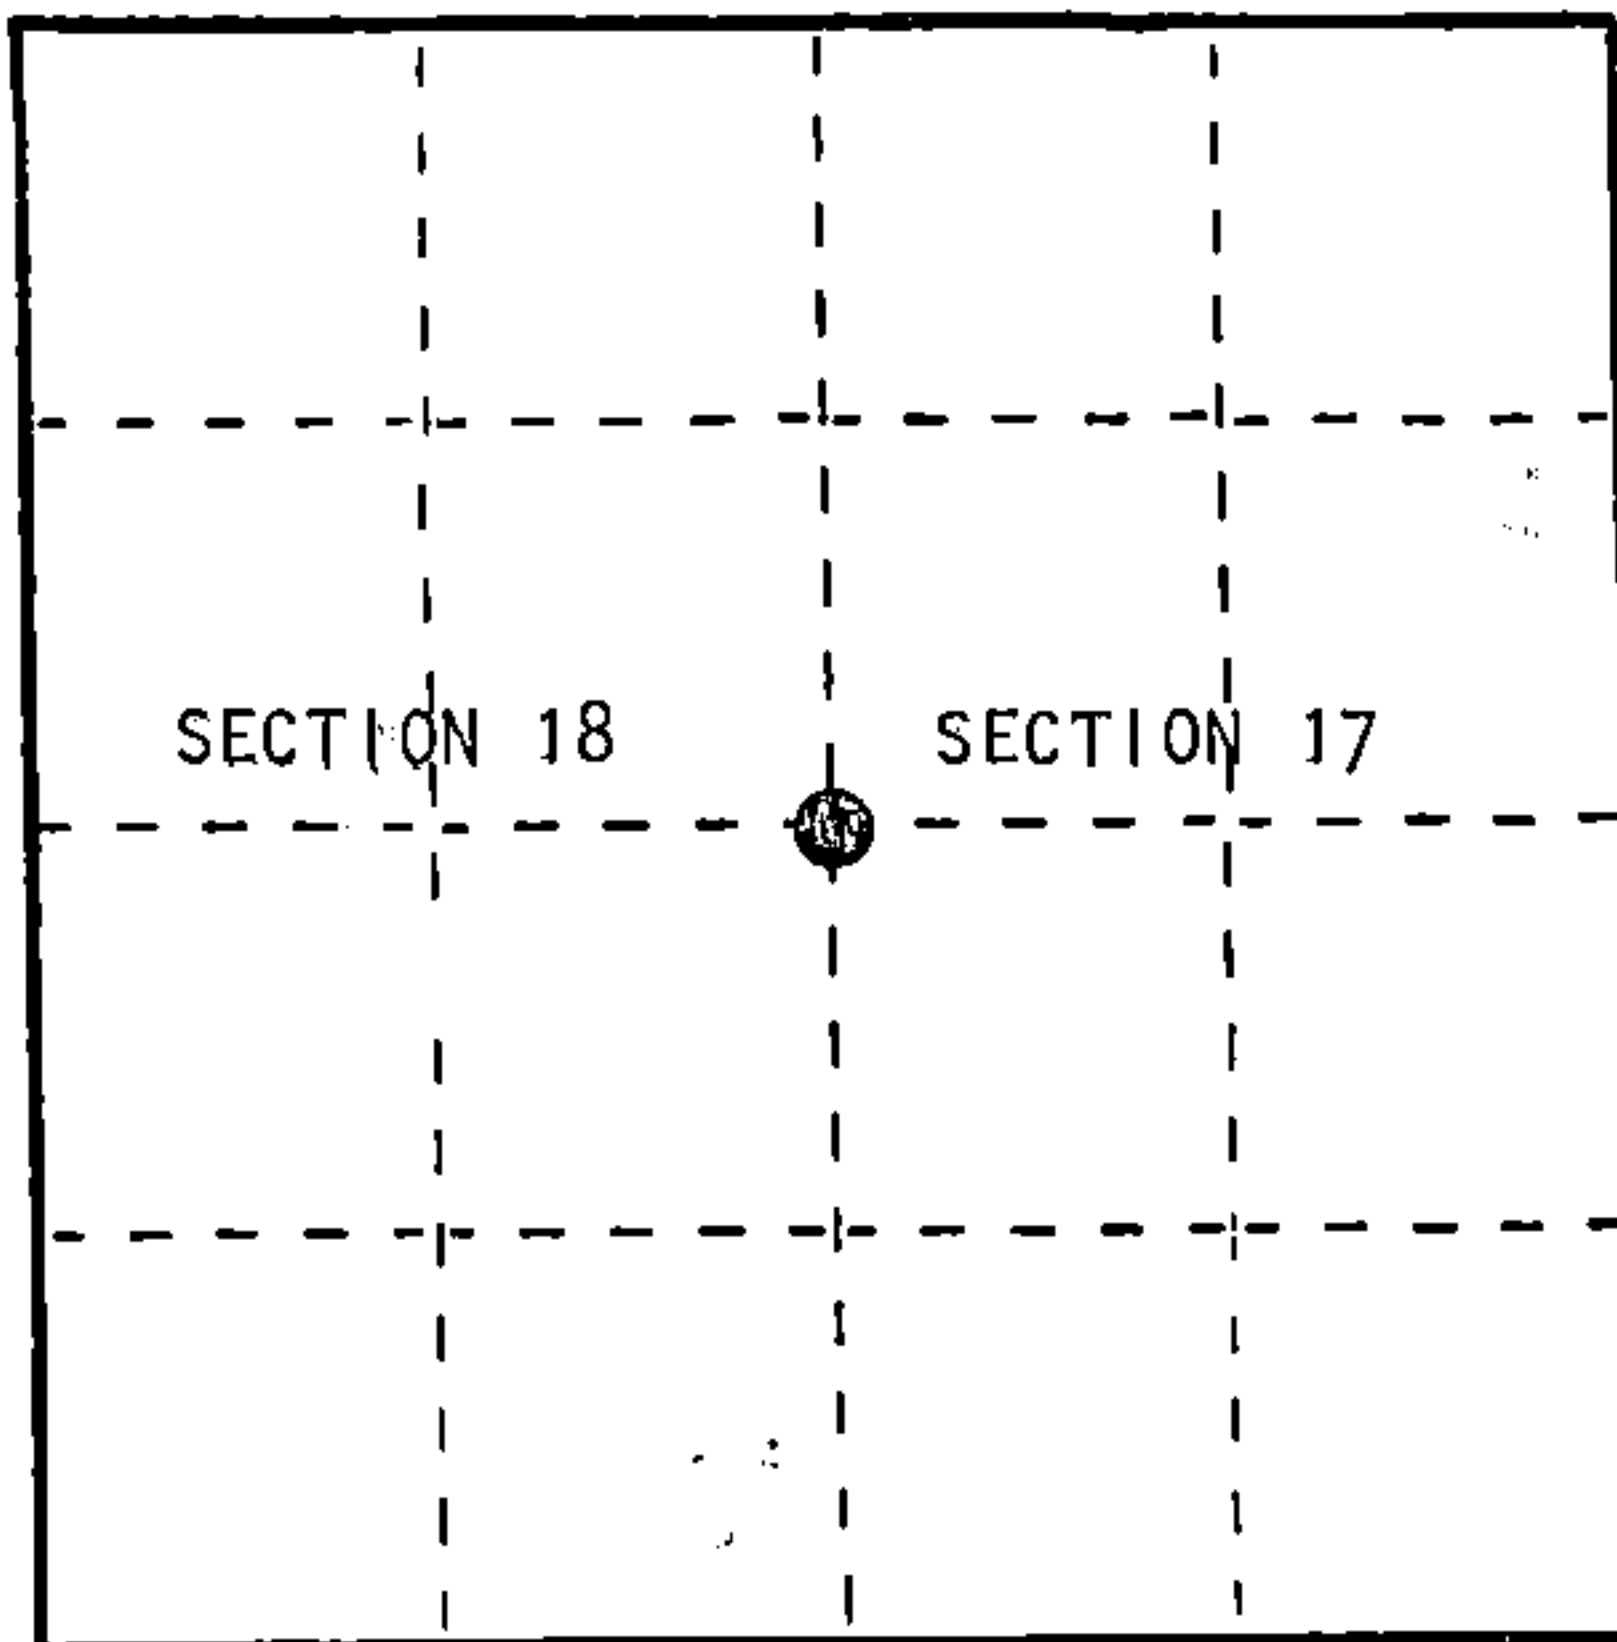

Quarter corner to Sections 17 and 18, T.36N., R.15E., Forest County, Wisconsin.

REGISTER'S OFFICE
 Forest County, Wis.
 Received for record this 21st day
 of April A.D., 1987, at
9:20 o'clock A.M. and recorded
 in Vol. CORNER RESTORATIONS
 page 5
Paul Hechendorfer
 Register of Deeds

(b) Describe any record evidence, monument evidence, occupational evidence, testimonial evidence or any other material evidence you considered, and whether the monument was found or placed.

In 1859 James McBride set a wood post with the following BT's: Spruce, 6", N.45W., 37 lks; Spruce, 6", N.55E., 7 lks.

In 1911 J.J. Melindy found a 4"x4" post 10" below road surface and made new BT's: Tamarack, 6", S.48½E., 47 lks; Tamarack, 4", N.47 3/4W., 34 7/8 lks; Spruce, 4", N.56E., 35 lks.


In 1936 W. Engblom found: a cedar post buried in center of road; Tamarack, 6", S.49E., 46 lks. He placed a metal location tag on a 6" white post S.87E. 30 lks from corner.

In 1982 M. Stefan (RLS) found fence corner 31.25 ft. west of centerline of road. Fences run west and north. Found no post or BT's. Restored corner position at centerline Rd. and at extension of fence line from west as best remaining evidence.

(c) In the plan view drawing below, provide reference ties to at least 4 witness monuments, or, if the location is within a municipality, to at least 2 witness monuments. (Witness monuments shall be made of concrete, natural stone, iron or other equally durable material.) Describe witness monuments.

(d) Show a plan view drawing depicting the relevant monuments and reference ties which is sufficient in detail to enable accurate relocation of the corner monument if the corner monument is disturbed. Indicate north.

- 2" x 36" aluminum monument with tablet stamped to identify corner.
- Black Spruce, 4", N.41°E., 39.97 feet
- Tamarack, 5", S.43°E., 41.05 feet
- Power Pole #3615-18R12, S.37°W., 53.58 feet
- Witness Corner, 2" x 36" aluminum monument, east, 30.25 feet

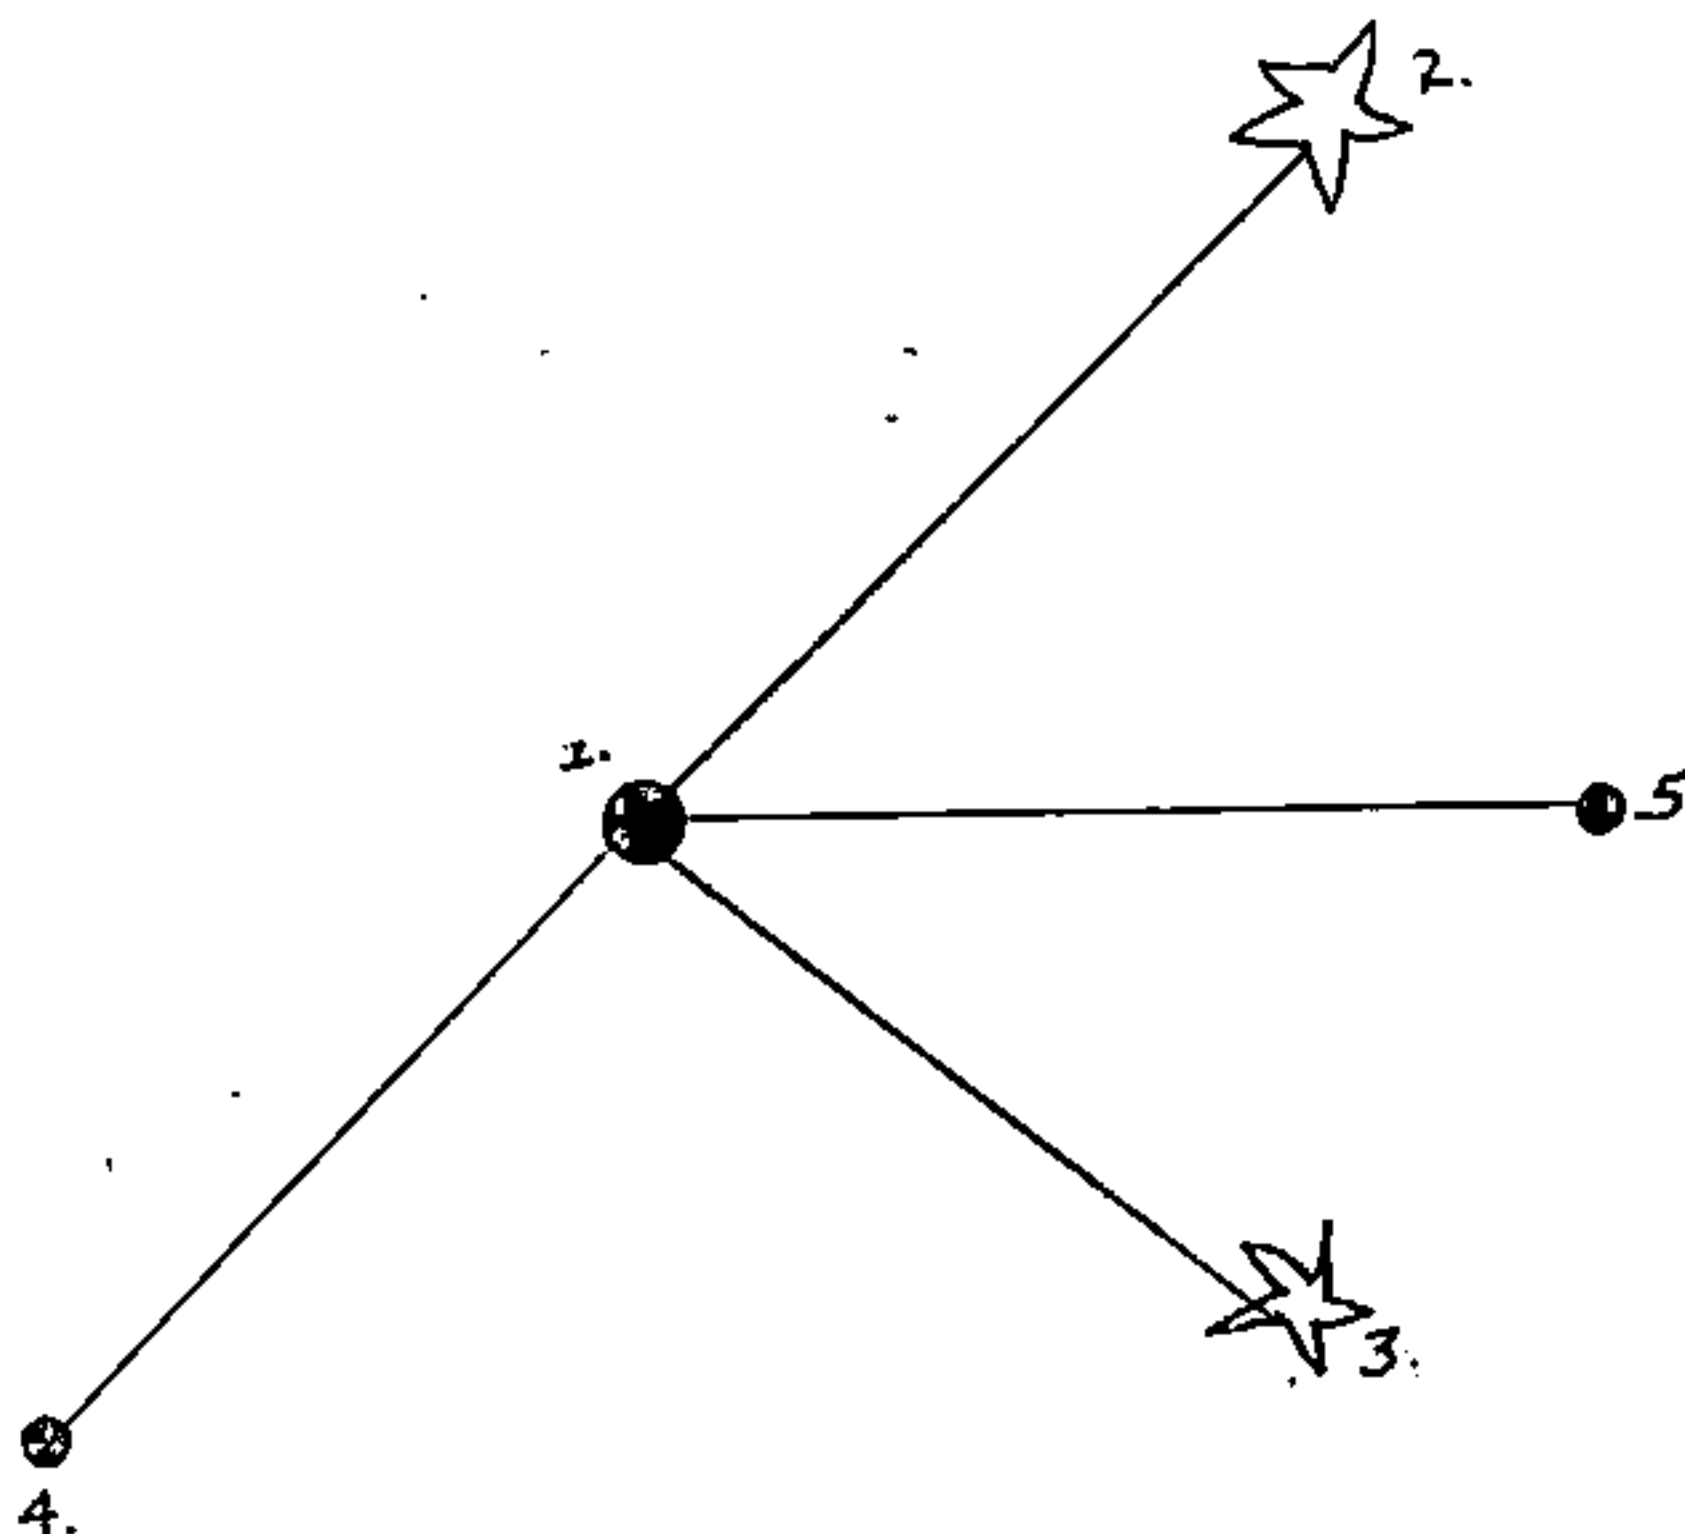

43615182000

(e) Describe any material discrepancy between the location of the corner as restored or reestablished and the location of that corner as previously restored or reestablished by distance and direction. Show the discrepancy on the plan view drawing under (d), above. Show the distances between the corner as previously restored or reestablished and (1) the corner as restored or reestablished, and (2) to at least 2 of the witness monuments shown on the drawing in (d), above.

None.

(f) Was the corner restored through acceptance of (1) an obliterated evidence location, or, (2) a found perpetuated location?

Obliterated evidence.

(g&h) Was the corner reestablished through lost corner proportionate methods? If so, show the method, including the directions and distances to other public land survey corners used as evidence or used for proportioning in determining the corner location?

No.

Affix Land Surveyor Seal



(i) I, Milo E. Stefan
(type or print name) certify that the corner location shown on this record was determined by me or under my direction and control and that this U.S. Public Land Survey Monument Record is correct and complete to the best of my knowledge and belief.

Milo E. Stefan
Signature

3/30/87
Date