

U. S. PUBLIC LAND SURVEY MONUMENT RECORD


INSTRUCTIONS:

This record shall show the location of the corner and shall include all of the following nine elements (a through i).

- (a) Identify the corner by reference to the U.S. public land survey system.  
 ○ = Corner monument restored.  
 Quarter Corner between Sections 6 and 31, T.35-36N R.15E., Forest County, Wisconsin

State Plane Coordinates, Wisconsin North Zone  
 N- 142657.11639  
 E-2310572.88427

Geographic Coordinates  
 N-45-33-00.01245  
 W-88-39-53.07803

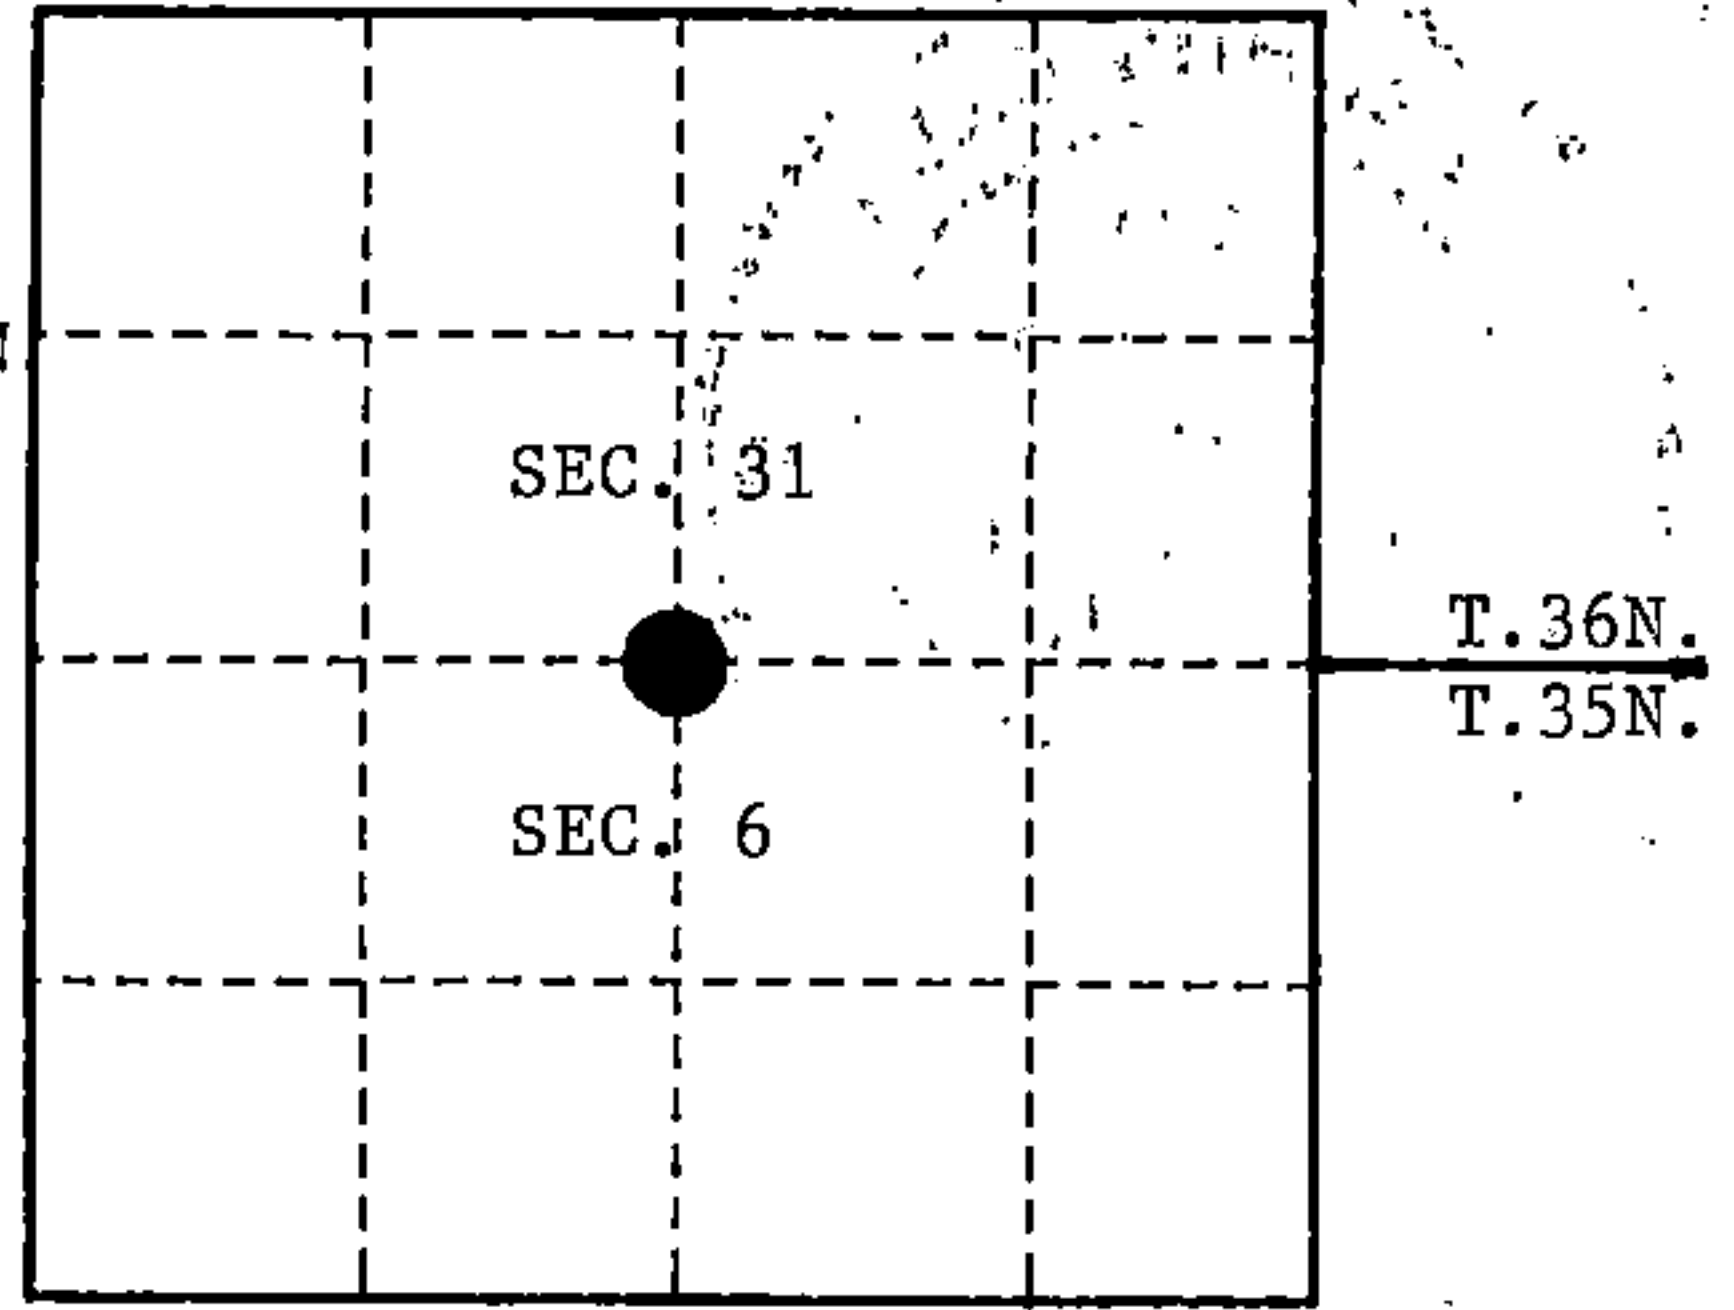

- (b) Describe any record evidence, monument evidence, occupational evidence, testimonial evidence or any other material evidence you considered, and whether the monument was found or placed.  
 Original survey in 1857 by Artemas Curtis. Set wood post, from which the following bear; Cedar, 8", N.06°W., 29 lks., Cedar, 6", S.12°W., 9 lks. West, 8.75 chains, stream 125 lks. wide runs South-Southeast.


In 1965, Jean Resvick, RLS with the Forest Service, found a 4"x4"x4' high cedar post scribed, 1/4 S. Also found a T-fence North that is approximately 60 years old. Found both original bearing tree stump holes. Measured West 577 feet to stream. Replaced cedar post with a 2"x60" galvanized iron pipe with a brass cap stamped to identify the corner. Blazed and scribed the bearing trees as noted below.

In 1995, Alan Harrison, RLS with the Forest Service, found the monument and bearing trees as set by Jean Resvick in 1965.

- (c) In the plan view drawing below, provide reference ties to at least 4 witness monuments, or, if the location is within a municipality, to at least 2 witness monuments. (witness monuments shall be made of concrete, natural stone, iron or other equally durable material.)

- (d) Show a plan view drawing depicting the relevant monuments and reference ties which is sufficient in detail to enable accurate relocation of the corner monument if the corner monument is disturbed. Indicate north.

1. 2"x60" iron pipe with brass cap stamped to identify corner.
2. Black Ash, 4", N.63°E., 22.18 feet
3. Cedar, 4", S.15°E., 25.72 feet
4. Black Ash, 8", S.45°W., 26.46 feet
5. Balsam, 4", N.18°W., 23.88 feet

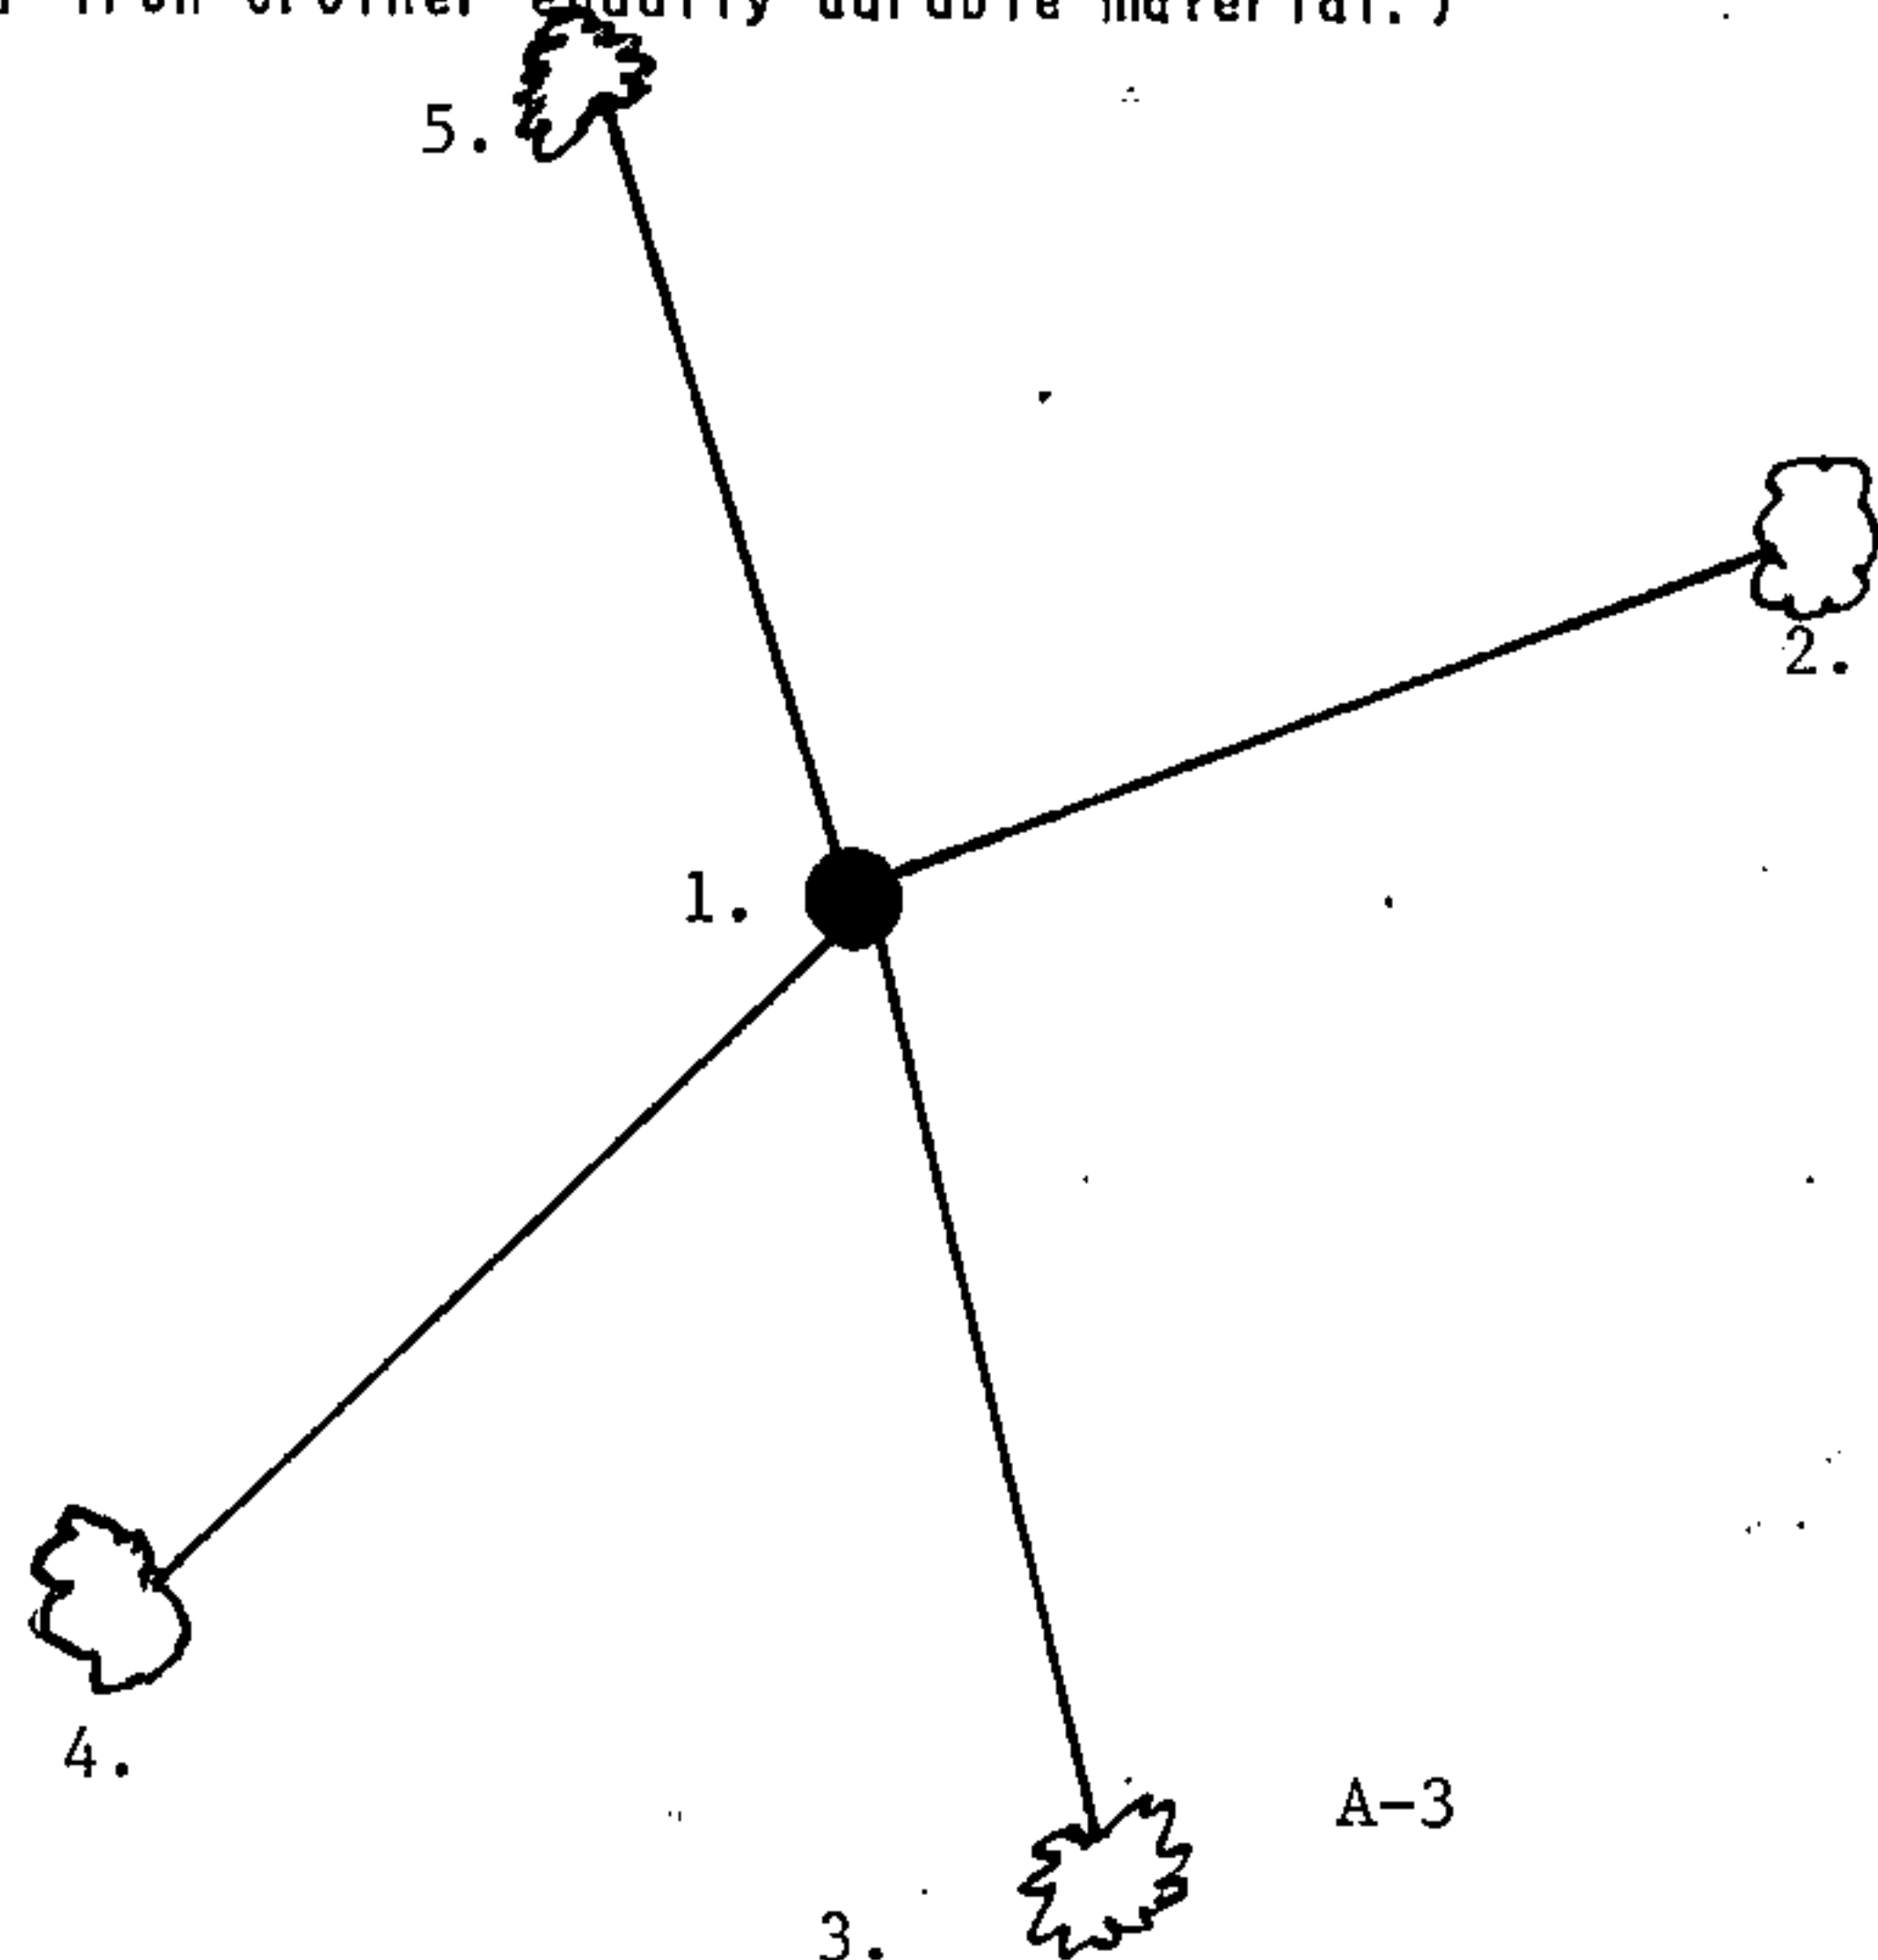

(e) Describe any material discrepancy between the location of the corner as restored or reestablished and the location of that corner as previously restored or reestablished by distance and direction. Show the discrepancy on the plan view drawing under (d), above. Show the distances between the corner as previously restored or reestablished and (1) the corner as restored or reestablished, and (2) to at least 2 of the witness monuments shown on the drawing in (d), above.

None

(f) Was the corner restored through acceptance of (1) an obliterated evidence location, or, (2) a found perpetuated location?

(2.)

(g & h) Was the corner reestablished through lost corner proportionate methods? If so, show the method, including the directions and distances to other public land survey corners used as evidence or used for proportioning in determining the corner location?

No

REGISTER'S OFFICE  
Forest County, Wis.  
Received for record this 30<sup>th</sup> day  
of November, A.D., 1995 at  
1:30 o'clock P.M. and recorded  
in Vol Cran Restoration  
page 35-36-15-A-3  
*[Signature]*  
Register of Deeds



Alan D. Harrison

(1) I, Alan D. Harrison  
(type or print name) certify that the corner location shown on this record was determined by me or under my direction and control and that this U.S. Public Land Survey Monument Record is correct and complete to the best of my knowledge and belief.

*[Signature]* 11/28/95  
Signature Date

CERTIFICATE READY FOR FILING:

*[Signature]*  
District Ranger