

## CERTIFIED LAND CORNER RESTORATION

State of Wisconsin

County of Forest

} ss.

I Jean F. Resvick, do hereby certify that on the 11 day of March, 19 76, I found evidence of the Southwest section corner of Section 31 Township 36 North, Range 16 East, Fourth Principal Meridian, as described hereon; and that from this evidence I established a new monument and accessories as described hereon to perpetuate the original location of this corner:

## Description of original monument and accessories and subsequent restorations:

Survey in 1857 by Artemas Curtis  
 91.41 chains west between Sections 6 and 31 set post  
 Sugar 15, N18W, 19 lks.  
 Yellow Birch, 12, N62E, 55 lks.  
 Sugar 10, S70W, 26 lks.  
 Lynn 12, S10E, 50 lks. (note for range line records this as being a Sugar)  
 North, 17 chains enter swamp NE NW


## Description of corner evidence found:

Maple post in mound of rock  
 Old post lying by mound.  
 Yellow Birch 26, bears N62E, 53 lks.  
 Location poster dated 6/11/36 by J.H.

## Description of monument and accessories I established to perpetuate the location of this corner:

Set 2 inch inside diameter, galvanized iron pipe, 3 feet long, filled with concrete with brass cap stamped:  
 T36N, R15E, R16E, S36, S31, S1, S6, T35N, 1976, S-802  
 Blazed and scribed the following new bearing trees,  
 Maple 13, N63E, 10.10 ft.  
 Basswood 9, S33W, 25.37 ft.  
 Basswood 9, N59W, 12.96 ft.  
 Set steel sign post 0.5 ft. west of monument

43615360000

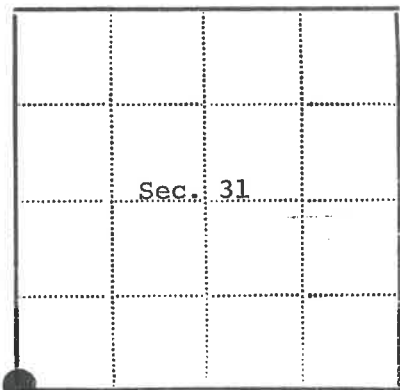

● - Corner monument restored  
 □ -

Resident witnesses

Dated at RhinelandWisconsin, this 11 day of March19 76.Signature Jean F. ResvickTitle Land Surveyor

(County Surveyor, Registered Land Surveyor, or other duly authorized official)

Surveyors Registration No. S-802DOCUMENT NUMBER  
**109589**Office of Register of Deeds County of Forest

I hereby certify that the within instrument was filed in this office for record on the 2nd day of July, 19 76, and was filed in Book No. \_\_\_\_\_ Page No. \_\_\_\_\_ of County Records.

Signature Eugene Stutzman Title Register of DeedsTownship 36 North, Range 16 East, Section 31, Index No. Z-1, Page No. 21