

CERTIFIED LAND CORNER RESTORATION

State of Wisconsin }
County of Forest } ss.

I Milo E. Stefan, do hereby certify that on the 8th day of July, 1982, I found evidence of the North Quarter corner of Section 1 Township 35N, Range 15E, Fourth Principal Meridian, as described hereon; and that from this evidence I established a new monument and accessories as described hereon to perpetuate the original location of this corner:

Description of original monument and accessories and subsequent restorations:

Surveyed in 1857 by Artemus Curtis
40.00 chains, set 1/4 section wood post
Sugar, 14", N41W, 43 lks., 28.38 feet
Basswood, 20", S31E, 41 lks., 27.06 feet


Description of corner evidence found:

Mound of stone with post hole in middle
Possible stump hole, N41W, 28.0 feet
Basswood clump and large stump hole, S31E, 27.0 feet

Description of monument and accessories I established to perpetuate the location of this corner:

Placed a 2" x 36" aluminum monument in mound of stone with tablet stamped as follows:
T36N, R15E, S36, 1/4, S1, T35N, 1982, RLS-1558
From which the following bear:
Hemlock, 14", N85E, 20.35 feet
Sugar, 12", S20W, 11.04 feet
Sugar, 6", N67W, 42.79 feet
Steel sign post, SW, 2.0 feet

DOCUMENT NO.
124181

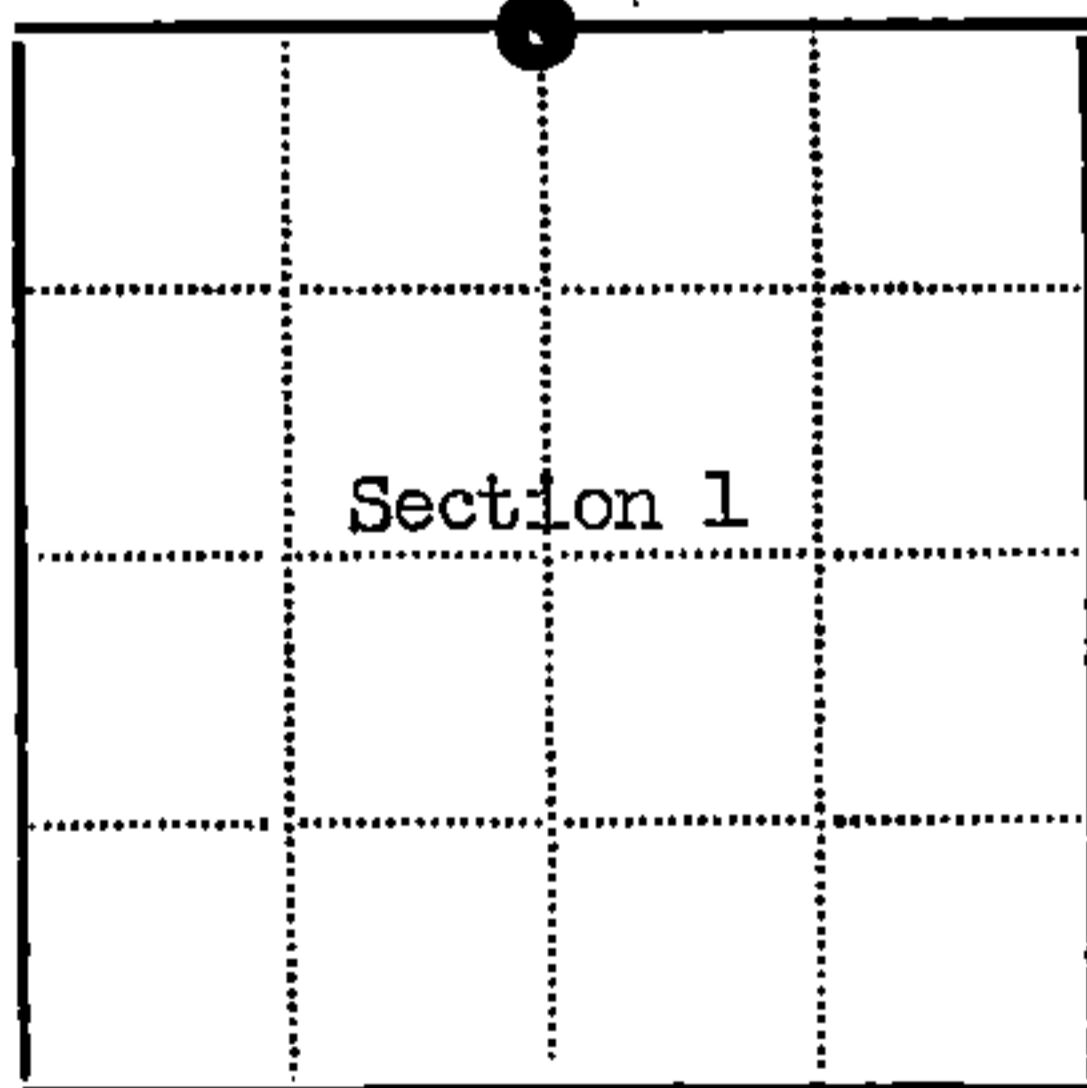

● - Corner monument restored
□ -

Resident witnesses.....

Dated at Rhinelander Wisconsin, this 2 day of MAY 1982

Signature Milo E. Stefan Title Land Surveyor
(County Surveyor, Registered Land Surveyor, or other duly authorized official)

Surveyors Registration No. RLS-1558

Office of Register of Deeds County of Forest

I hereby certify that the within instrument was filed in this office for record on the 12th day of September 12 1983, and was filed in Book No. Page No. of County Records.

Signature Eugene Stutz Title Register of Deeds

Township 35N, Range 15E, Section 1, Index No. A-23, Page No. 63