

CERTIFIED LAND CORNER RESTORATION

State of Wisconsin }
County of Forest } ss.

I Milo E. Stefan, do hereby certify that on the 24th day of June, 1982, I found evidence of the North Quarter corner of Section 12 Township 36 North, Range 16 East, Fourth Principal Meridian, as described hereon; and that from this evidence I established a new monument and accessories as described hereon to perpetuate the original location of this corner:

Description of original monument and accessories and subsequent restorations:

Surveyed in 1858 by James McBride
40.00 chains, set wood post
Spruce, 8", S21°W, 24 lks.
Tamarack, 10", N53°W, 25 lks.


Description of corner evidence found:

Found root remains of Spruce BT, S21°W, 15.84 feet
Tamarack stump, 10", N53°W, 16 1/2 feet scribed "1/4s"
Local Evidence: Location poster (DNR), N84°E, 20.8 feet, on 8" Cedar.

Description of monument and accessories I established to perpetuate the location of this corner:

We placed a 2" x 60" aluminum monument stamped as follows:
T36N, R16E, S1, 1/4, S12, 1982, RLS-1558
From which the following bear:
Cedar, 8", S76°E, 35.08 feet
Cedar, 5", S66°W, 24.77 feet
Cedar, 6", N45°W, 30.21 feet
Steel Sign Post, East, 1.70 feet

DOCUMENT NO.
124220

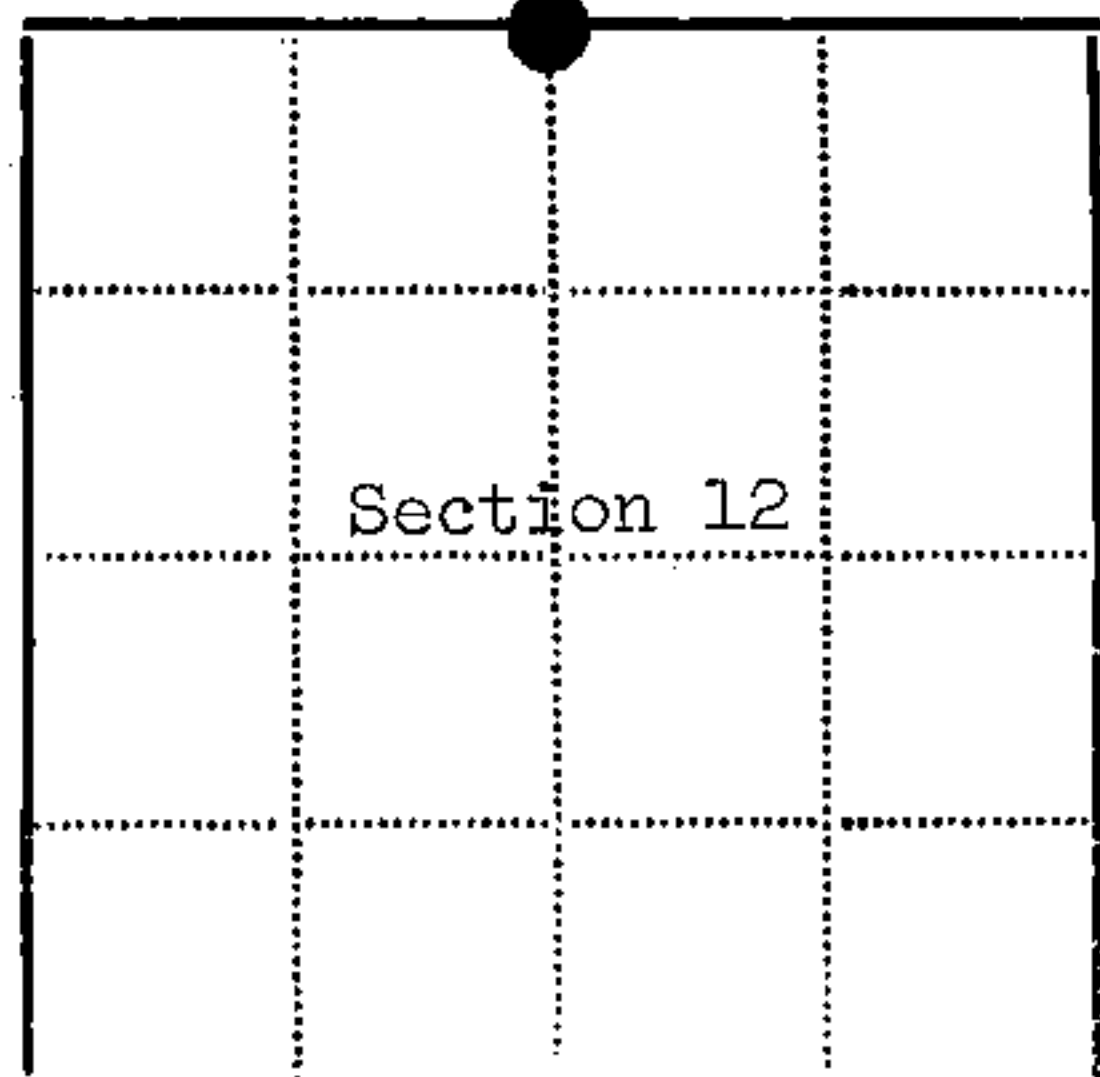

● - Corner monument restored
□ -

Resident witnesses.....

Dated at Rhinelander Wisconsin, this 14th day of September 1983.

Signature *Milo E. Stefan* Title Land Surveyor
(County Surveyor, Registered Land Surveyor, or other duly authorized official)

Surveyors Registration No. RLS-1558

Office of Register of Deeds County of Forest

I hereby certify that the within instrument was filed in this office for record on the 14th day of September 1983, and was filed in Book No. Page No. of County Records.

Signature *Karen Staryny* Title Register of Deeds

Township 36 North, Range 16 East, Section 12, Index No. E-23, Page No. 28

436 16010020

E 21