

U. S. PUBLIC LAND SURVEY MONUMENT RECORD

INSTRUCTIONS:


This record shall show the location of the corner and shall include all of the following nine elements (a through i).

- (a) Identify the corner by reference to the U.S. public land survey system.
 O = Corner monument restored.

Quarter Corner common to Sections 1 and 2,
 T36N-R16E

Index Number C-21 (T36N-R16E)

Forest County, Wisconsin

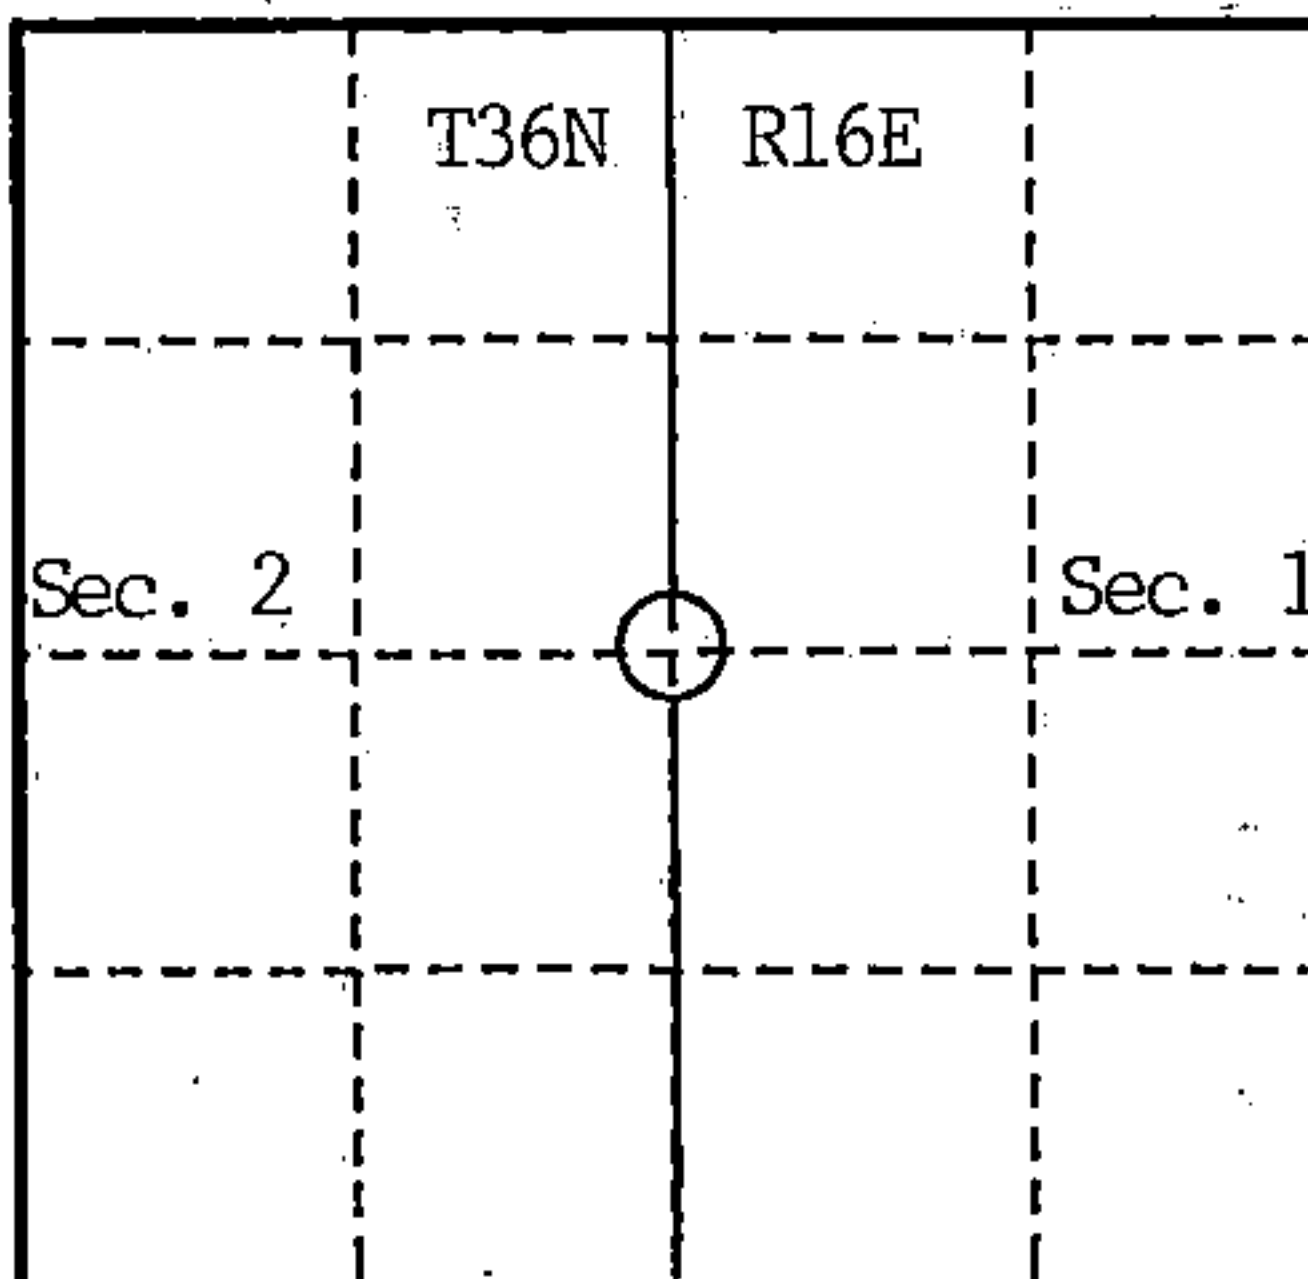

- (b) Describe any record evidence, monument evidence, occupational evidence, testimonial evidence or any other material evidence you considered, and whether the monument was found or placed.

1858 - Original post set by James McBride, witnessed by 36 W. Birch S55E 07 lks.; 12 Sugar N70W 30 lks. Corner was established on corrected closing line 40.00 chains North of corner to 1,2,11 and 12 and 39.84 chains South of standard corner on town line. Original notes contains no information as to feature calls or line trees.


1930 - Goodman Lumber Co. recovered rotted BT stumps and set a 4" oak post in a pile of stones, 10 feet east of a (north-south) road centerline. Other NBTs were noted as existing but not documented.

1991 - Corner search based on traverse between NW and SW corners of Section 1 by Coleman Engineering Company yielded no evidence of 1930 post or NBTs. Engeling Road (F.R. 2371) has been constructed between Sections 1 and 2; it is assumed the centerline was intended to follow the section line. A well-established fenceline runs westerly from the road, and is considered to be supporting occupational evidence of the corner location. The position identified by the road centerline/fenceline intersection is approximately 39.5 feet North of the proportioned position. Despite the conflict with record measurements, I have accepted the existing evidence as locating the most probable position of the true corner, and monumented the road centerline (24' wide gravel) at the fenceline as extended.

- (c) In the plan view drawing below, provide reference ties to at least 4 witness monuments, or, if the location is within a municipality, to at least 2 witness monuments. (Witness monuments shall be made of concrete, natural stone, iron or other equally durable material.)

- (d) Show a plan view drawing depicting the relevant monuments and reference ties which is sufficient in detail to enable accurate relocation of the corner monument if the corner monument is disturbed. Indicate north.

1. 5/8" x 24" rebar with plastic cap "CEC - S-1767" set 6" below gravel surface.
2. 1" x 36" Aluminum monument Witness Corner stamped "WC"; West on line 33.00 feet.
3. Sugar 9" N64°E 30.16 feet.
4. Sugar 9" S65°E 36.37 feet.
5. Sugar 9" S40°W 56.05 feet.
6. Basswood 14" N29°W 37.70 feet.

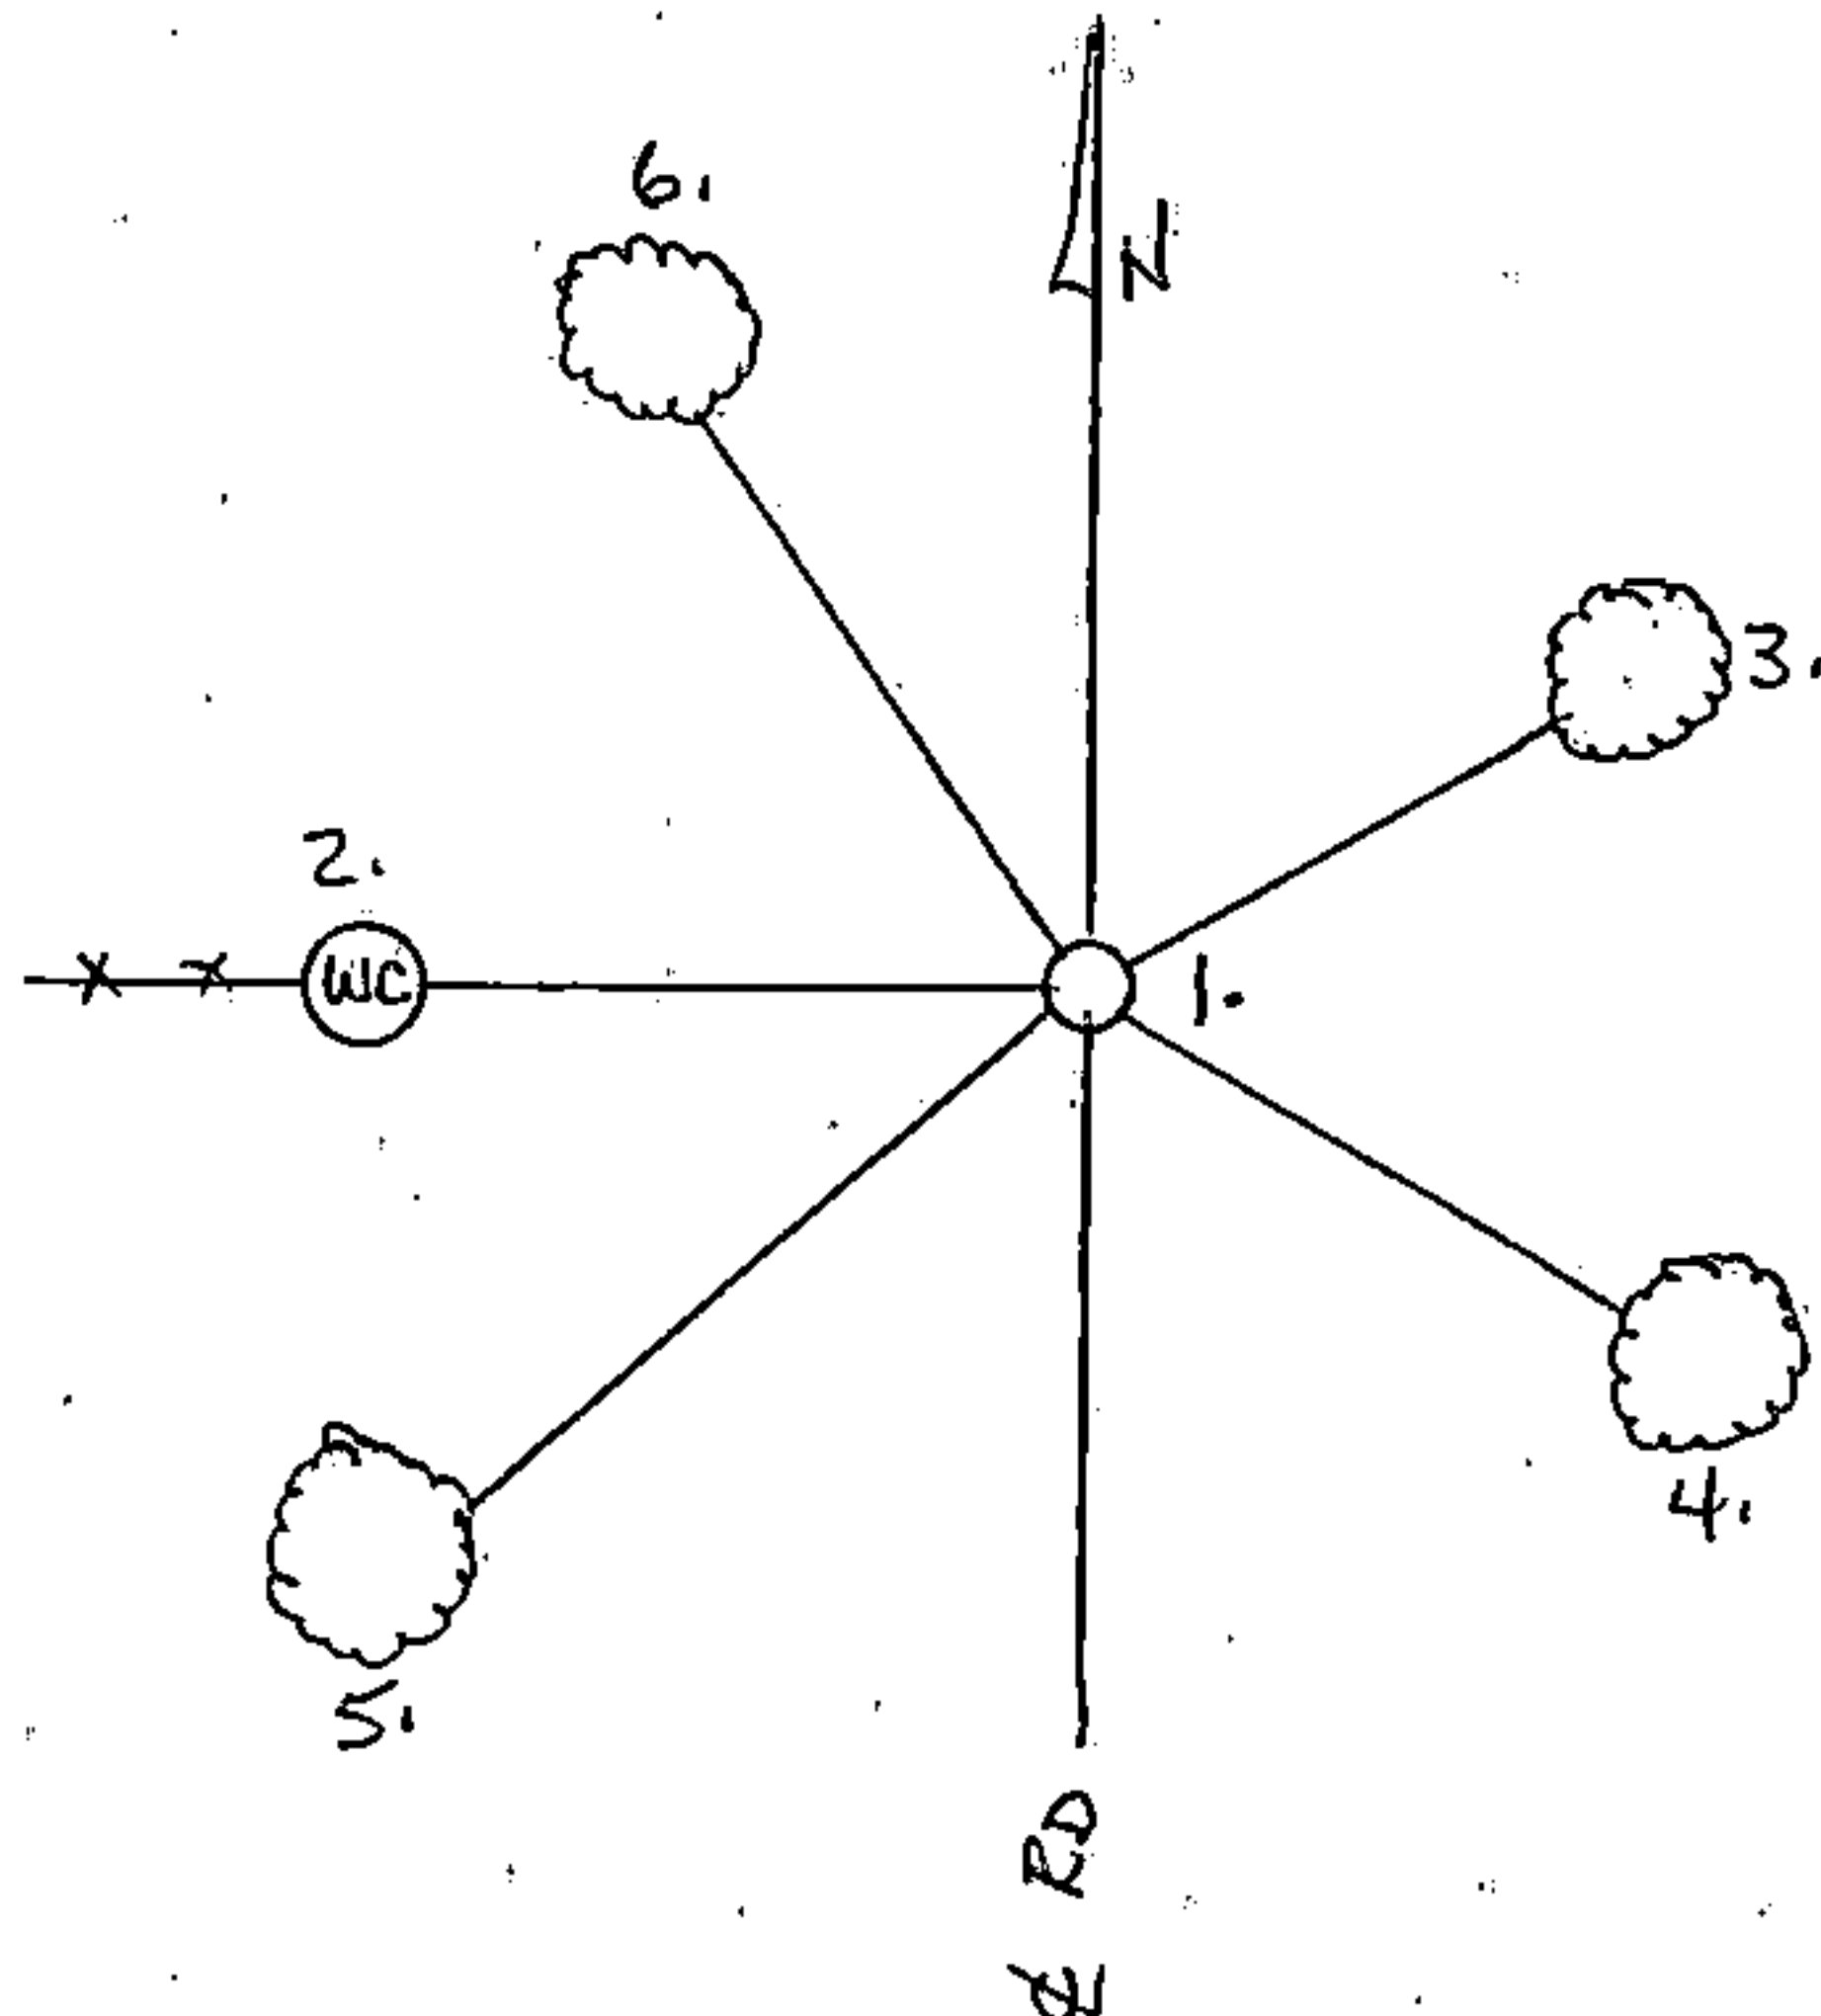

REGISTER'S OFFICE
 Forest County, Wis.

Received for record this 8th day
 of October, A.D., 1997 at
2:00 o'clock P.M. and recorded
 in Vol. Corner Restorations
 page C-21

Paul Achenbacher
 Register of Deeds

43616022000

C-21

(e) Describe any material discrepancy between the location of the corner as restored or reestablished and the location of that corner as previously restored or reestablished by distance and direction. Show the discrepancy on the plan view drawing under (d), above. Show the distances between the corner as previously restored or reestablished and (1) the corner as restored or reestablished, and (2) to at least 2 of the witness monuments shown on the drawing in (d), above.

Restored corner position is believed to be the most probable location of the true corner based on accepted evidence and past usage.

(f) Was the corner restored through acceptance of (1) an obliterated evidence location, or, (2) a found perpetuated location?

(1) Corner is believed to be obliterated, not lost, and was restored in accordance with observed evidence.

(g & h) Was the corner reestablished through lost corner proportionate methods? If so, show the method, including the directions and distances to other public land survey corners used as evidence or used for proportioning in determining the corner location?

No.

(1) 1. Charles F. Clark, RLS 1767
COLEMAN ENGINEERING COMPANY

(type or print name) certify that the corner location shown on this record was determined by me or under my direction and control and that this U.S. Public Land Survey Monument Record is correct and complete to the best of my knowledge and belief.

Charles F. Clark

Signature

August 23, 1991

Date

CERTIFICATE READY FOR FILING:

Darrell E. Richards
Acting District Ranger

