

CERTIFIED LAND CORNER RESTORATION

State of Wisconsin

County of Forest

ss.

I, Milo E. Stefan, do hereby certify that on the 13 day of December, 19179,
I found evidence of the East Quarter corner of Section 7
Township 36 North, Range 16 East, Fourth Principal Meridian, as described
hereon; and that from this evidence I established a new monument and accessories as described hereon to per-
petuate the original location of this corner:

Description of original monument and accessories and subsequent restorations:

Surveyed in 1858 by James McBride.
North between Sections 7 and 8.
40.00 chains set $\frac{1}{4}$ section post.
Tamarack 8", N20°E, 15 links.
Tamarack 8", S31°W, 11 links.

Description of corner evidence found:

5" X 5" wood post, scribed, with 1 $\frac{1}{2}$ " iron pipe along side, from which evidence
of original bearing trees were located. 10" scribed tamarack snag, N20°E, 15 links.
12" Tamarack stump with BT blaze S31°W, 11 links.

Description of monument and accessories I established to perpetuate the location of this corner:


Replaced wood post and iron pipe with a 2 inch inside diameter aluminum pipe
capped with a 3 $\frac{1}{2}$ " tablet stamped: T36N, R16E, $\frac{1}{4}$, S7, S8, 1979, S-1558.

Blazed and scribed the following new bearing trees:

Cedar, 11", S18°E, 32.20 feet
Cedar 9", S60°W, 29.70 feet
Yellow Birch, 11", N42°W, 12.10 feet
Set a steel sign post southwest of the monument 1.0 feet.

DOCUMENT NO.

119858

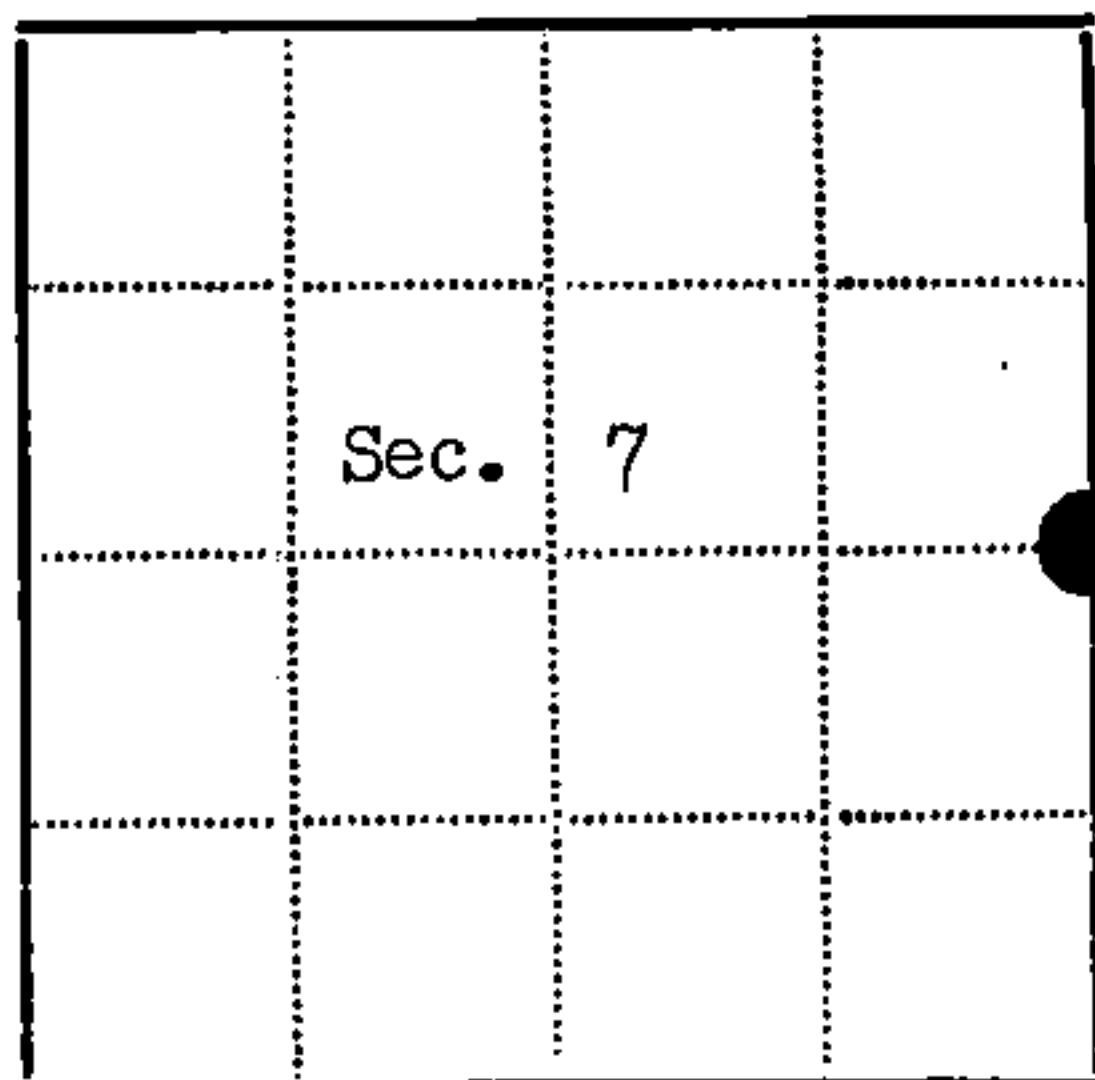

● - Corner monument restored

□ -

Resident witnesses.....

Dated at Laona Wisconsin, this 3 day of November
1980.

Signature Milo E. Stefan Title Land Surveyor
(County Surveyor, Registered Land Surveyor, or other duly authorized official)

Surveyors Registration No. S-1558Office of Register of Deeds County of Forest

I hereby certify that the within instrument was filed in this office for record
on the 2nd day of June, 1981, and was filed in Book
No. Page No. of County Records.

Signature Eugene Statyn Title Register of Deeds

Township 36N, Range 16E, Section 7, Index No. G-5, Page No.

43616072000