

CERTIFIED LAND CORNER RESTORATION

State of Wisconsin }
County of Forest } ss.

I Milo E. Stefan, do hereby certify that on the 10th day of September, 1981, I found evidence of the Northwest corner of Section 14, Township 36 North, Range 16 East, Fourth Principal Meridian, as described hereon; and that from this evidence I established a new monument and accessories as described hereon to perpetuate the original location of this corner:

Description of original monument and accessories and subsequent restorations:

Surveyed in 1858 by James McBride
80.00 chains, set wood post
Sugar, 10", N40W, 24 lks.
Sugar, 10", N28E, 31 lks.
Sugar, 12", S62E, 29 lks.
Sugar, 10", S30W, 39 lks.

Surveyed in 1927 by Goodman Lumber Co.
From NW BT, set flue pipe 34" long alongside
3" Elm post.

Description of corner evidence found:

Found 34" flue pipe.
Found very rotten Sugar Maple stump. Remains N40W, 16', as called by Goodman.

Description of monument and accessories I established to perpetuate the location of this corner:

Replaced flue pipe with a 2" x 30" aluminum pipe in a mound of stone with tablet stamped as follows:


T36N, R16E, S10, S11, S15, S14, 1981, RLS-1558

From which the following bear:

Sugar, 5", N40E, 2.45 feet
Sugar, 4", S48E, 16.51 feet
Sugar, 5", S8W, 22.56 feet
Sugar, 5", N55W, 10.45 feet
Set a steel sign post SW, 3.6 feet

DOCUMENT NO.
124222

43616100000

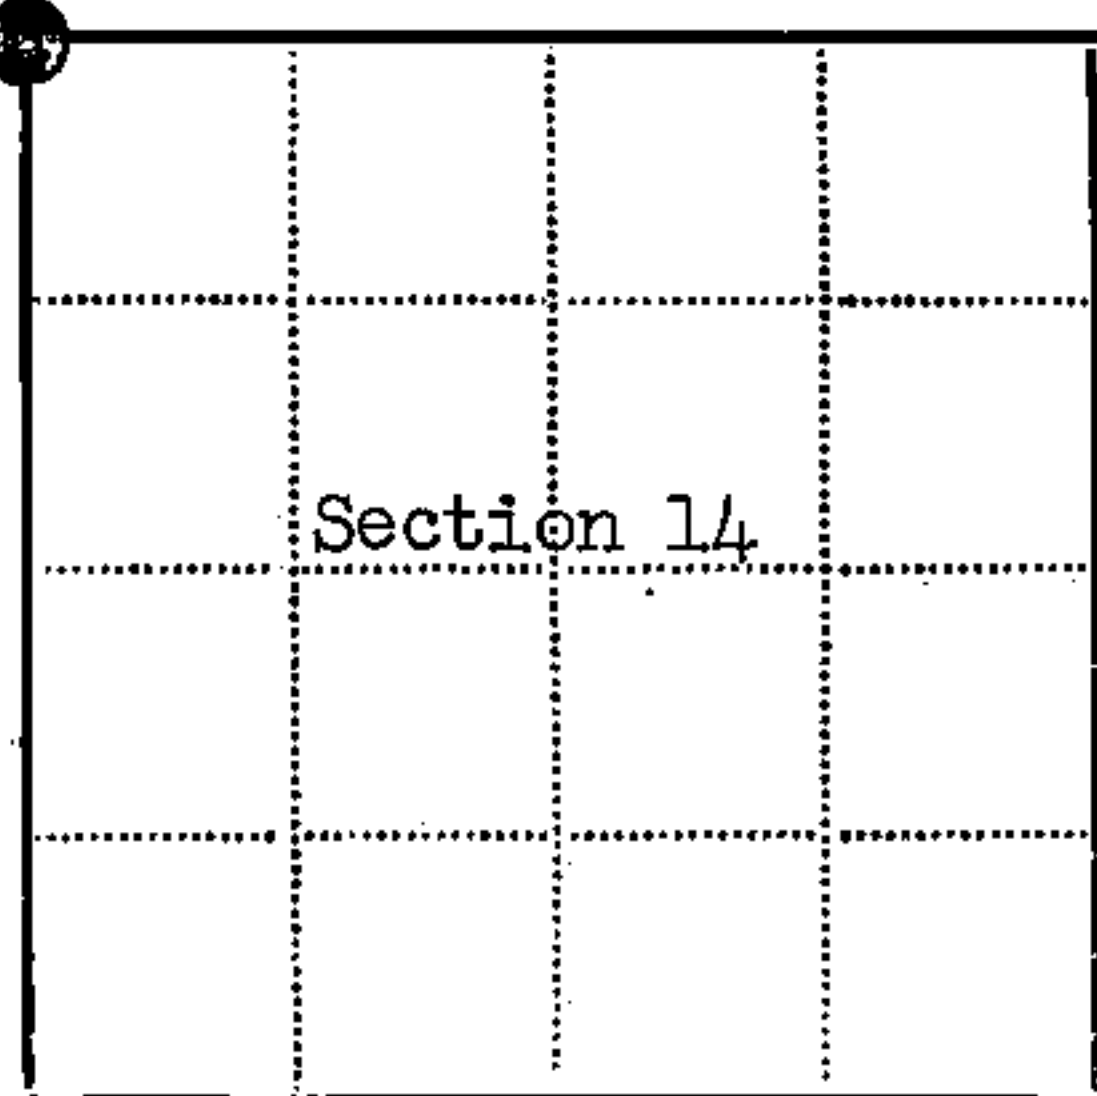

● - Corner monument restored
□ -

Resident witnesses.....

Dated at Rhinelander Wisconsin, this 14th day of September, 1982.

Signature Milo E. Stefan Title Land Surveyor
(County Surveyor, Registered Land Surveyor, or other duly authorized official)

Surveyors Registration No. RLS-1558

Office of Register of Deeds County of Forest

I hereby certify that the within instrument was filed in this office for record on the 14th day of September, 1983, and was filed in Book No. Page No. of County Records.

Signature Eugene Stacey Title Register of Deeds

Township 36 North, Range 16 East, Section 14, Index No. J-17, Page No. 77

77