

CERTIFIED LAND CORNER RESTORATION

State of Wisconsin }  
County of Forest } ss.

I, Milo E. Stefan, do hereby certify that on the 18th day of November, 1981, I found evidence of the West  $\frac{1}{4}$  corner of Section 11 Township 36 North, Range 16 East, Fourth Principal Meridian, as described hereon; and that from this evidence I established a new monument and accessories as described hereon to perpetuate the original location of this corner:

Description of original monument and accessories and subsequent restorations:

Surveyed in 1858 by James McBride  
40.00 chains, set  $\frac{1}{4}$  section wood post  
Elm, 12", S56E, 14 lks., 9.24 feet  
Birch, 16", S66W, 20 lks., 13.2 feet

Surveyed in 1927 by Goodman Lumber Co.  
Found 3" Hardwood post and 14" Elm stump,  
S56E, 14 lks., set 3" Hemlock post and  
25" flue pipe.


Description of corner evidence found:

Found flue pipe.  
Found stump hole, S66W, 13.2 feet and possible stump hole, S56E, 9.24 feet.

Description of monument and accessories I established to perpetuate the location of this corner:

We replaced flue pipe with a 36" aluminum monument with tablet stamped as follows:  
T36N, R16E, S10,  $\frac{1}{4}$ , S11, 1981, RLS-1558  
From which the following bear:  
Rock Elm, 6", S61E, 13.45 feet  
W. Spruce, 8", S14E, 104.18 feet  
W. Spruce, 10", N17W, 112.86 feet  
Steel sign post with mound of stone around monument, N70E, 1.4 ft.

DOCUMENT NO.  
**124219**

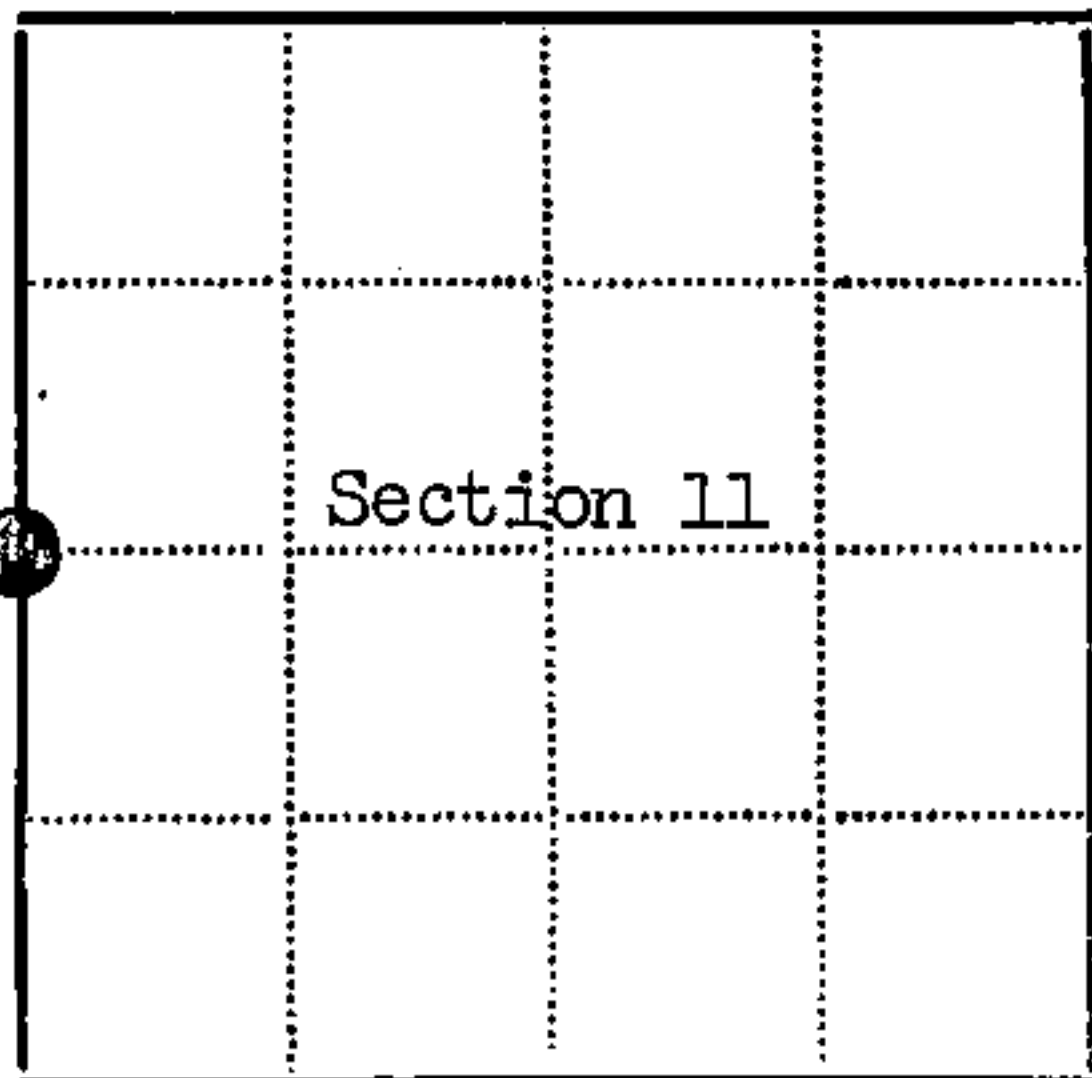

● - Corner monument restored  
□ -

Resident witnesses.....

Dated at Rhinelander Wisconsin, this 2 day of MAY 1982.

Signature Milo E. Stefan Title Land Surveyor  
(County Surveyor, Registered Land Surveyor, or other duly authorized official)

Surveyors Registration No. RLS-1558

Office of Register of Deeds County of Forest

I hereby certify that the within instrument was filed in this office for record on the 14th day of September 1983, and was filed in Book No. Page No. of County Records.

Signature Eugene J. Staszewski Title Register of Deeds

Township 36 North, Range 16 East, Section 11, Index No. G-17, Page No. 78

43616102000

G  
17