

142947

U. S. PUBLIC LAND SURVEY MONUMENT RECORD


INSTRUCTIONS : This record shall show the location of the corner and shall include all of the following nine elements (a through i).

- (a) Identify the corner by reference to the U.S. public land survey system.
- = Corner monument restored.

Quarter Corner Common to Sections 12 and 13, T36N-R16E

Index Number J-23 (T36N-R16E)

Forest County, Wisconsin

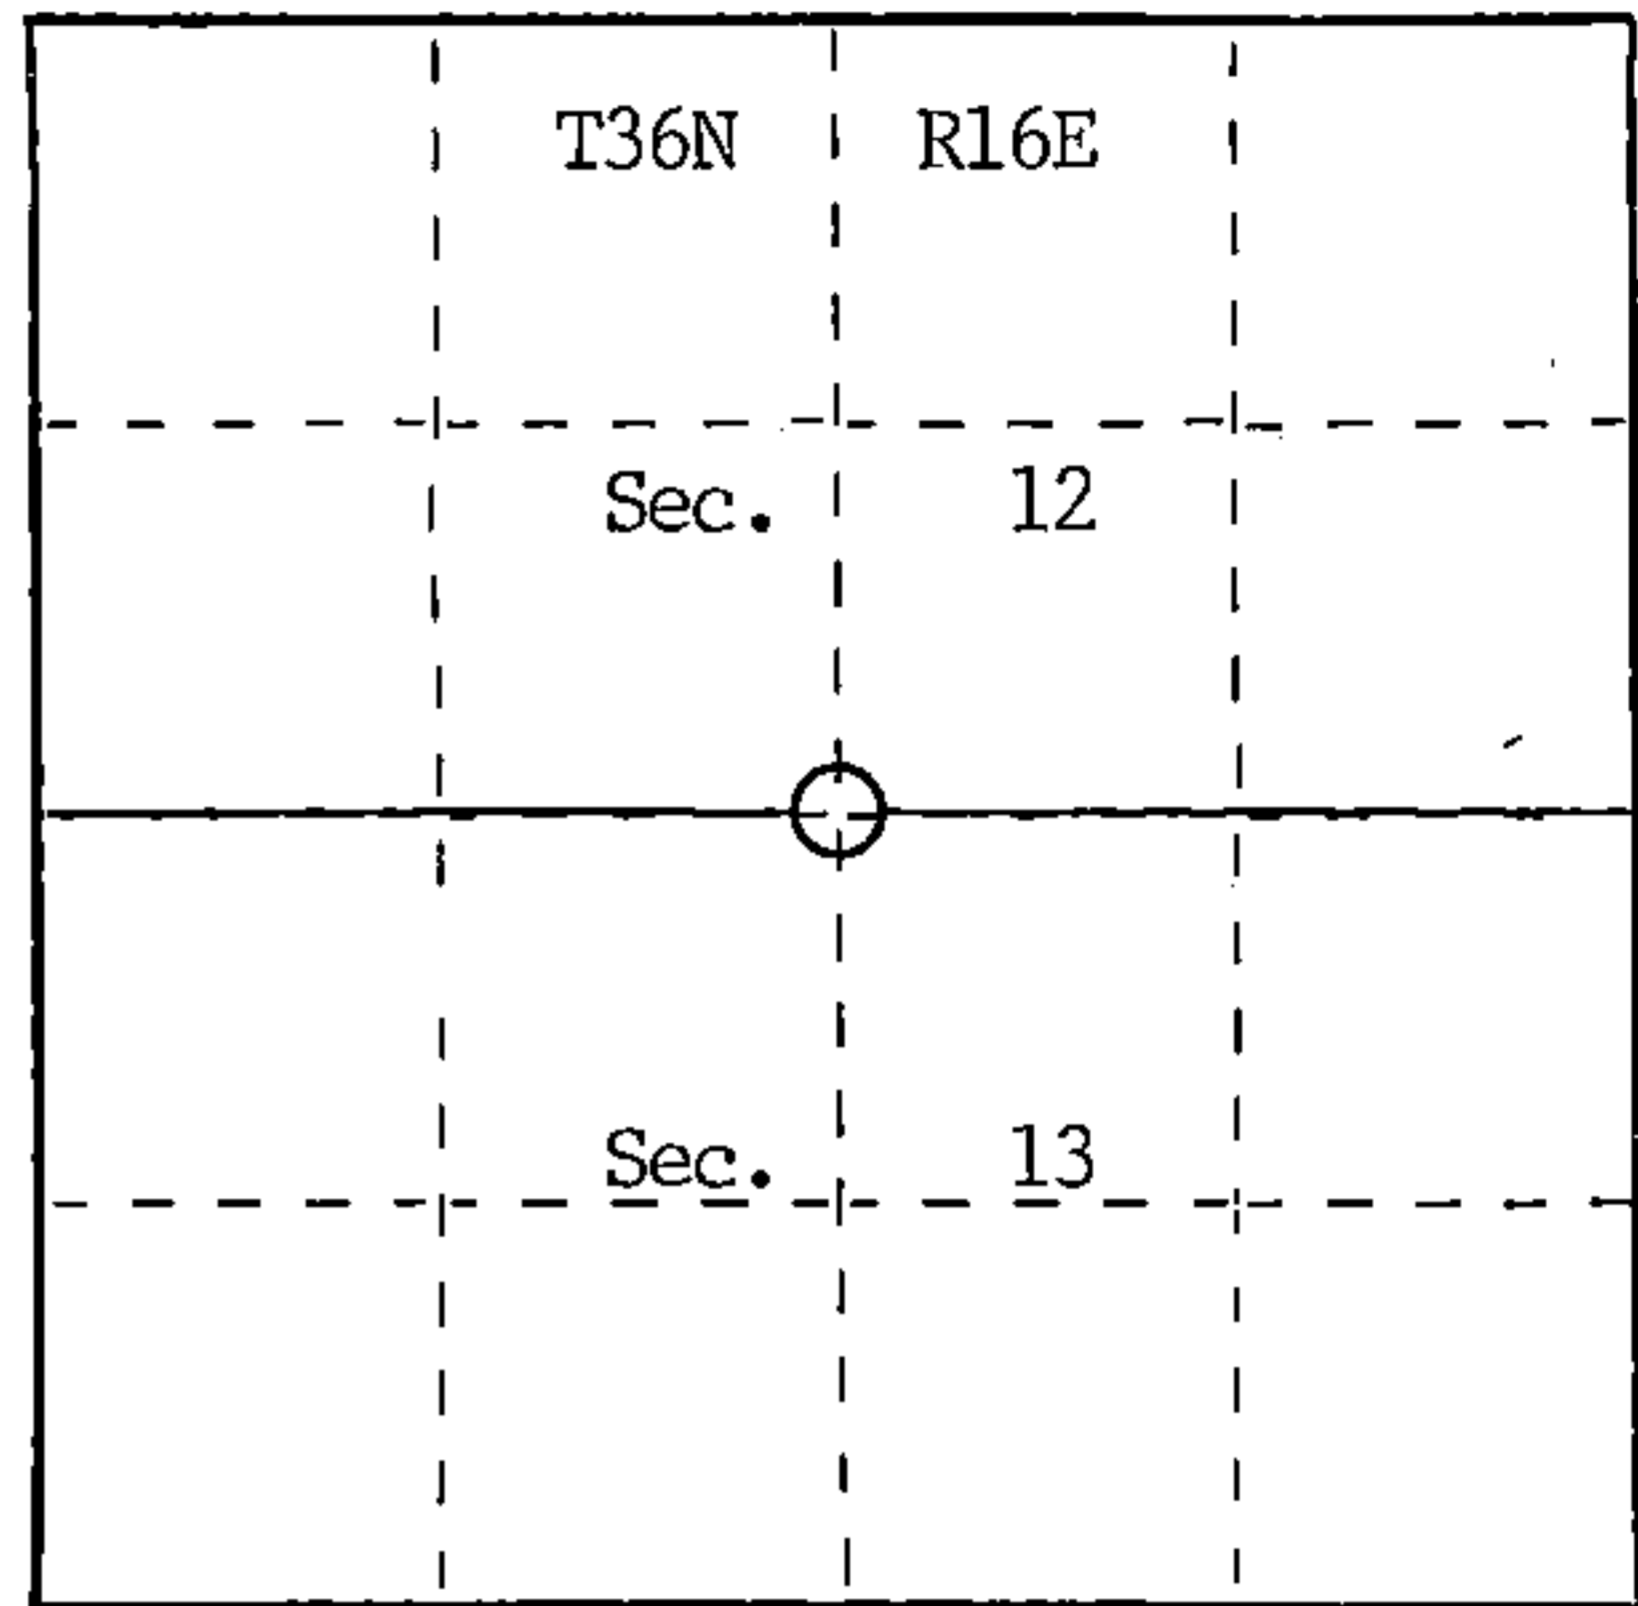


- (b) Describe any record evidence, monument evidence, occupational evidence, testimonial evidence or any other material evidence you considered, and whether the monument was found or placed.

- 1858 - Original post set by James McBride, witnessed by 12 Fir N42E 20 lks.; 12 Fir S45E 13 lks.
- 1917 - Records of Goodman Lumber Co. indicate corner restored with 5" cedar post by J. Jenkins; no record of original evidence recovered or NBTs marked. Goodman further restored this corner in 1927 with a flue pipe in a pile of stones.
- 1982 - Pipe was recovered by M. Stefan, S-1558, per Forest Service records. Corner was restored with 2" x 36" aluminum monument witnessed by: W.Spruce 12" S79°E 41.03'; W.Spruce 10" S09°E 64.30'; W.Spruce 18" S85°W 68.19'; Steel sign post East 1.4'.
- 1991 - Coleman Engineering Company recovered aluminum monument and references by March M. Stefan and marked one additional NBT

- (c) In the plan view drawing below, provide reference ties to at least 4 witness monuments, or, if the location is within a municipality, to at least 2 witness monuments. (Witness monuments shall be made of concrete, natural stone, iron or other equally durable material.) Describe witness monuments.

- (d) Show a plan view drawing depicting the relevant monuments and reference ties which is sufficient in detail to enable accurate relocation of the corner monument if the corner monument is disturbed. Indicate north.

1. 2" x 36" Aluminum monument with position stamped on cap.
2. W. Spruce 12" S79°E 41.03 feet.
3. W. Spruce 10" S09°E 64.30 feet.
4. W. Spruce 18" S85°W 68.19 feet.
5. Aspen 8" N50°E 10.77 feet.
6. Steel sign post East 1.4 feet.

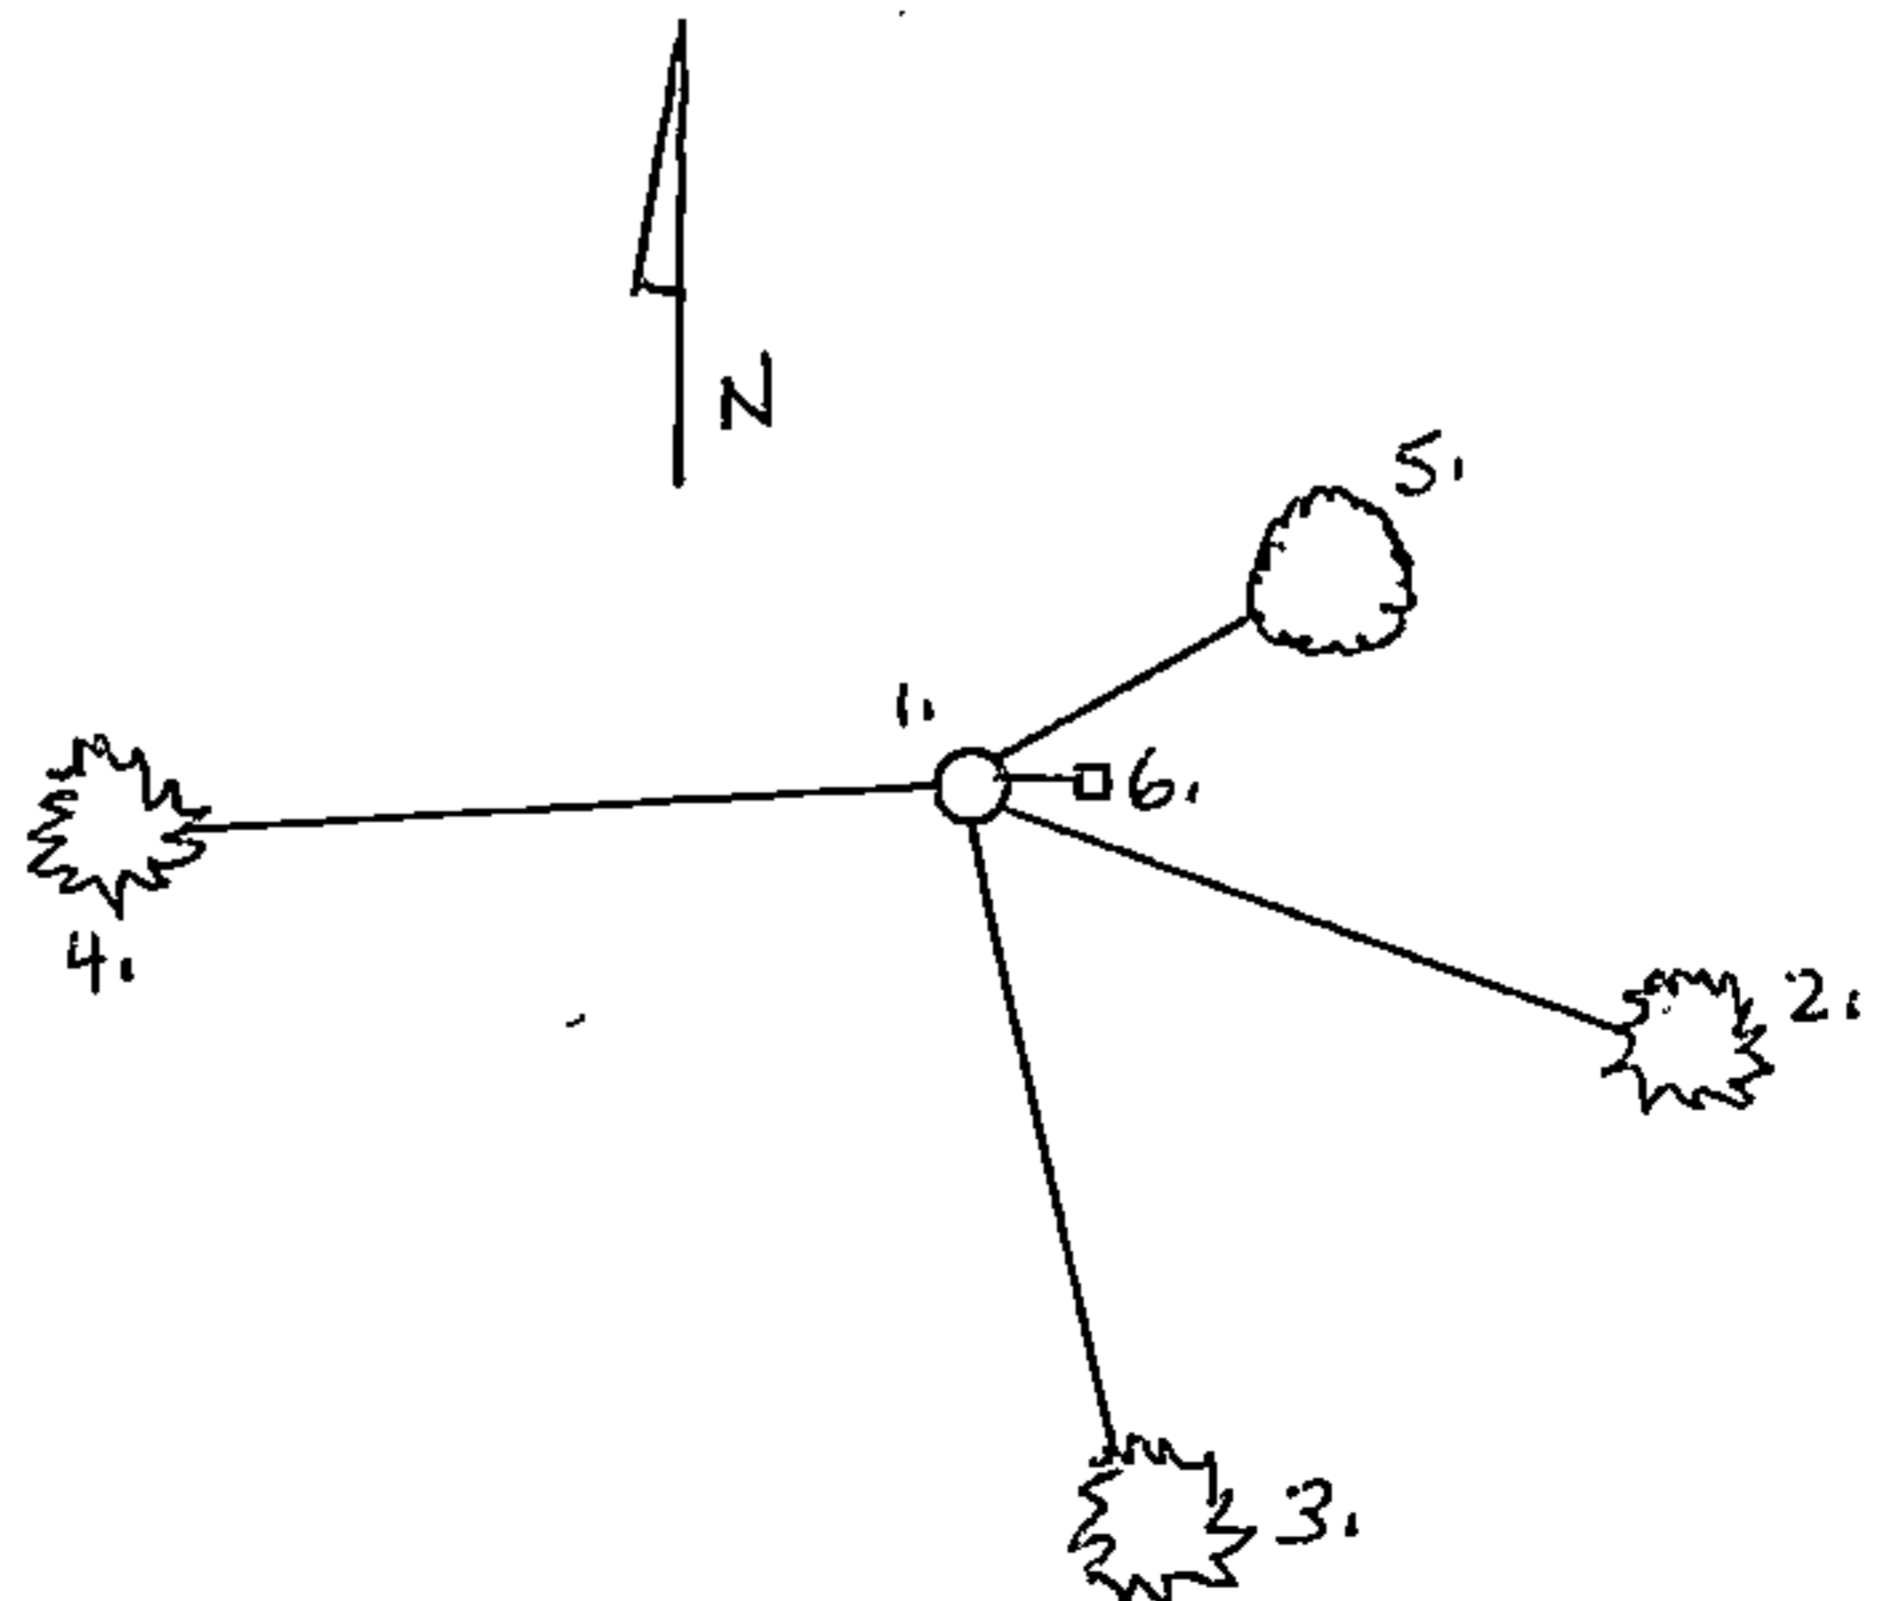

REGISTER'S OFFICE }
Forest County, Wis. }

Received for record this 8th day
of October A.D., 1991 at
2:00 o'clock P.M. and recorded
in Vol. Case Restorations
page J-23

Paul Spickard
Register of Deeds

43616120020

- (e) Describe any material discrepancy between the location of the corner as restored or reestablished and the location of that corner as previously restored or reestablished by distance and direction. Show the discrepancy on the plan view drawing under (d), above. Show the distances between the corner as previously restored or reestablished and (1) the corner as restored or reestablished; and (2) to at least 2 of the witness monuments shown on the drawing in (d), above.

Accepted recovered monument as true corner position.

- (f) Was the corner restored through acceptance of (1) an obliterated evidence location, or, (2) a found perpetuated location?

(2) Found perpetuated location.

- (g&h) Was the corner reestablished through lost corner proportionate methods? If so, show the method, including the directions and distances to other public land survey corners used as evidence or used for proportioning in determining the corner location?

No.

- (i) I, Charles F. Clark, RLS 1767
COLEMAN ENGINEERING COMPANY
(type or print name) certify that the corner location shown on this record was determined by me or under my direction and control and that this U.S. Public Land Survey Monument Record is correct and complete to the best of my knowledge and belief.

Signature

Charles F. Clark

Date

August 22, 1991

CERTIFICATE READY FOR FILING:

Darrell E. Richards
Acting District Ranger

Affix Land Surveyor Seal

