

CERTIFIED LAND CORNER RESTORATION

State of Wisconsin }  
County of Forest } ss.

I Milo E. Stefan, do hereby certify that on the 22nd day of September, 1982, I found evidence of the Northwest corner of Section 21 Township 36N, Range 16E, Fourth Principal Meridian, as described hereon; and that from this evidence I established a new monument and accessories as described hereon to perpetuate the original location of this corner:

Description of original monument and accessories and subsequent restorations:

Surveyed in 1858 by James McBride  
80.00, set wood post  
Fir, 12", N76°E, 112 lks., 73.92'  
Tamarack, 6", S9°E, 26 lks., 17.16'  
Fir, 10", S84°W, 76 lks., 50.16'  
Tamarack, 6", N34°W, 36 lks., 23.76'

Description of corner evidence found:

Stump hole, N76°E, 74'  
Tamarack roots, S9°E, 17'  
Stump hole, S84°W, 50'  
Tamarack stump, 6"-8", N34°W, 23.8'  
Local Evidence: 8" x 8" x 5' Cedar post with another rotted off post alongside  
Blazed line, north, east, and west.


Description of monument and accessories I established to perpetuate the location of this corner:

Replaced post with a 2" x 60" aluminum monument with tablet stamped as follows:  
T36N, R16E, S17, S16, S20, S21, 1982, RLS-1558  
From which the following bear:  
Yellow Birch, 8", N78°E, 77.89'  
Hemlock, 18", S58°E, 49.46'  
Red Maple, 10", S74°W, 48.47'  
Hemlock, 18", N51°W, 76.35'  
Steel Sign Post, East, 2.0'

DOCUMENT NO.  
124224



43616170000

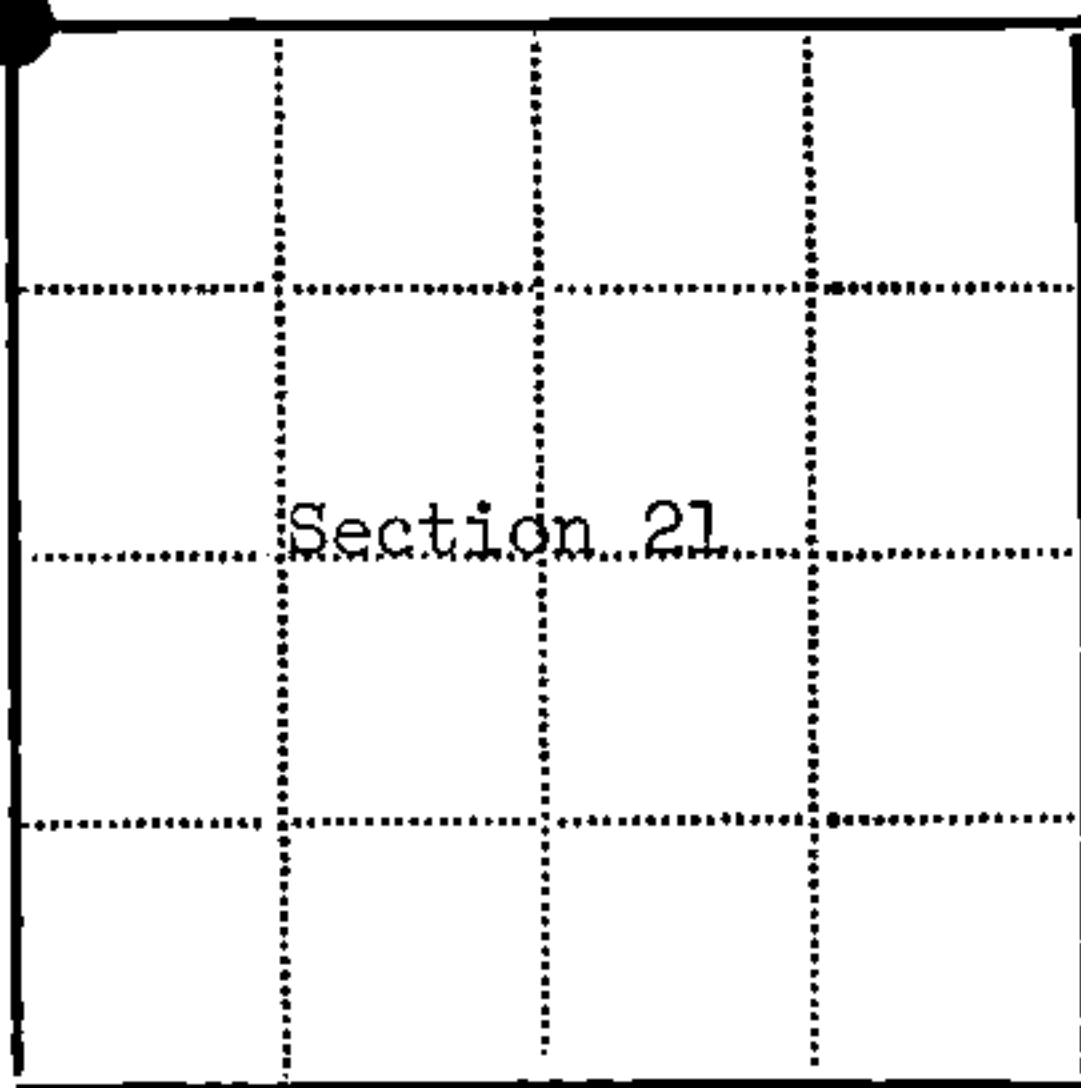

● - Corner monument restored  
□ -

Resident witnesses.....

Dated at Rhinelander Wisconsin, this 2 day of MAY 1982

Signature Milo E. Stefan Title Land Surveyor  
(County Surveyor, Registered Land Surveyor, or other duly authorized official)

Surveyors Registration No. RLS-1558

Office of Register of Deeds County of Forest

I hereby certify that the within instrument was filed in this office for record on the 14th day of September 1983, and was filed in Book No. Page No. of County Records.

Signature Register of Deeds Title Register of Deeds

Township 36 North, Range 16 East, Section 21, Index No. N-9, Page No. 9

N  
9