

DOCUMENT NUMBER

139377


U. S. PUBLIC LAND SURVEY MONUMENT RECORD.

INSTRUCTIONS: This record shall show the location of the corner and shall include all of the following nine elements (a through i).

(a) Identify the corner by reference to the U.S. public land survey system.

● = Corner monument restored.

Section Corner to Sections 17-18-19-20, T.36N., R.16E., Forest County, Wisconsin.

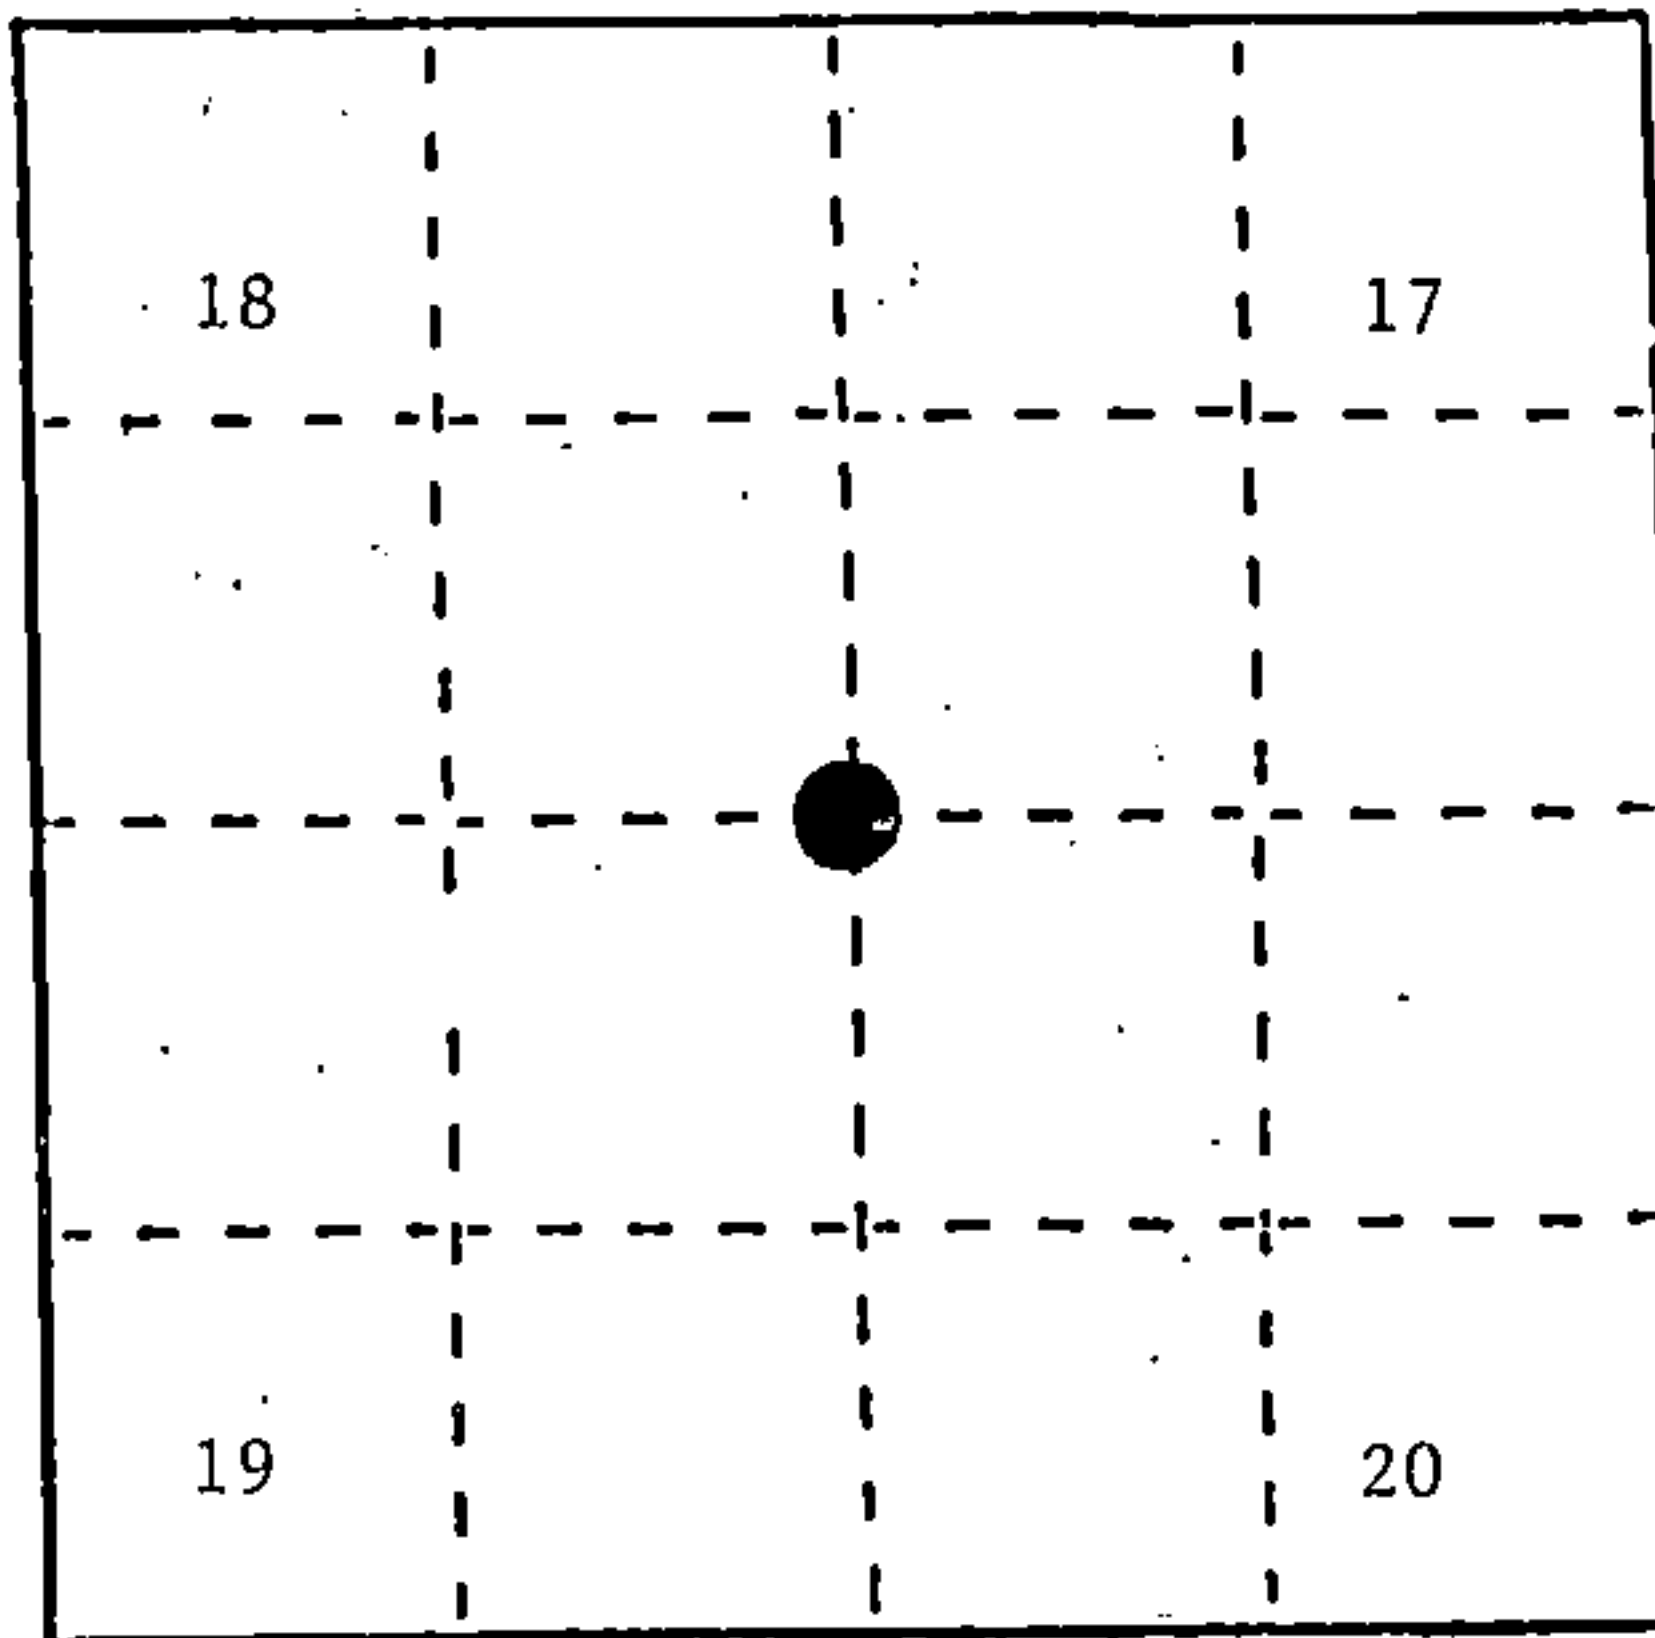

(b) Describe any record evidence, monument evidence, occupational evidence, testimonial evidence or any other material evidence you considered, and whether the monument was found or placed.

In 1858 James McBride set a wood post with the following B.T.'s:

Elm	24"	N.21°W.	33 links	(21.78 feet)
Birch	8"	N.65°E.	39 links	(25.74 feet)
Linden	10"	S.35°E.	33 links	(21.78 feet)
Sugar	14"	S.21°W.	8 links	(5.28 feet)

In 1917 J. Melendy found original B.T.'s with the elm being a stump. Set a 4" x 4" elm post and made the following B.T.'s:


Maple	12"	S.42½°W.	32 links	(21.12 feet)
Elm	14"	S.34½°W.	49½ links	(32.505 feet)
Elm	16"	N.29½°W.	56 3/4 links	(37.455 feet)

In 1988 Alan Harrison found original basswood evidence and Melandy's SE elm as a decayed stump, ±300 feet south found a 30" hemlock with overgrowth from blazes. The point at record direction and distance from the found bearing trees is accepted as the best available evidence of the corner location.

(c) In the plan view drawing below, provide reference ties to at least 4 witness monuments, or, if the location is within a municipality, to at least 2 witness monuments. (Witness monuments shall be made of concrete, natural stone, iron or other equally durable material.) Describe witness monuments.

(d) Show a plan view drawing depicting the relevant monuments and reference ties which is sufficient in detail to enable accurate relocation of the corner monument if the corner monument is disturbed. Indicate north.

- 2½" x 36½ aluminum monument with tablet stamped to identify the corner.
- Basswood, 10"; N.89°E., 39.59 feet.
- Sugar, 12", S.20°E., 41.60 feet.
- Sugar, 10", S.72°W., 68.51 feet.
- Sugar, 9", N.44°W., 93.49 feet.
- Steel Sign Post, East, 0.79 feet.

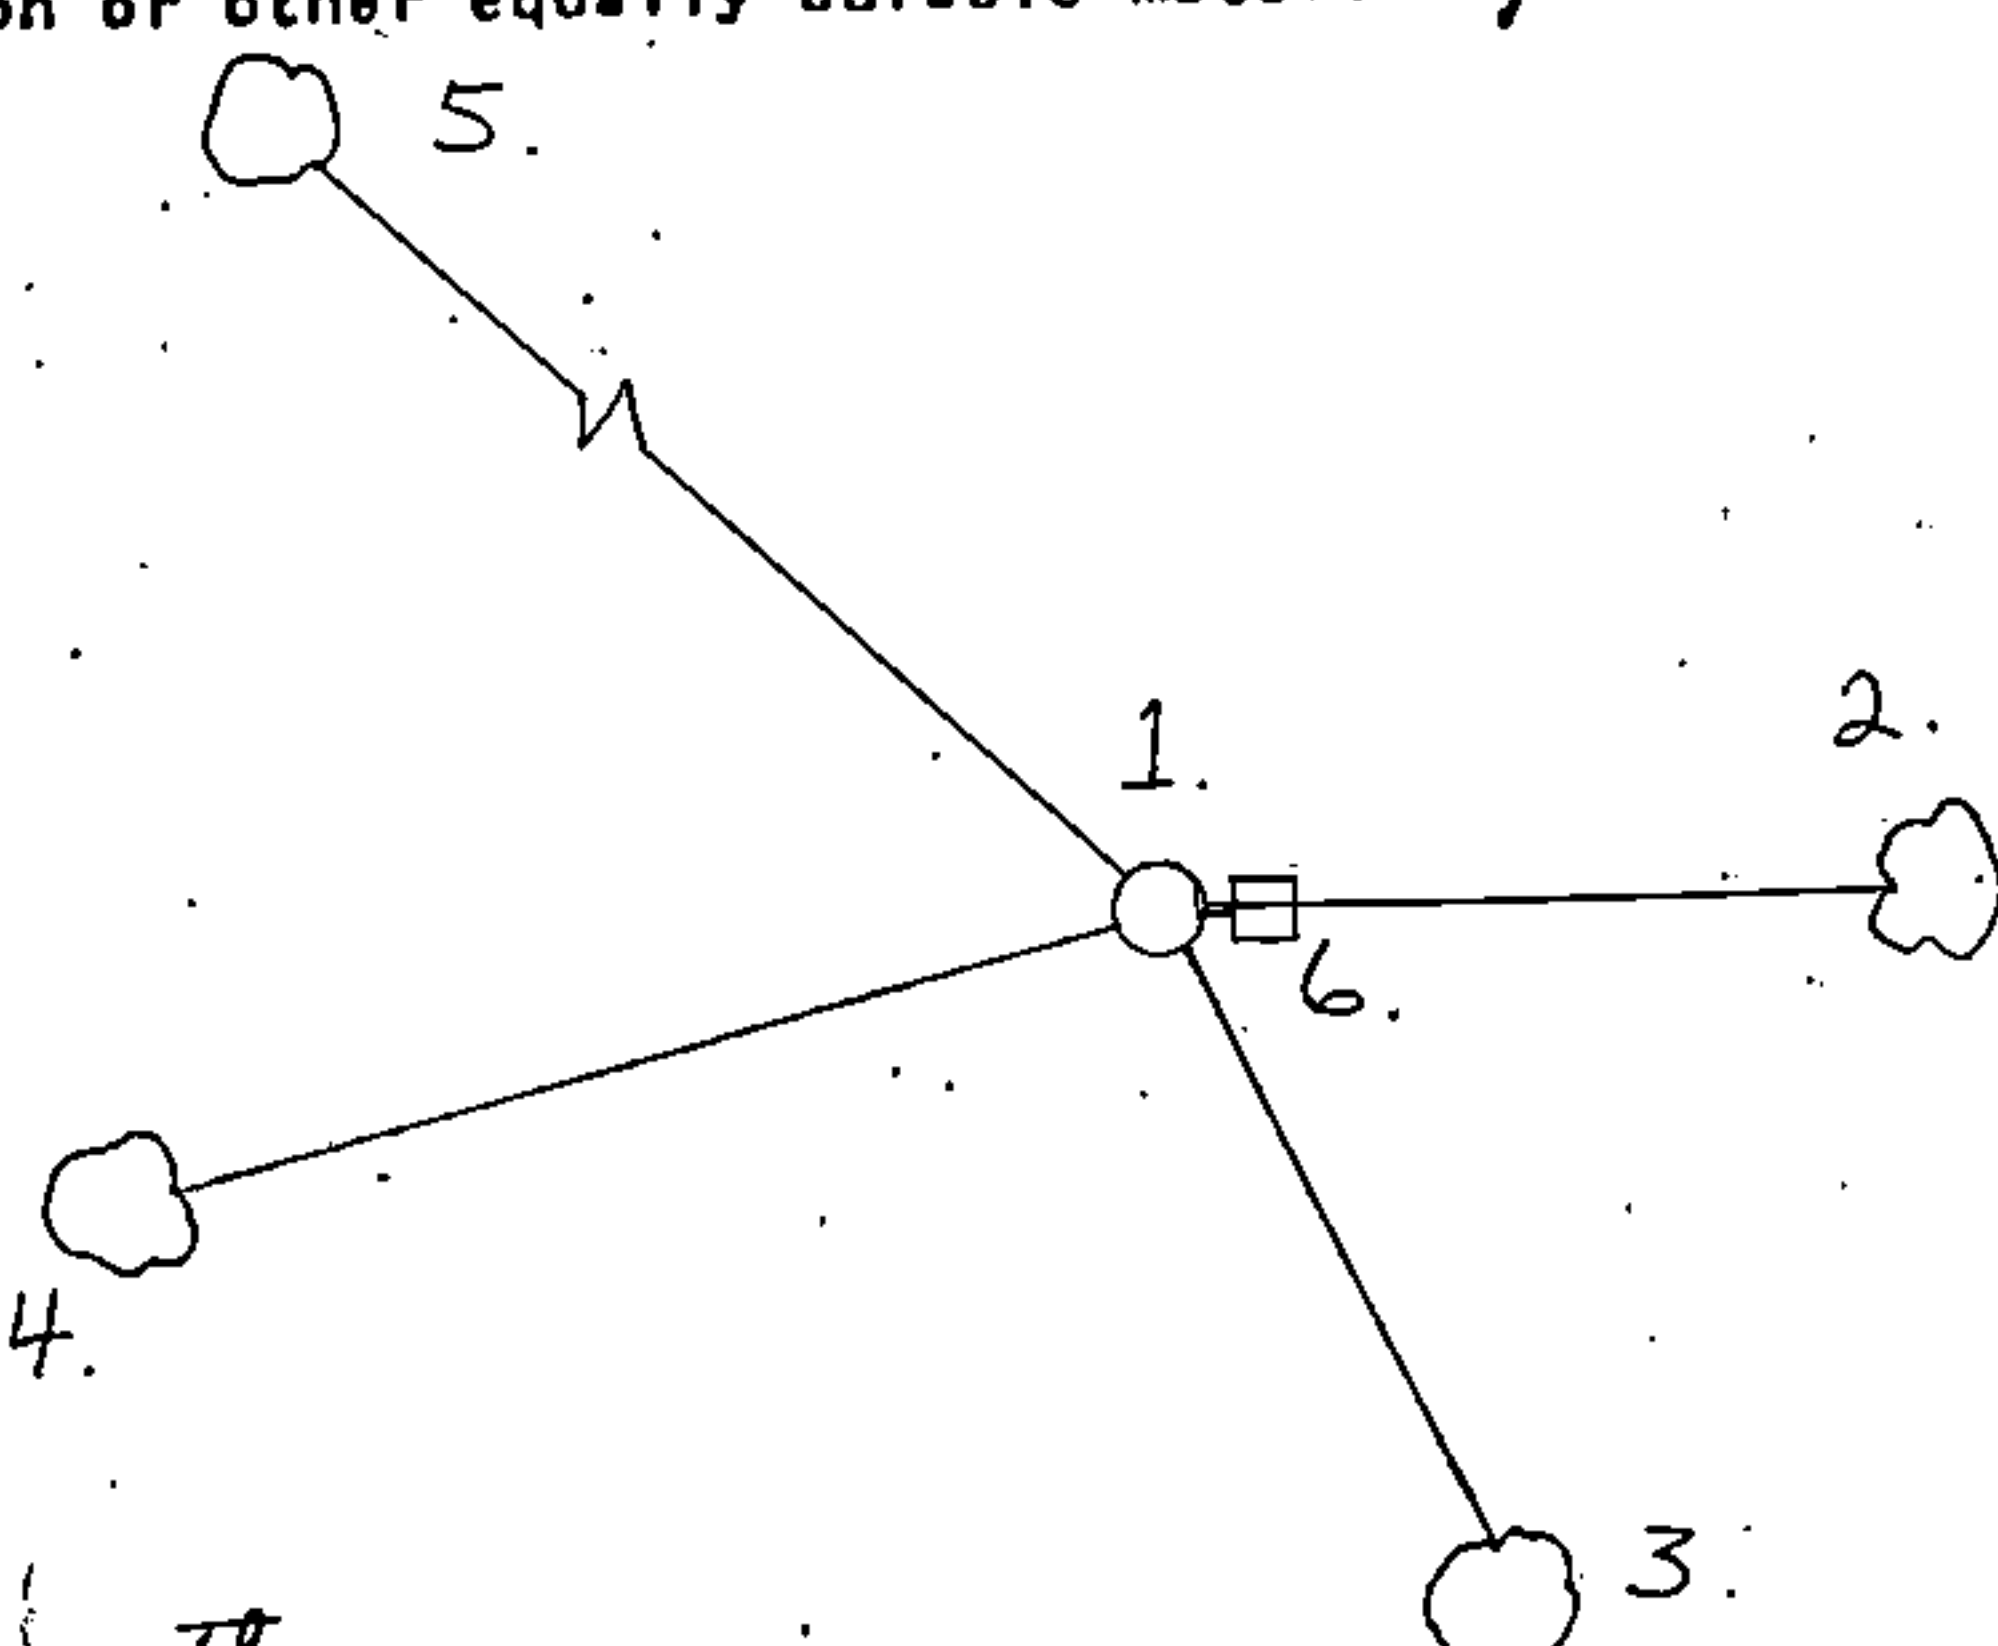

REGISTER'S OFFICE
Forest County, Wis.

Received for record this 29th day of March A.D., 1990 at 10:00 o'clock A.M. and recorded in Vol. CORNER RESTORATIONS page N-5

Paul A. Schenck
Register of Deeds

43616180000

(e) Describe any material discrepancy between the location of the corner as restored or reestablished and the location of that corner as previously restored or reestablished by distance and direction. Show the discrepancy on the plan view drawing under (d), above. Show the distances between the corner as previously restored or reestablished and (1) the corner as restored or reestablished, and (2) to at least 2 of the witness monuments shown on the drawing in (d), above.

None.

(f) Was the corner restored through acceptance of (1) an obliterated evidence location, or, (2) a found perpetuated location?


(2) a found perpetuated location

(g&h) Was the corner reestablished through lost corner proportionate methods? If so, show the method, including the directions and distances to other public land survey corners used as evidence or used for proportioning in determining the corner location?

No.

(i) I, Alan D. Harrison
(Type or print name) certify that the corner location shown on this record was determined by me or under my direction and control and that this U.S. Public Land Survey Monument Record is correct and complete to the best of my knowledge and belief.

Alan D. Harrison 3/1/90
Signature Date

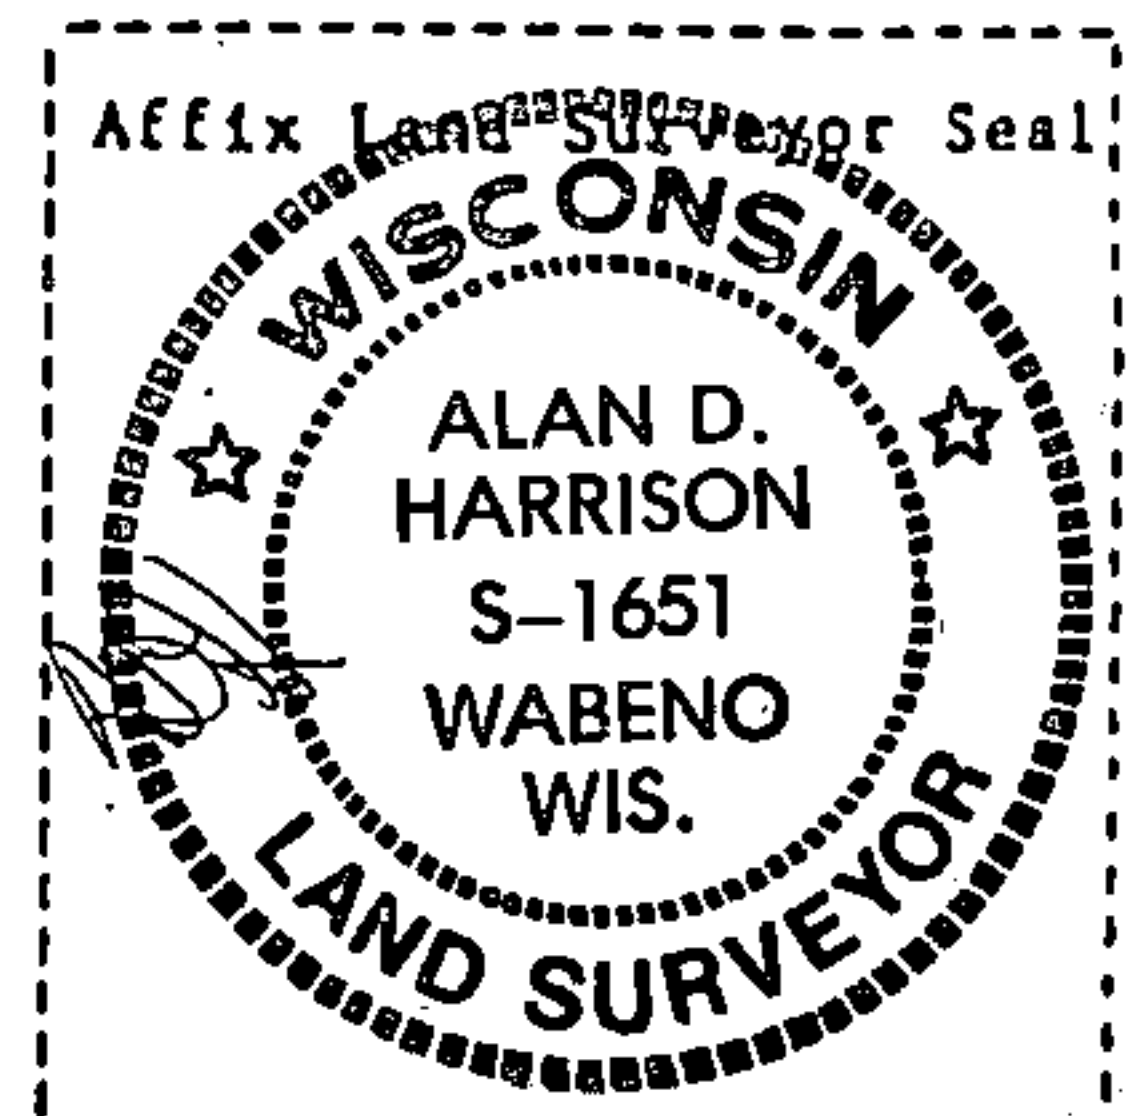

CERTIFICATE READY FOR FILING:

Paul B. Staeger
District Ranger