

CERTIFIED LAND CORNER RESTORATION

State of Wisconsin }
County of Forest } ss.

I, Jean F. Resvick, do hereby certify that on the 11 day of March, 1976, I found evidence of the East quarter corner of Section 18 Township 36 North Range 16 East, Fourth Principal Meridian, as described hereon; and that from this evidence I established a new monument and accessories as described hereon to perpetuate the original location of this corner:

Description of original monument and accessories and subsequent restorations:

Surveyed by James McBride in 1858
40 chains north between Sections 17 and 18
Set post
Tamarack 6, N73E, 69 lks.
Tamarack 6, S50W, 36 lks.

Description of corner evidence found:


6x6 scribed Tamarack post 7 ft. long
Tamarack snag 6" when scribed, S40W, 36 lks., scribing visible.
Tamarack stump, N73E, 69 lks. Scribe over growth of bearing tree.

Description of monument and accessories I established to perpetuate the location of this corner:

Set 2 inch inside diameter, galvanized iron pipe 5 ft. long
filled with concrete with brass cap stamped:
T36N, R16E, 1/4, S18, S17, 1976, S-802


Blazed and scribed the following new bearing trees
Tamarack 3, N88E, 9.77 feet
Black Spruce 4, S14E, 9.97 feet
Tamarack 4, N16W, 23.64 feet

43616182000

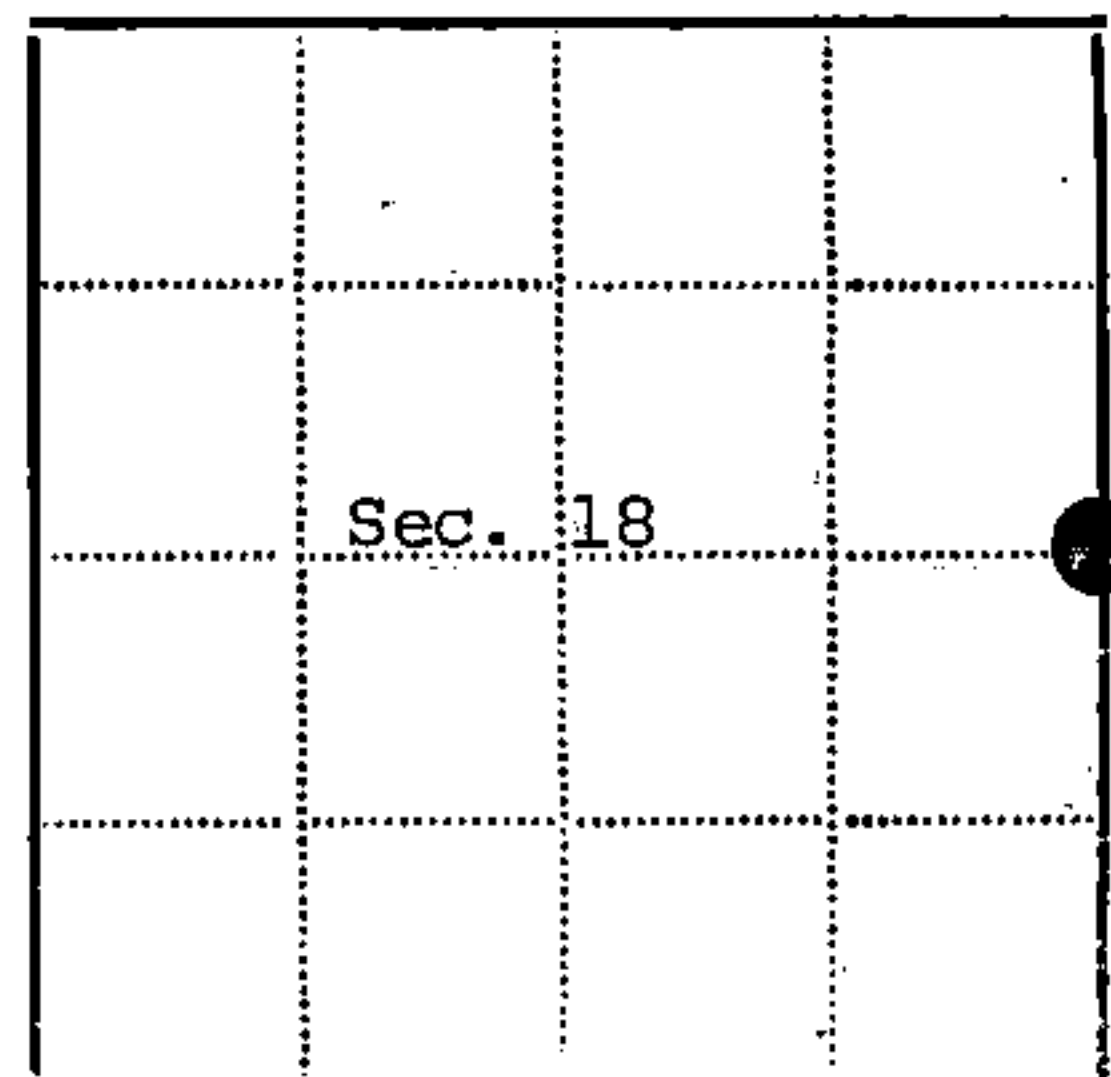

● - Corner monument restored
□ -

Resident witnesses _____
Dated at Rhinelander Wisconsin this 24 day of March 1976.
Signature Jean F. Resvick Title Land Surveyor
(County Surveyor, Registered Land Surveyor, or other duly authorized official)
Surveyors Registration No. S-802 DOCUMENT NUMBER 109587

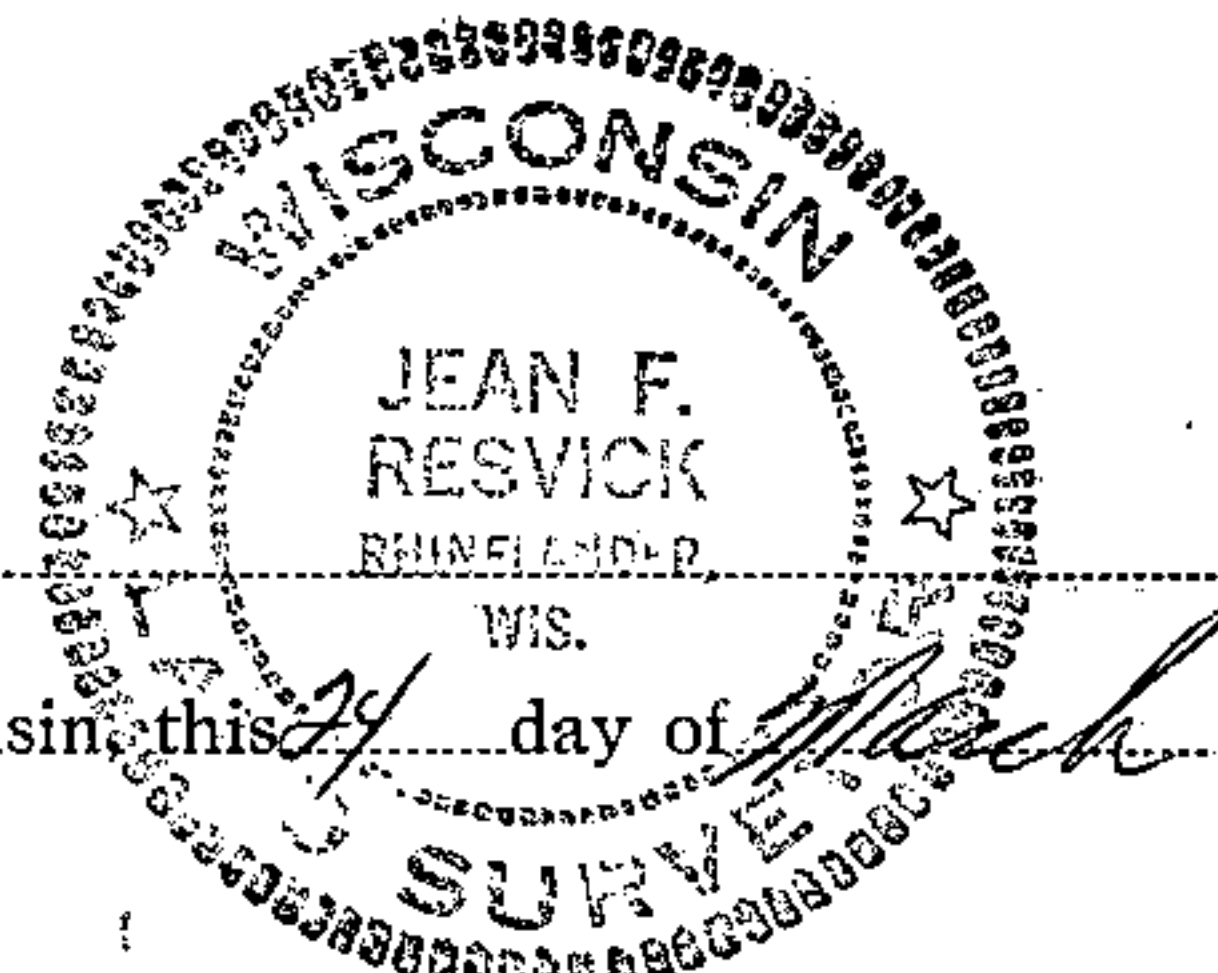

Office of Register of Deeds County of Forest
I hereby certify that the within instrument was filed in this office for record on the 2nd day of July 1976, and was filed in Book No. _____ Page No. _____ of County Records.

Signature Eugene Staszynski Title Register of Deeds

Township 36 North, Range 16 East, Section 18, Index No. L-5, Page No. _____

59