

CERTIFIED LAND CORNER RESTORATION

State of Wisconsin }
County of Forest } ss.

I, Milo E. Stefan, do hereby certify that on the 22 day of October, 1980, I found evidence of the Southwest corner of Section 20 Township 36 North, Range 16 East, Fourth Principal Meridian, as described hereon; and that from this evidence I established a new monument and accessories as described hereon to perpetuate the original location of this corner:

Description of original monument and accessories and subsequent restorations:

Surveyed by James McBride in July 1858.
Set Wood Post.
Fir, 6", N37°W, 14 links
Cedar, 12", N80°W, 49 links
Fir, 8", S42°E, 26 links
Fir, 8", S38°W, 11 links.

Description of corner evidence found:

Location poster on fallen Balsam tree
Balsam stump, 12" - 14", N37°W, 9.2 feet
Cedar 14", N80°W, 32.5 feet
Balsam stump very rotted, S42°E, 15.8 feet
Balsam stump very rotted, S38°W, 7.3 feet.

Description of monument and accessories I established to perpetuate the location of this corner:


At corner position set a 2 inch by 30 inch aluminum monument with cap stamped: T36N, R16E, S19, S20, S30, S29, 1980, R.L.S. 1558.

From which the following bear:
Cedar, 12", S80°E, 6.28 feet
Balsam, 10", S1°E, 10.55 feet
Cedar, 12", S77°W, 72.08 feet
W. Spruce, 9", N60°W, 45.15 feet.

DOCUMENT NO.
119865



43616190000

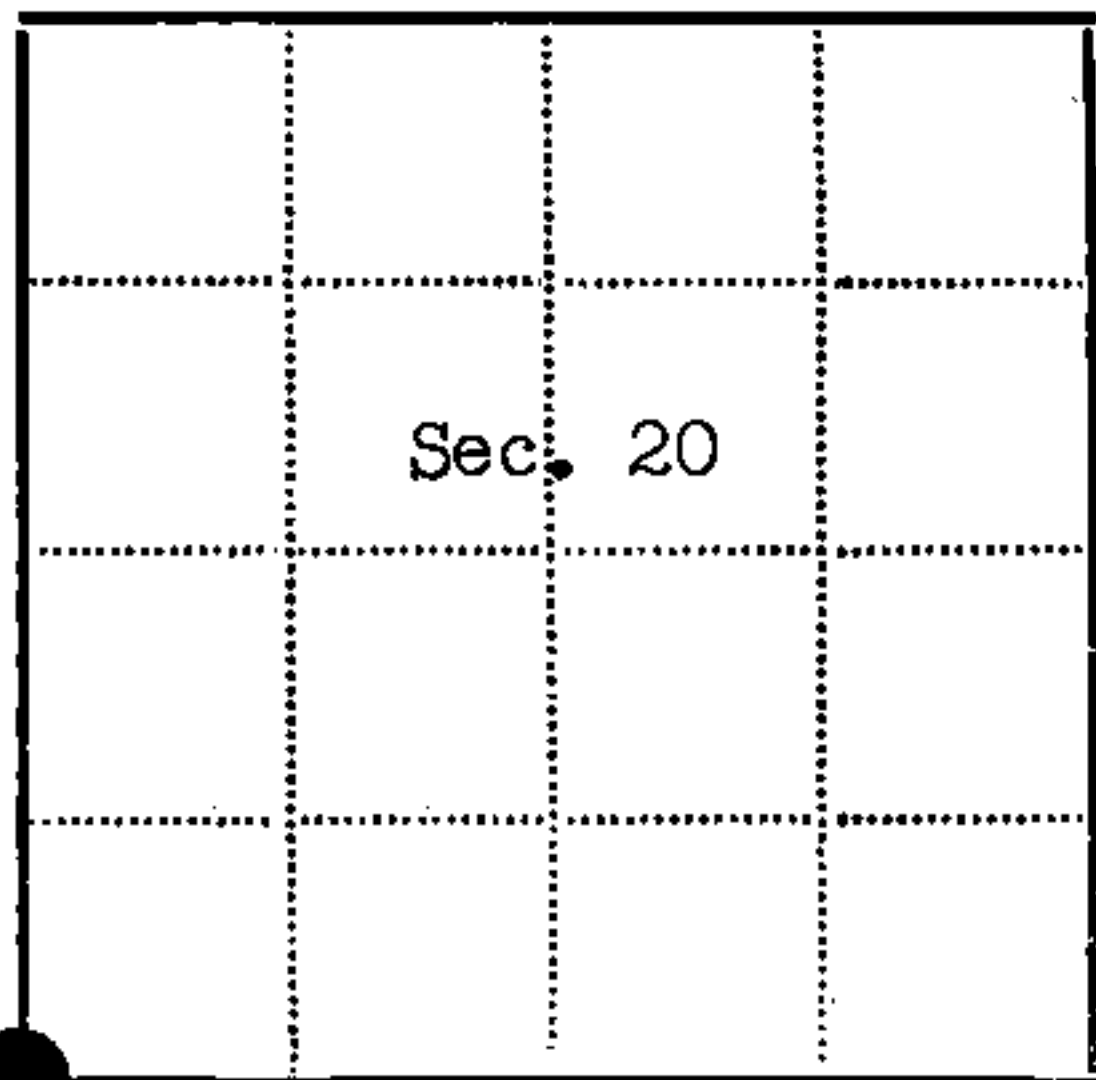

● - Corner monument restored
□ -

Resident witnesses.....

Dated at Laona Wisconsin, this 3 day of November 1980.

Signature Milo E. Stefan Title Land Surveyor
(County Surveyor, Registered Land Surveyor, or other duly authorized official)

Surveyors Registration No. 1558.

Office of Register of Deeds County of Forest

I hereby certify that the within instrument was filed in this office for record on the 2nd day of June 1981, and was filed in Book No. Page No. of County Records.

Signature Eugene Staty Title Register of Deeds

Township 36N, Range 16E, Section 20, Index No. R-5, Page No.

R
5