

CERTIFIED LAND CORNER RESTORATION

State of Wisconsin }
County of Forest } ss.

I William B. Cochrane, do hereby certify that on the 15th day of May, 19 80, I found evidence of the East quarter corner of Section 19 Township 36 North, Range 16 East, Fourth Principal Meridian, as described hereon; and that from this evidence I established a new monument and accessories as described hereon to perpetuate the original location of this corner:

Description of original monument and accessories and subsequent restorations:

Surveyed in 1858 by James McBride.
North between Sections 19 and 20, 40.00 chains set quarter section post.
Cedar, 20 inches, S81W, 4 links
Elm, 12 inches, N76E, 21 links.



Description of corner evidence found:

1 inch iron pipe lying on ground. No post was found.
Cedar snag tipped over, about 22 inches diameter and an Elm stump.
At a point S76W, 21 links from the Elm stump, the cedar snag bears S81W, 4 links.

Description of monument and accessories I established to perpetuate the location of this corner:

At the corner position, determined from the original bearing tree evidence, I set a 2 inch inside diameter galvanized iron pipe, 3 feet long, filled with concrete, with a brass cap stamped:
T36N, R16E, 1/4, S19, S20, 1980, S-1107

Blazed and scribed the following new bearing trees:
Basswood, 6 inches, S19W, 19.71 feet
Basswood, 11 inches, West, 36.52 feet.

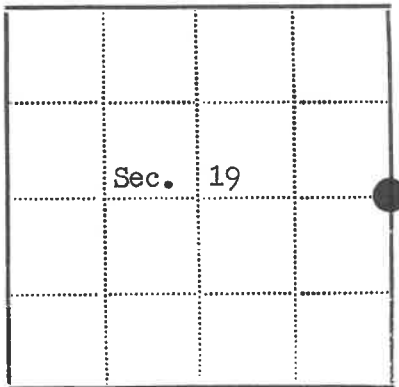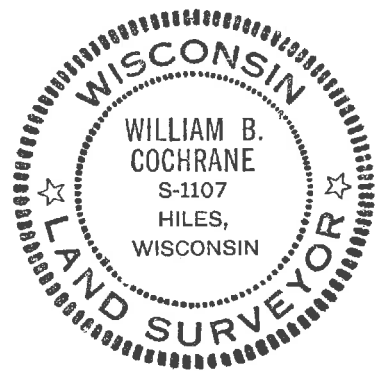

● - Corner monument restored
□ -

Resident witnesses.....

Dated at Laona Wisconsin, this 28th day of May 19 80.

Signature William B. Cochrane Title Land Surveyor
(County Surveyor, Registered Land Surveyor, or other duly authorized official)

Surveyors Registration No. S-1107 DOCUMENT NO. 118084

Office of Register of Deeds County of Forest

I hereby certify that the within instrument was filed in this office for record on the 9th day of June 19 80, and was filed in Book No. Page No. of County Records.

Signature Sharon Mueller Title Deputy

Township 36 North, Range 16 East, Section 19, Index No. P-5, Page No.