


U. S. PUBLIC LAND SURVEY MONUMENT RECORD

INSTRUCTIONS: This record shall show the location of the corner and shall include all of the following nine elements (a through i).

- (a) Identify the corner by reference to the U.S. public land survey system.
- = Corner monument restored.

Quarter Corner Common to Sections 22 and 23,  
T36N, R16E, Forest County, Wisconsin.

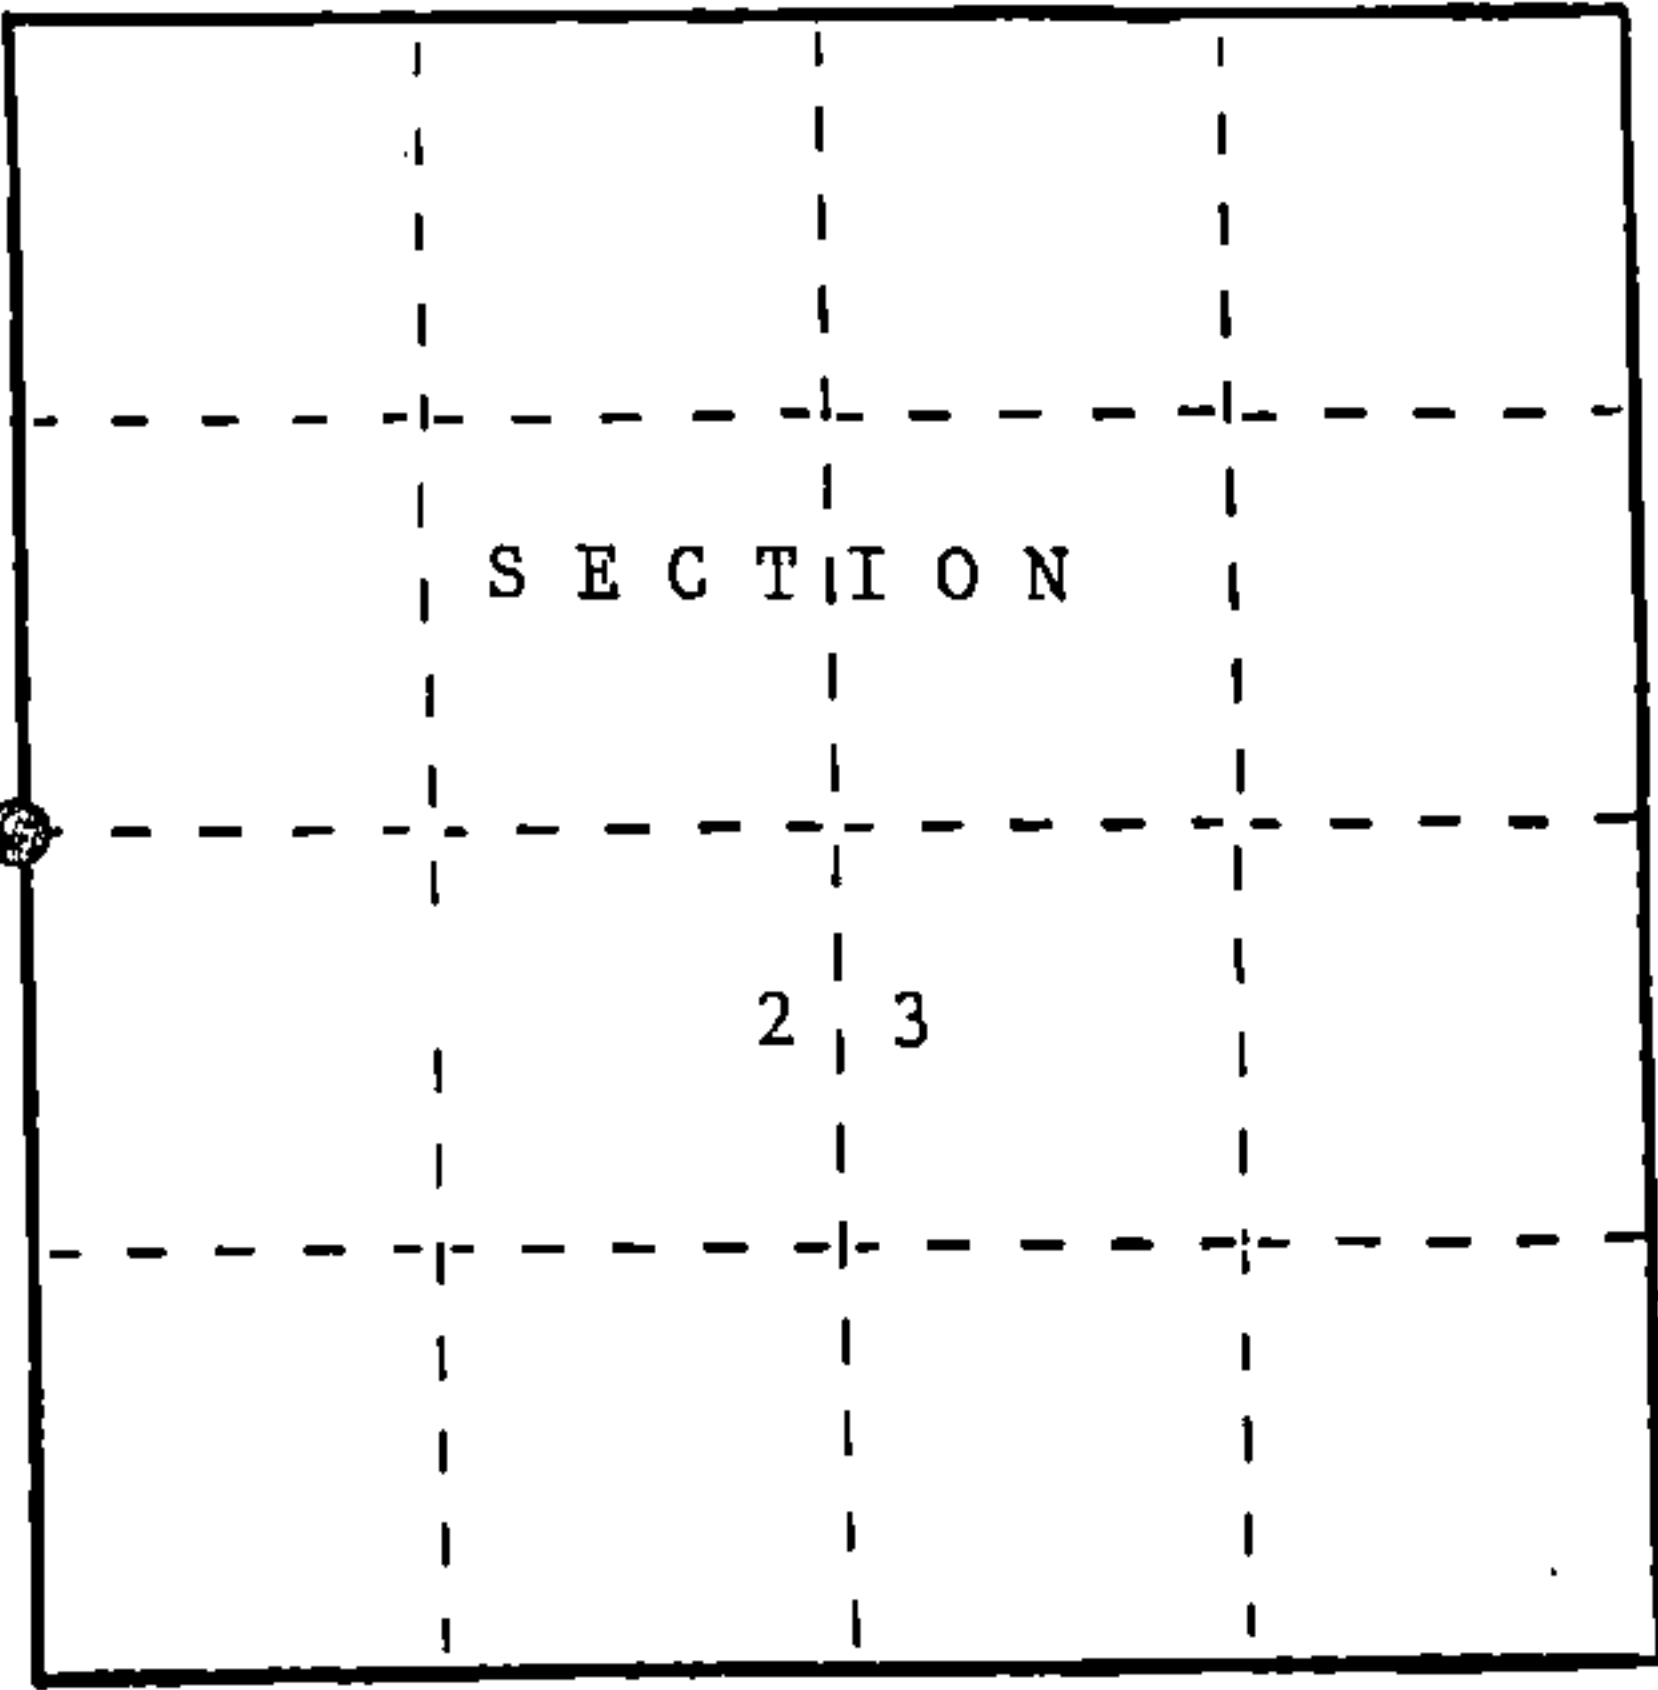

REGISTER'S OFFICE  
Forest County, Wis.  
Received for record this 17th day  
of December A.D., 1988 at  
2:50 o'clock P.M. and recorded  
in Vol. CORNER RESTORATIONS  
page P. 17  
Paul Aschenheuer  
Register of Deeds

- (b) Describe any record evidence, monument evidence, occupational evidence, testimonial evidence or any other material evidence you considered, and whether the monument was found or placed.

In 1858, James McBride set a wood post for the corner and the following corner references:  
Cedar 10" S22°E 8 lks. Cedar 8" S48°W 18 lks.


In 1926, Goodman Lumber Company set a wood post by proportional measurement and then replaced it with flue pipe. Found an 8" leaning cedar tree 5 paces Southeast with a blaze on it.

In 1988, John Schulke found two Cedar stumps that fit the GLO notes.  
Placed 2 1/2" dia. X 60" aluminum monument.

- (c) In the plan view drawing below, provide reference ties to at least 4 witness monuments, or, if the location is within a municipality, to at least 2 witness monuments. (Witness monuments shall be made of concrete, natural stone, iron or other equally durable material.)  
Describe witness monuments.

- (d) Show a plan view drawing depicting the relevant monuments and reference ties which is sufficient in detail to enable accurate relocation of the corner monument if the corner monument is disturbed. Indicate north.

1. 2 1/2" Dia. X 60" aluminum magnetic cap monument stamped to identify the corner.
2. Aspen 9" N30°W 64.58 feet
3. Black Ash 4" N14°E 49.32 feet
4. Black Cherry 6" S19°E 78.12 feet
5. Balsam 8" S11°W 76.35 feet
6. Steel sign post Southeast 1.0 feet

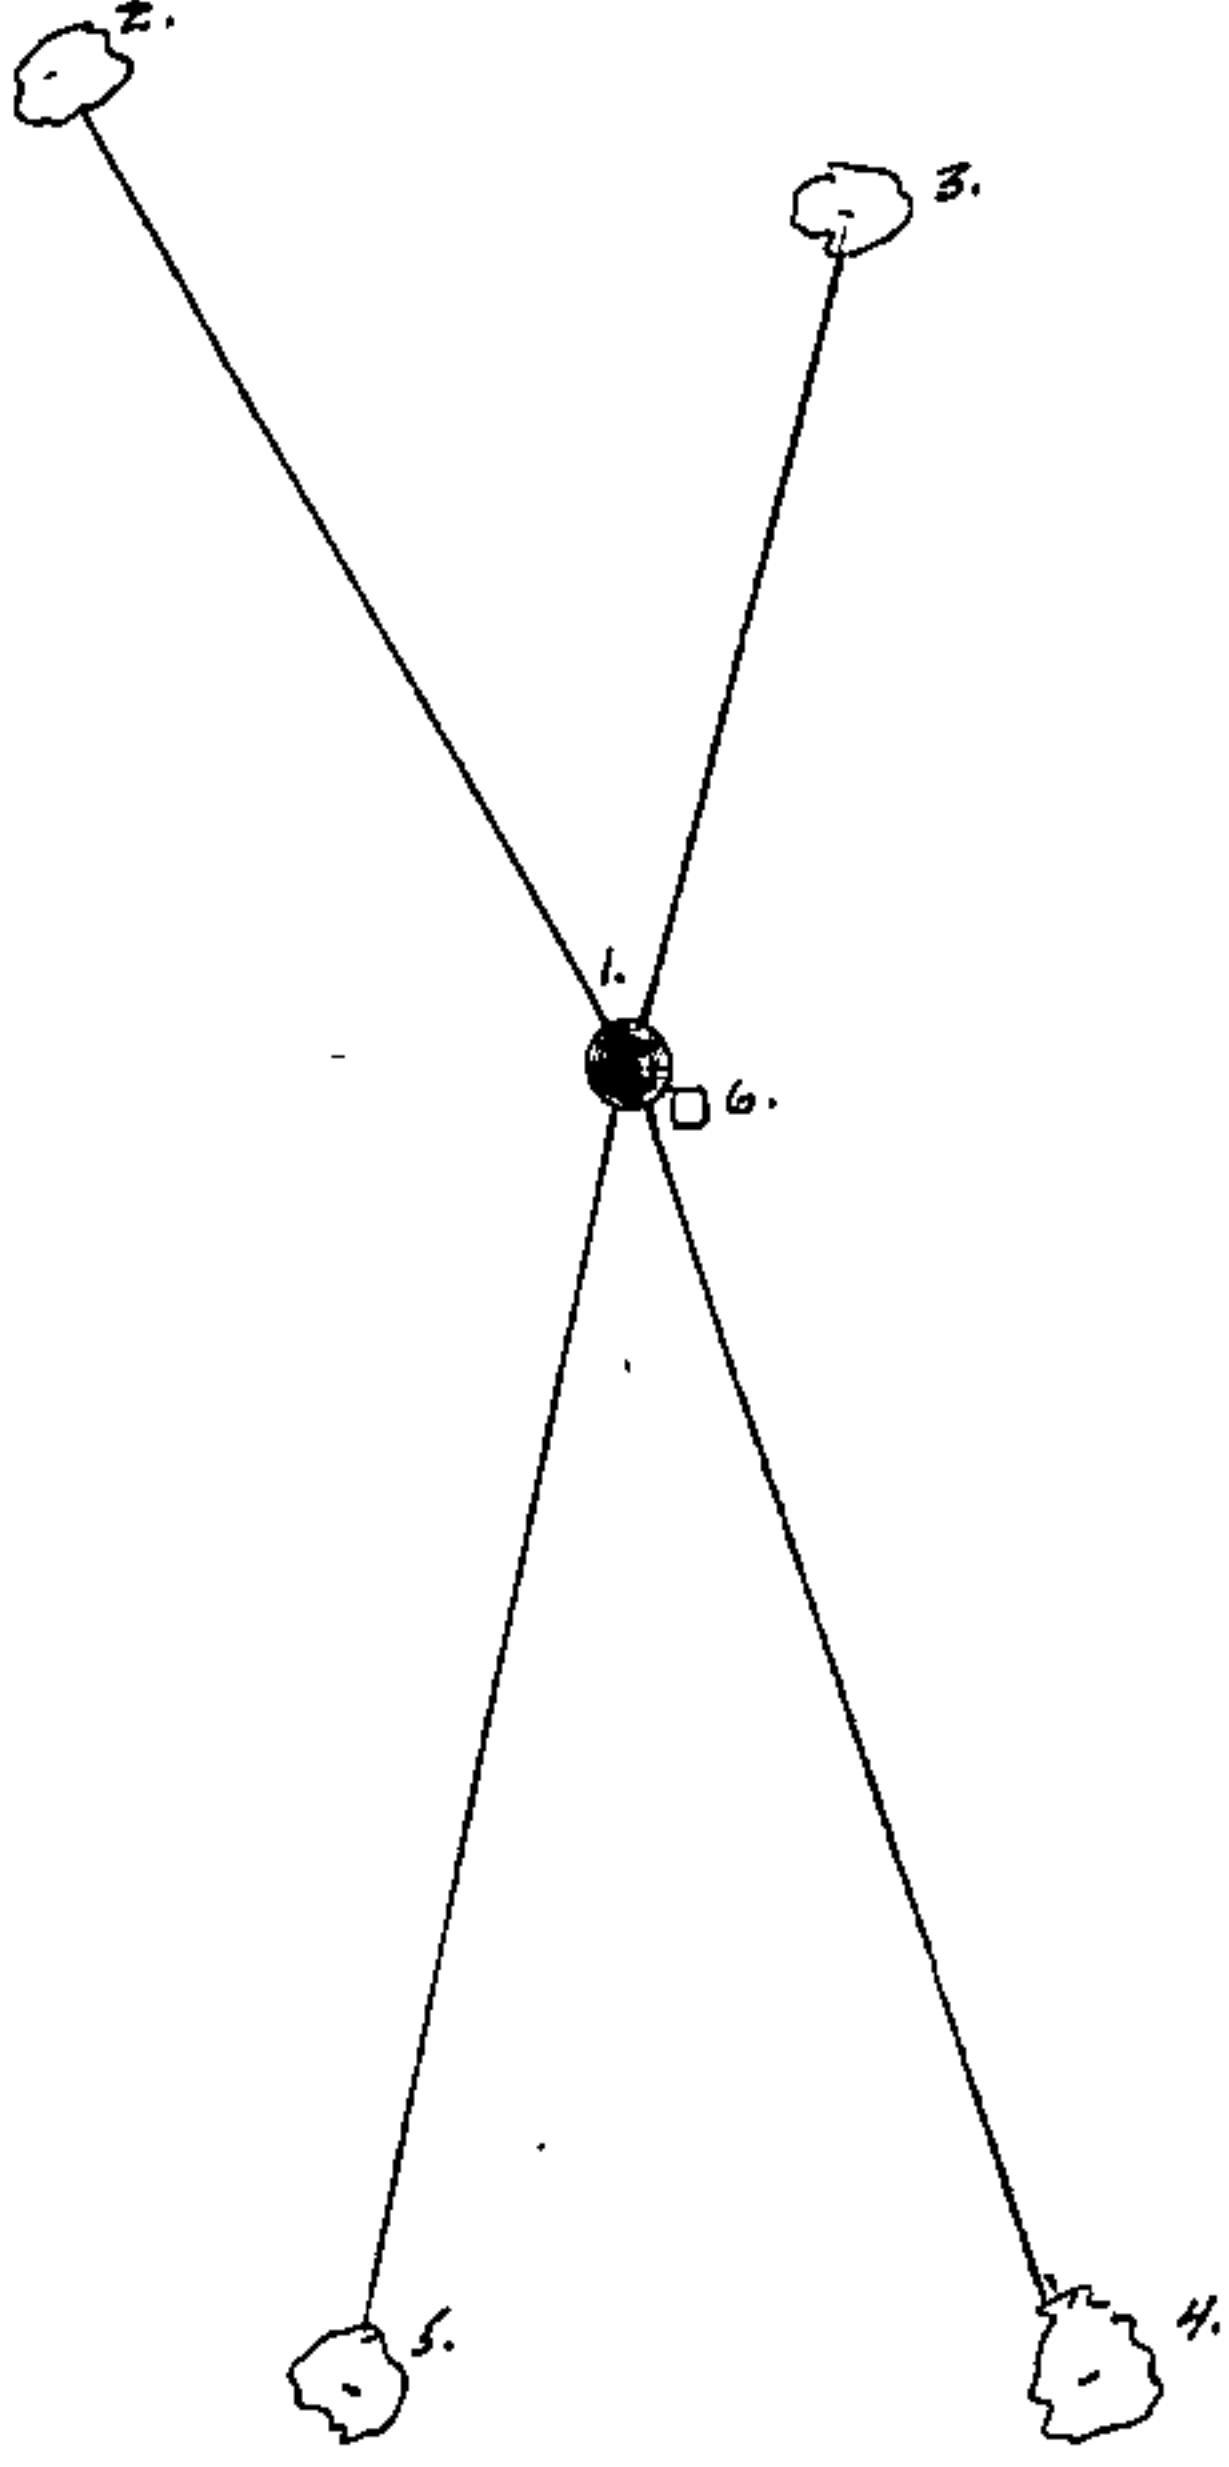

43616222000

- (e) Describe any material discrepancy between the location of the corner as restored or reestablished and the location of that corner as previously restored or reestablished by distance and direction. Show the discrepancy on the plan view drawing under (d), above. Show the distances between the corner as previously restored or reestablished and (1) the corner as restored or reestablished, and (2) to at least 2 of the witness monuments shown on the drawing in (d), above.


No discrepancy, first corner restoration.

- (f) Was the corner restored through acceptance of (1) an obliterated evidence location, or, (2) a found-perpetuated location?

(1) an obliterated evidence location.

- (g&h) Was the corner reestablished through lost corner proportionate methods? If so, show the method, including the directions and distances to other public land survey corners used as evidence or used for proportioning in determining the corner location?

- (i) I, John Schulke  
(type or print name) certify that the corner location shown on this record was determined by me or under my direction and control and that this U.S. Public Land Survey Monument Record is correct and complete to the best of my knowledge and belief.

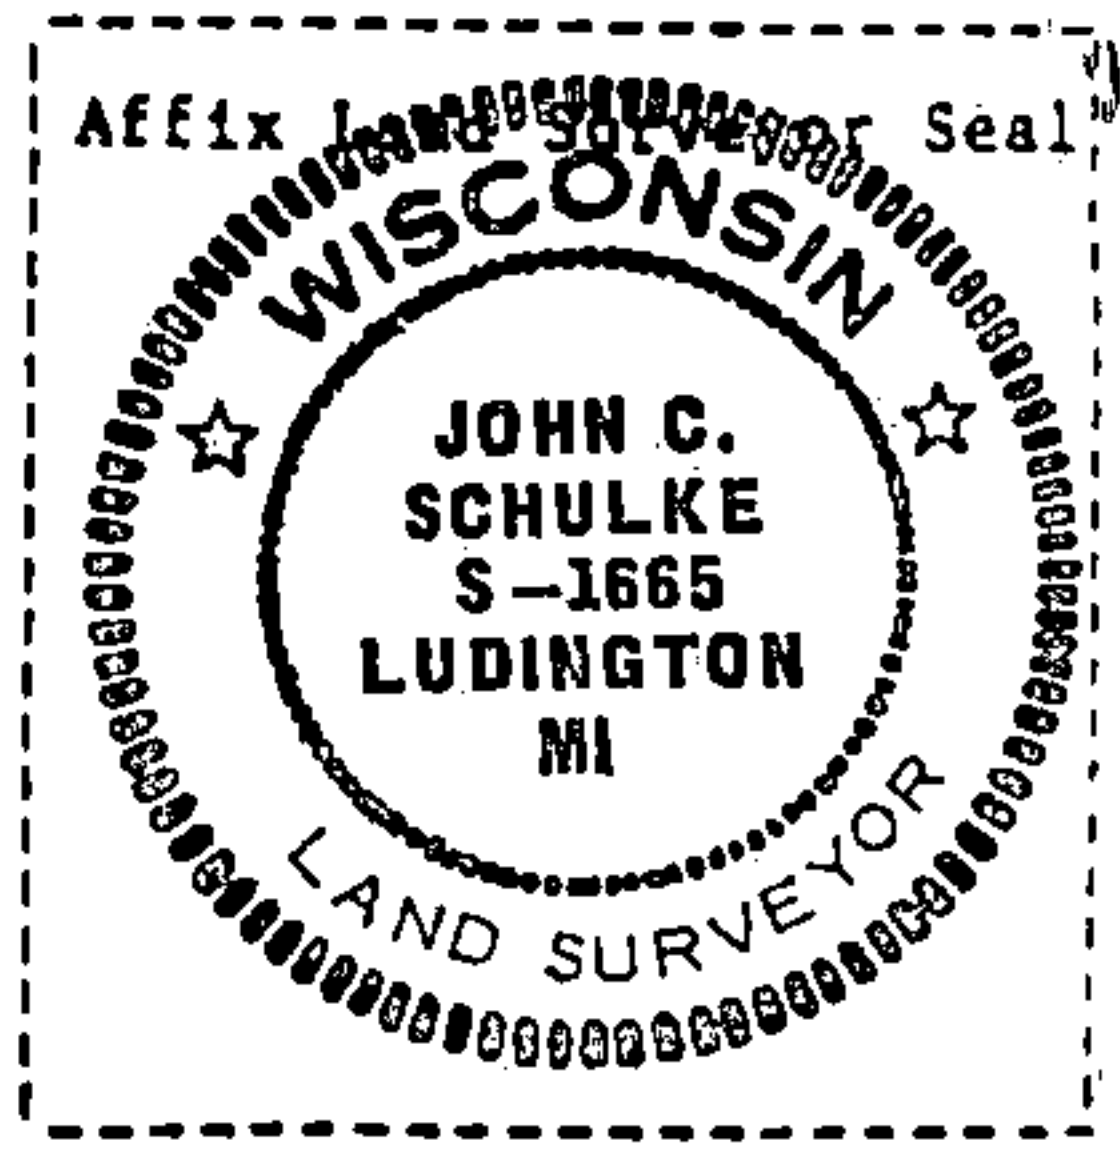

John Schulke 12/2/88  
Signature Date

Certificate ready for filing: Dale B. Staeger  
District Ranger