

DOCUMENT NUMBER  
**136621**


**U. S. PUBLIC LAND SURVEY MONUMENT RECORD.**

**I N S T R U C T I O N S :** This record shall show the location of the corner and shall include all of the following nine elements (a through i).

(a) Identify the corner by reference to the U.S. public land survey system.

○ = Corner monument restored.

Quarter Corner Common to Sections 26 and 27,  
T36N, R16E, Forest County, Wisconsin.

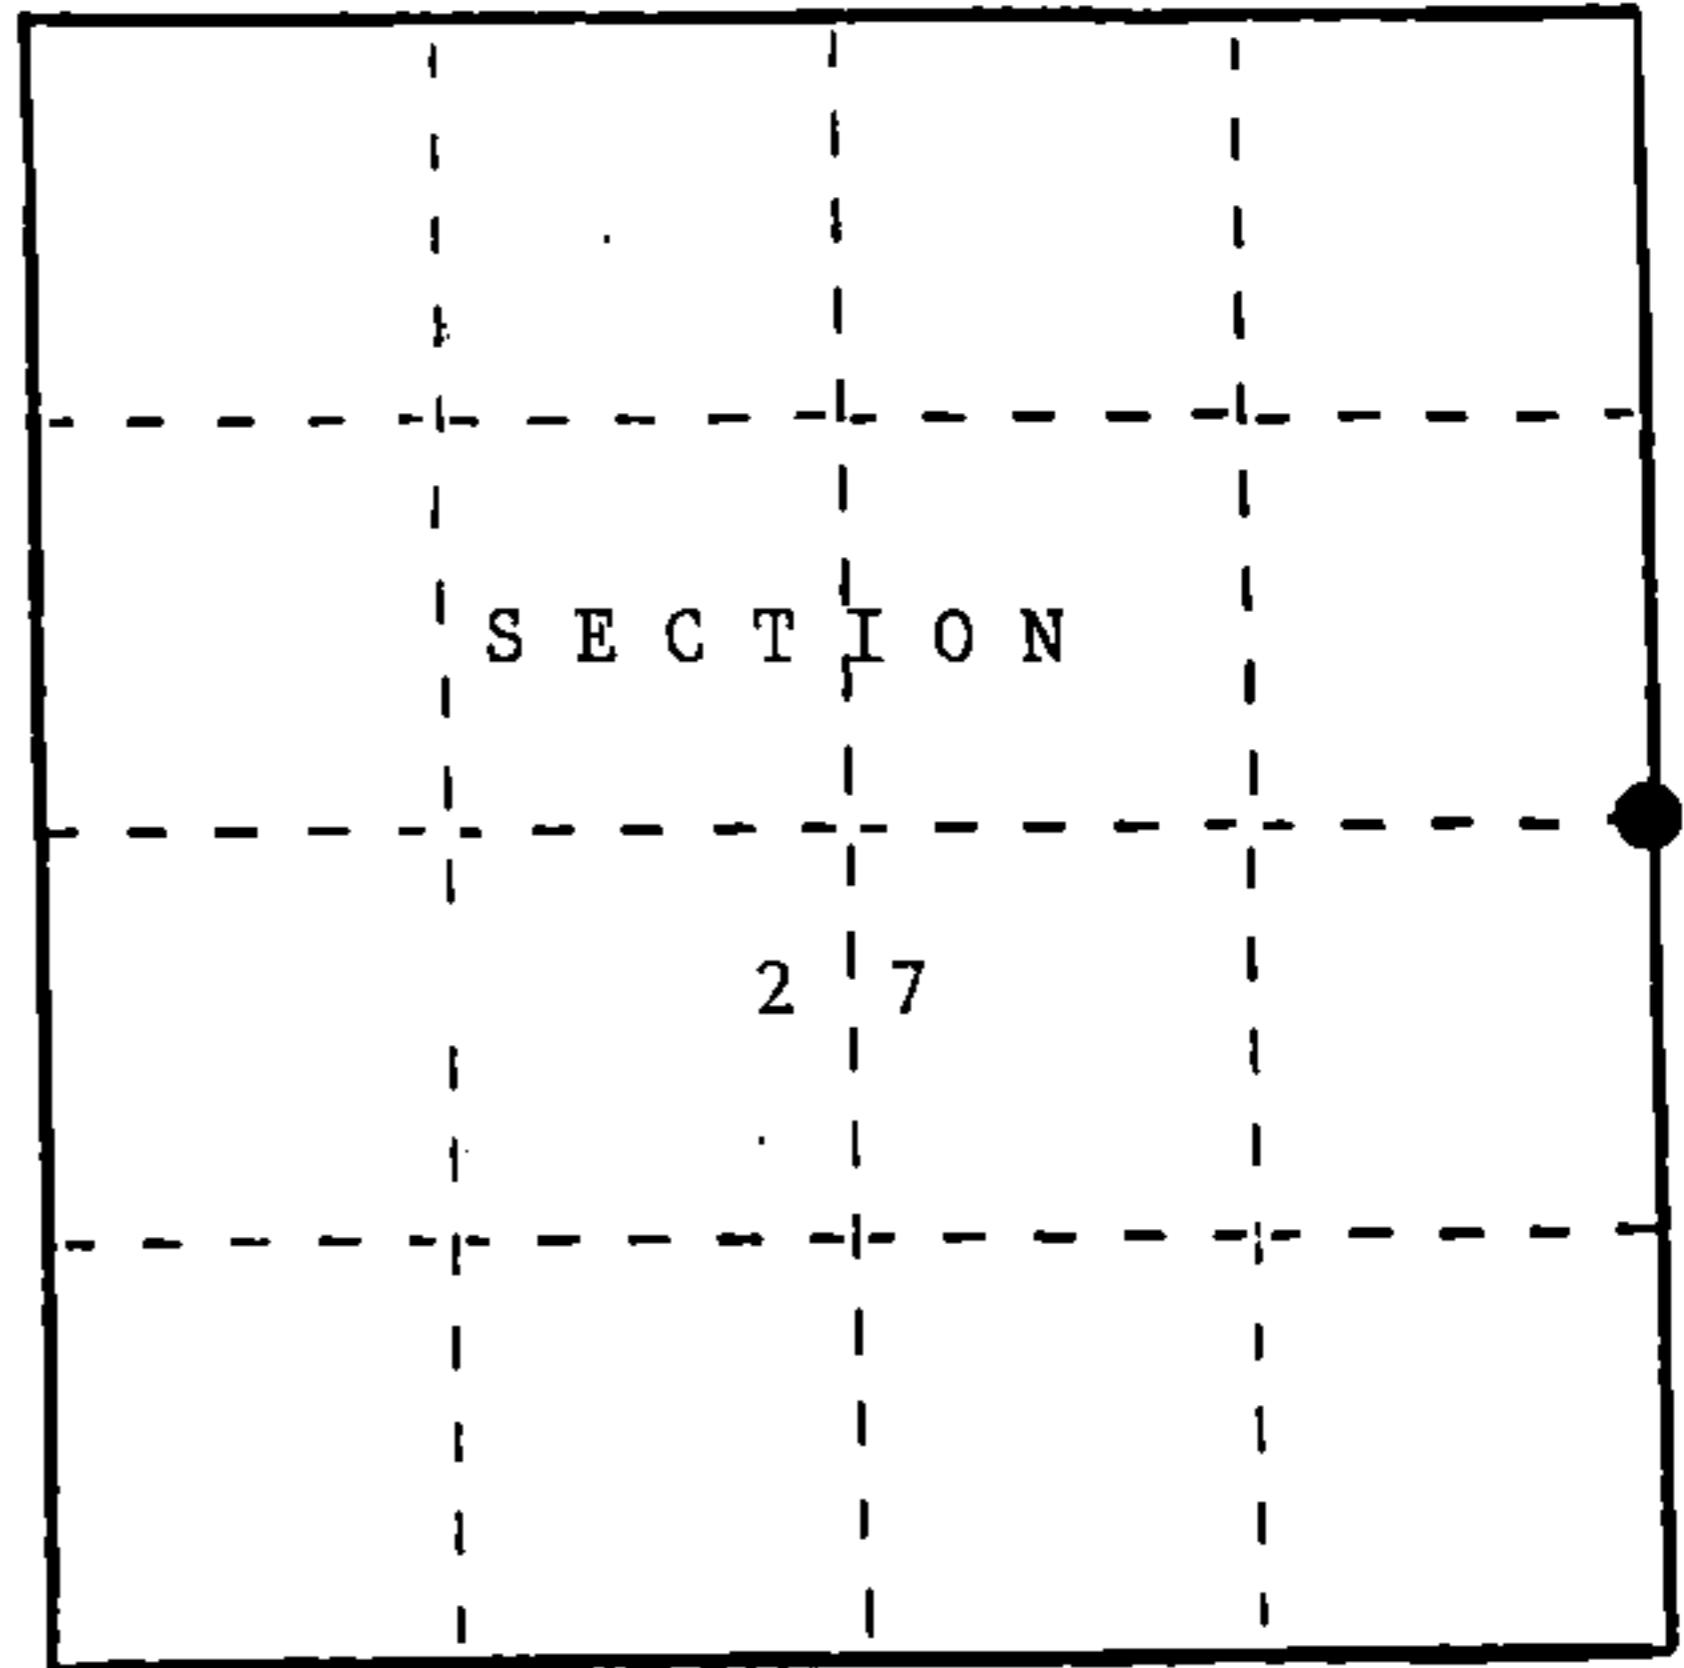

REGISTER'S OFFICE  
Forest County, Wis. *gth*  
Received for record this *19th* day  
of *December* A.D., 19*88* at  
*2:50* o'clock *P.*M. and recorded  
in Vol. *CORNER RESTORATIONS*  
page *11*  
*Paul Archerheimer*  
Register of Deeds

(b) Describe any record evidence, monument evidence, occupational evidence, testimonial evidence or any other material evidence you considered, and whether the monument was found or placed.

In 1858, James McBride set a wood post for the corner and the following corner references:  
Sugar 8" S33°W 35 lks. Elm 10" S20°E 25 lks.


In 1926, Goodman Lumber Company found no evidence.

In 1988, John Schulke found no evidence. Placed 2 1/2" dia. X 36" aluminum monument.  
The center of a two track road is Northeast 41 feet from the monument.

(c) In the plan view drawing below, provide reference ties to at least 4 witness monuments, or, if the location is within a municipality, to at least 2 witness monuments. (Witness monuments shall be made of concrete, natural stone, iron or other equally durable material.)  
Describe witness monuments.

(d) Show a plan view drawing depicting the relevant monuments and reference ties which is sufficient in detail to enable accurate relocation of the corner monument if the corner monument is disturbed. Indicate north.

1. 2 1/2" dia. X 36" aluminum magnetic cap monument stamped to identify the corner.
2. Aspen 6" N10°E 13.57 feet
3. Black Cherry 6" S60°E 32.53 feet
4. Spruce 3" S40°E 52.39 feet
5. Aspen 10" N56°W 75.47 feet
6. Steel sign post Southwest 1.1 feet

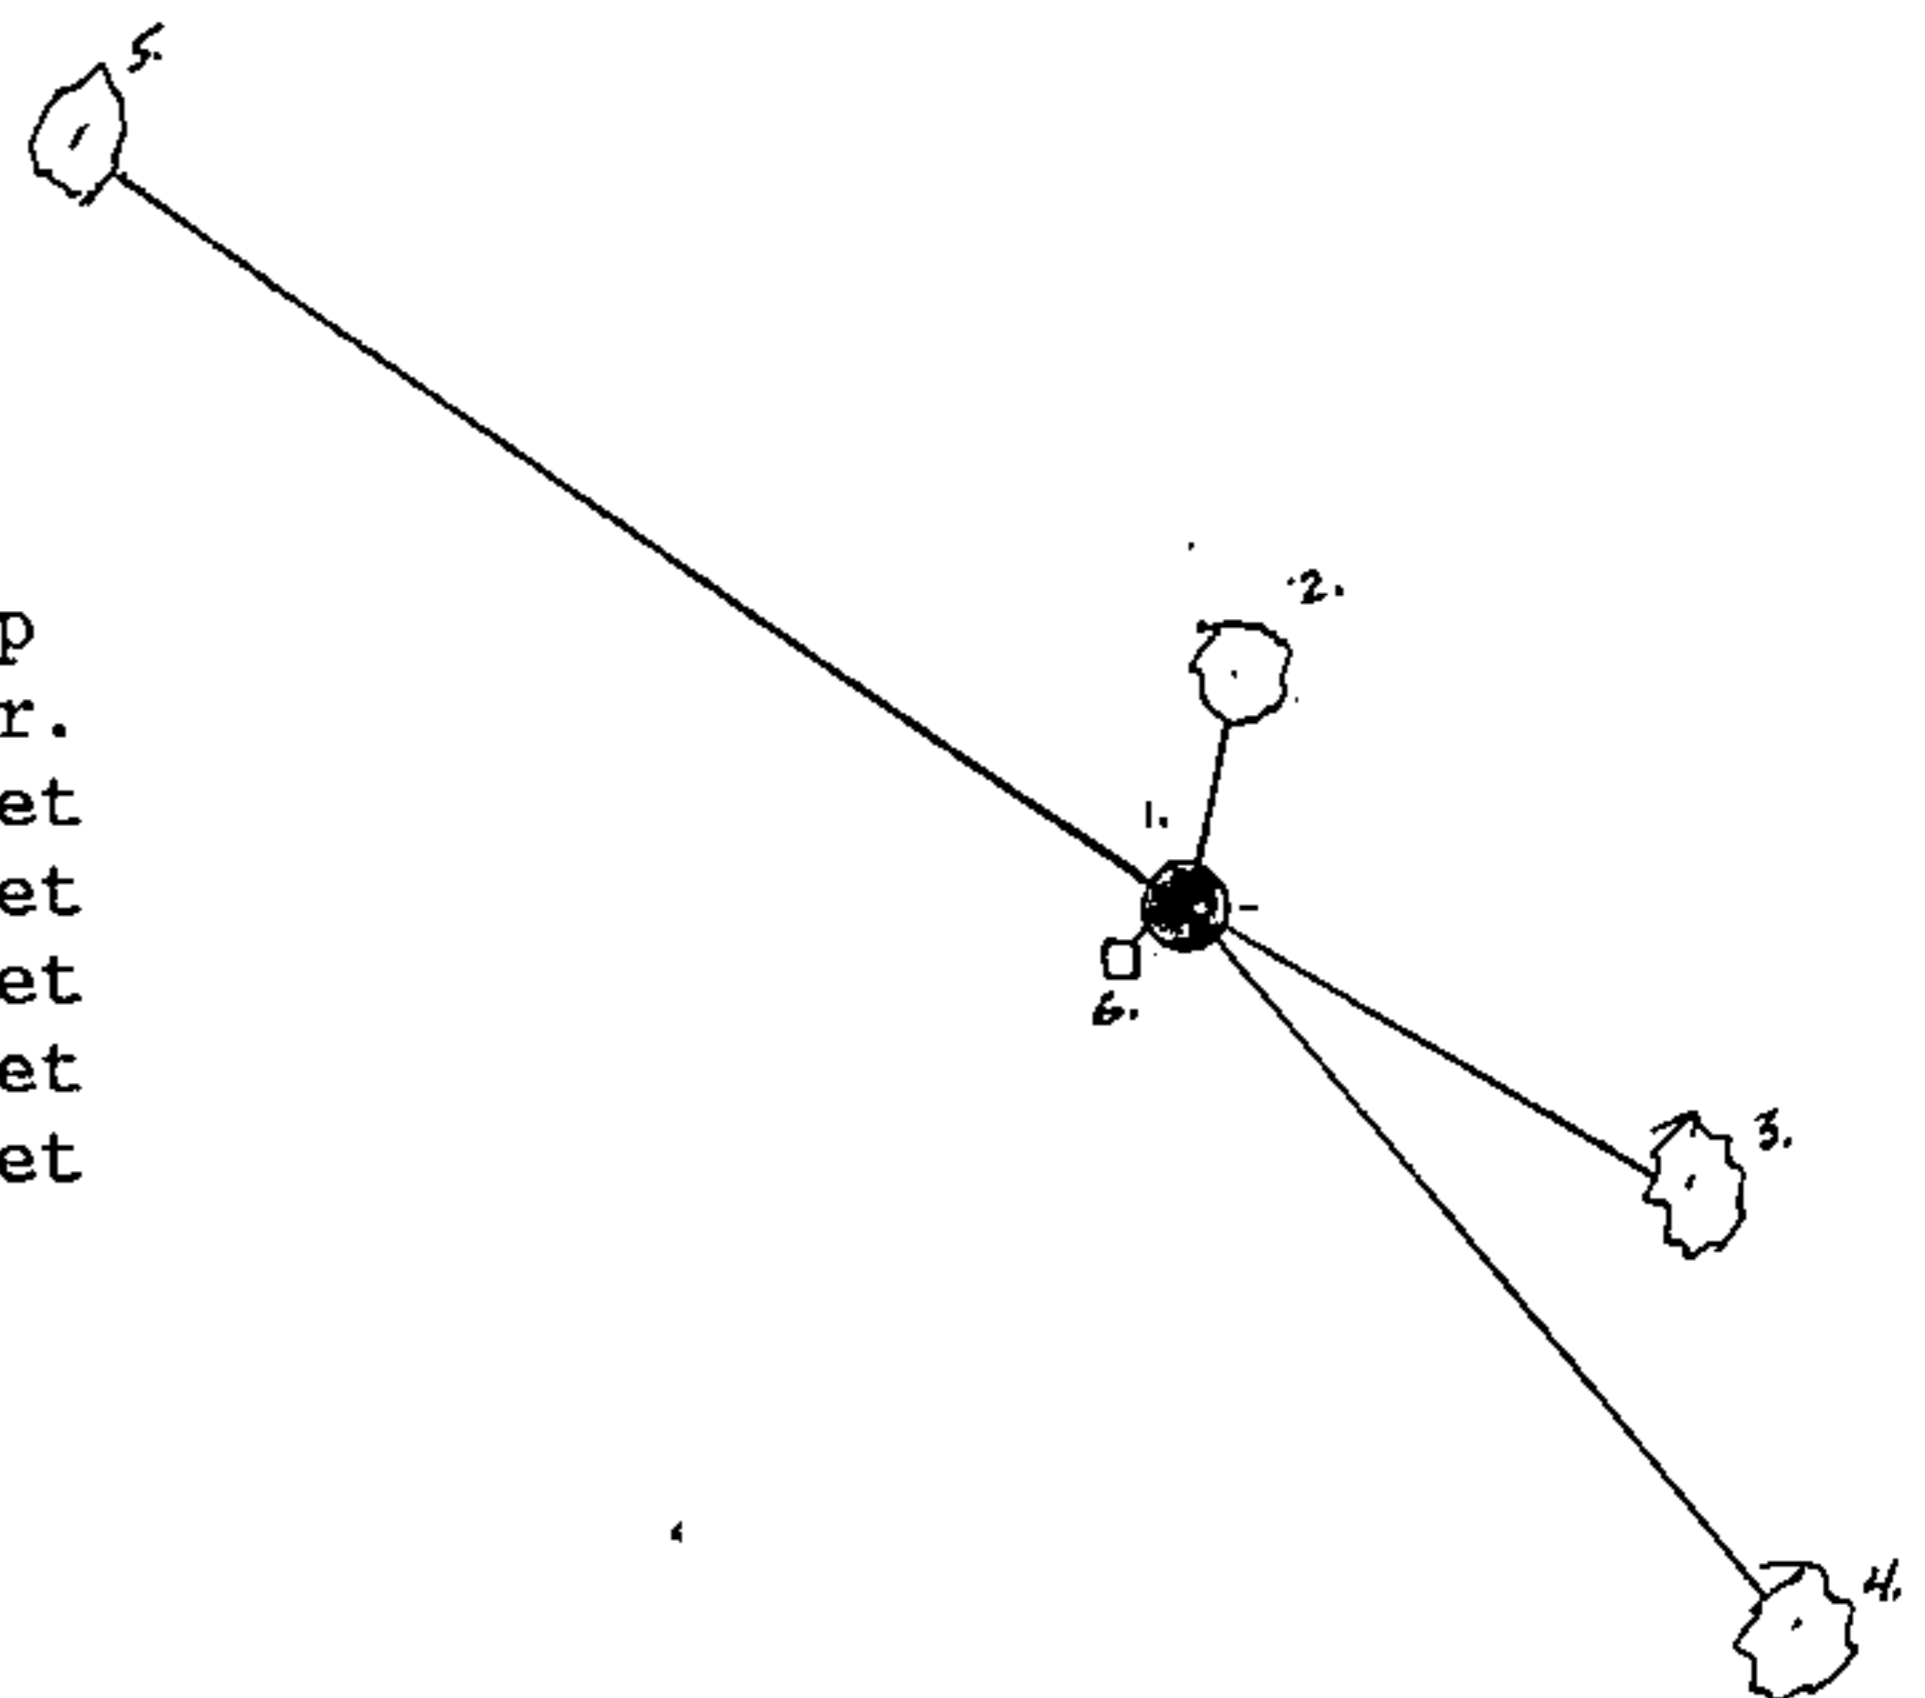

43616272000

