


U. S. PUBLIC LAND SURVEY MONUMENT RECORD

INSTRUCTIONS:

This record shall show the location of the corner and shall include all of the following nine elements (a through i).

- (a) Identify the corner by reference to the U.S. public land survey system.
 ○ = Corner monument restored.

Quarter Corner Common to Sections 31 and 6,
 T.35-36N., R.16E., Forest County, Wisconsin.

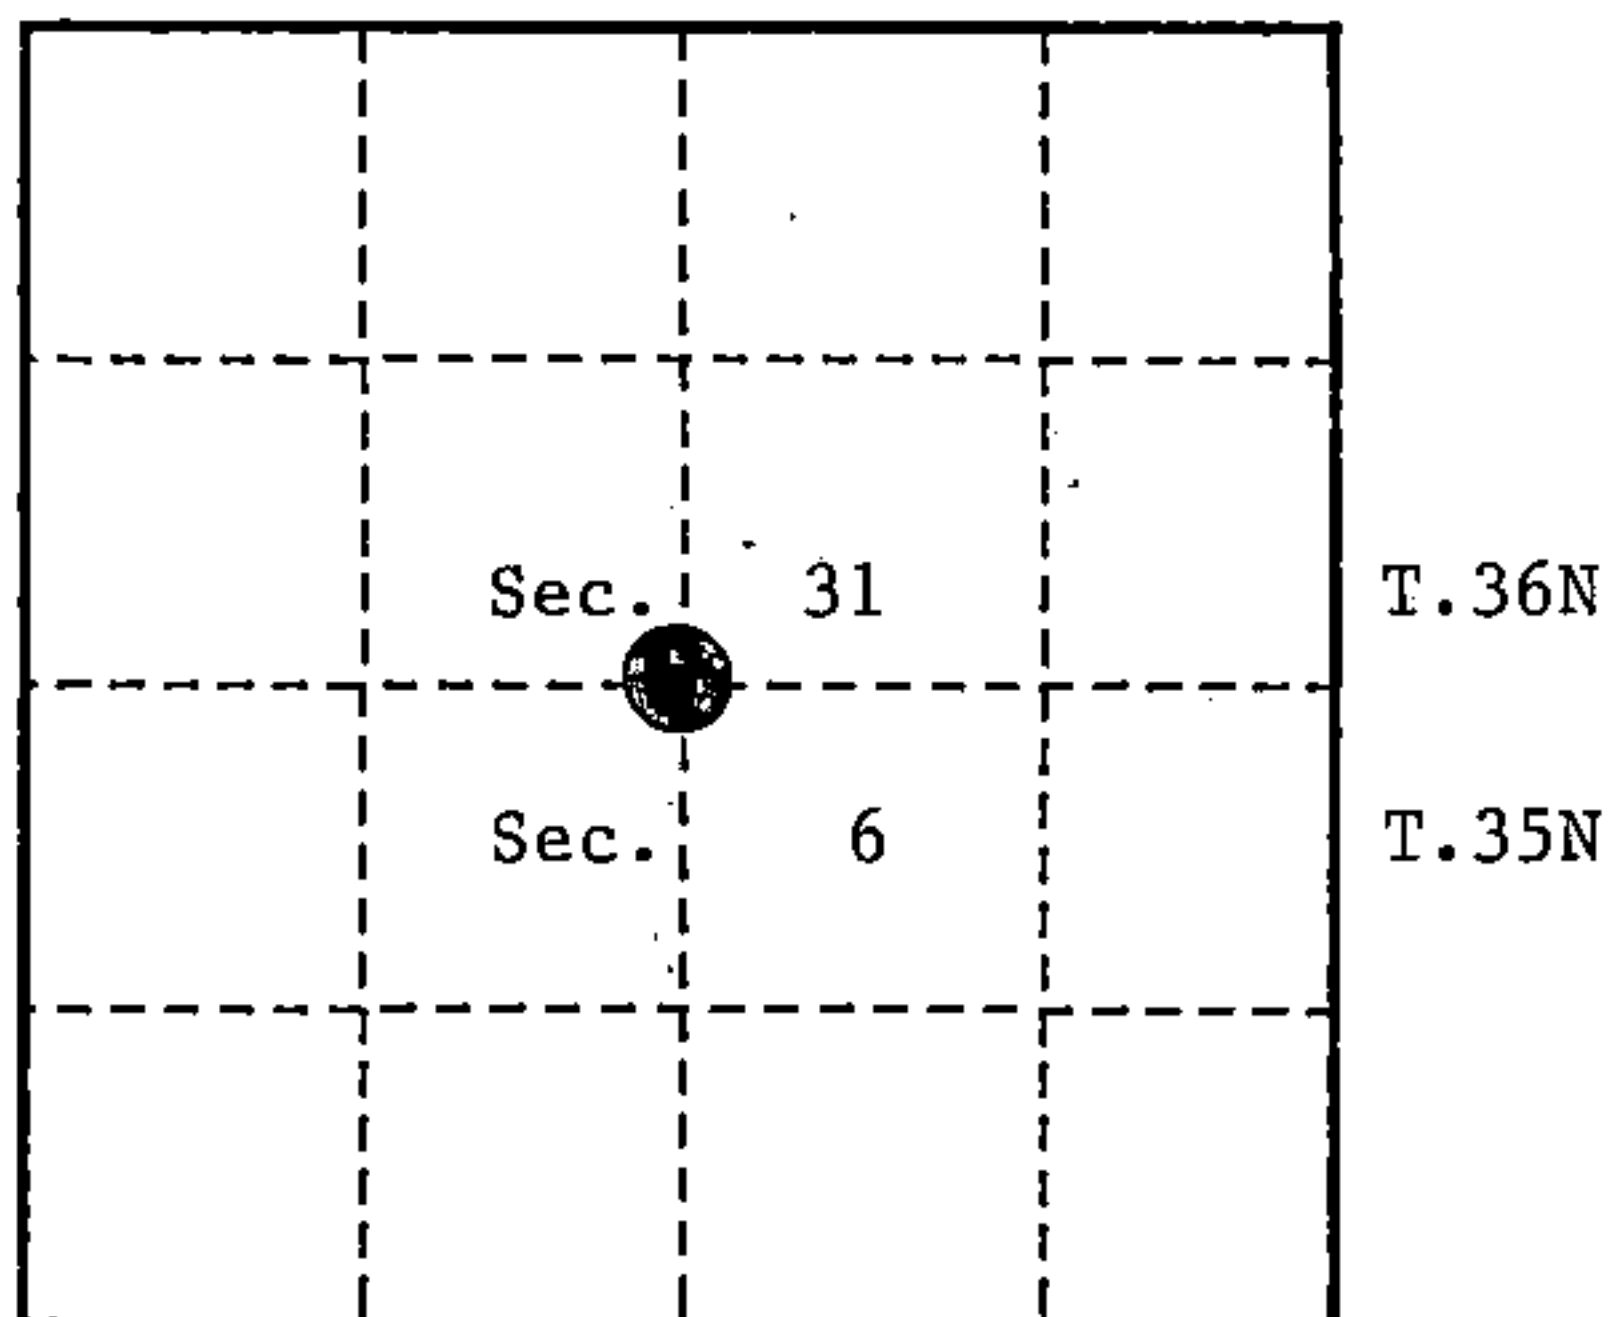

- (b) Describe any record evidence, monument evidence, occupational evidence, testimonial evidence or any other material evidence you considered, and whether the monument was found or placed.

In 1857, Artemas Curtis set a wood post and the following bearing trees; Yellow Birch, 18", N.15°W., 24 links (15.84 feet), Sugar, 6", S.21°E., 25 links (16.50 feet).


In 1911, J. Melindy found Quarter Post and the following original bearing trees; Yellow Birch, marked, N.15°W., 15.18 feet, Maple, 14", marked, S.20°E., 16.50 feet. Replaced old post with a 4"x4"x48" cedar post.

On May 4, 1993, Alan D. Harrison (RLS) found a metal location poster and a one foot length of old cedar post just East of a post hole. No original or J. Melindy bearing tree evidence was recovered. Accepted post hole and accessories as the best evidence of the corner position.

- (c) In the plan view drawing below, provide reference ties to at least 4 witness monuments, or, if the location is within a municipality, to at least 2 witness monuments. (witness monuments shall be made of concrete, natural stone, iron or other equally durable material.)

- (d) Show a plan view drawing depicting the relevant monuments and reference ties which is sufficient in detail to enable accurate relocation of the corner monument if the corner monument is disturbed. Indicate north.

1. 2½"x36" Aluminum monument with tablet stamped to identify the corner.
2. Basswood, 7", S.40°E., 47.55 feet.
3. Sugar, 8", S.55°W., 25.52 feet.
4. Large Rock, 5'x3", N.42°W., 17.28 feet.
5. Steel Sign Post, East, 0.97 feet.

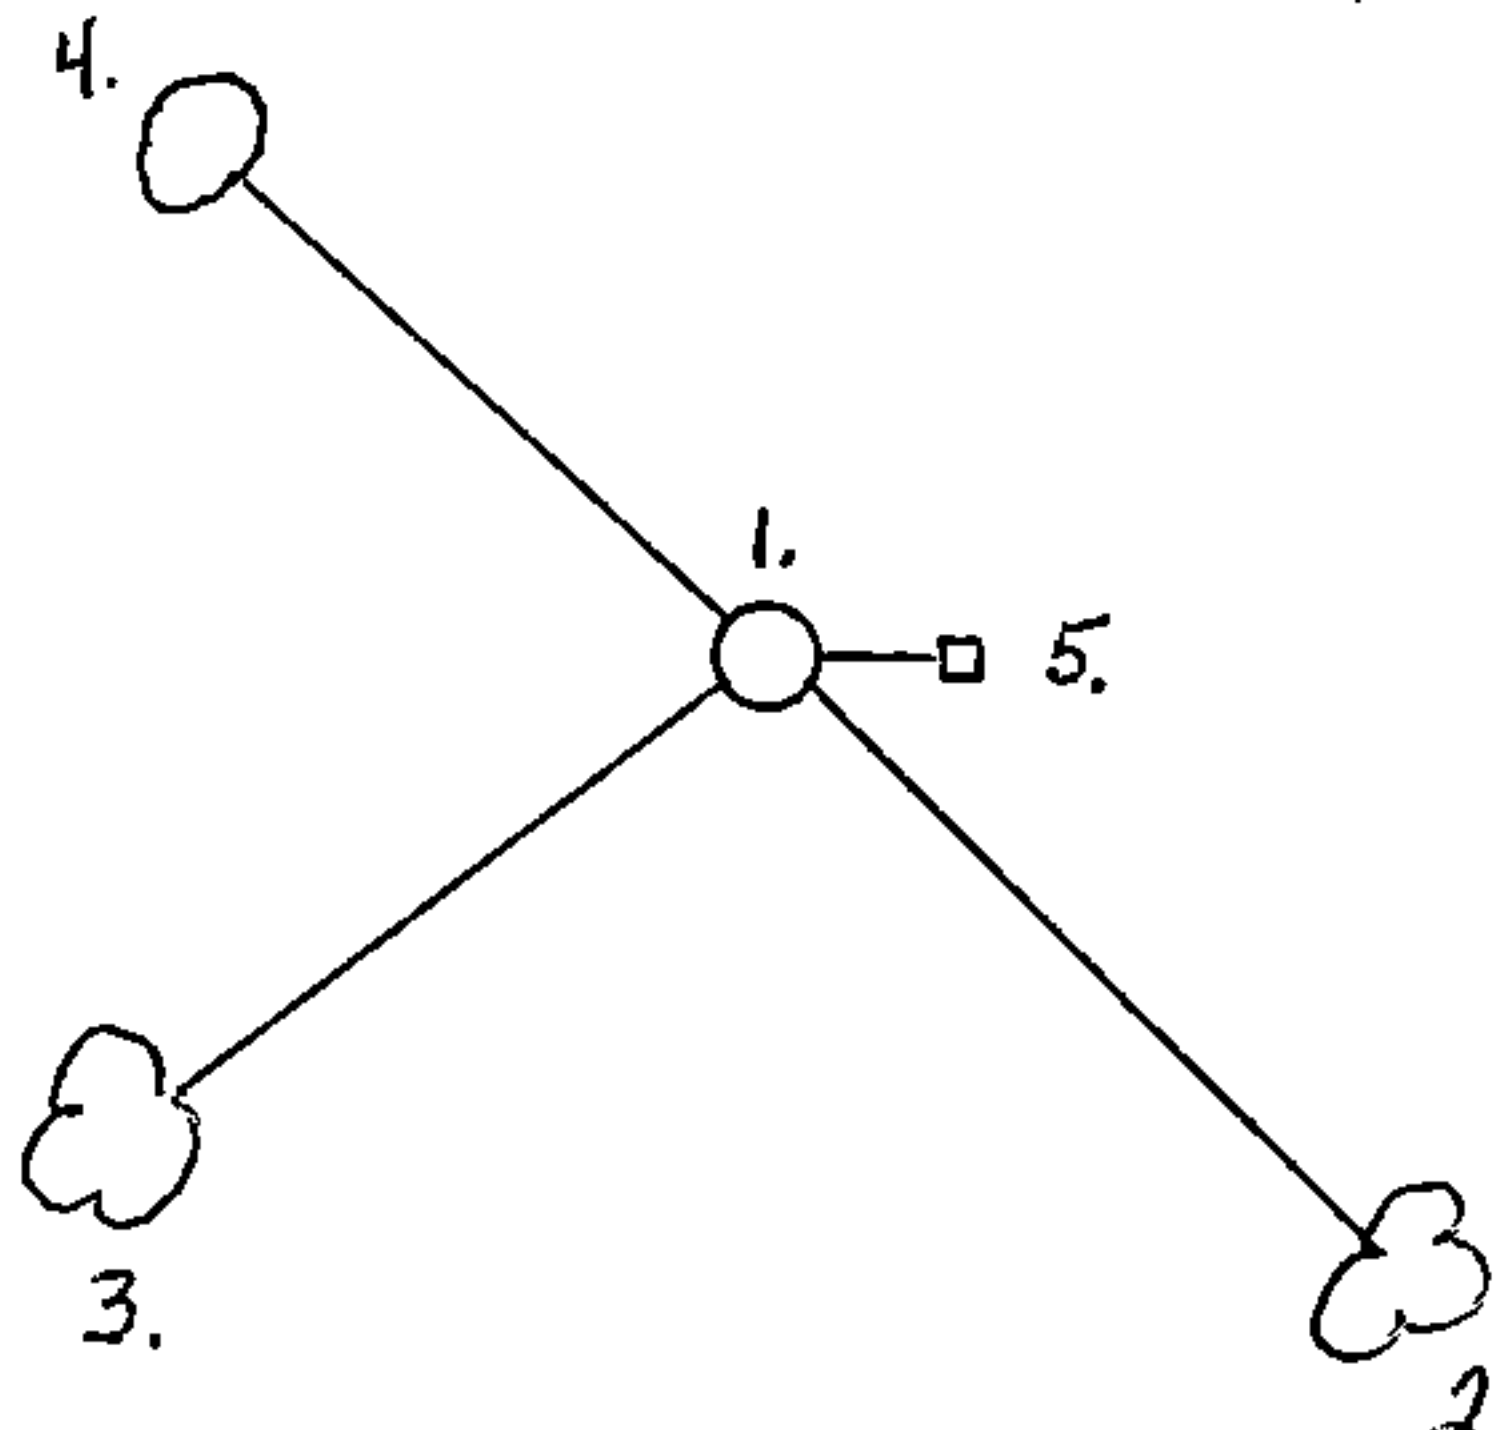

4 361631 0020

(e) Describe any material discrepancy between the location of the corner as restored or reestablished and the location of that corner as previously restored or reestablished by distance and direction. Show the discrepancy on the plan view drawing under (d), above. Show the distances between the corner as previously restored or reestablished and (1) the corner as restored or reestablished, and (2) to at least 2 of the witness monuments shown on the drawing in (d), above.

None

(f) Was the corner restored through acceptance of (1) an obliterated evidence location, or, (2) a found perpetuated location?

Restored from accepted evidence.


(g & h) Was the corner reestablished through lost corner proportionate methods? If so, show the method, including the directions and distances to other public land survey corners used as evidence or used for proportioning in determining the corner location?

No

REGISTER'S OFFICE
Forest County, Wis.

Received for record this 15th day
of September A.D. 1994 at
1:00 o'clock P.M. and recorded
in Vol. Case Restoration
page 2-3

Alan D. Harrison
Register of Deeds

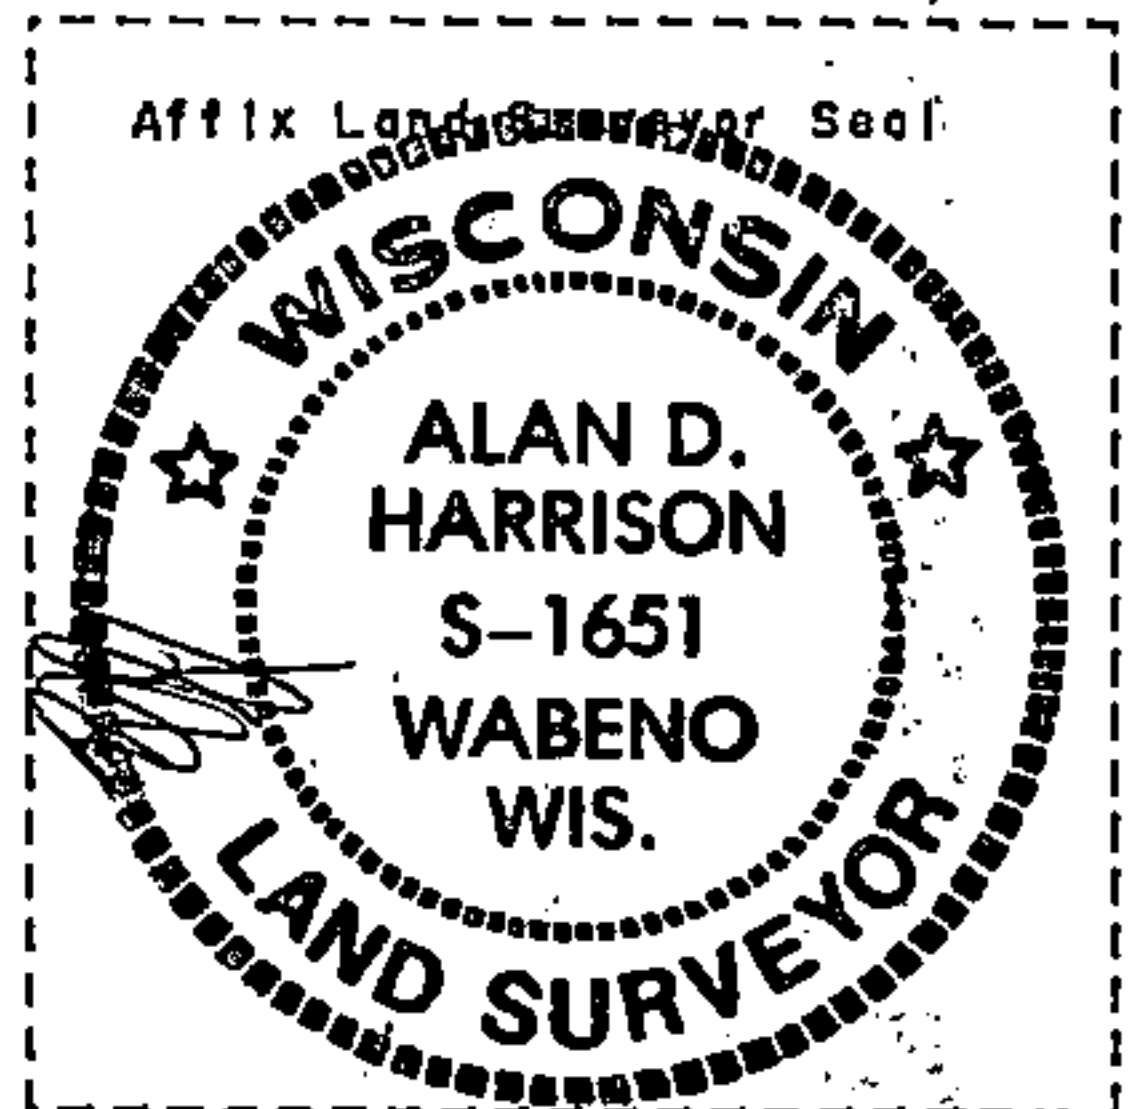

(1) I, Alan D. Harrison

(type or print name) certify that the corner location shown on this record was determined by me or under my direction and control and that this U.S. Public Land Survey Monument Record is correct and complete to the best of my knowledge and belief.

Alan D. Harrison

Signature

8/17/94

Date

CERTIFICATE READY FOR FILING:

Shel Vap
District Ranger