

CERTIFIED LAND CORNER RESTORATION

Index No. Q-1

State of Wisconsin }  
County of Forest } ss.


I Philip T. Hansen, do hereby certify that on the 14th day of February, 1978, I found evidence of the S 1/16 corner of Sections 25 & 19 Township 37, North, Range 11 & 12 East, Fourth Principal Meridian, as described hereon; and that from this evidence I established a new monument and accessories as described hereon to perpetuate the original location of this corner.

Resident witnesses:


Glen Barker

Jim Claflin

Herb Wagoner

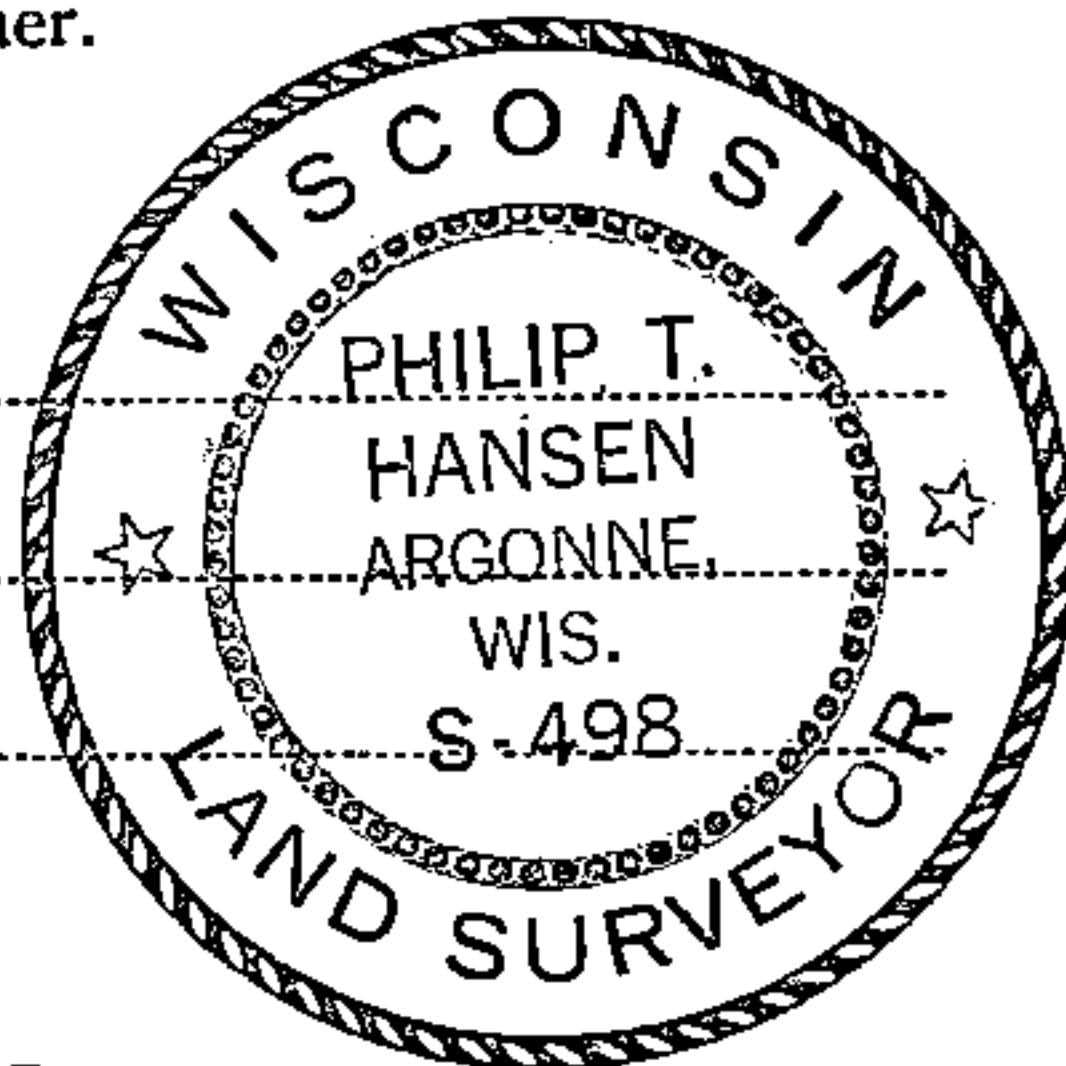

FORM 985 R. C. MILLER CO., MILWAUKEE

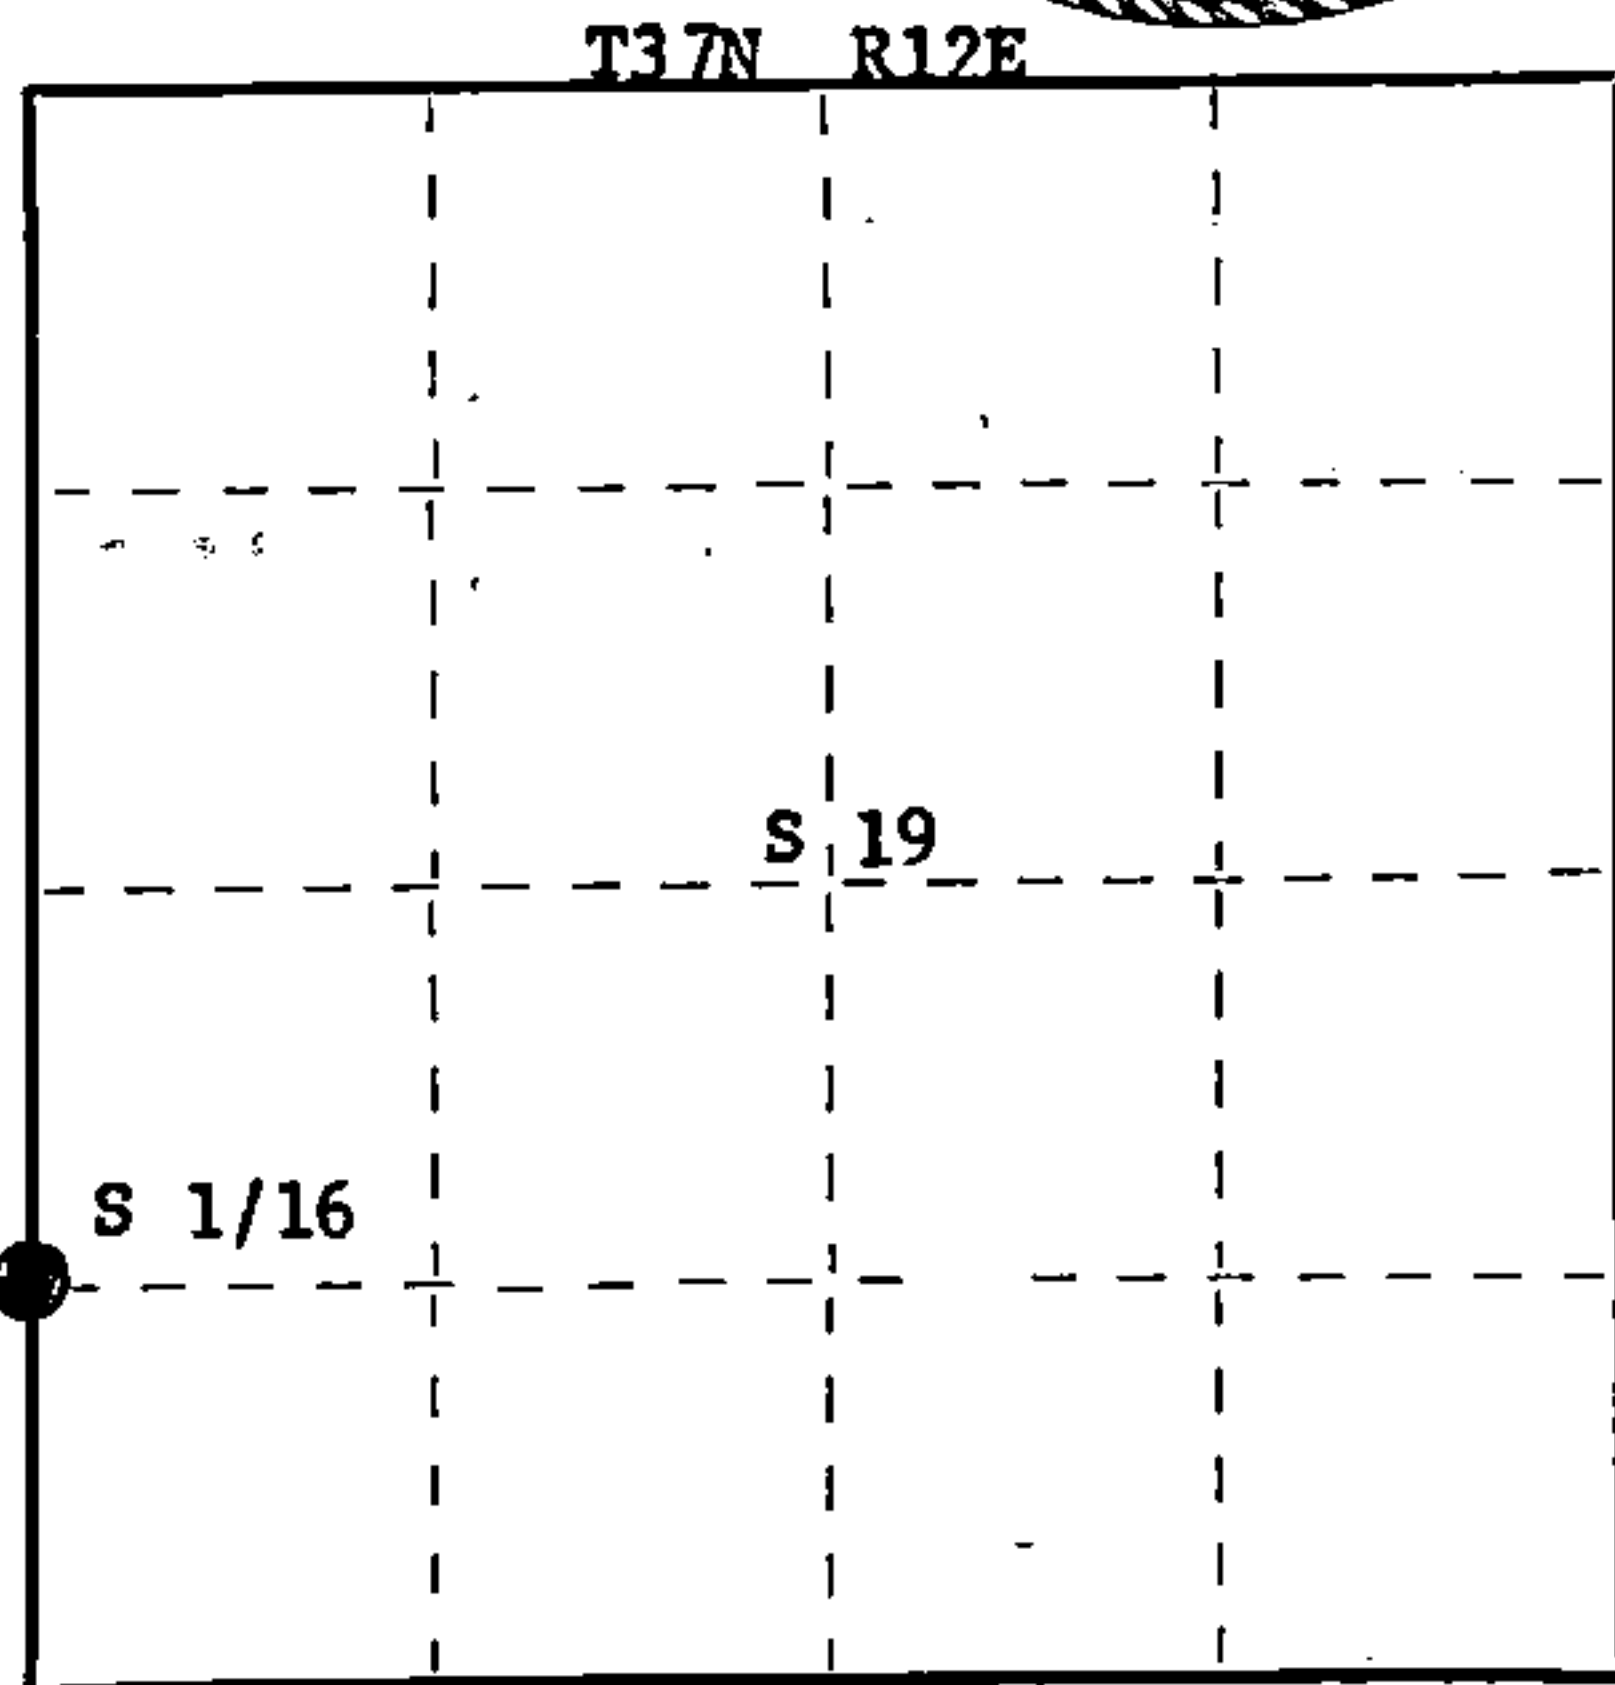

○ = Corner monument restored.

History of original corner establishment:

Corner established by V. Maine, County Surveyor, in 1935. Corrected line, set S 1/16 at 60.13 chains south of section corner 13, 24, 18, 19.

Set cedar post.

BT's - spruce 6" S49° 50' E, 9 links  
spruce 5" S60° 30' W, 25 links  
spruce 5" N63° W, 29 links

Description of corner evidence found:

Recovered Maine's 3" cedar post, squared and scribed 1/8S - S19 - 1/8S - S29.


Post standing in very poor condition.

Recovered OBT's - black spruce 6" S49° 50' E, 9 links, now a 12' stub, scribed 1/8S BT.  
black spruce 5" S60° 30' W, 25 links (25.9 lks) - now dead, scribed BT.

Description of monument and accessories I established to perpetuate the original location of this corner.

Replaced post with a 1 1/2" o.d. iron pipe with 2" brass cap, stamped: Projects 12" above ground.

NBT's - black spruce 6" N84° E, 25.3 links  
black spruce 7" S40° W, 47.2 links  
scribed 1/16 BT.

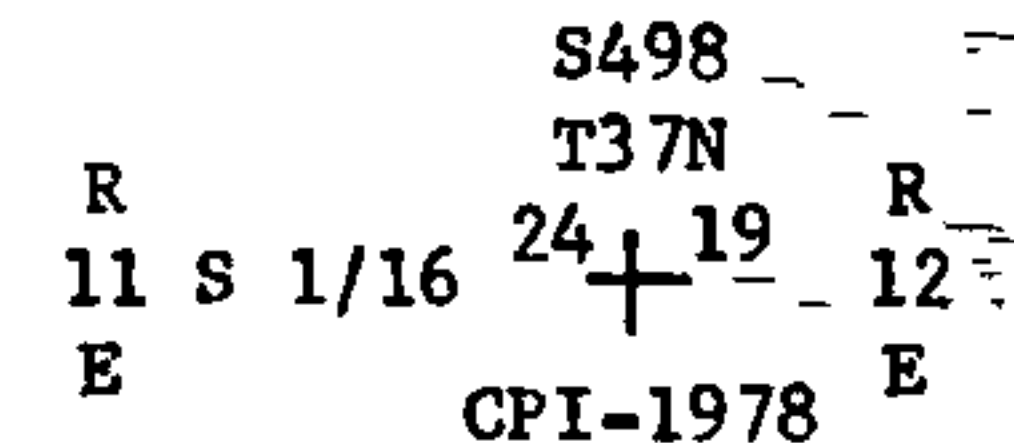

Dated at Rhineland, Wis., this 8th day of March, 1978.

Signature Philip T. Hansen Title Registered Land Surveyor Registration No. S-498  
(County Surveyor, Registered Land Surveyor, or other duly authorized official)

Office of Register of Deeds, County of Forest, I hereby certify that the within instrument was filed in this office for record on the 15th day of March, 1978 at 1:15 o'clock P. M.

EUGENE STATEZNY  
(Register of Deeds)

DOCUMENT NUMBER 113438

By Eileen Schmidt Deputy

43711241000