


U.S. PUBLIC LAND SURVEY MONUMENT RECORD

Index No. C-21

State of Wisconsin }  
County of FOREST } ss.

I, John Schulke, do hereby certify that on the 28th day of August, 1989, I found evidence of the East Quarter corner of Section 2 Township 37 North, Range 12 East, Fourth Principal Meridian, as described hereon; and that from this evidence I established a new monument and accessories as described hereon to perpetuate the original location of this corner.

Resident witnesses:

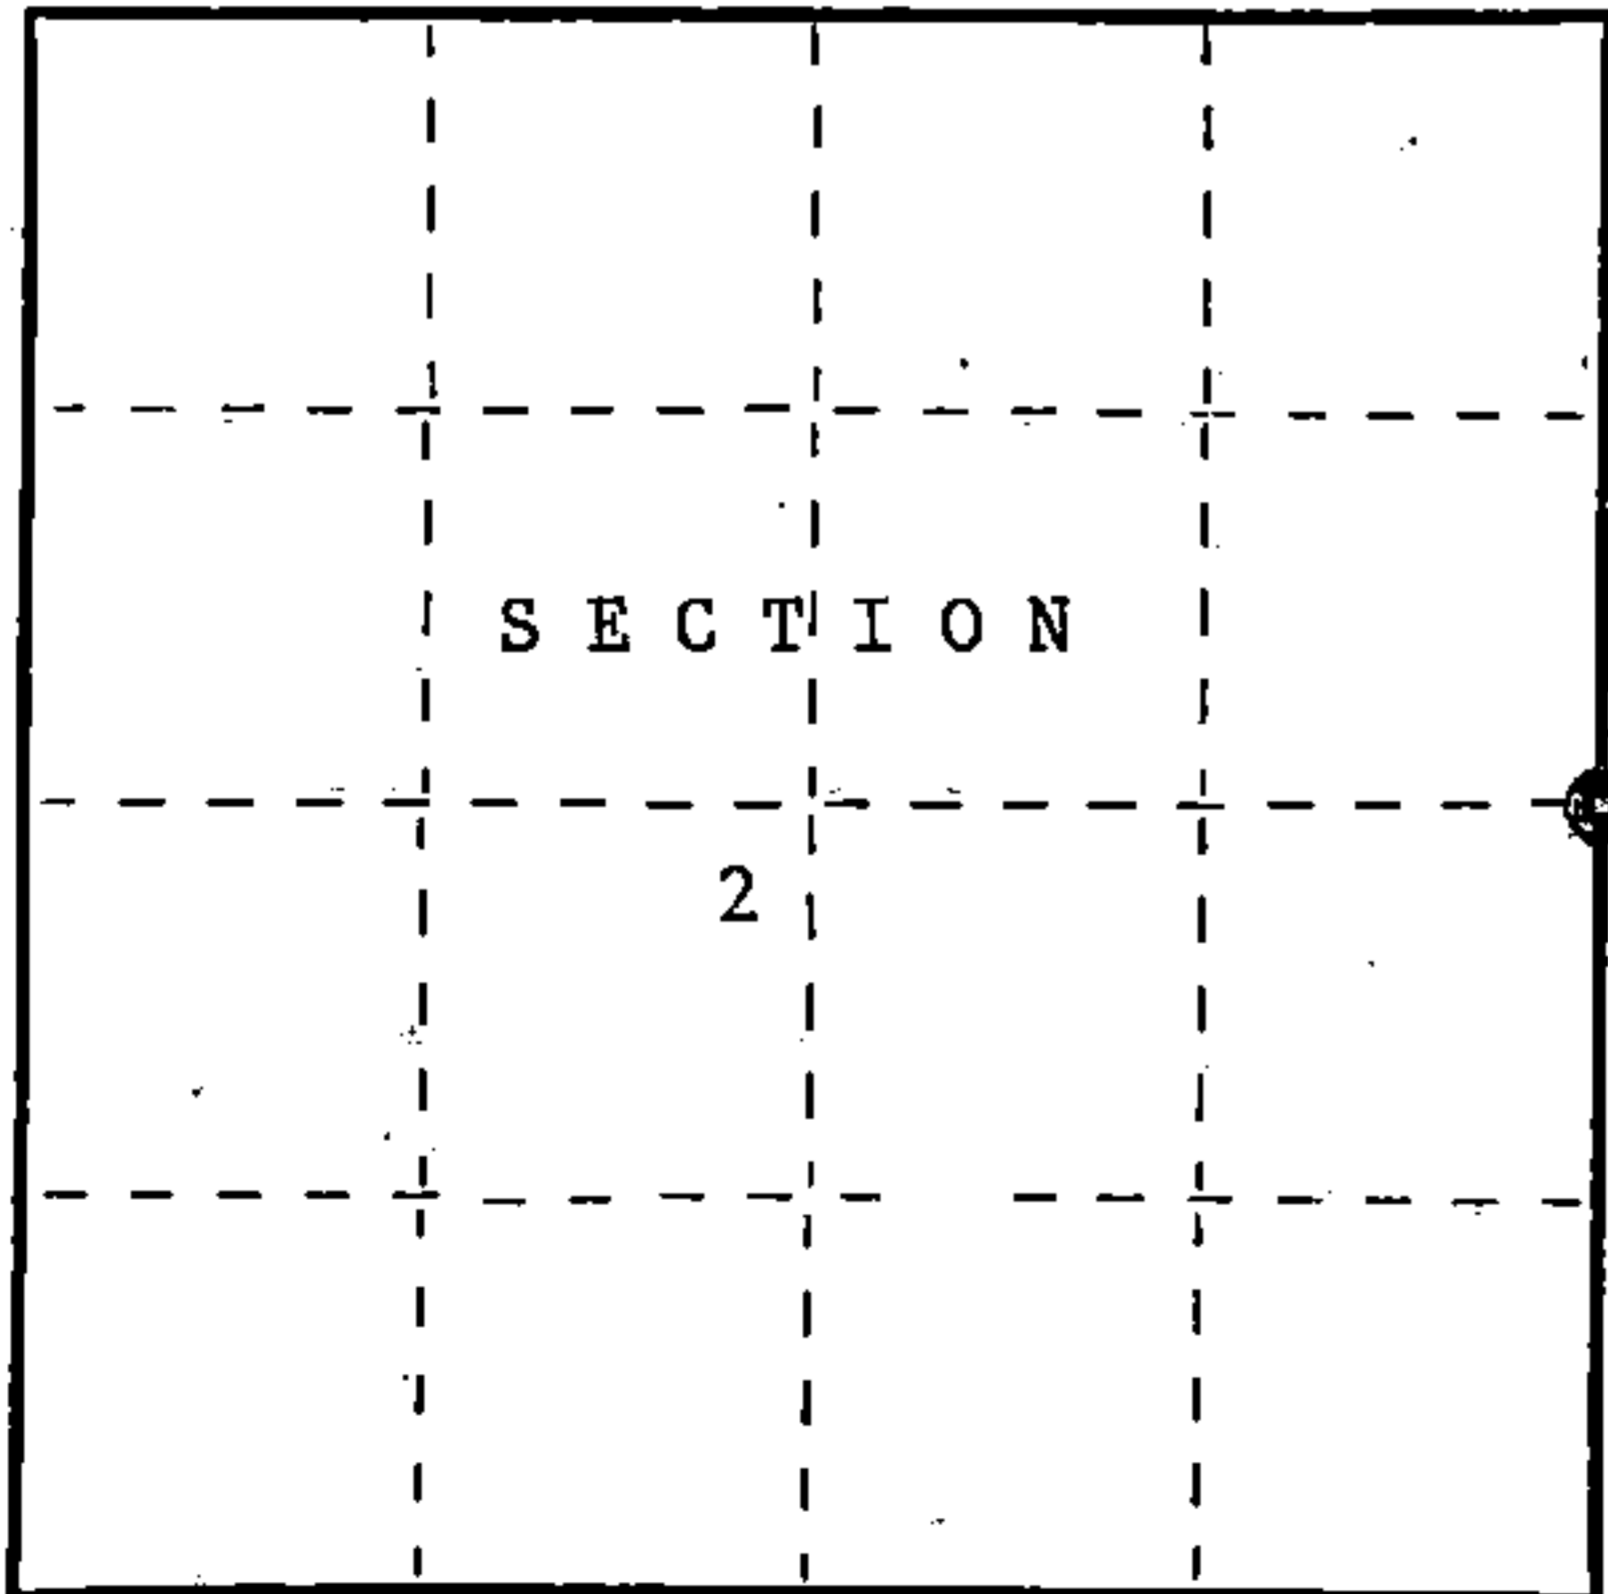

● = Corner monument restored.

History of original corner establishment:

In 1859, Original Government Surveyed by Wm. E. Daugherty. Set a wood post with the following corner references: Birch 6" S32°E 29 lks., Hemlock 25" N32°W 25 lks.

Description of corner evidence found:

In 1989, John Schulke found no evidence of the original corner.

Description of monument and accessories I established to perpetuate the original location of this corner.

Set a 2 1/2" dia. X 36" aluminum magnetic cap monument stamped to identify the corner. Set a steel sign post 1.0 ft. North of the monument. The following corner references: Twin Red Maple 4" N52°W 43.01 ft., Twin Red Maple 4" N02°E 76.96 ft., Red Maple 7" N74°E 59.37 ft., Aspen 7" S08°W 24.38 ft.

Dated at Wabesa, Wis., this 25th day of October, 1989.

Signature John C. Schulke Title Register Land Surveyor Registration No. S-1665  
(County Surveyor, Registered Land Surveyor, or other duly authorized official)

Office of Register of Deeds, County of Forest, I hereby certify that the within instrument was filed in this office for record on the 8th day of March, 1990 at 1:00 o'clock P. M.

Paul Alexander  
(Register of Deeds)

By \_\_\_\_\_ Deputy

FORM NO. 985-A

H.C. Miller Company

Stock No. 26273

DOCUMENT NUMBER

139246

43712022000

(e) Describe any material discrepancy between the location of the corner as restored or reestablished and the location of that corner as previously restored or reestablished by distance and direction. Show the discrepancy on the plan view drawing under (d), above. Show the distances between the corner as previously restored or reestablished and (1) the corner as restored or reestablished, and (2) to at least 2 of the witness monuments shown on the drawing in (d), above.


No.

(f) Was the corner restored through acceptance of (1) an obliterated evidence location, or, (2) a found perpetuated location?

Neither.


(g&h) Was the corner reestablished through lost corner proportionate methods? If so, show the method, including the directions and distances to other public land survey corners used as evidence or used for proportioning in determining the corner location?

Yes.

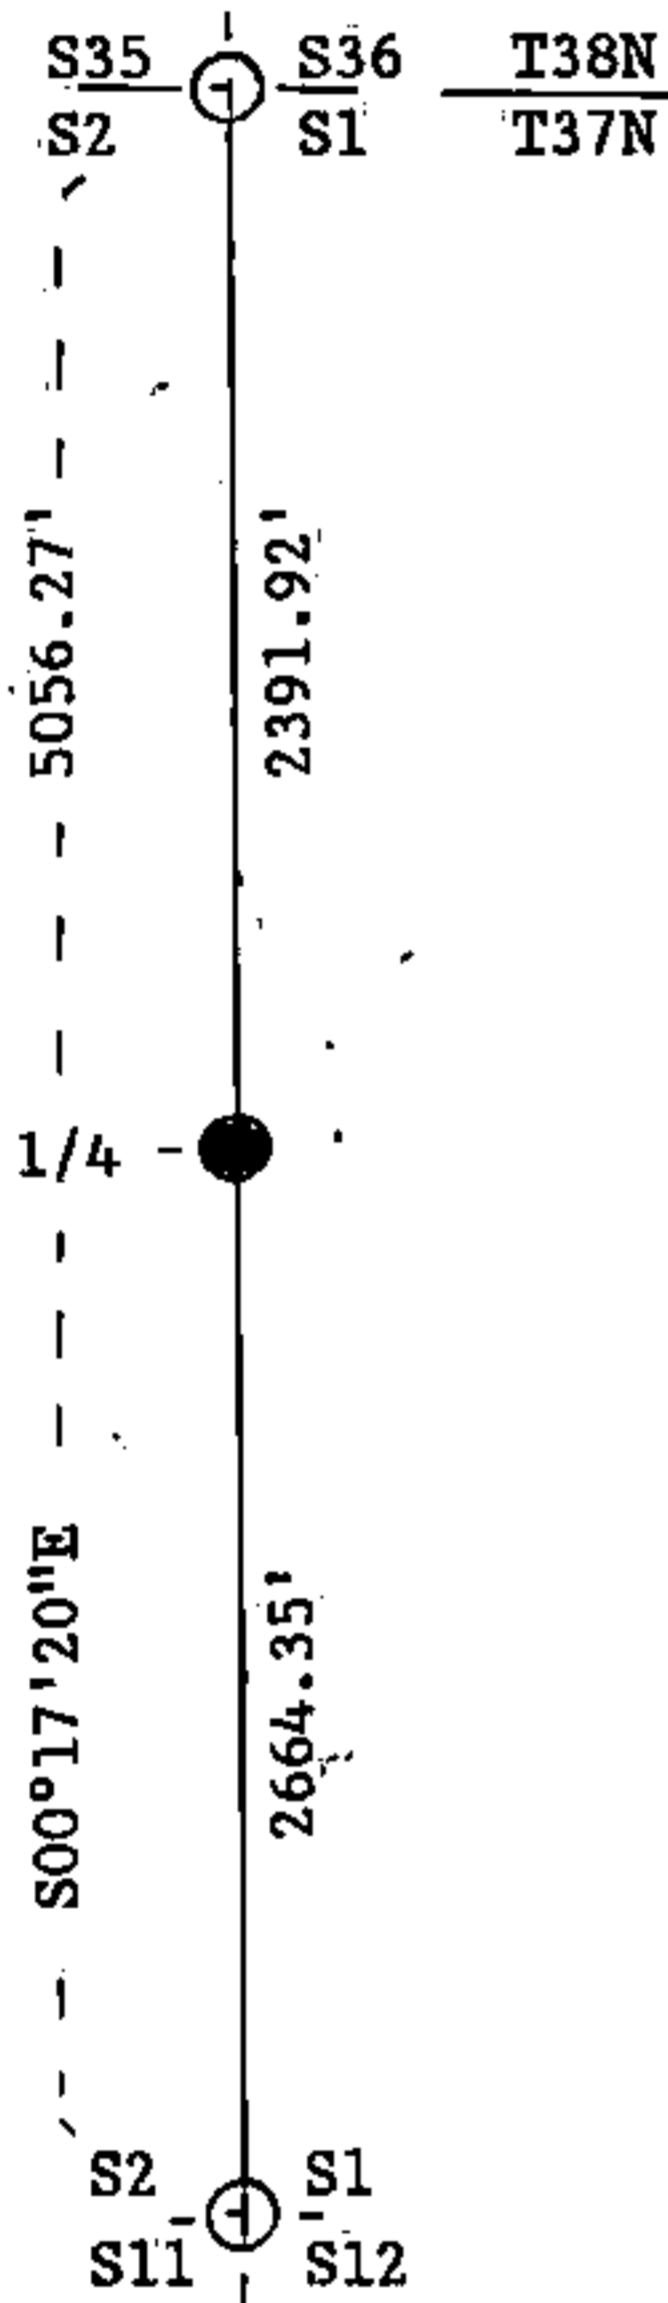


QUARTER CORNER

S2 | S1

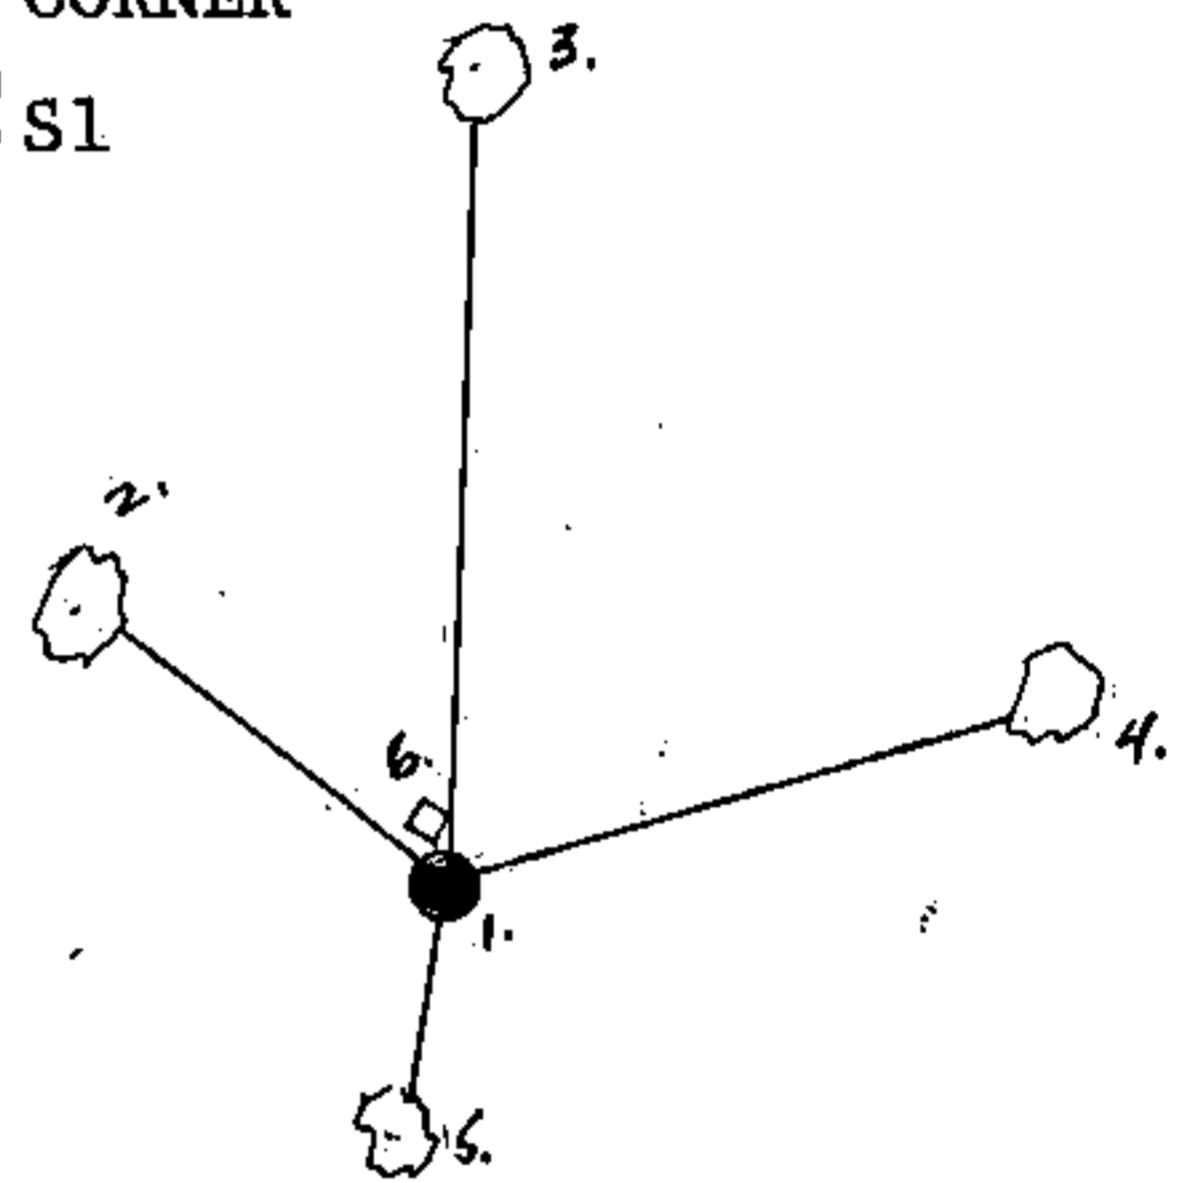

1. 2 1/2" X 36" aluminum monument.
2. Twin Red Maple 4" N52°W 43.01 ft.
3. Twin Red Maple 4" N02°E 76.96 ft.
4. Red Maple 7" N74°E 59.37 ft.
5. Aspen 7" S08°W 24.38 ft.
6. Steel sign post North 1.0 ft.

Affix Land Surveyor Seal

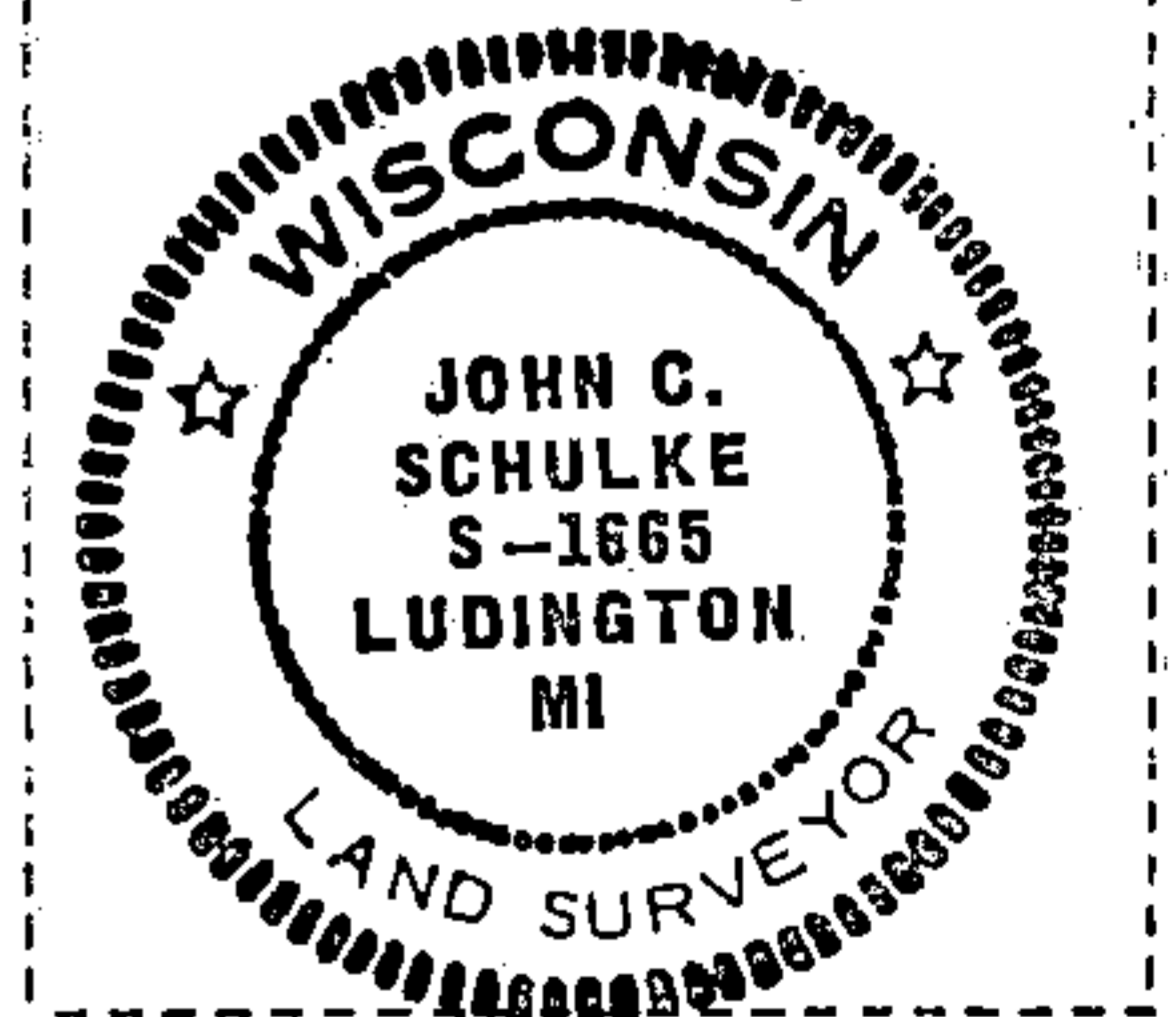

(i) I, John Schulke (RLS-1665)  
 (type or print name) certify that the corner location shown on this record was determined by me or under my direction and control and that this U.S. Public Land Survey Monument Record is correct and complete to the best of my knowledge and belief.

John Schulke Signature Oct 25, 1989 Date

Survey requested by: Dale Staege District Ranger 1989 Date