

# U.S. PUBLIC LAND SURVEY MONUMENT RECORD


Index No. E-17

State of Wisconsin }  
County of FOREST } ss.

I, John Schulke, do hereby  
certify that on the 30th day  
of August, 1989, I found  
evidence of the Southeast  
corner of Section 3  
Township 37, North, Range  
12 East, Fourth Principal Meridian,  
as described hereon; and that from this evidence  
I established a new monument and accessories  
as described hereon to perpetuate the original  
location of this corner.

Resident witnesses:

Alois Tauer  
Roman Tauer  
William Cochrane

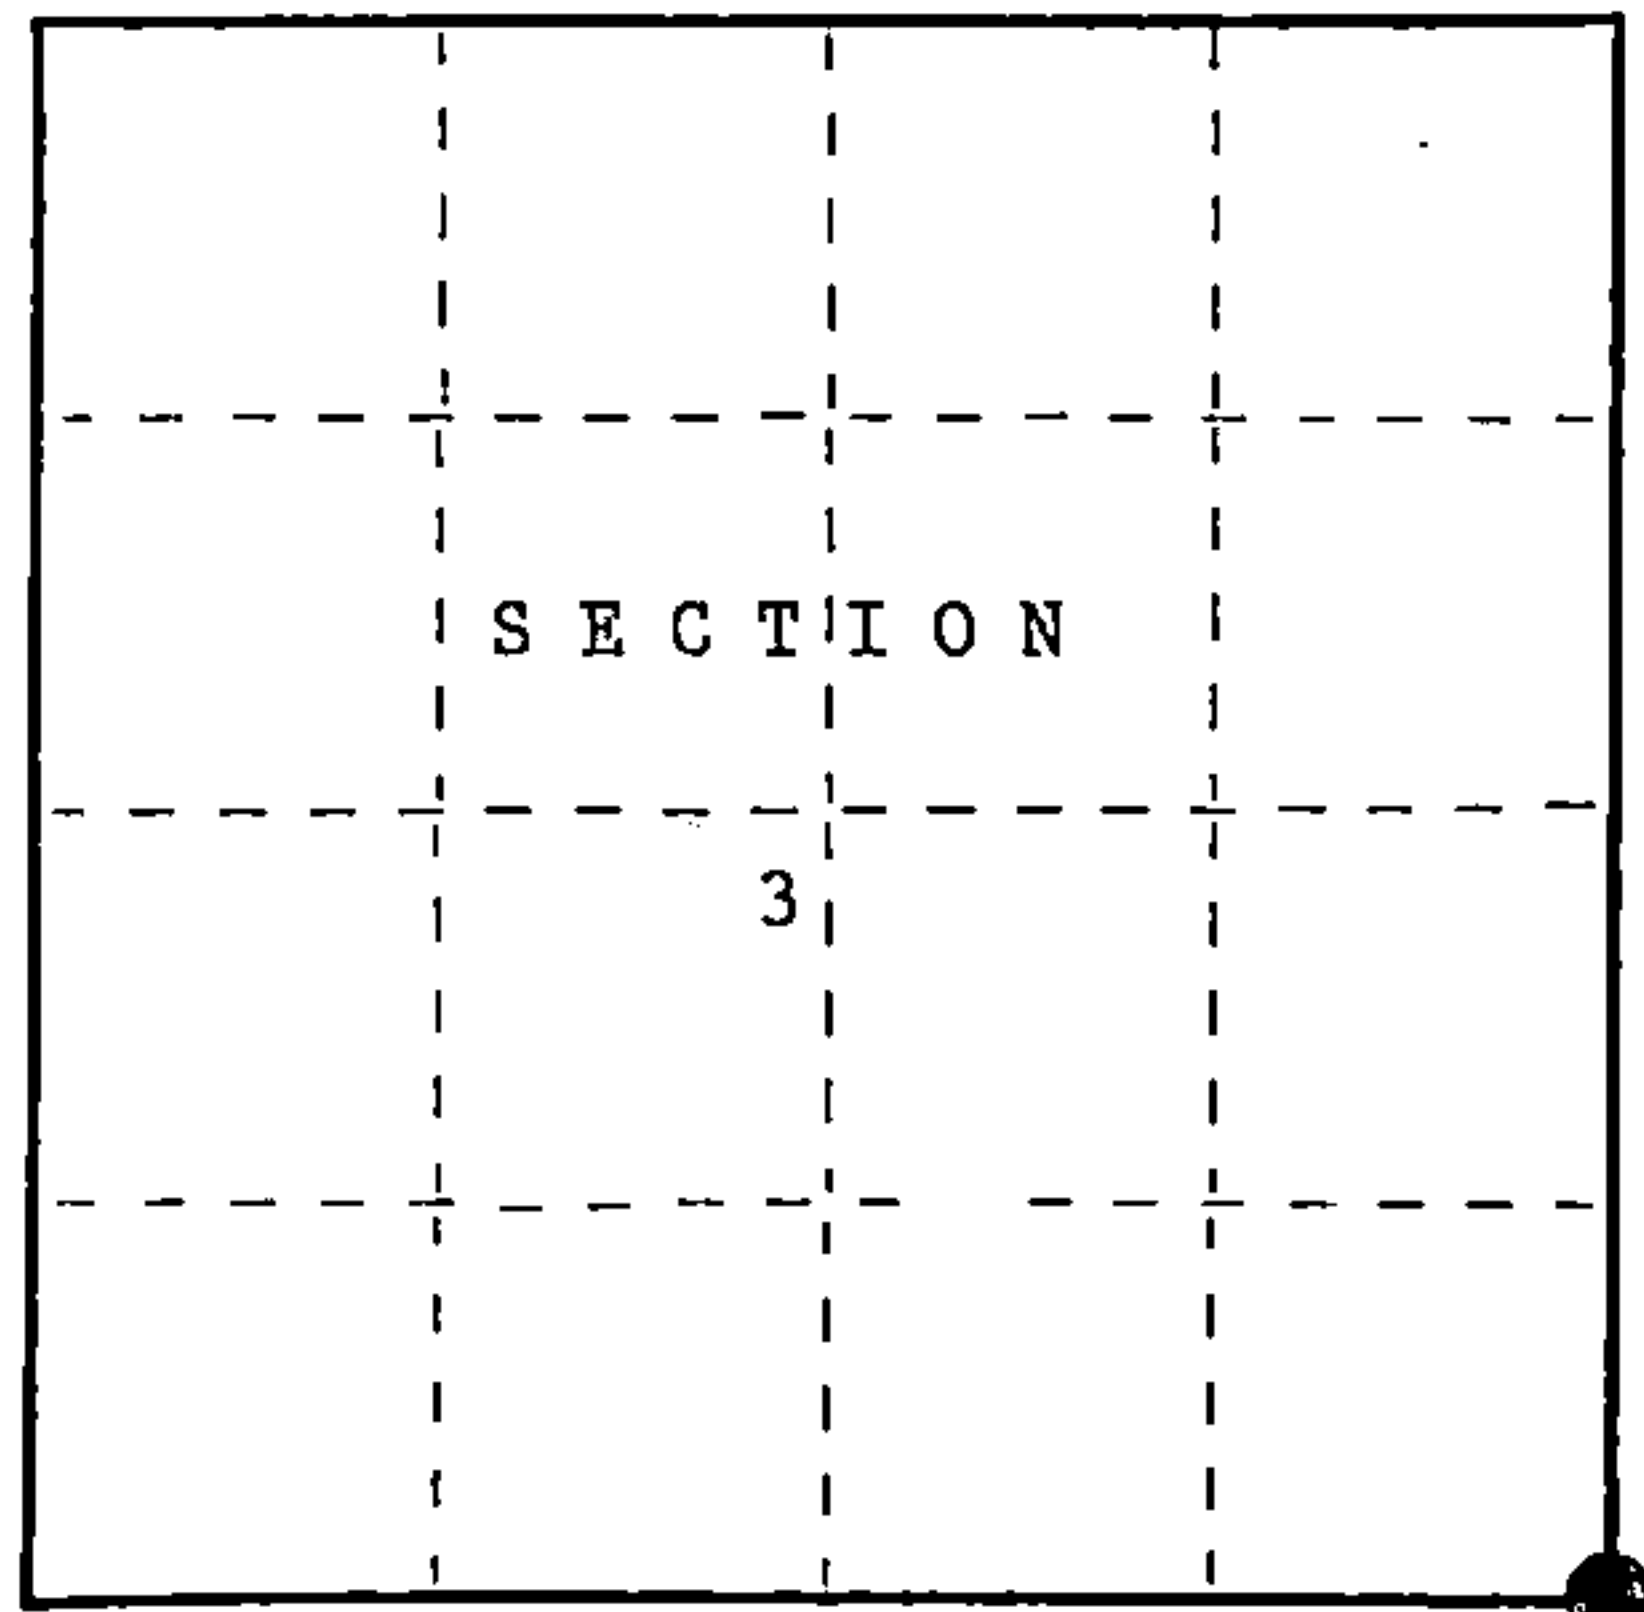

● = Corner monument restored.

History of original corner establishment:

In 1859, Original Government Surveyed by Wm. E. Daugherty. Set a wood post with the following corner references: Sugar 12" S56°E 9 lks.  
Sugar 16" S20°W 20 lks.

Description of corner evidence found:

In 1989, John Schulke found no evidence of the original corner. Found a spike in the road 5 feet North of the center line. This position has been used by other surveyors and adjacent property owners for many years. I accept the location as the best available evidence of the corner position.

Description of monument and accessories I established to perpetuate the original location of this corner.

Set a railroad spike 0.3 ft. under black top of a road. Set a 2 1/2" dia. X 36" aluminum magnetic witness cap monument stamped to identify the location of the corner. Witness monument placed in a mound of stones. Set a steel sign post 0.9 feet South of the witness monument. The following corner references:

Sugar Maple 14" N62°W 36.54 ft.  
Twin Sugar Maple 10" N78°E 54.48 ft.  
Iron pipe 1" N02°W 21.20 ft.  
Witness monument 2 1/2" S04°45'W 33.0 ft.

Dated at Wabeno, Wis., this 25th day of October, 1989

Signature John C Schulke Title Register Land Surveyor Registration No S-1665  
(County Surveyor, Registered Land Surveyor, or other duly authorized official)

Office of Register of Deeds, County of Forest, I hereby certify that the within  
instrument was filed in this office for record on the 8th day of March, 1990  
at 1:00 o'clock P. M.

Paul Aschenbrenner  
(Register of Deeds)

By \_\_\_\_\_ Deputy

FORM NO. 985-A

H.C. Miller Company  
DESIGNER

Stock No. 26273

DOCUMENT NUMBER

139250

437120300005

e) Describe any material discrepancy between the location of the corner as restored or reestablished and the location of that corner as previously restored or reestablished by distance and direction. Show the discrepancy on the plan view drawing under (d), above. Show the distances between the corner as previously restored or reestablished and (1) the corner as restored or reestablished, and (2) to at least 2 of the witness monuments shown on the drawing in (d), above.

No.

(f) Was the corner restored through acceptance of (1) an obliterated evidence location, or, (2) a found perpetuated location?

(1) an obliterated evidence location.


(g&h) Was the corner reestablished through lost corner proportionate methods? If so, show the method, including the directions and distances to other public land survey corners used as evidence or used for proportioning in determining the corner location?

No.


SECTION CORNER

S3	S2
S10	S11

1. Set a railroad spike 0.3 ft. under black top of road as the corner.
2. Sugar Maple 14" N62°W 36.54 ft.
3. Twin Sug. Maple 10" N78°E 54.48 ft.
4. Iron pipe 1" N02°W 21.20 ft.
5. Witness monument 2 1/2" S04°45'W 33.0 ft.
6. Steel sign post set South 0.9 ft. of the witness monument.

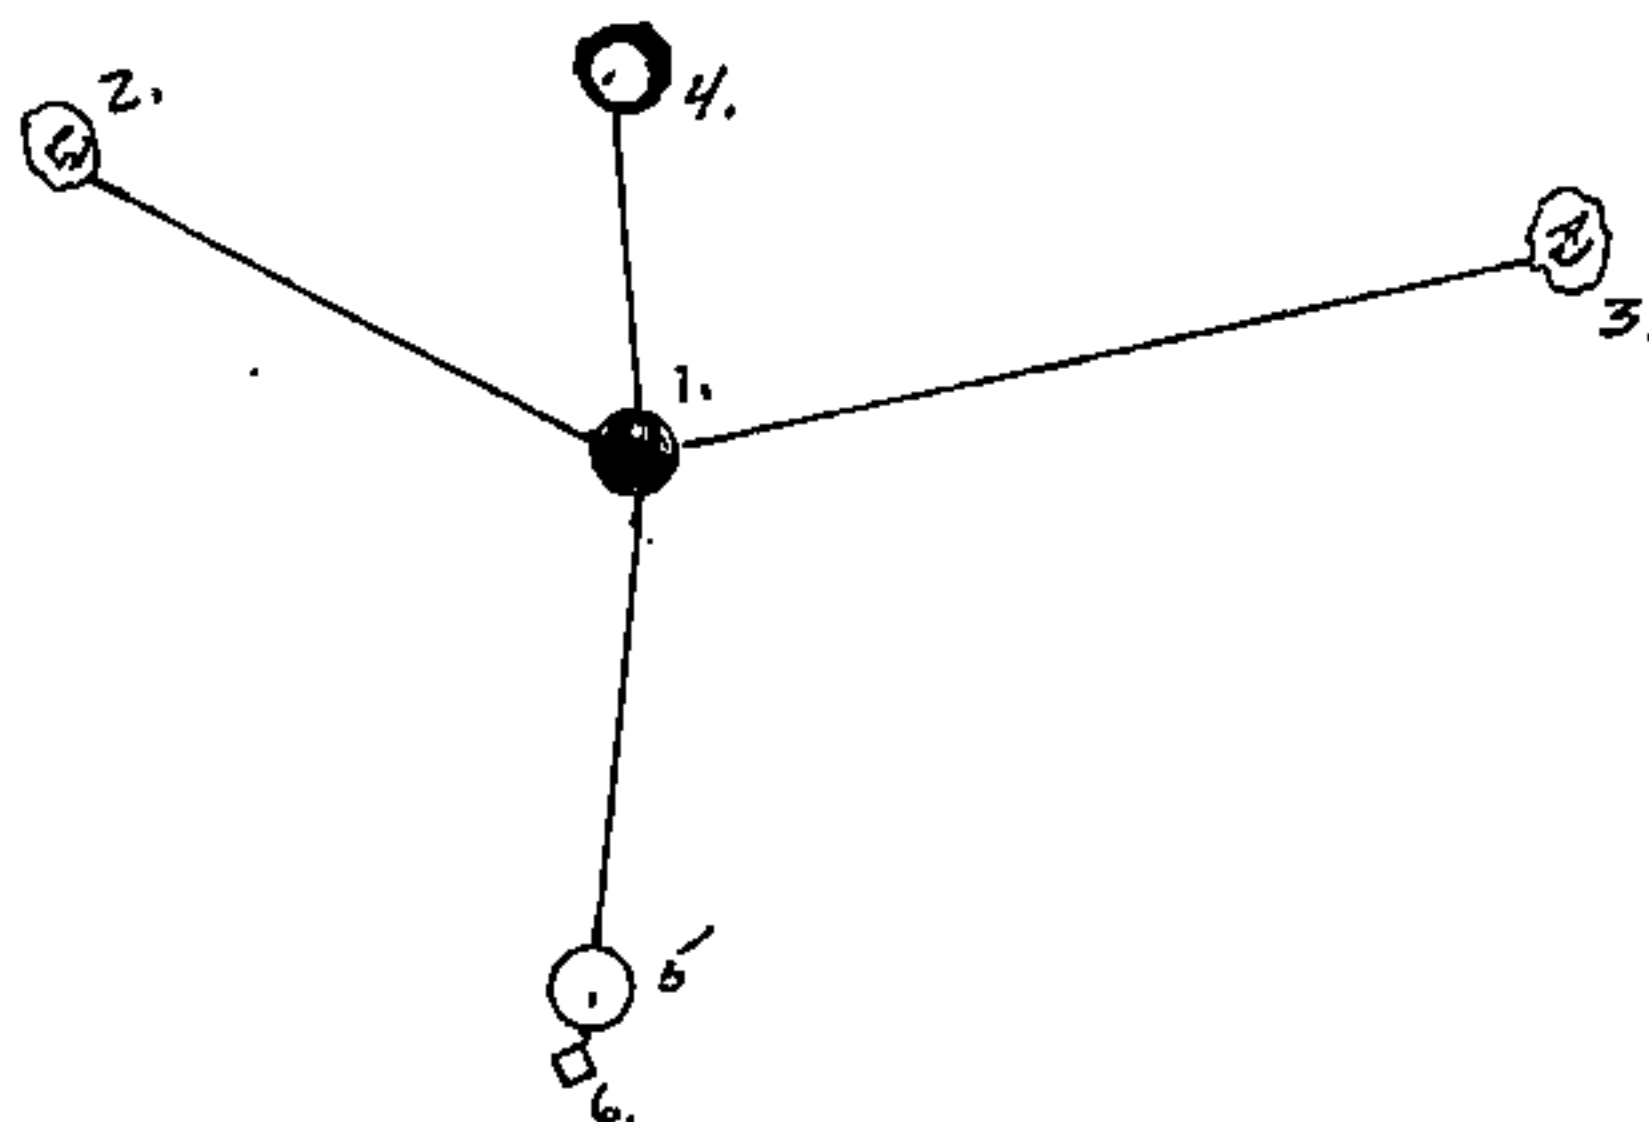

(i) I, John Schulke (R.L.S.-1665)  
(type or print name) certify that the corner location shown on this record was determined by me or under my direction and control and that this U.S. Public Land Survey Monument Record is correct and complete to the best of my knowledge and belief.

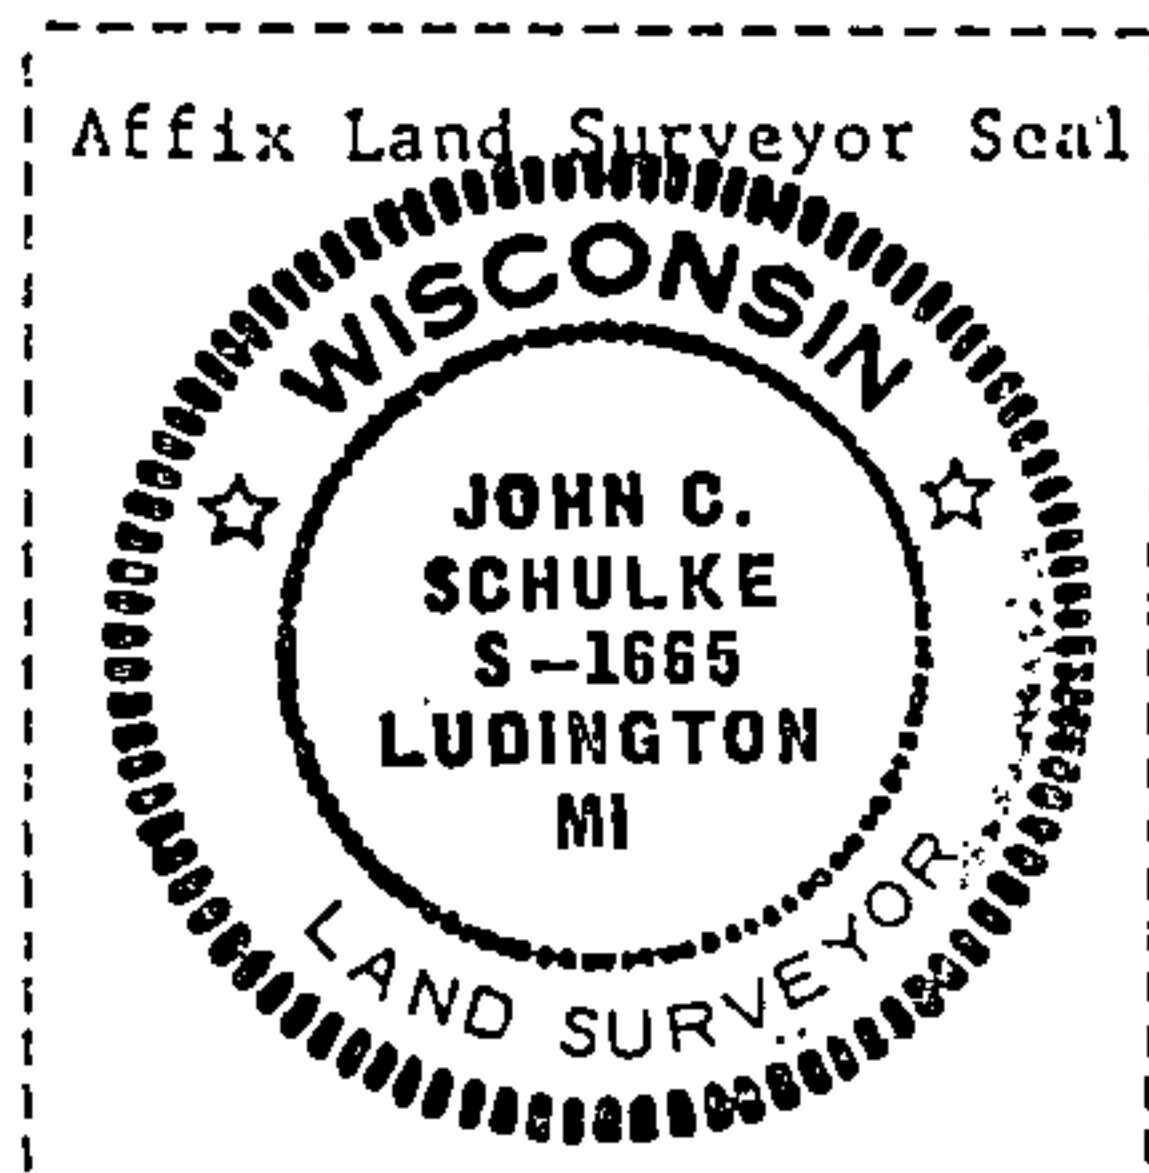

John C. Schulke Oct. 25, 1989  
Signature Date

Survey requested by Dale Stange 1989  
District Ranger Date