

CERTIFIED LAND CORNER RESTORATION

State of Wisconsin }
County of Forest } ss.

I, Milo E. Stefan, do hereby certify that on the 13th day of May, 1982, I found evidence of the Northwest corner of Section 16 Township 37N, Range 12E, Fourth Principal Meridian, as described hereon; and that from this evidence I established a new monument and accessories as described hereon to perpetuate the original location of this corner:

Description of original monument and accessories and subsequent restorations:

Surveyed in 1859 by Wm. Daugherty
80.00 chains north, set wood post
Birch, 10", SW, 24 lks., 15.84 feet
Cedar, 10", NW, 20 lks., 13.20 feet


Description of corner evidence found:

Found 1 1/4" iron pipe at fence corner
5" x 5" x 24" post at base of Hemlock
Stump remains, SW, 16 feet
Cedar (stump very rotten), NW, 13.2 feet

Description of monument and accessories I established to perpetuate the location of this corner:

Replaced iron pipe with a 2" x 36" aluminum monument with tablet stamped as follows:
T37N, R12E, S8, S9, S17, S16, 1982, RLS-1558
From which the following bear:
Cedar, 12", NE, 47.78 feet
Hemlock, 14", S82E, 9.94 feet
Hemlock, 20", S70W, 14.56 feet
Cedar, 8", NW, 29.43 feet
Steel sign post, NW, 1.4 feet

DOCUMENT NO.
124240

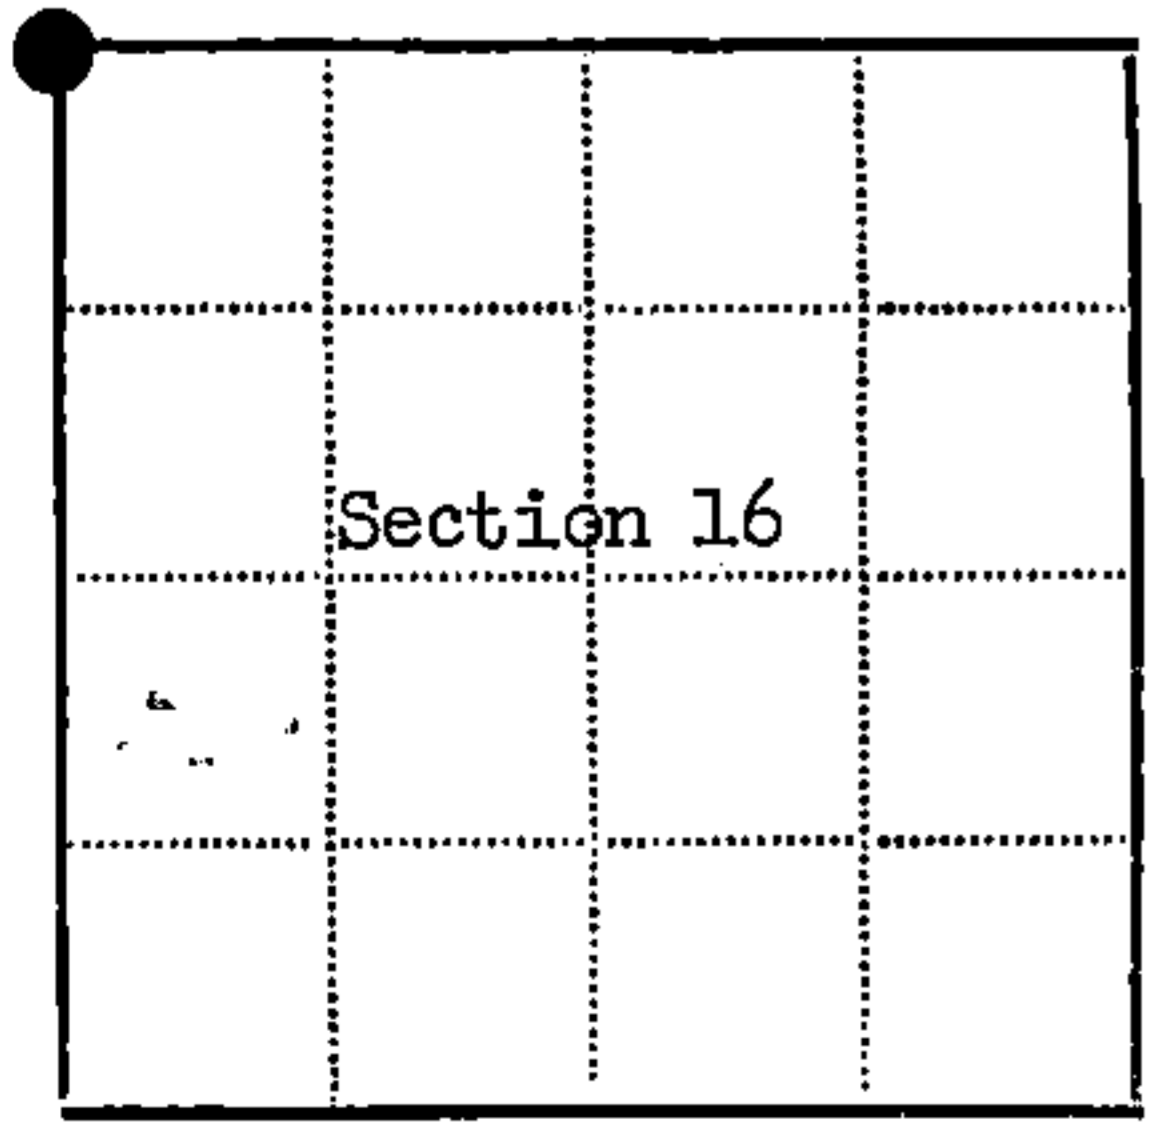

● - Corner monument restored
□ -

Resident witnesses.....

Dated at Rhinelander Wisconsin, this 2 day of May 1982

Signature Milo E. Stefan Title Land Surveyor
(County Surveyor, Registered Land Surveyor, or other duly authorized official)

Surveyors Registration No. RLS-1558

Office of Register of Deeds County of Forest

I hereby certify that the within instrument was filed in this office for record on the 15th day of September 1983, and was filed in Book No. Page No. of County Records.

Signature Eugene Statory Title Register of Deeds

Township 37N, Range 12E, Section 16, Index No. J-9, Page No. 8

4371208

6