

CERTIFIED LAND CORNER RESTORATION


Index No. **9 17**

State of Wisconsin }  
County of Forest } ss.

I William B. Cochrane, do hereby certify that on the 10 th day of September, 1977, I found evidence of the Southeast Section corner of Section 10 Township 37, North, Range 12 East, Fourth Principal Meridian, as described hereon; and that from this evidence I established a new monument and accessories as described hereon to perpetuate the original location of this corner.

Resident witnesses:  
Miles H. Cochrane

FORM 985 H. G. MILLER CO., MILWAUKEE

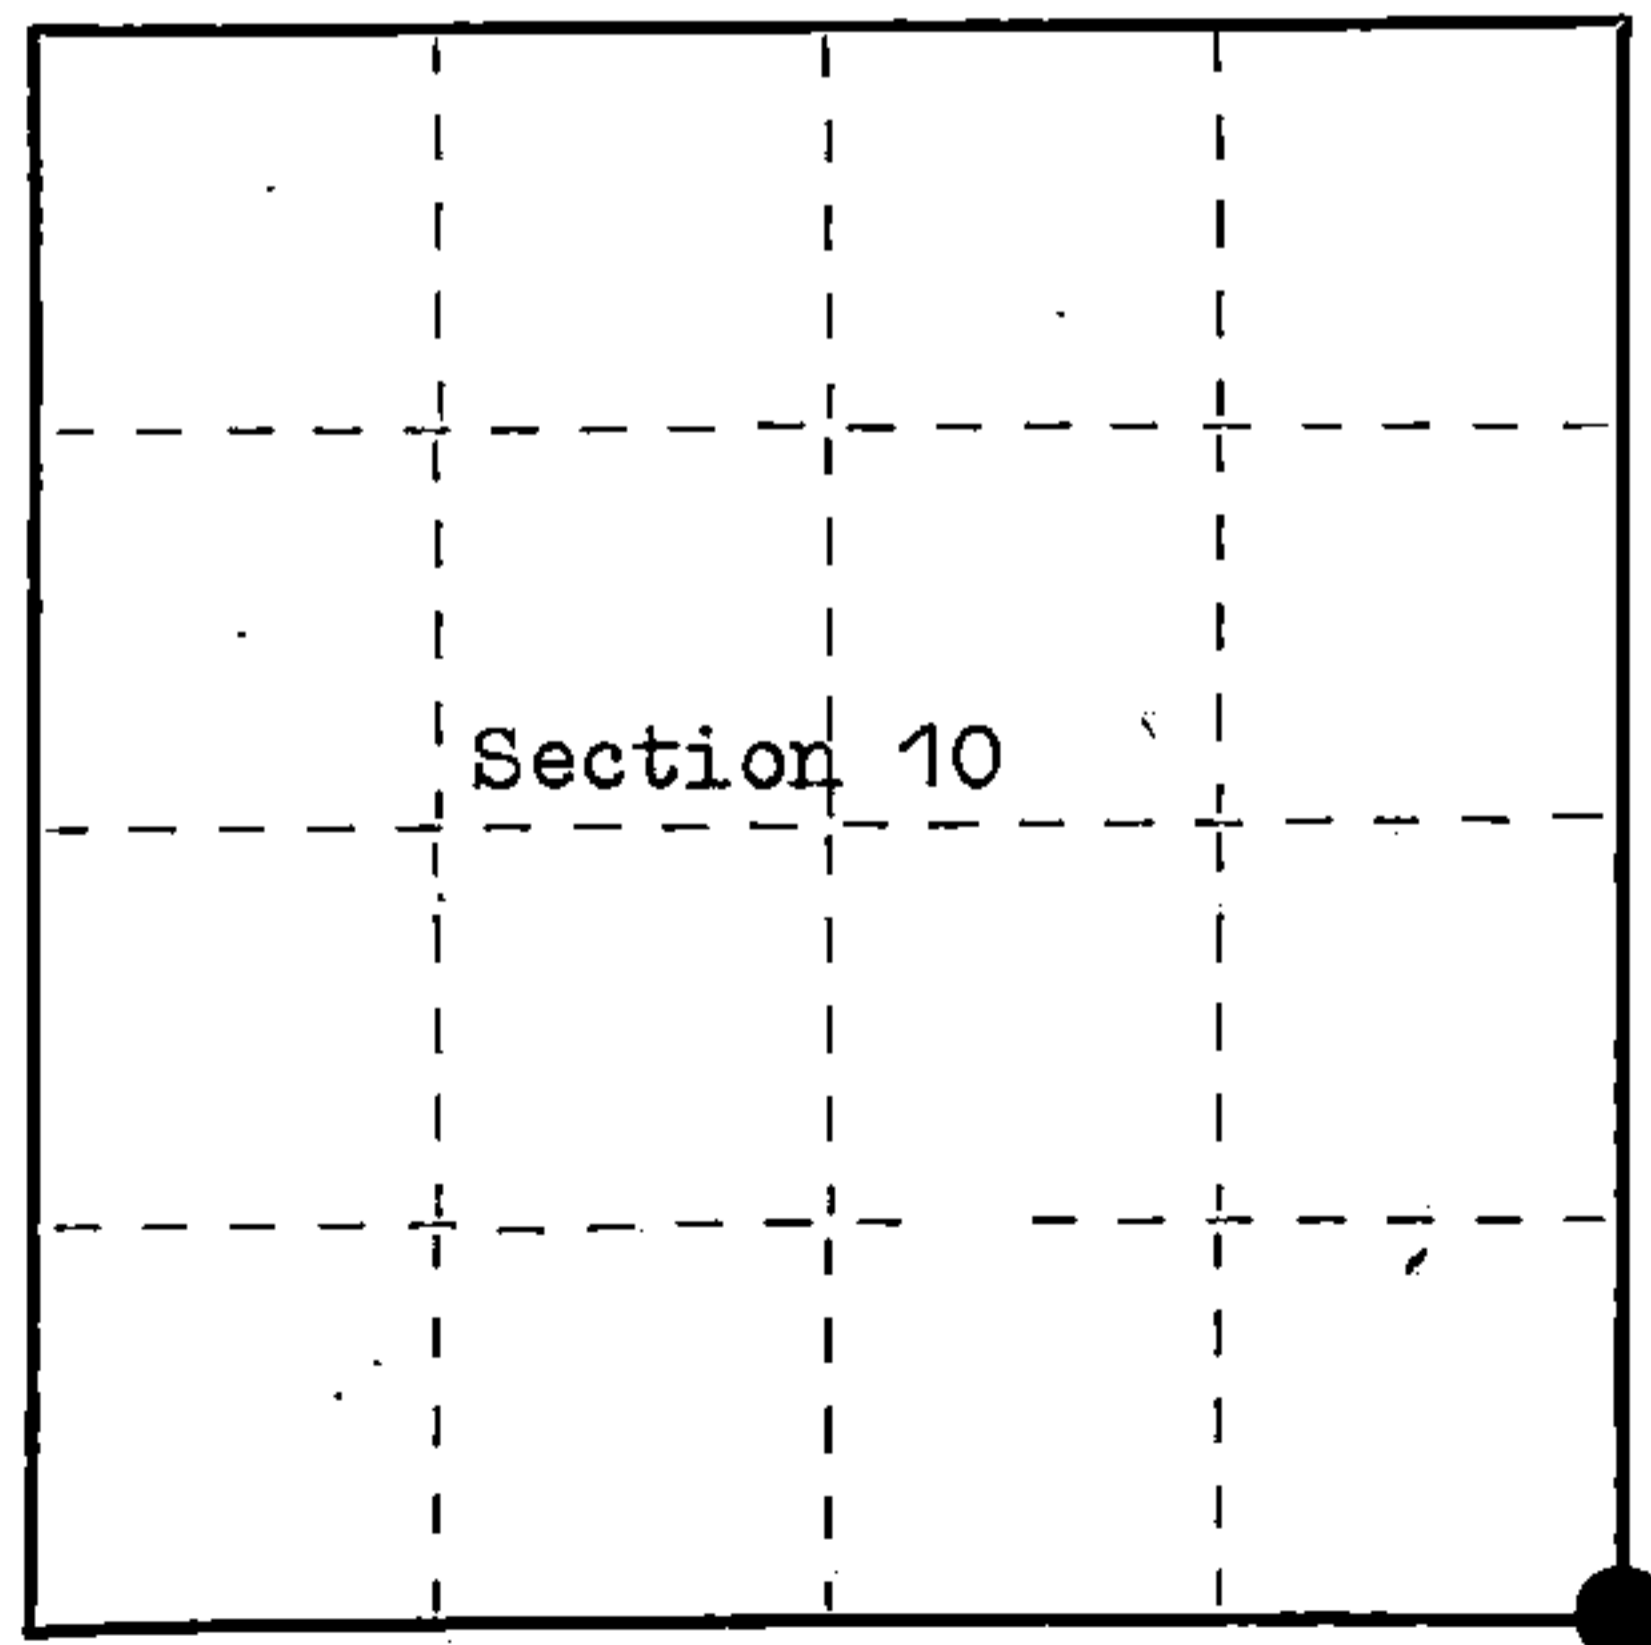

○ = Corner monument restored.

History of original corner establishment:

Surveyed in 1859 by Wm. E. Daugherty  
North between Sections 14 and 15  
80.00 chs. Set post corner to Sections 10, 11, 14, and 15  
Birch, 18", S 71° E, 27 lks.  
Birch, 15", N 74° W, 22 lks.

Description of corner evidence found:

1/4" diameter iron pipe driven flush with the road surface.  
Old road runs East and West.  
Original BT's would fall in the road.  
This position has been used for many years by other surveyors.  
I have used this position in subdividing Section 10 and found the measurements to agree with other surveys of the area.  
I accept this position as the best available evidence.

Description of monument and accessories I established to perpetuate the original location of this corner.

From the iron pipe, I set a 2 1/2" Berntsen, A-1 Federal Monument, 30 inches long, with the cap stamped:  
T37N R12E, S10, S11, S14, S15, 1977, S-1107, REFERENCE CORNER, 8  
From the iron pipe in the road the monument bears S 9° W, 8 FT and the following bear:  
Yellow Birch, 12", S 28° W, 15.26 FT  
Basswood, 5", N 42° W, 39.95 FT  
Maple, 6", N 83° E, 34.33 FT


Dated at Hiles, Wis., this 19 th day of September, 1977

Signature William B. Cochrane Title Land Surveyor Registration No. 44957  
(County Surveyor, Registered Land Surveyor, or other duly authorized official)

Office of Register of Deeds, County of Forest, I hereby certify that the within instrument was filed in this office for record on the 20 th day of September, 1977 at 9:00 o'clock A. M.

Eugene Stutzman  
(Register of Deeds)  
By \_\_\_\_\_ Deputy

DOCUMENT NUMBER - **112378**

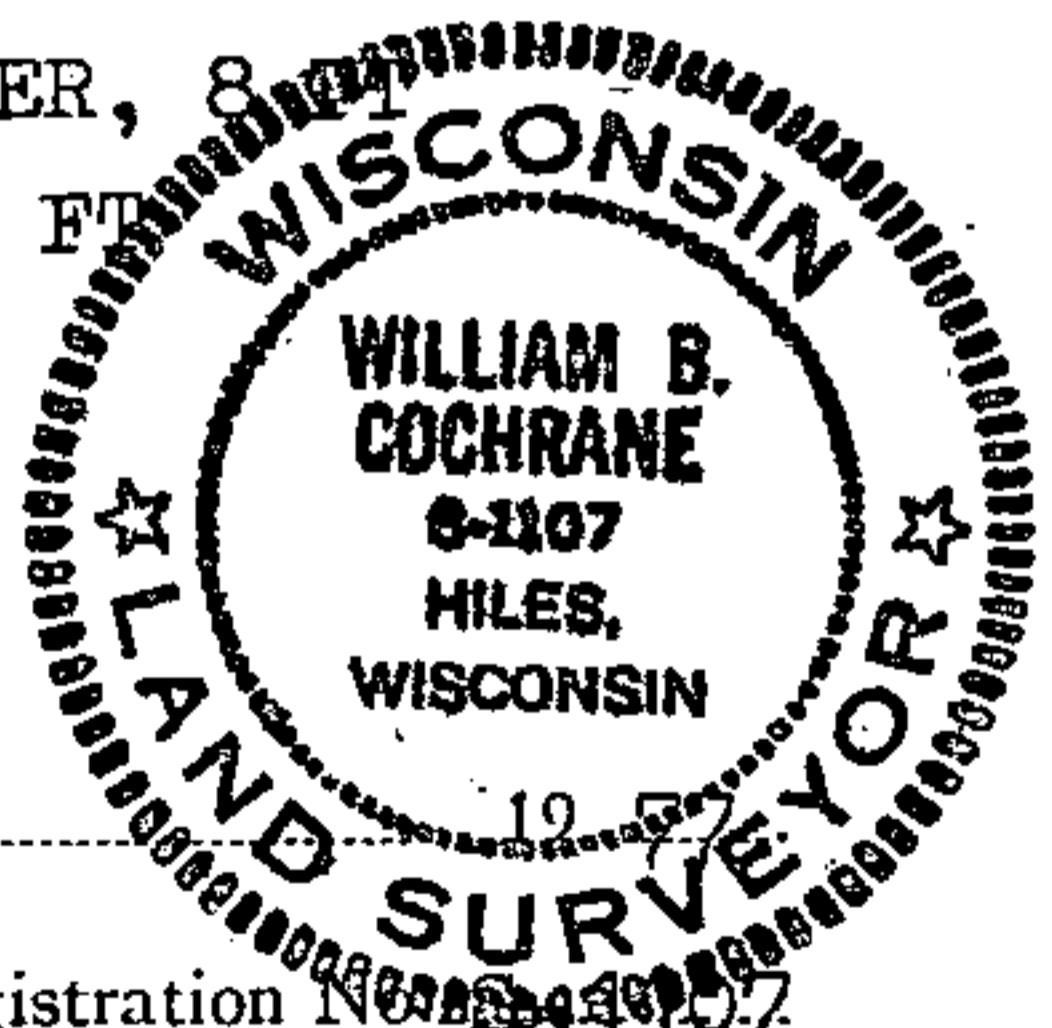

43712180000