

Register


DOCUMENT NUMBER 129882

U. S. PUBLIC LAND SURVEY MONUMENT RECORD

INSTRUCTIONS: This record shall show the location of the corner and shall include all of the following nine elements (a through i).

- (a) Identify the corner by reference to the U.S. public land survey system.
- = Corner monument restored.

Quarter Corner to Sections 7 and 12, T.37N., R.13E.

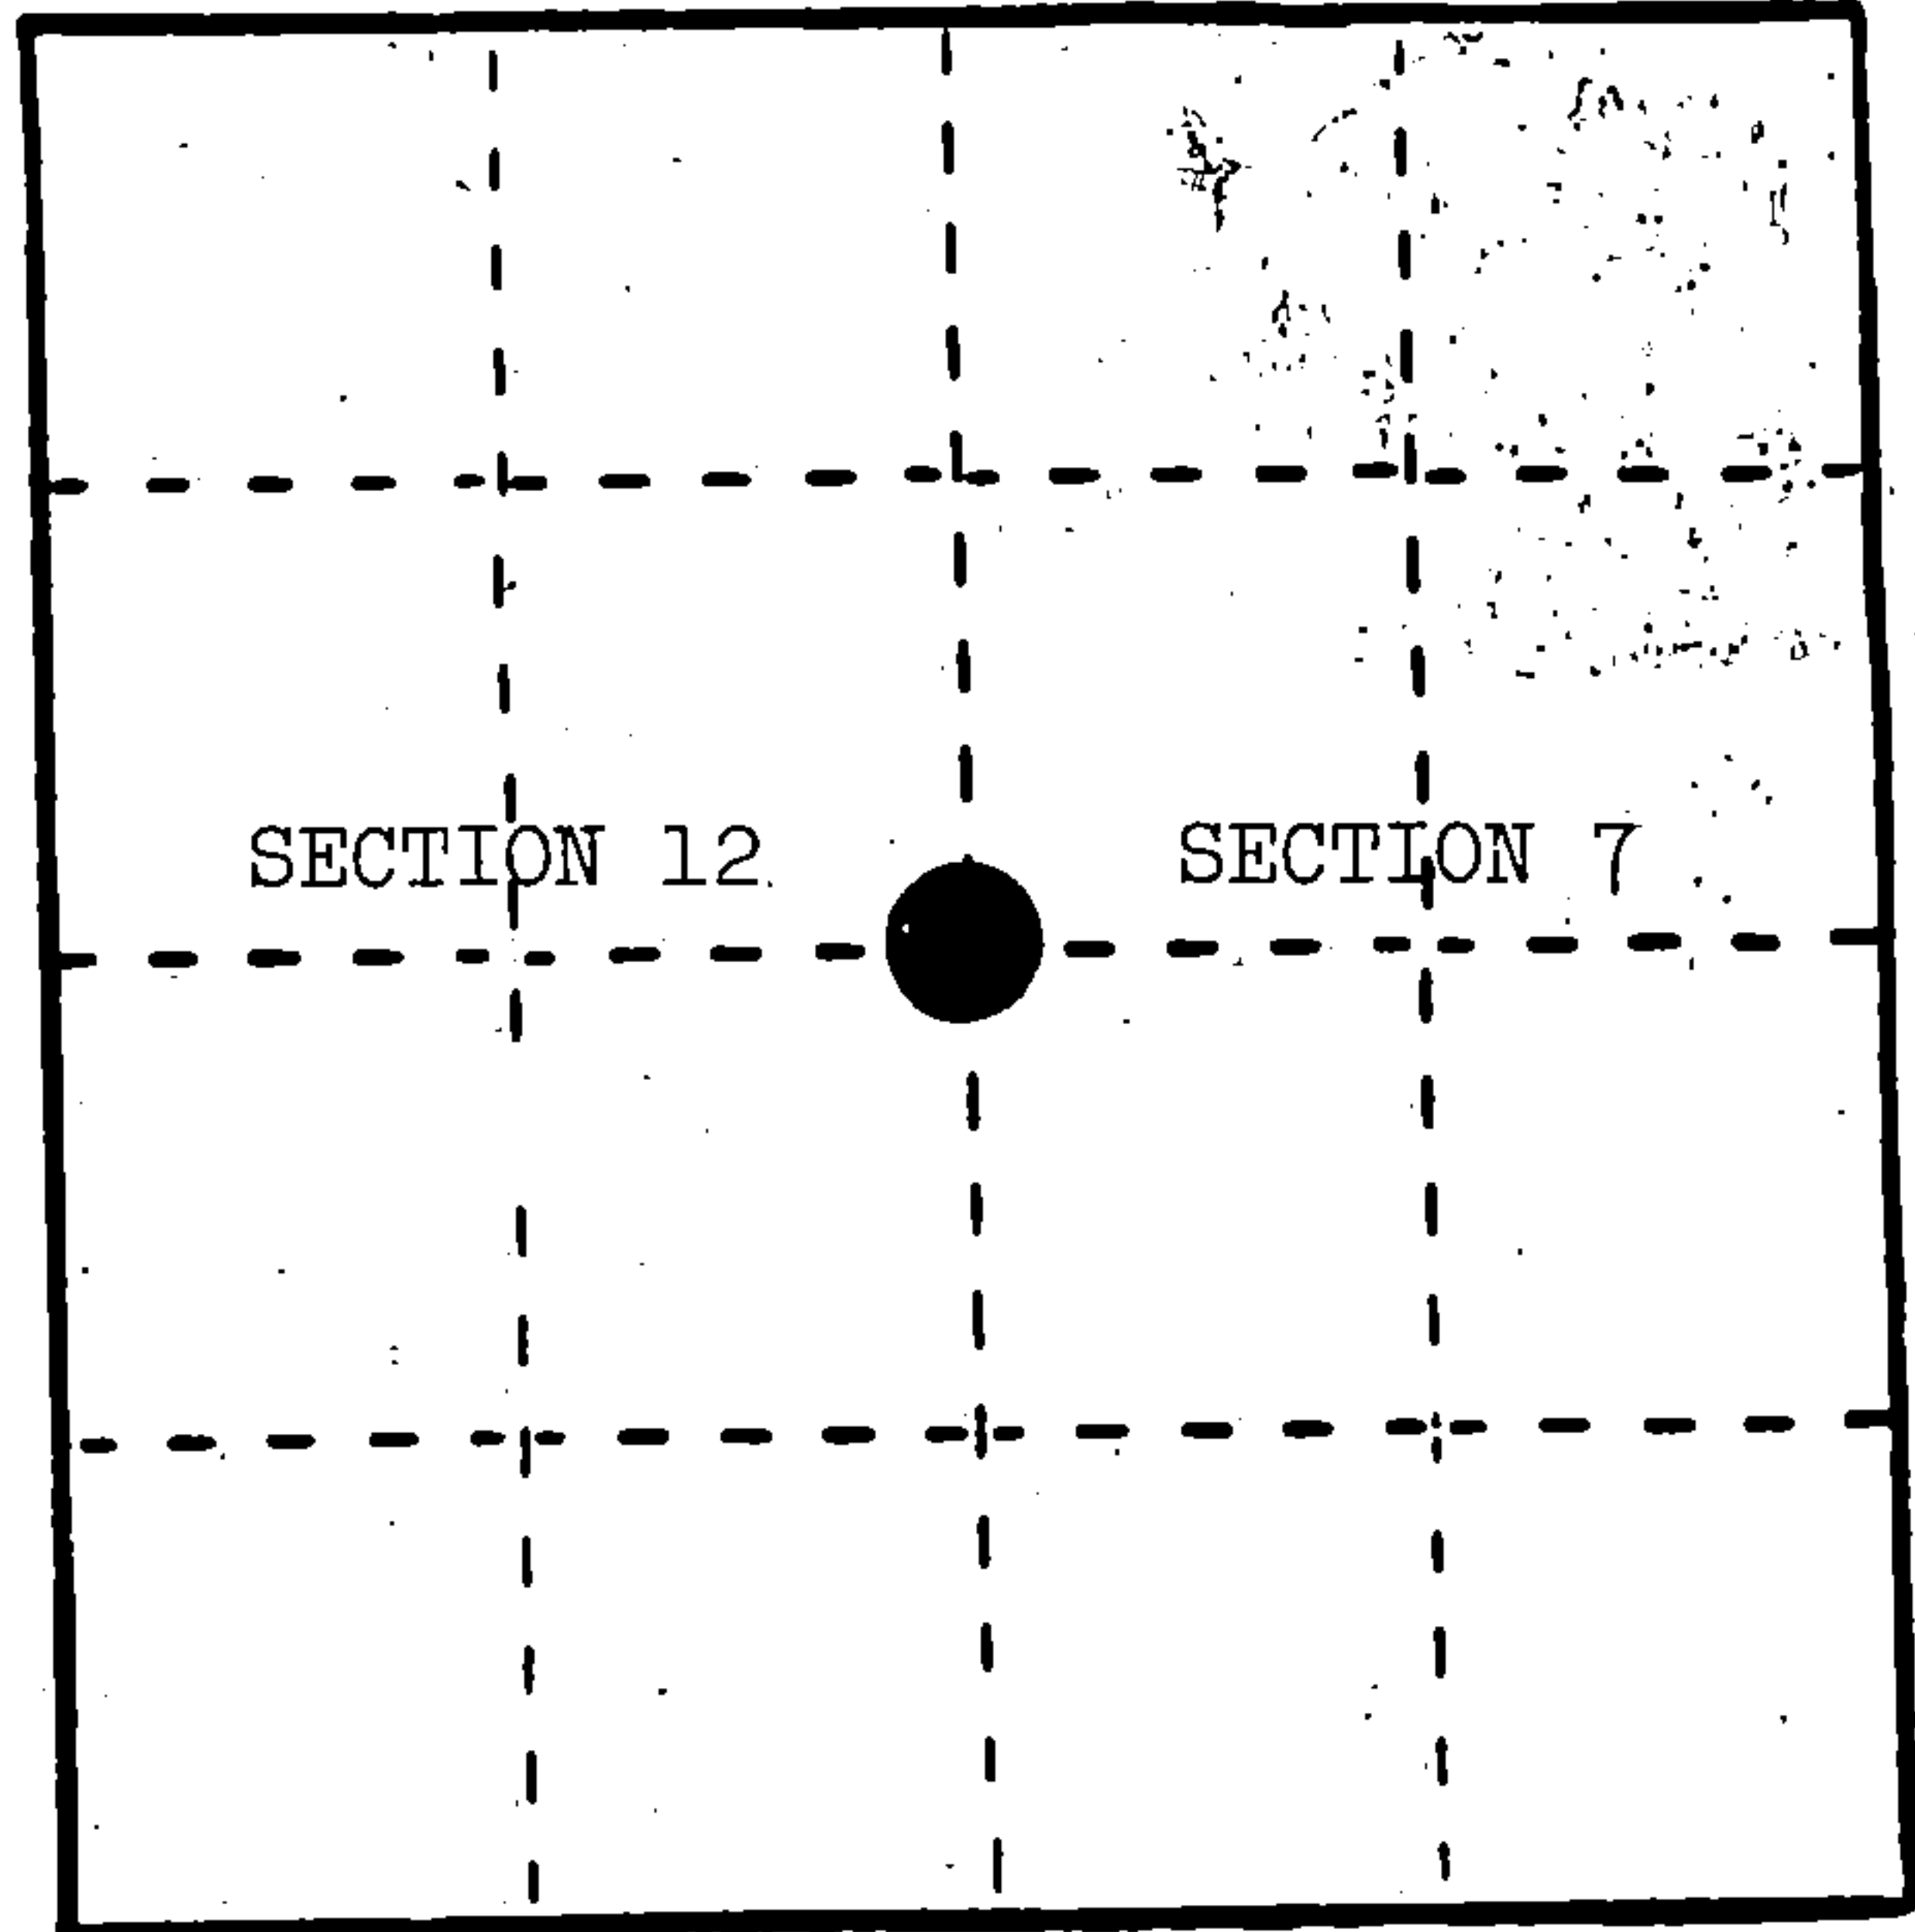

REGISTER'S OFFICE
 Forest County, Wis.
 Received for record this 17th day
 of March A.D. 1986 at
 10:40 o'clock A.M. and recorded
 in Vol. CORNER RESTORATIONS
 page G-25
Paul Aschenbrenner
 Register of Deeds


- (b) Describe any record evidence, monument evidence, occupational evidence, testimonial evidence or any other material evidence you considered, and whether the monument was found or placed.

In 1858, Alfred Millard set wood post with the following BTs: Lynn, 22", N.79°E., 19 links; Lynn, 12", S.79°W., 17 links.
 March 27, 1937, CCCs found Cedar post, 5" x 5" x 30", in good shape and scribed. Also found Yellow Birch stump, S.27°E., 18 links and location poster on 8" Maple, S.9°E., 31 links.
 October, 1964, J. Resvick found fence corner with fence north and west, 4" x 4" squared post (rotted off), 6" x 6" post lying on side, 12" Yellow Birch stump (scribed), S.25°E., 12.70 feet, and 15" Lynn, S.79°W., 11.22 feet.
 June 19, 1985, Alan Harrison found corner of fence line--2 feet south is post hole with 6" x 6" post lying on ground. Also found double Basswood progeny, S.79°W., 11.2 feet; 14" Sugar (as per "874"), S.9°E., 20.5 feet; old Yellow Birch stump with a 12" live Yellow Birch growing on top, S.27°E., 12.0 feet.

- (c) In the plan view drawing below, provide reference ties to at least 4 witness monuments, or, if the location is within a municipality, to at least 2 witness monuments. (Witness monuments shall be made of concrete, natural stone, iron or other equally durable material.) Describe witness monuments.

- (d) Show a plan view drawing depicting the relevant monuments and reference ties which is sufficient in detail to enable accurate relocation of the corner monument if the corner monument is disturbed. Indicate north.

- 2" x 36" aluminum monument, in a mound of stone, stamped to identify the corner.
- Sugar, 9", N.62°E., 20.02 feet
- Sugar, 8", S.46°W., 21.21 feet
- Yellow Birch, 11", N.52°W., 19.62 feet
- Steel Sign Post, Southeast, 1.10 feet

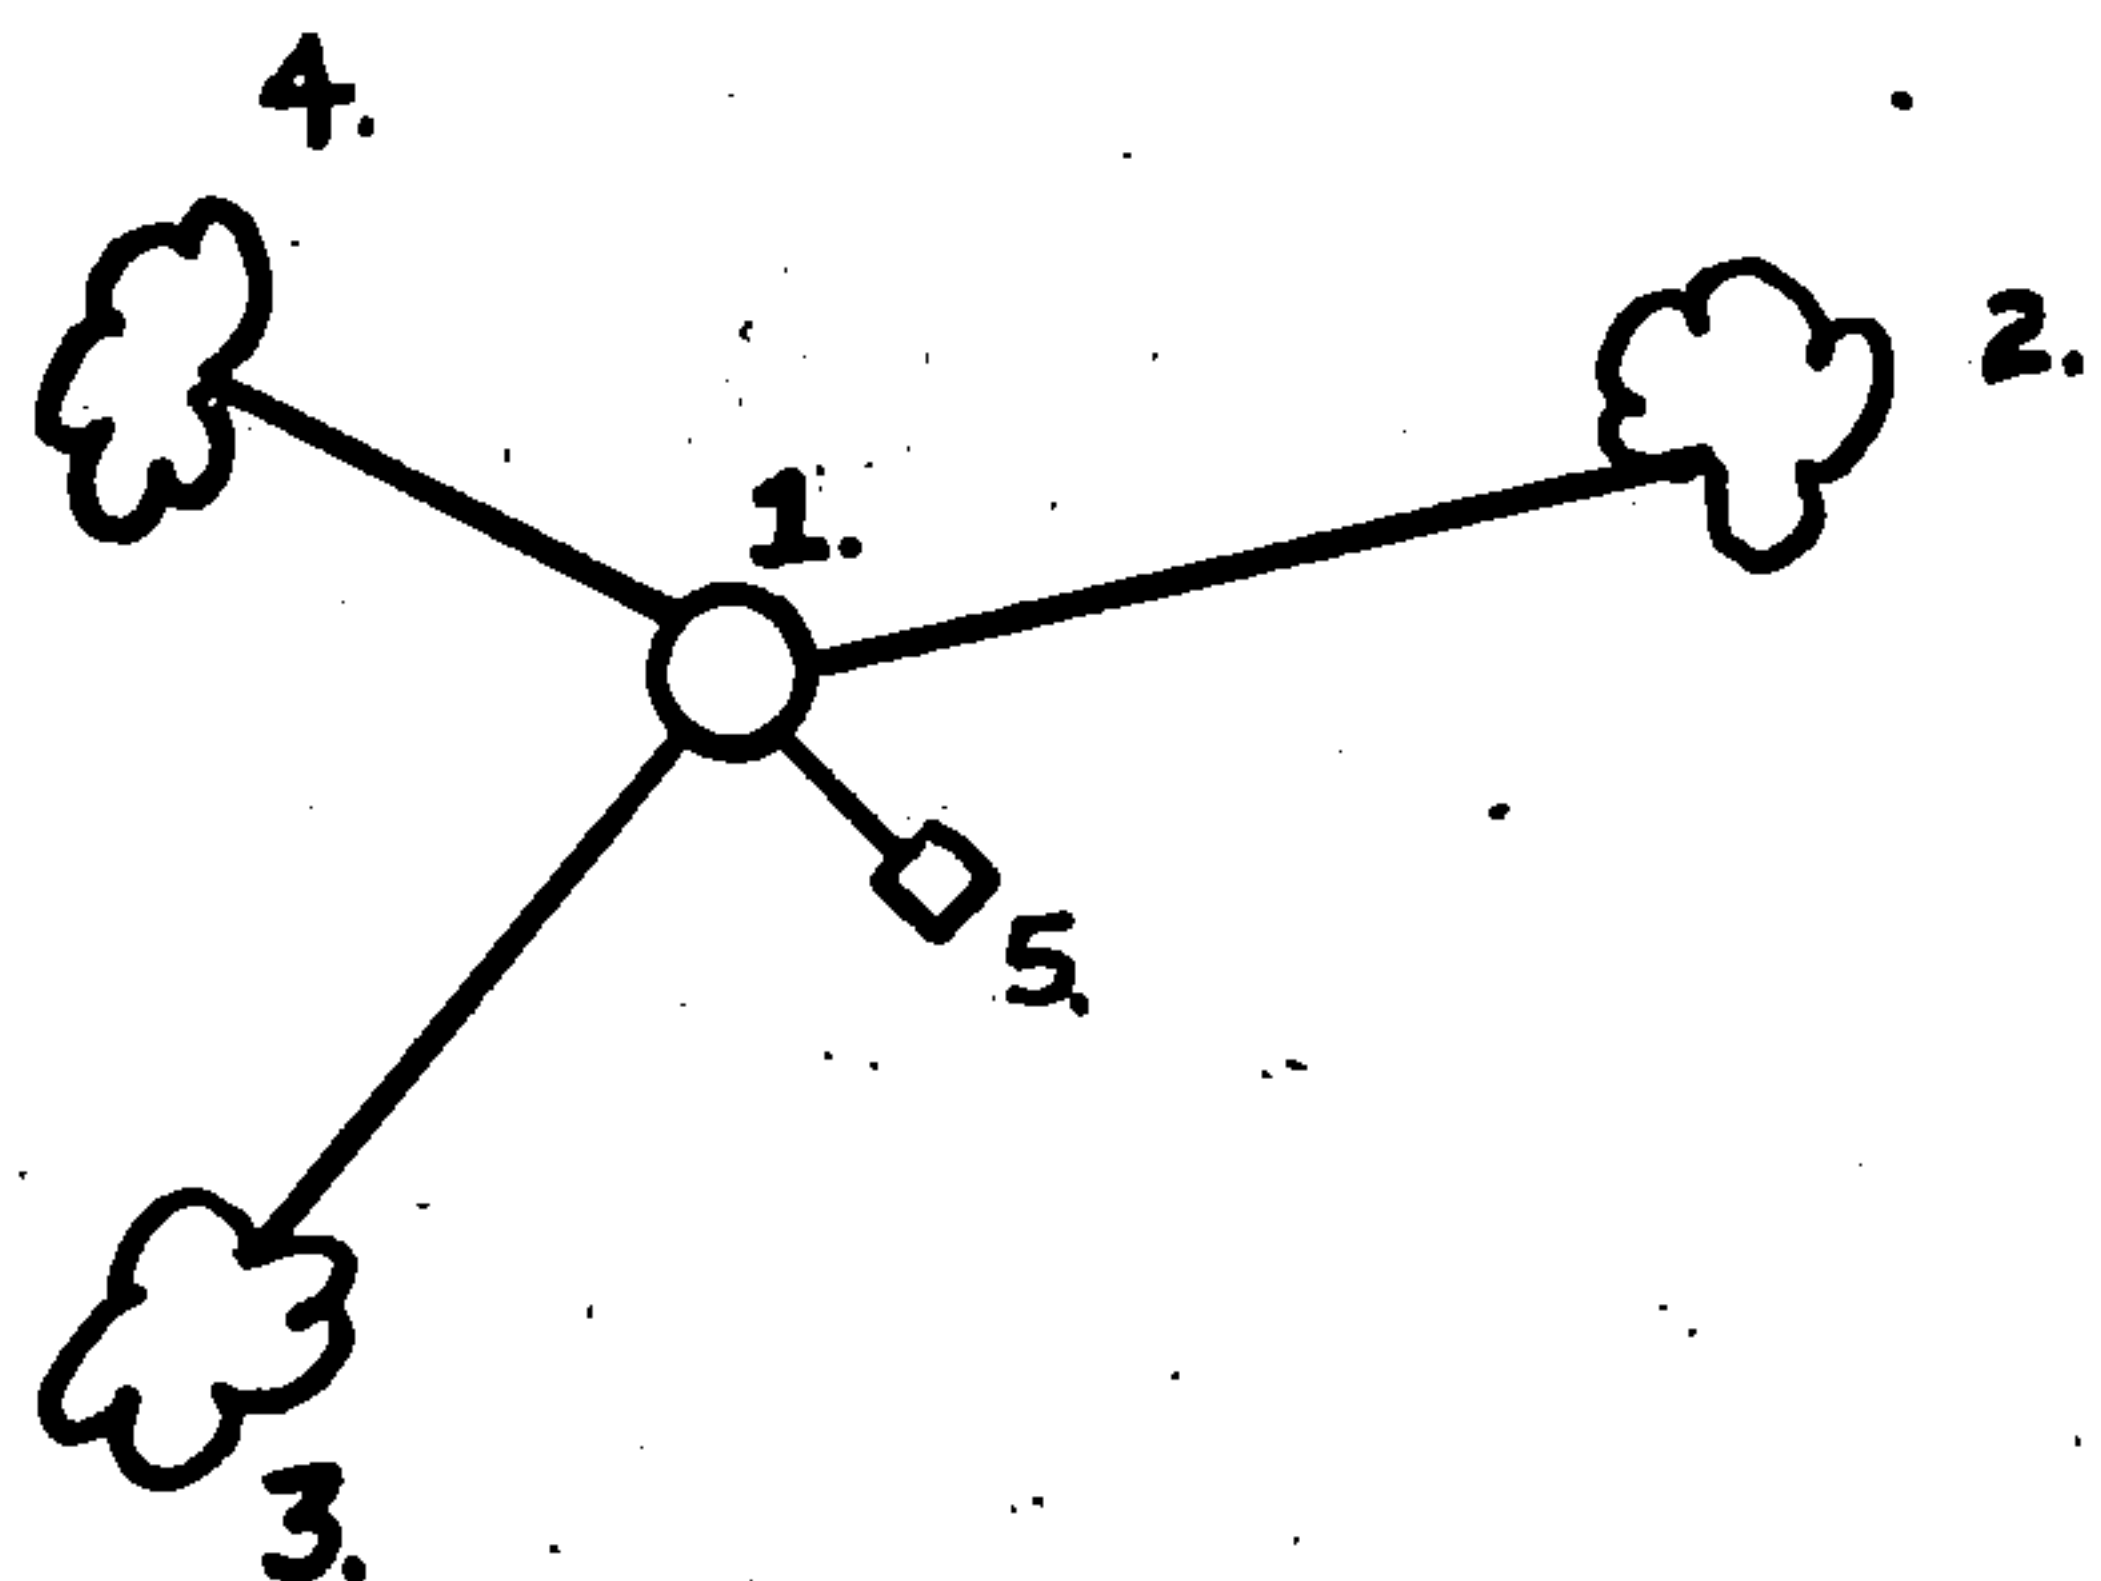

(e) Describe any material discrepancy between the location of the corner as restored or reestablished and the location of that corner as previously restored or reestablished by distance and direction. Show the discrepancy on the plan view drawing under (d), above. Show the distances between the corner as previously restored or reestablished and (1) the corner as restored or reestablished, and (2) to at least 2 of the witness monuments shown on the drawing in (d), above.

None.

(f) Was the corner restored through acceptance of (1) an obliterated evidence location, or, (2) a found perpetuated location?

(2) a found perpetuated location.

(g) Was the corner reestablished through lost corner proportionate methods? If so, show the method, including the directions and distances to other public land survey corners used as evidence or used for proportioning in determining the corner location?

No.

Affix Land Surveyor Seal



(1) I, Alan D. Harrison
(type or print name) certify that the corner location shown
on this record was determined by me or under my direction and
control and that this U.S. Public Land Survey Monument Record is
correct and complete to the best of my knowledge and belief.

Alan D. Harrison 1/3/85
Signature Date