

U.S. PUBLIC LAND SURVEY MONUMENT RECORD

Index No. N-12 & 13

State of Wisconsin }
County of FOREST } ss.

I, John C. Schulke, do hereby certify that on the 12th day of June, 1986, I found evidence of the Meander corner of Sections 16 and 21, Township 37 North, Range 12 East, Fourth Principal Meridian, as described hereon; and that from this evidence I established a new monument and accessories as described hereon to perpetuate the original location of this corner.

Resident witnesses:
.....
.....
.....

History of original corner establishment:

Original Government Survey in 1859 by William Daugherty.


Fir 8" N58°W 12 links
Fir 8" S50°W 87 links

Description of corner evidence found:
Recovered 1 1/4" diameter truck axle.
No bearing trees.

Description of monument and accessories I established to perpetuate the original location of this corner.

Blazed, scribed and painted the following bearing trees:

Red Maple 12" N18°W 55.99 feet
Twin Red Maple 10" N75°W 44.53 feet
Red Maple 10" N20°E 36.02 feet
Red Maple 10" S50°W 33.41 feet
Steel sign post Northwest 2.1 feet

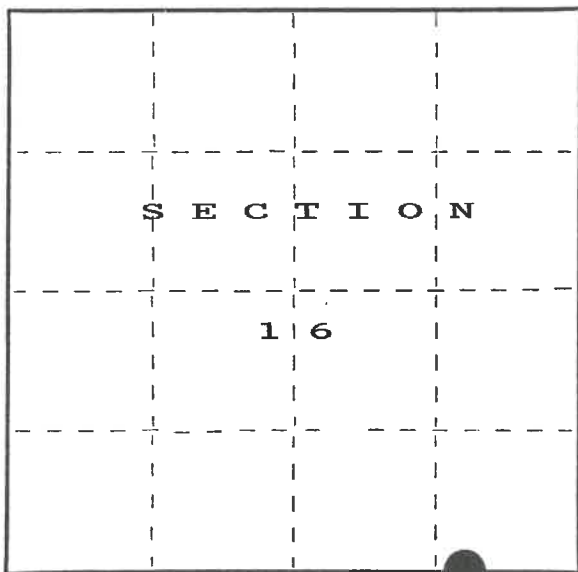

○ = Corner monument restored.

Dated at Ludington, Mich., this fifth day of January, 1987.

Signature: John C. Schulke Title: Land Surveyor Registration No. S-1665
(County Surveyor, Registered Land Surveyor, or other duly authorized official)

Office of Register of Deeds, County of Forest, I hereby certify that the within instrument was filed in this office for record on the 24th day of February, 1987, at 2:00 o'clock P.M.

Paul Ascherbrenner
(Register of Deeds)

By.....Deputy

REGISTRAR'S OFFICE
Forest County, Wis.

Received for record this 24th day of January A.D., 1987, at 2:00 o'clock P.M. and recorded in Vol. CORNER RESTORATIONS page N-12 & 13
Paul Ascherbrenner
Register of Deeds

FORM NO. 985-A
H.C. Miller Company
REGISTERED SURVEYORS
MILWAUKEE, WISCONSIN

Stock No. 26273

DOCUMENT NUMBER
132178

43712160008


(e) Describe any material discrepancy between the location of the corner as restored or reestablished and the location of that corner as previously restored or reestablished by distance and direction. Show the discrepancy on the plan view drawing under (d), above. Show the distances between the corner as previously restored or reestablished and (1) the corner as restored or reestablished, and (2) to at least 2 of the witness monuments shown on the drawing in (d), above.

No discrepancy, accepted existing corner as the best evidence.

(f) Was the corner restored through acceptance of (1) an obliterated evidence location, or, (2) a found perpetuated location?


The corner was restored through the acceptance of a found perpetuated location.

(g&h) Was the corner reestablished through lost corner proportionate methods? If so, show the method, including the directions and distances to other public land survey corners used as evidence or used for proportioning in determining the corner location?

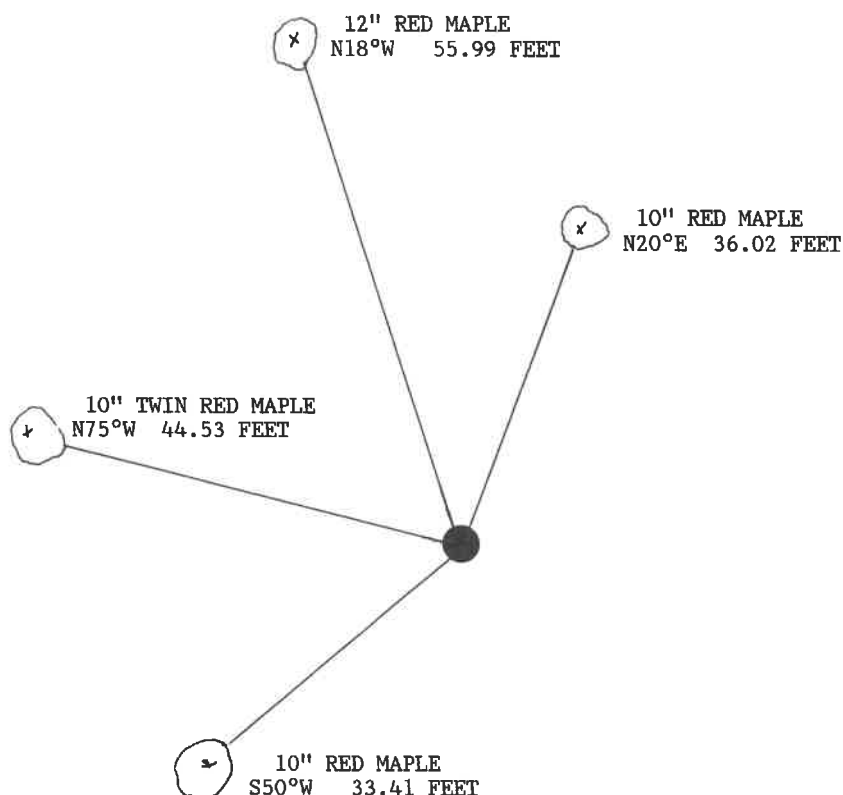

QUARTER CORNER

S16
+
S21

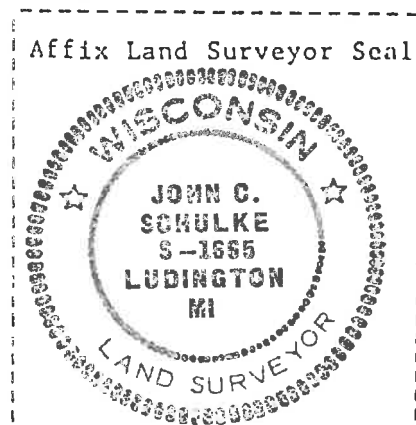

(i) I, John C. Schulke
(type or print name) certify that the corner location shown on this record was determined by me or under my direction and control and that this U.S. Public Land Survey Monument Record is correct and complete to the best of my knowledge and belief.

John C. Schulke
Signature

January 5th, 1987
Date

Certificate Ready for Filing:

Dale S. Stage
District Ranger

2/24/87
Date