


U.S. PUBLIC LAND SURVEY MONUMENT RECORD

Index No. N-11

State of Wisconsin }  
County of FOREST } ss.

I, John G. Schulke, do hereby certify that on the 13th day of June, 1986, I found evidence of the South Quarter corner of Section 16 Township 37, North, Range 12 East, Fourth Principal Meridian, as described hereon; and that from this evidence I established a new monument and accessories as described hereon to perpetuate the original location of this corner.

Resident witnesses:

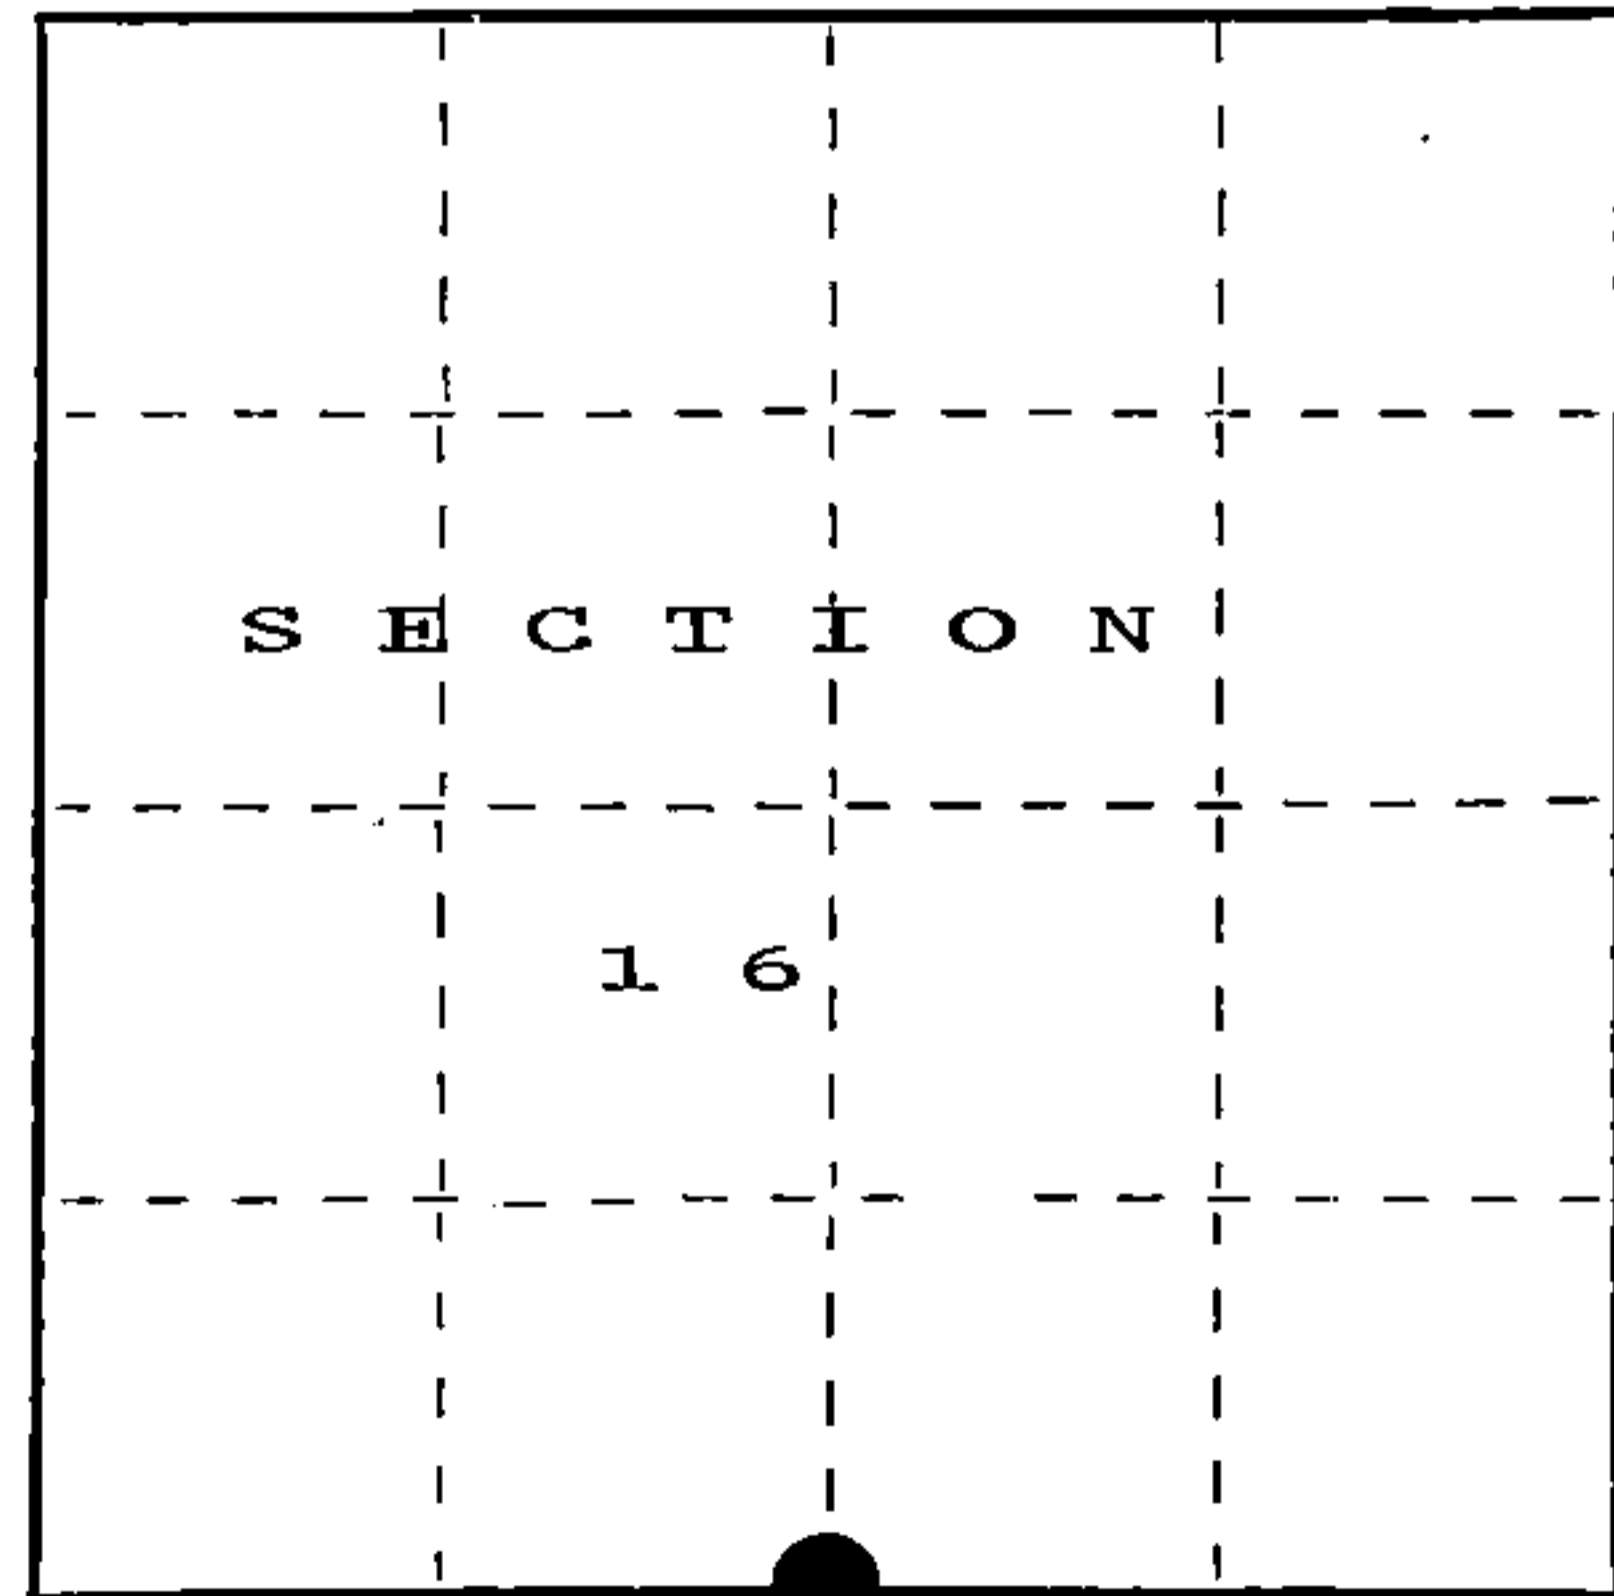

○ = Corner monument restored.

History of original corner establishment:

Original Government Survey in 1859 by William Daugherty.

Original Bearing trees: Cedar 10" N11°E 13 lks.  
Cedar 10" S22°E 12 lks.

Description of corner evidence found:

Found 2 1/2" dia. aluminum capped monument stamped to identify the corner set by William Cochrane (S-1107) in 1983.

Found blaze and scribing on Cedar tree 13" N86°W 13.58 feet

Description of monument and accessories I established to perpetuate the original location of this corner.

Blazed, scribed, painted and tagged the following bearing trees:

Cedar	16"	N48°W	16.99 feet
Cedar	8"	N38°E	17.22 feet
Cedar	5"	S69°E	22.93 feet
Cedar	12"	S16°W	69.88 feet
Steel sign post		North	1.0 foot

Dated at Ludington, Michigan, this fifth day of January, 1987.

Signature: John C. Schulke Title: Land Surveyor Registration No. S-1665  
(County Surveyor, Registered Land Surveyor, or other duly authorized official)

Office of Register of Deeds, County of Forest, I hereby certify that the within instrument was filed in this office for record on the 24th day of February, 1987 at 2:00 o'clock P.M.


Paul Aschenbrenner  
(Register of Deeds)

By \_\_\_\_\_ Deputy

REGISTER'S OFFICE  
Forest County, Wis.

Received for record this 24th day of February, A.D., 1987 at 2:00 o'clock P.M. and recorded in Vol. CORNER RESTORATIONS page 9-11  
Paul Aschenbrenner  
Register of Deeds

FORM NO. 985-A

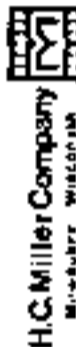

Stock No. 26273

DOCUMENT NUMBER  
132177

43712160020



(e) Describe any material discrepancy between the location of the corner as restored or reestablished and the location of that corner as previously restored or reestablished by distance and direction. Show the discrepancy on the plan view drawing under (d), above. Show the distances between the corner as previously restored or reestablished and (1) the corner as restored or reestablished, and (2) to at least 2 of the witness monuments shown on the drawing in (d), above.

No discrepancy, accepted existing corner as the best evidence.

(f) Was the corner restored through acceptance of (1) an obliterated evidence location, or, (2) a found perpetuated location?

The corner was restored through the acceptance of a found perpetuated location.

(g&h) Was the corner reestablished through lost corner proportionate methods? If so, show the method, including the directions and distances to other public land survey corners used as evidence or used for proportioning in determining the corner location?

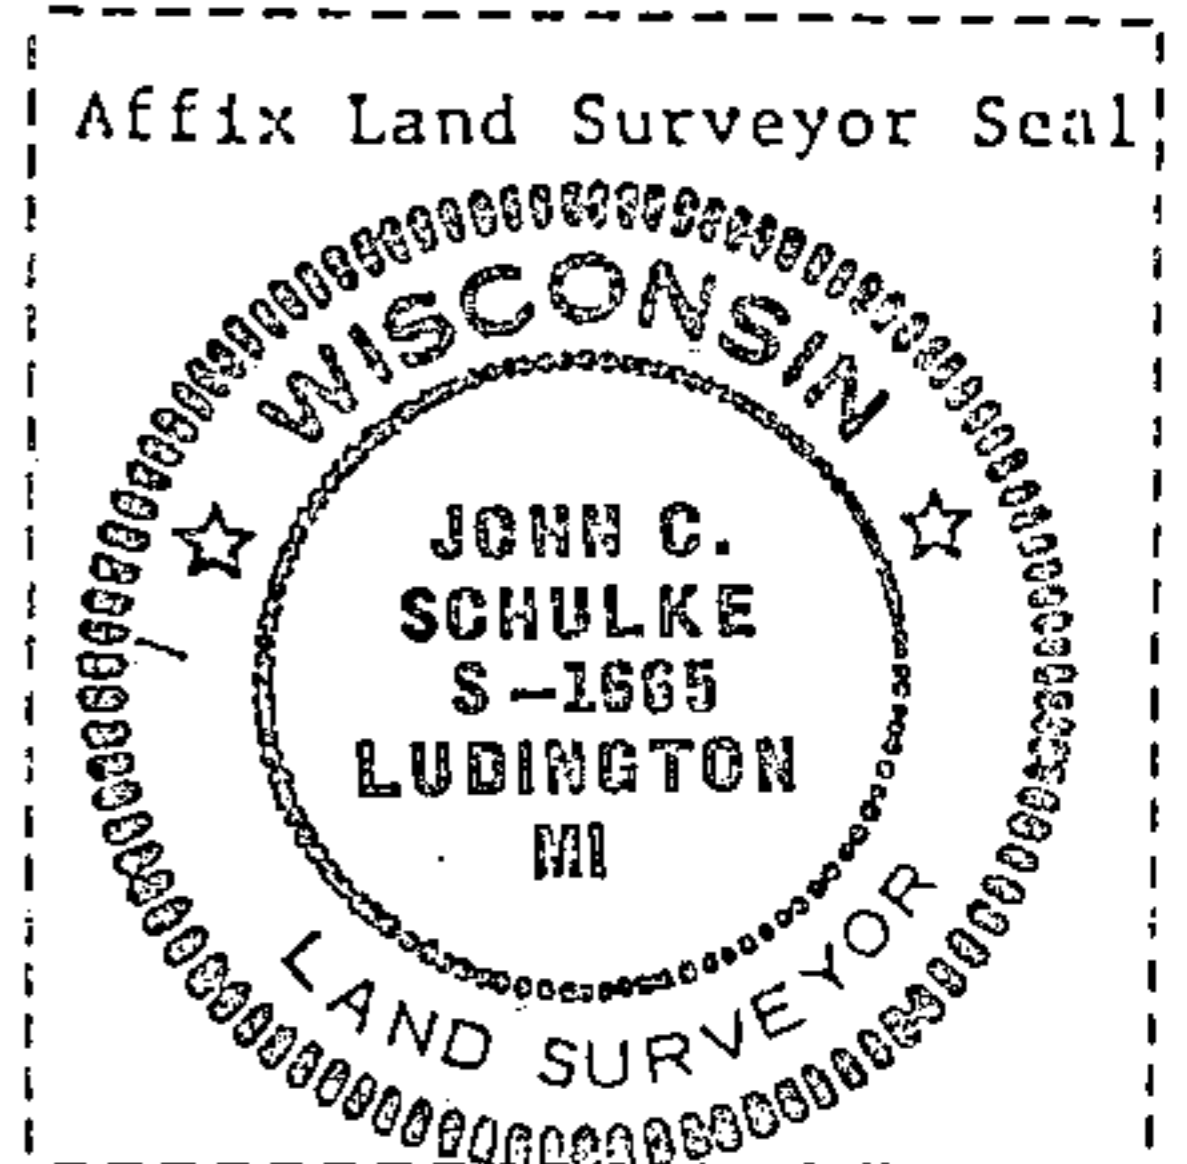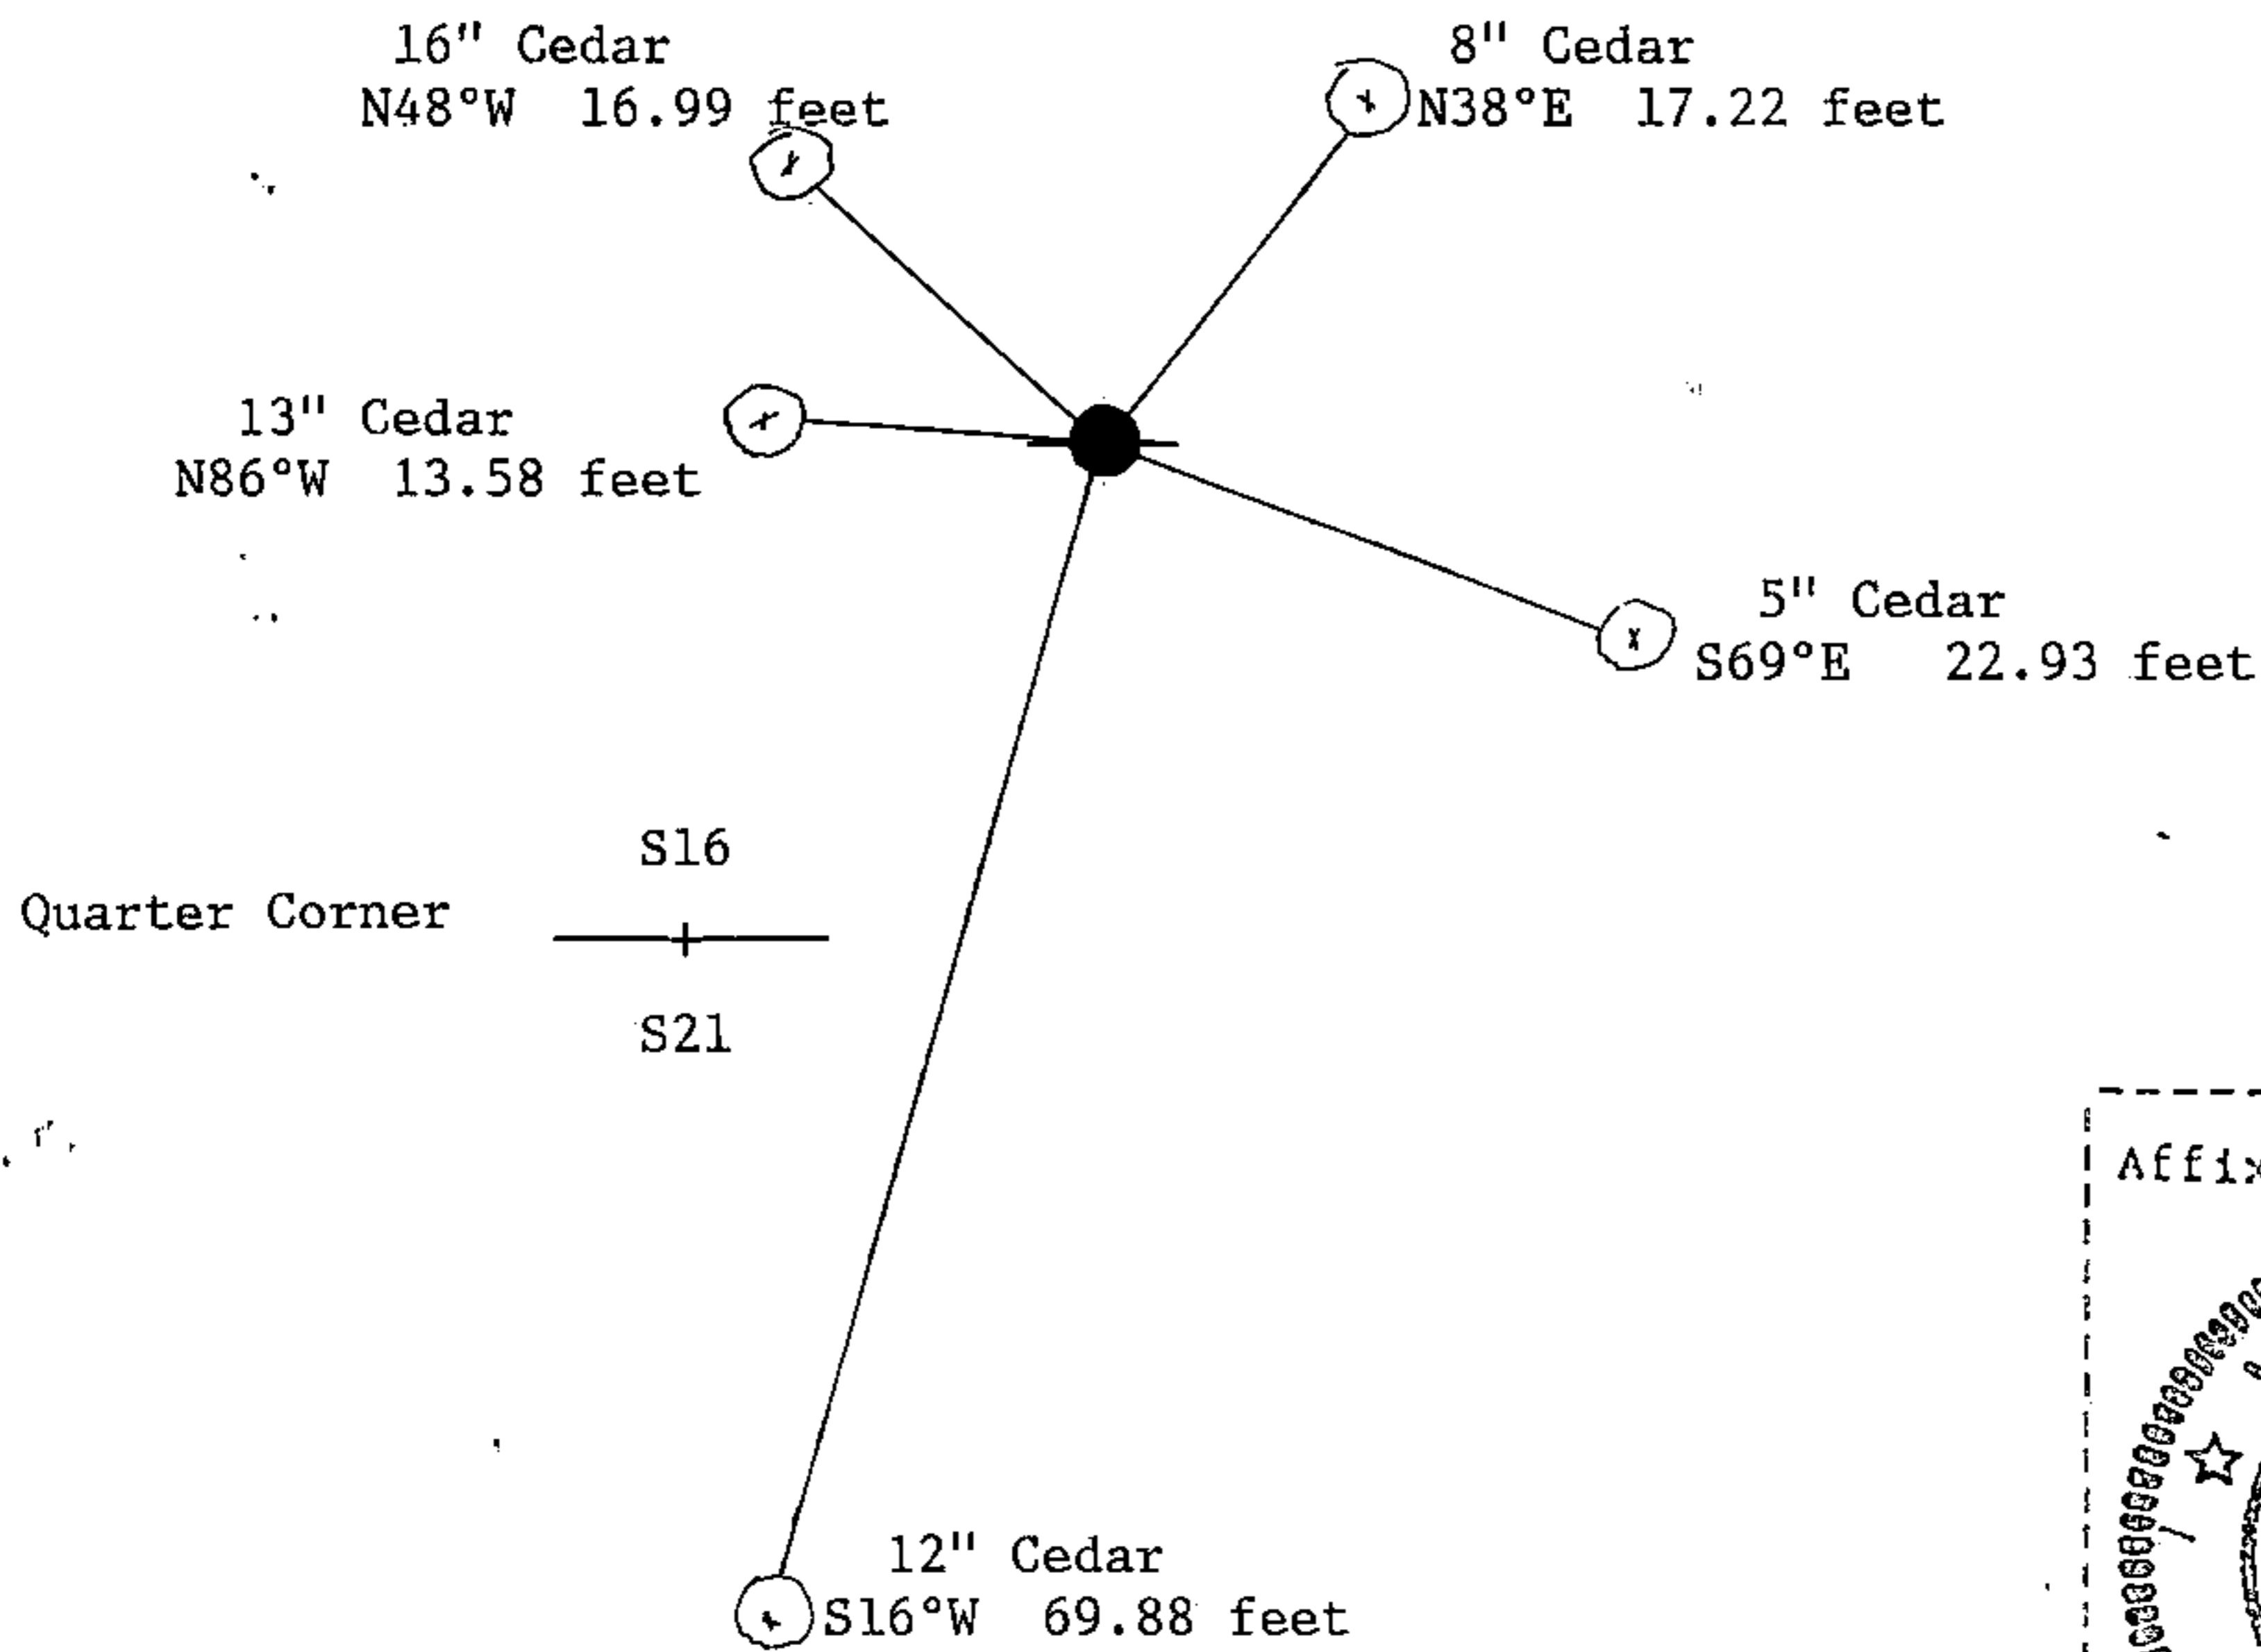

(i) I, John C. Schulke  
 (type or print name) certify that the corner location shown on this record was determined by me or under my direction and control and that this U.S. Public Land Survey Monument Record is correct and complete to the best of my knowledge and belief.

John C. Schulke Jan 5th, 1987  
 Signature Date

Certificate Ready for Filing: Dale B. Staege 2/24/87  
 District Ranger Date