

U.S. PUBLIC LAND SURVEY MONUMENT RECORD

Index No. J.K. - 13

State of Wisconsin } ss.
County of FOREST

I, John C. Schulke, do hereby certify that on the 14th day of November, 1986, I found evidence of the Witness Meander corner of Section 16 Township Thirty-seven, North, Range Twelve East, Fourth Principal Meridian, as described hereon; and that from this evidence I established a new monument and accessories as described hereon to perpetuate the original location of this corner.

Resident witnesses:

.....
.....
.....

History of original corner establishment:

- 1. Original corner established in 1859 by William Daughter, U.S. Deputy Surveyor. Set wooden post with the following bearing trees: Hemlock 7" N70°W 3 links Hemlock 10" N67°E 10 links
2. Corner restored in survey of Government Lot 1 Section 15, dated June 1952 by Nicholas M. Rowinski.

Description of corner evidence found:

No evidence recovered from the Rowinski Survey. The area the corner is located has been eroded heavily by Pine Lake. Recovered 1 1/2" iron pipe on Section line.

Description of monument and accessories I established to perpetuate the original location of this corner.

Set 2 1/2" X 3' aluminum magnetic capped Forest County Monument stamped to identify the corner. Scribed the following bearing trees:

Table with 4 columns: Tree Name, Diameter, Bearing, Distance. Includes Cedar (9", N54°E, 34.70 feet), White Birch (8", S88°W, 14.58 feet), Red Maple (5", N34°W, 9.42 feet), Black Ash (5", N06°W, 7.40 feet), Found Iron Pipe (1", S11°E, 17.9 feet).


Dated at Ludington, Michigan, Wis., this fifth day of January, 1987.

Signature John C. Schulke Title John C. Schulke Registration No. S-1665 (County Surveyor, Registered Land Surveyor, or other duly authorized official)

Office of Register of Deeds, County of Forest, I hereby certify that the within instrument was filed in this office for record on the 11th day of February, 1987 at 3:45 o'clock P.M.


(Register of Deeds)

By Deputy

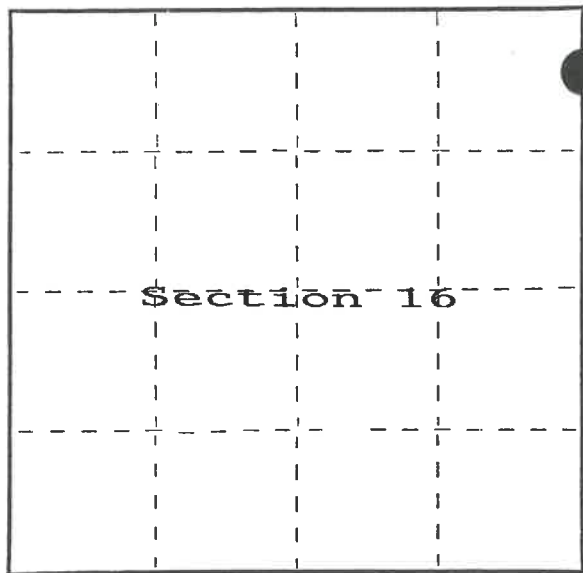

O = Corner monument restored.

FORM NO. 985-A

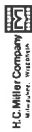

Stock No. 26273

DOCUMENT NUMBER 132070

43712163700

(e) Describe any material discrepancy between the location of the corner as restored or reestablished and the location of that corner as previously restored or reestablished by distance and direction. Show the discrepancy on the plan view drawing under (d), above. Show the distances between the corner as previously restored or reestablished and (1) the corner as restored or reestablished, and (2) to at least 2 of the witness monuments shown on the drawing in (d), above.

Corner restored based on Rowinski survey, which is the only restoration of record.

(f) Was the corner restored through acceptance of (1) an obliterated evidence location, or, (2) a found perpetuated location?

Corner was restored through acceptance of an obliterated evidence location.

(g&h) Was the corner reestablished through lost corner proportionate methods? If so, show the method, including the directions and distances to other public land survey corners used as evidence or used for proportioning in determining the corner location?

