

CERTIFIED LAND CORNER RESTORATION

State of Wisconsin }
County of Forest } ss.

I, Milo E. Stefan, do hereby certify that on the 13th day of May, 1982, I found evidence of the West Quarter corner of Section 16 Township 37N, Range 12E, Fourth Principal Meridian, as described hereon; and that from this evidence I established a new monument and accessories as described hereon to perpetuate the original location of this corner:

Description of original monument and accessories and subsequent restorations:

Surveyed in 1859 by Wm. Daugherty
40.00 chains north, set 1/4 section wood post
Fir, 8", N55E, 21 lks., 13.86 feet
Birch, 10", S27W, 22 lks., 14.52 feet


Description of corner evidence found:

Found scribed wood post nailed to fence corner
Stump hole, S27W, 13.8 feet

Description of monument and accessories I established to perpetuate the location of this corner:

Placed a 2" x 36" aluminum monument in fence corner with tablet stamped as follows:
T37N, R12E, S17, 1/4, S16, 1982, RLS-1558
From which the following bear:
Sugar Maple, 12", S6W, 8.70 feet
Sugar Maple, 8", S75W, 23.39 feet
Sugar Maple, 6", N37W, 30.93 feet
Steel sign post, South, 1.2 feet

DOCUMENT NO.
124241

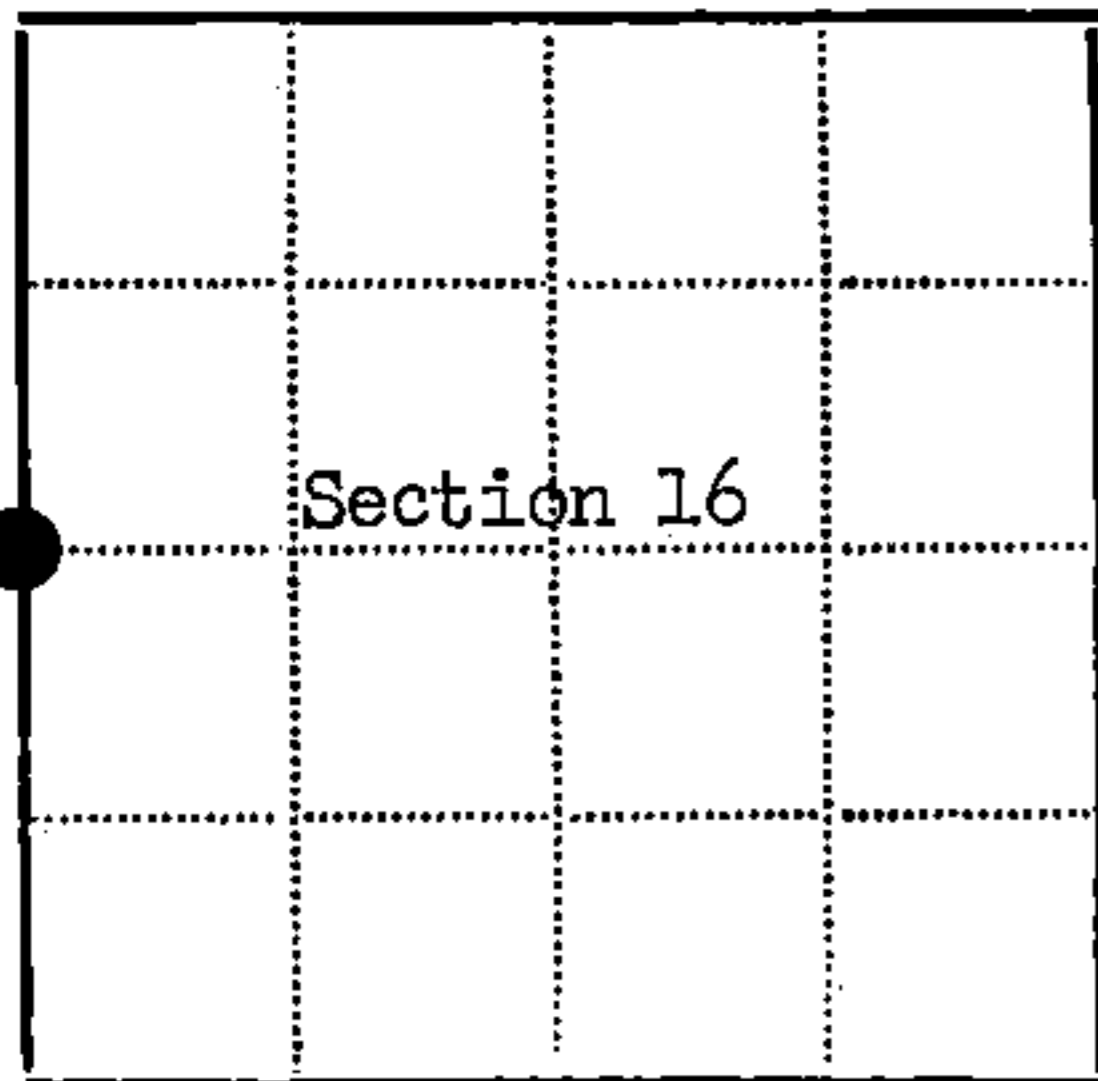

● - Corner monument restored
□ -

Resident witnesses.....

Dated at Rhinelander, Wisconsin, this 2 day of MAY, 1982.

Signature Milo E. Stefan Title Land Surveyor
(County Surveyor, Registered Land Surveyor, or other duly authorized official)

Surveyors Registration No. RLS-1558

Office of Register of Deeds County of Forest

I hereby certify that the within instrument was filed in this office for record on the 15th day of September, 1983, and was filed in Book No. Page No. of County Records.

Signature Eugene Staszny Title Register of Deeds

Township 37N, Range 12E, Section 16, Index No. L-9, Page No. 11

4 37 12 17 2000

6