

U.S. PUBLIC LAND SURVEY MONUMENT RECORD

Index No. P-5

State of Wisconsin }
County of FOREST } ss.

History of original corner establishment:
Original Government Survey in 1859 by William Daugherty.

Original bearing trees: Tamarack 6" N50°W 42 lks.
Tamarack 6" S16°E 8 lks.

I, John Schulke, do hereby certify that on the 14th day of October, 1986, I found evidence of the West Quarter corner of Section 20 Township 37, North, Range 12 East, Fourth Principal Meridian, as described hereon; and that from this evidence I established a new monument and accessories as described hereon to perpetuate the original location of this corner.


Description of corner evidence found:

No evidence found.

Resident witnesses:

Description of monument and accessories I established to perpetuate the original location of this corner. Set a 2 1/2" diameter aluminum pipe monument, 5 feet long, 4 feet in the ground, with an aluminum cap stamped; T37N, R12E, 1/4, S19, S20, 1986, S-1665. Established the following new bearing trees which are blazed, scribed, painted and tagged.

Spruce 5" N67°E 45.86 feet
Tamarack 3" N22°E 95.13 feet
Tamarack 5" S54°E 95.72 feet
Spruce 4" S69°W 38.62 feet
Steel sign post Northwest 0.9 feet

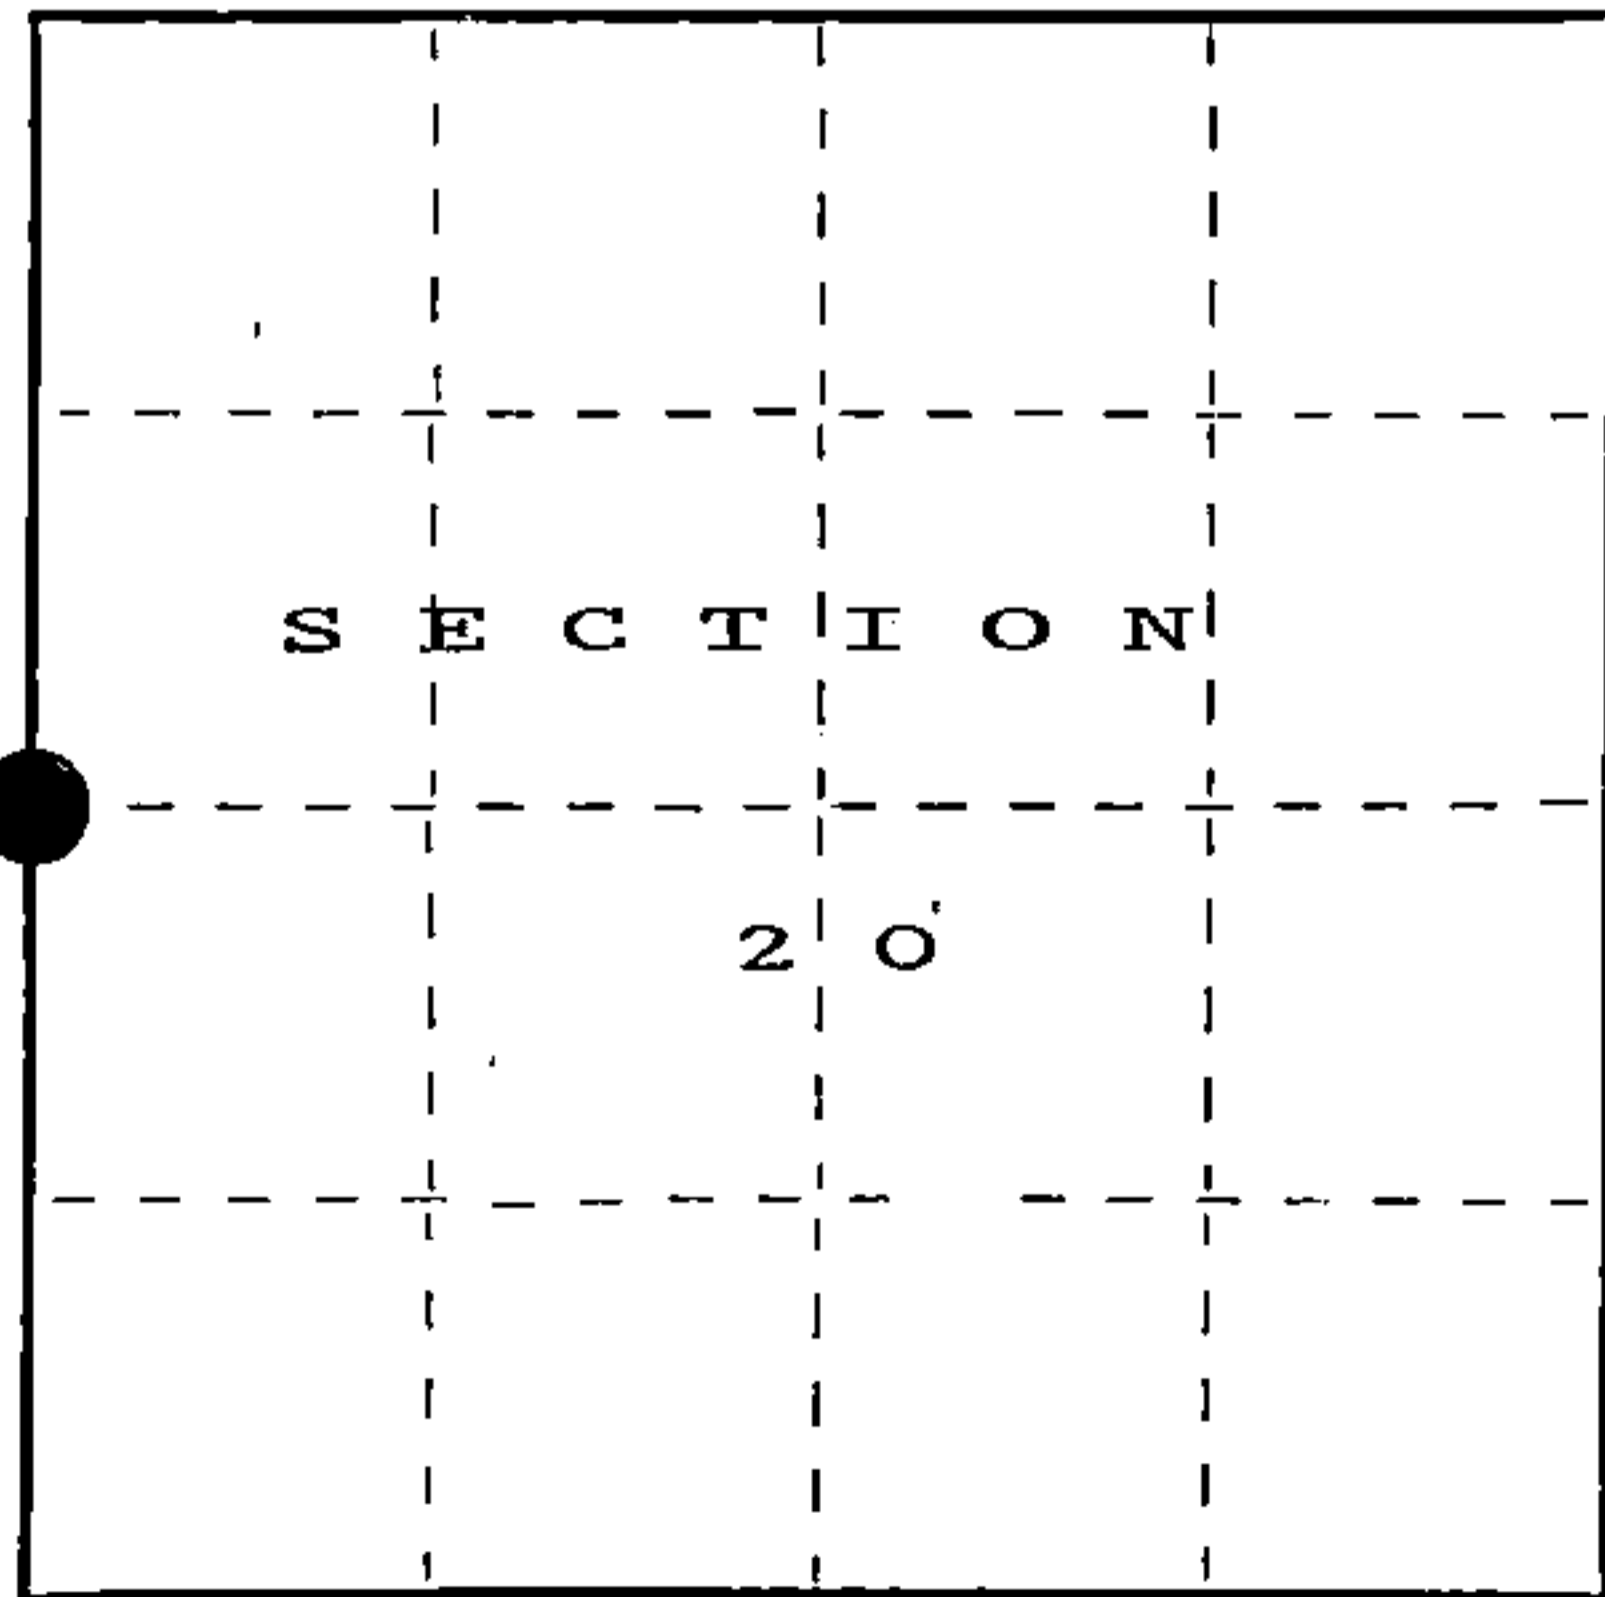

○ = Corner monument restored.

Dated at Ludington, Michigan, ~~Wis.~~, this fifth day of January, 1987.

Signature: John C. Schulke Title: Land Surveyor Registration No. S-1665
(County Surveyor, Registered Land Surveyor, or other duly authorized official)

Office of Register of Deeds, County of Forest, I hereby certify that the within instrument was filed in this office for record on the 24th day of February, 1987 at 2:00 o'clock P. M.

Paul Aschenbrenner
(Register of Deeds)


By.....Deputy

REGISTER'S OFFICE
Forest County, Wis.

Received for record this 24th day of February, 1987, at 2:00 o'clock P.M. and recorded in Vol. CORNER RESTORATIONS

Paul Aschenbrenner
Register of Deeds

FORM NO. 985-A

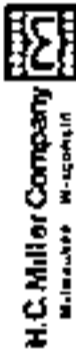

Stock No. 26273

DOCUMENT NUMBER
132183

4371219

(e) Describe any material discrepancy between the location of the corner as restored or reestablished and the location of that corner as previously restored or reestablished by distance and direction. Show the discrepancy on the plan view drawing under (d), above. Show the distances between the corner as previously restored or reestablished and (1) the corner as restored or reestablished, and (2) to at least 2 of the witness monuments shown on the drawing in (d), above.


No discrepancy, first corner restoration.

(f) Was the corner restored through acceptance of (1) an obliterated evidence location, or, (2) a found perpetuated location?

See g and h

(g&h) Was the corner reestablished through lost corner proportionate methods? If so, show the method, including the directions and distances to other public land survey corners used as evidence or used for proportioning in determining the corner location?

Corner position was reestablished through lost corner proportionate methods.

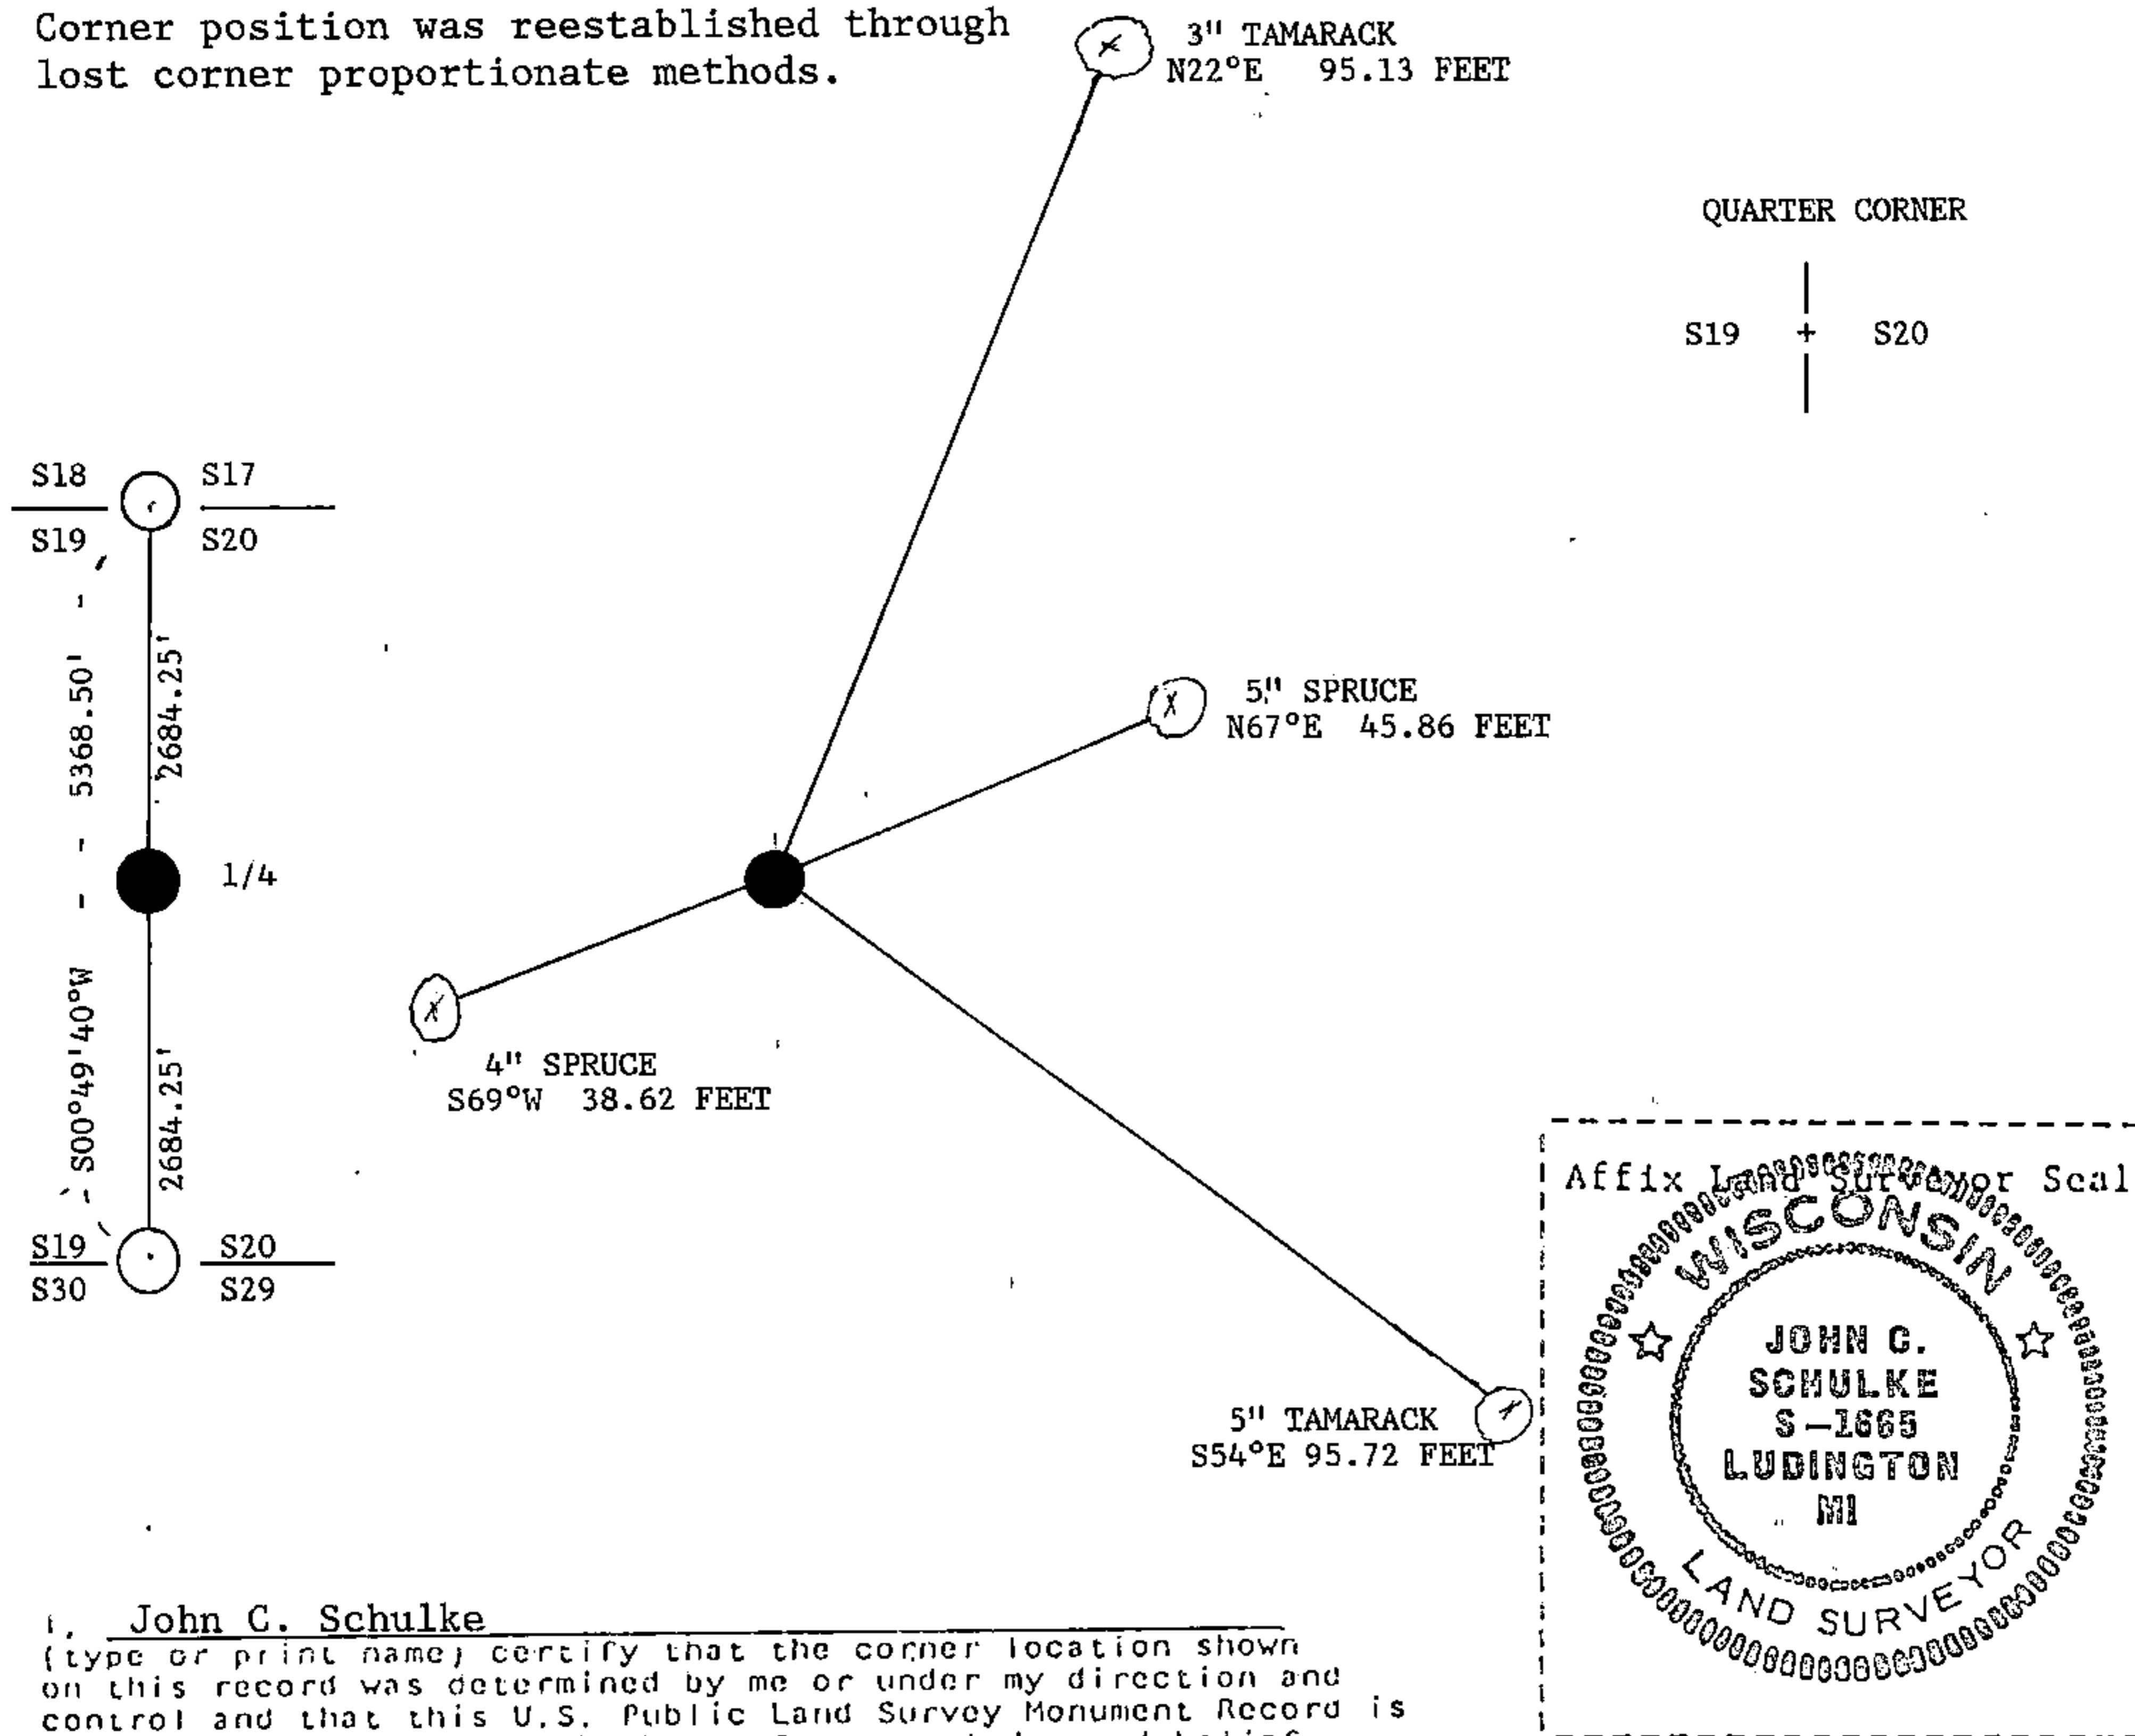

(i) I, John C. Schulke
 (type or print name) certify that the corner location shown on this record was determined by me or under my direction and control and that this U.S. Public Land Survey Monument Record is correct and complete to the best of my knowledge and belief.

John C. Schulke January 5th, 1987
 Signature Date

Certificate Ready for Filing: Dale S. Stange 2/24/87
 District Ranger Date