

CERTIFIED LAND CORNER RESTORATION

Index No. **QR17**

State of Wisconsin }
County of Forest } ss.

I William B. Cochrane, do hereby certify that on the 18 th day of August, 1977, I found evidence of the South Meander corner ~~X~~ between Secs. 22 and 23 Township 37, North, Range 12 East, Fourth Principal Meridian, as described hereon; and that from this evidence I established a new monument and accessories as described hereon to perpetuate the original location of this corner.

Resident witnesses:

Miles H. Cochrane

Brian James

History of original corner establishment:

Surveyed in 1859 by Wm. E. Daugherty North between Sections 22 and 23. 19.85 chs. To Pine Lake and set a Meander Post Birch, 16", N 80° E, 10 lks. Birch, 10", S 26° W, 10 lks.

Description of corner evidence found:


1" iron pipe and 4x4 squared cedar post. This position is tied into the survey of Section 23 and is accepted as being the meander corner position. This position has been used by other surveyors in lake lot subdivisions. No original evidence was recovered. The area has been developed for summer homes.

Description of monument and accessories I established to perpetuate the original location of this corner.

I replaced the 4x4 cedar post with a 2½" Berntsen, A-1 Federal Monument, 30 inches long, with cap stamped:

T37N R12E, S22, S23, 1977, S-1107, MEANDER CORNER From which: W. Ash, 6", bears S 41° E, 13.02 feet

FORM 985 R. C. MILLER CO., MILWAUKEE

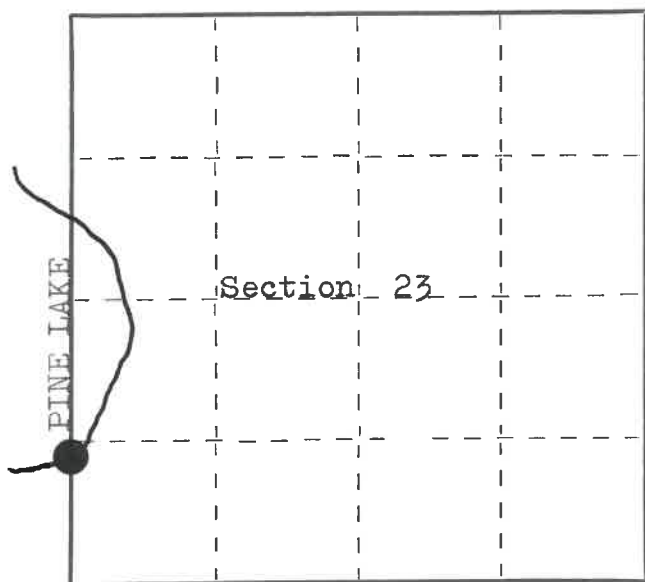

○ = Corner monument restored.



43712220900

Dated at Hiles, Wis., this 26 th day of August 1977

Signature William B. Cochrane Title Land Surveyor Registration No. S-1107
(County Surveyor, Registered Land Surveyor, or other duly authorized official)

Office of Register of Deeds, County of FOREST, I hereby certify that the within instrument was filed in this office for record on the 29 th day of August, 1977 at 4:20 o'clock P. M.

Eugene Staszny
(Register of Deeds)

By..... Deputy

DOCUMENT NUMBER
112224